


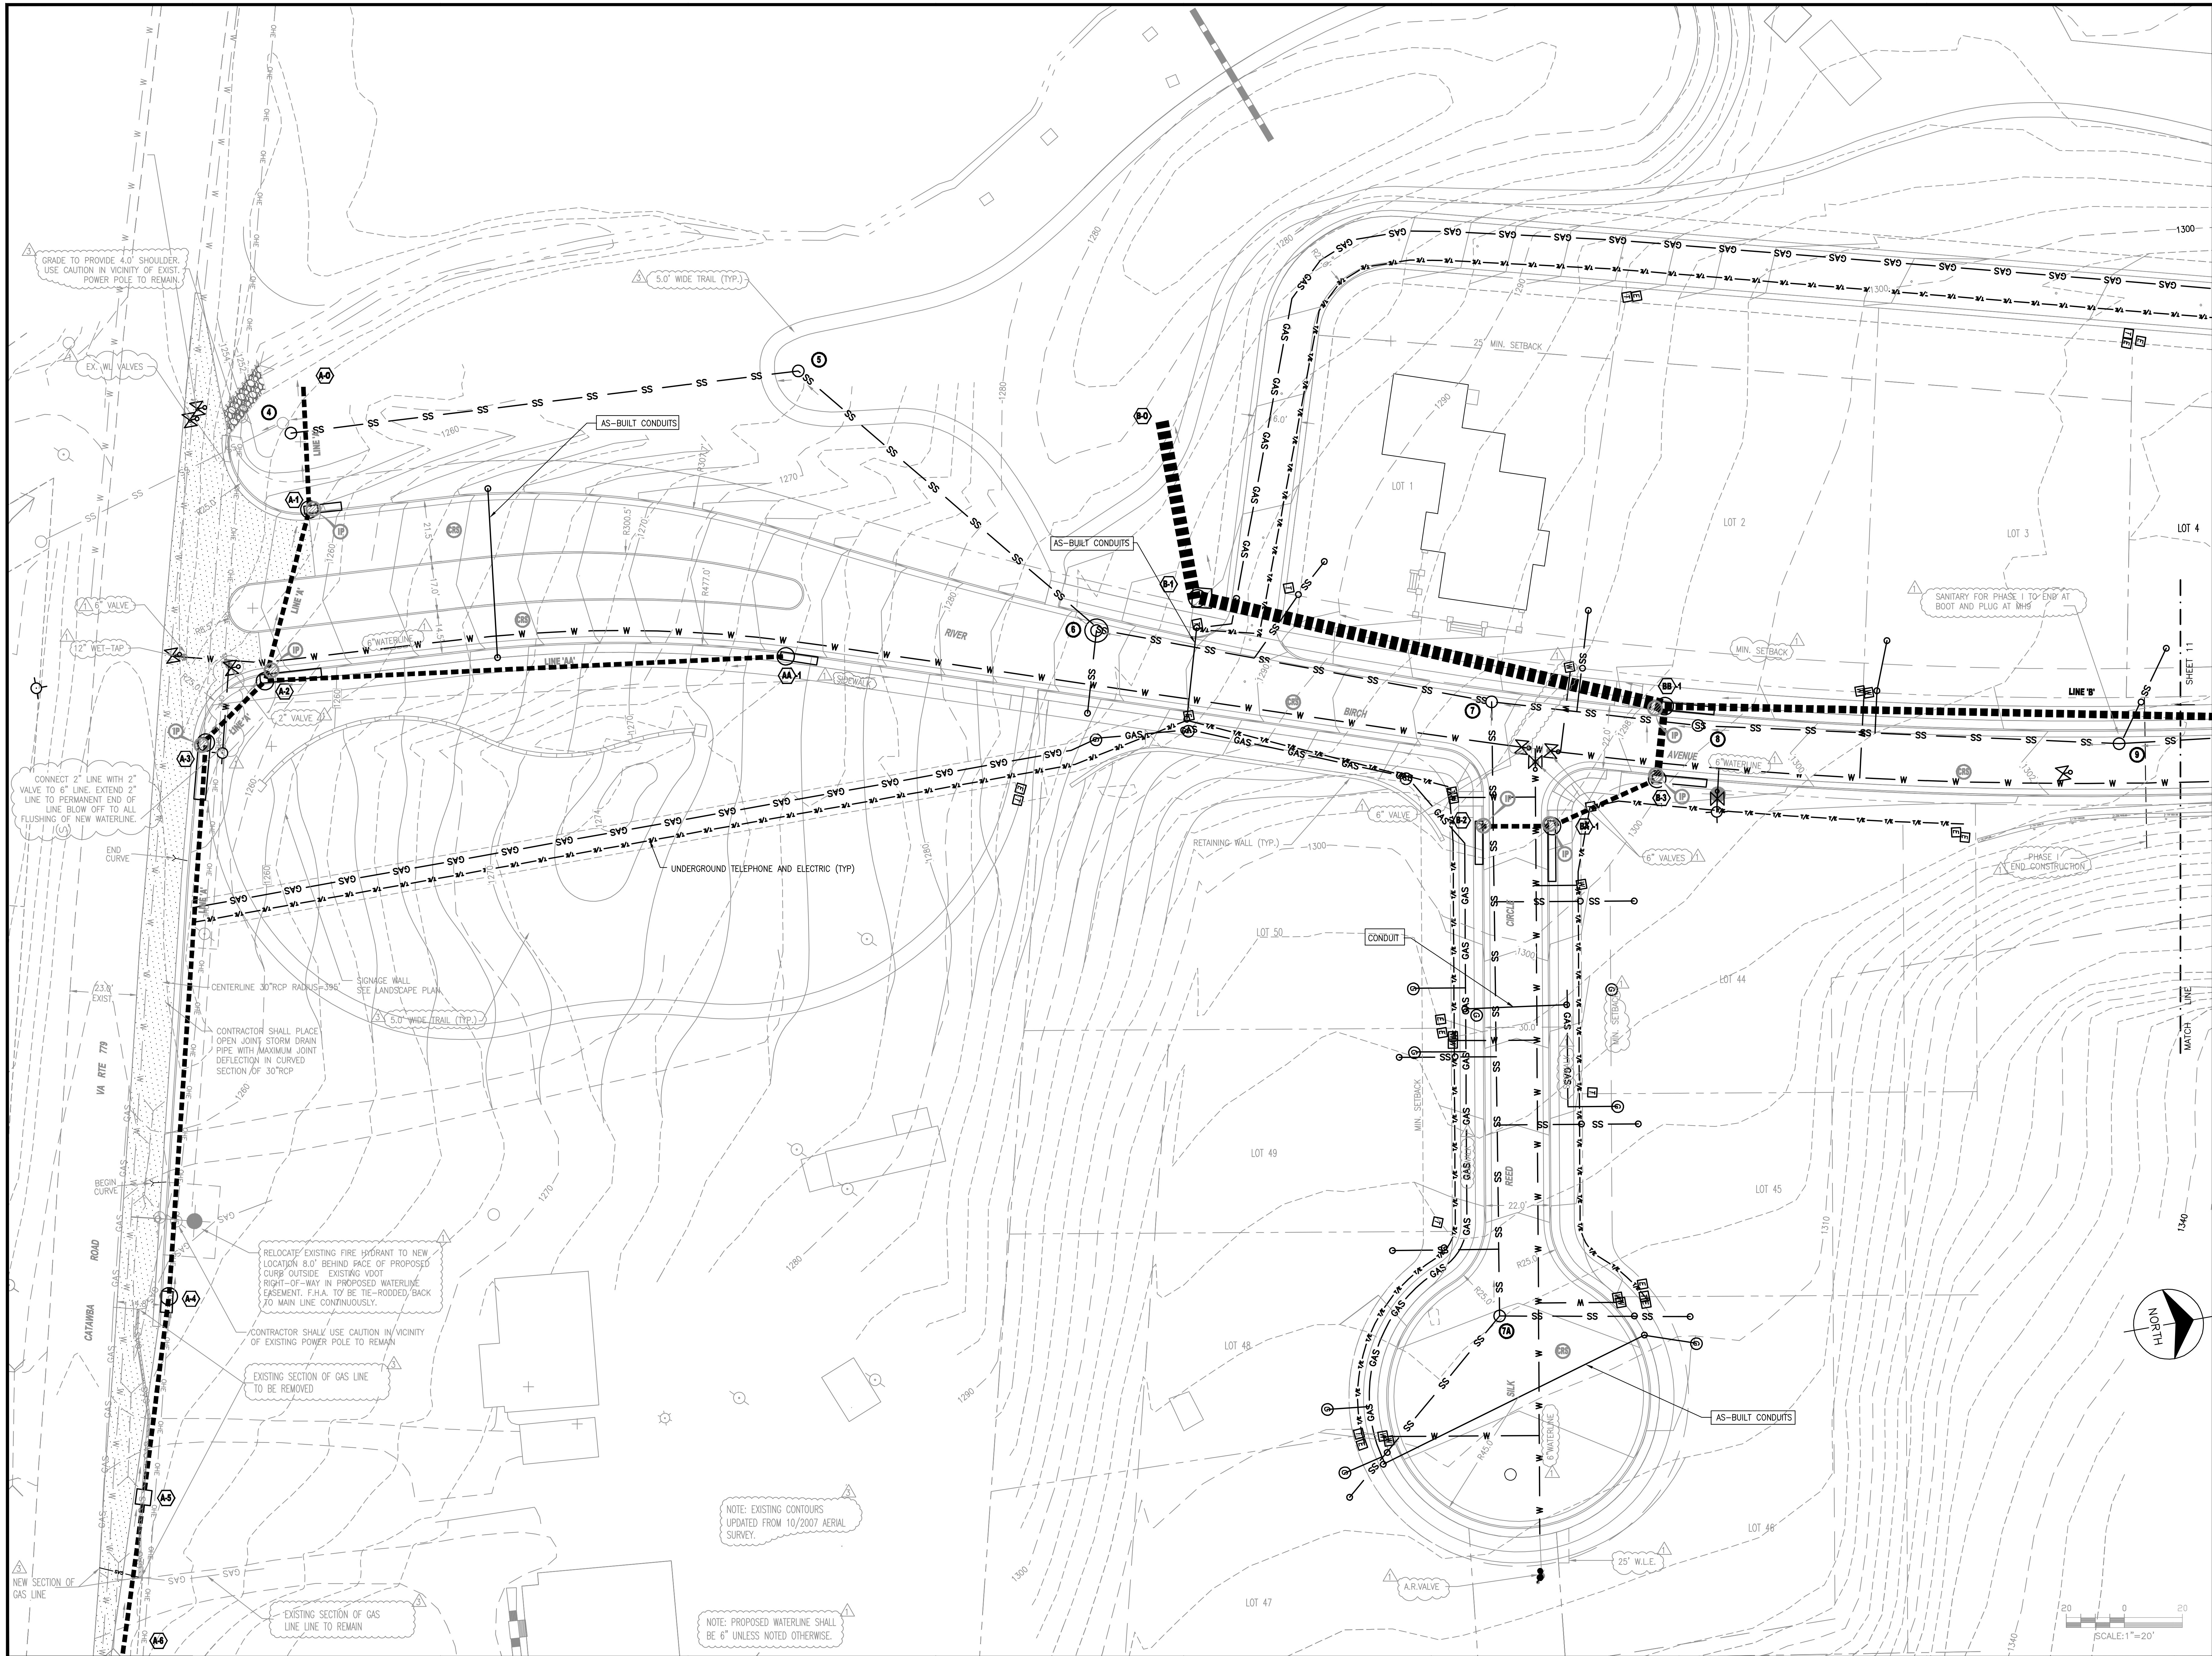

VARIOUS DEVELOPMENT REVISIONS  
VARIOUS COUNTY REVIEW COMMENTS

MSMJ  
MSMJ  
BY

07/08/08  
3/10/08  
DATE

MARK  
MARK  
REVISIONS

DATE 5/8/08  
PROJECT 03083  
DESIGNED RHW  
DRAWN MSMJ  
CHECKED RHW

ENGINEERING  
CONCEPTS, INC.  
"Creating Success"  
20 S. Riverside Street, PO Box 616  
Fayetteville, Virginia 22801  
540.473.1233 fax 540.473.1234



PROJECT FRALIN AND WALDRON  
DALEVILLE TOWN CENTER

DRAWING COMPREHENSIVE DEVELOPMENT PLAN

SHEET  
C-10