




NOTE: EXISTING CONTOURS
UPDATED FROM 10/2007 AERIAL
SURVEY.

NOTE: PROPOSED WATERLINE SHALL
BE 6" UNLESS NOTED OTHERWISE.

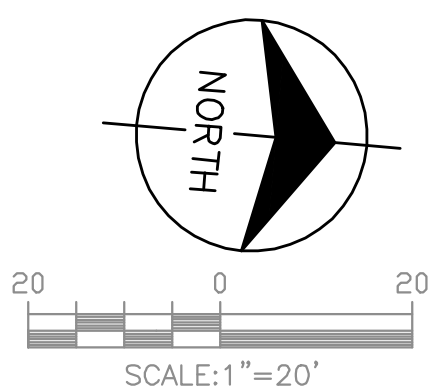

PROJECT FRALIN AND WALDRON
DALEVILLE TOWN CENTER

ENGINEERING
CONCEPTS, INC.
"Creating Success"

AS-BUILT

DRAWING COMPREHENSIVE DEVELOPMENT PLAN

DATE 5/8/08
PROJECT 03083
DESIGNED RHW
DRAWN MSMJ
CHECKED RHW

DATE 09/29/08
03/08/08
MARK DATE
BY MSMJ
REVISIONS

VARIOUS DESIGN DEVELOPMENT REVISIONS
VARIOUS COUNTY REVIEW COMMENTS
DESCRIPTION

SHEET

C-11