

COMMONWEALTH OF VIRGINIA
 BRADLEY C. CRAIG
 Lic. No. 023879
 PROFESSIONAL ENGINEER

Revisions	Date
1 VDOT COMMENTS	12/13/11
2 RECORD DRAWINGS	9/28/12

Issue Date: DECEMBER 4, 2011	Drawn By: ARB	Checked By: BCC
	Designed By: ARB	Date: 12/1/11

Mattern & Craig
CONSULTING ENGINEERS • SURVEYORS

701 FIRST STREET, S.W.
ROANOKE, VIRGINIA 24016
(540) 345-6342
FAX (540) 345-7691

CLOVERDALE WATERLINE EXTENSION
 COVER SHEET
 BOTE COURT COUNTY, VIRGINIA


Vertical Scale:
N/A

Horizontal Scale:
N/A

Commission Number:
3178

Sheet No.:

C-1

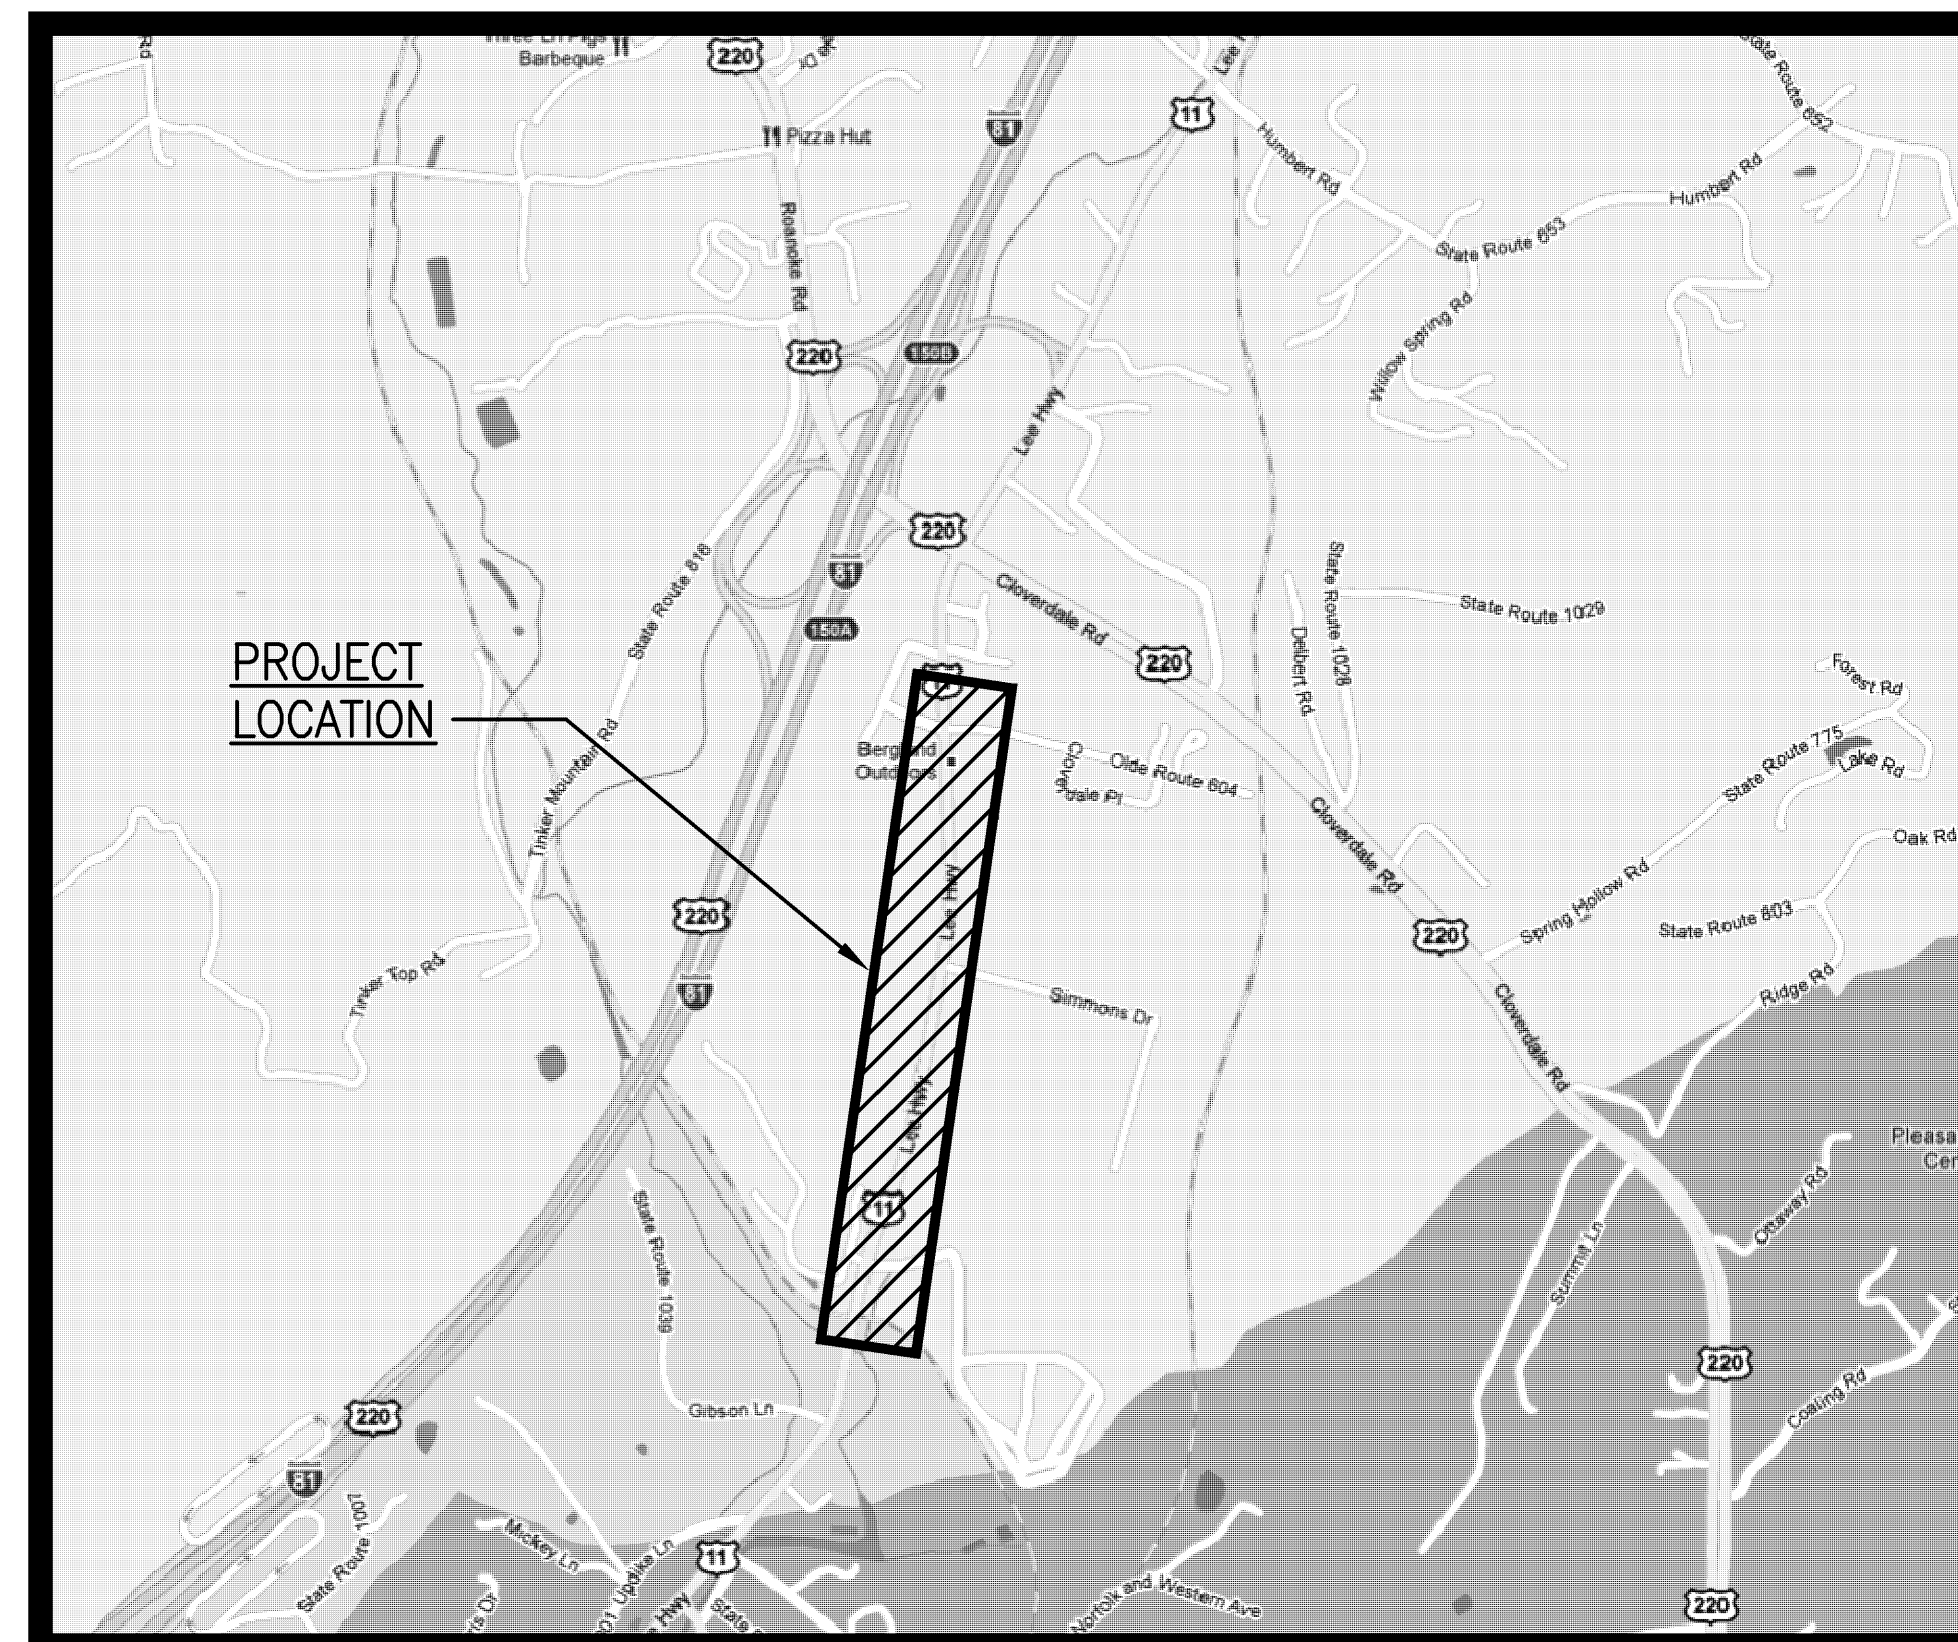

- C-1 COVER SHEET
- C-2 ABBREVIATIONS AND LEGEND
- C-3 SHEET INDEX, CONTROL DATA AND GENERAL NOTES
- C-4 PLAN AND PROFILE- 12" WATERLINE
- C-5 PLAN AND PROFILE- 12" WATERLINE
- C-6 PLAN AND PROFILE- 12" WATERLINE
- C-7 PLAN AND PROFILE- 12" WATERLINE
- C-8 PLAN AND PROFILE- 12" WATERLINE
- C-9 WATER DETAILS
- C-10 EROSION AND SEDIMENT CONTROL
NARRATIVE AND DETAILS
- C-11 EROSION AND SEDIMENT CONTROL DETAILS
- E-1 SITE PLAN AND SERVICE RACK DETAIL -
ELECTRICAL



COMM. NO. 3178

SET NO.