
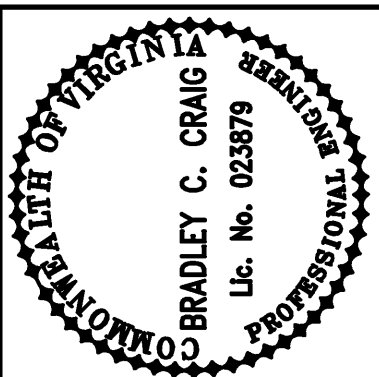


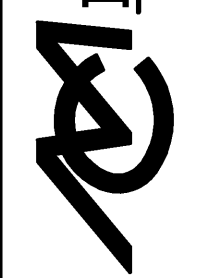

Revisions	Date
1 VDOT COMMENTS	12/13/11
2 RECORD DRAWINGS	9/28/12

Issue Date:	DECEMBER 4, 2011
Drawn By:	ARB
Designed By:	ARB
Checked By:	BCC
Date:	12/11/11

**Mattern & Craig**
CONSULTING ENGINEERS • SURVEYORS
701 FIRST STREET, S.W.
ROANOKE, VIRGINIA 24016
(540) 345-9342
FAX (540) 345-7891

CLOVERDALE WATERLINE EXTENSION

PLAN AND PROFILE- 12" WATERLINE

BOTEICOURT COUNTY, VIRGINIA

Vertical Scale:
1"= 10'

Horizontal Scale:
1"= 30'



Commission Number:
3178

Sheet No.:

C-6

VIRGINIA STATE PLANE - GRID NORTH
SOUTH ZONE (NAD 83/93)

SR INVESTMENTS, INC
INST. No. 110001622
P.B. 20, PG. 45
PARCEL No. 101-145

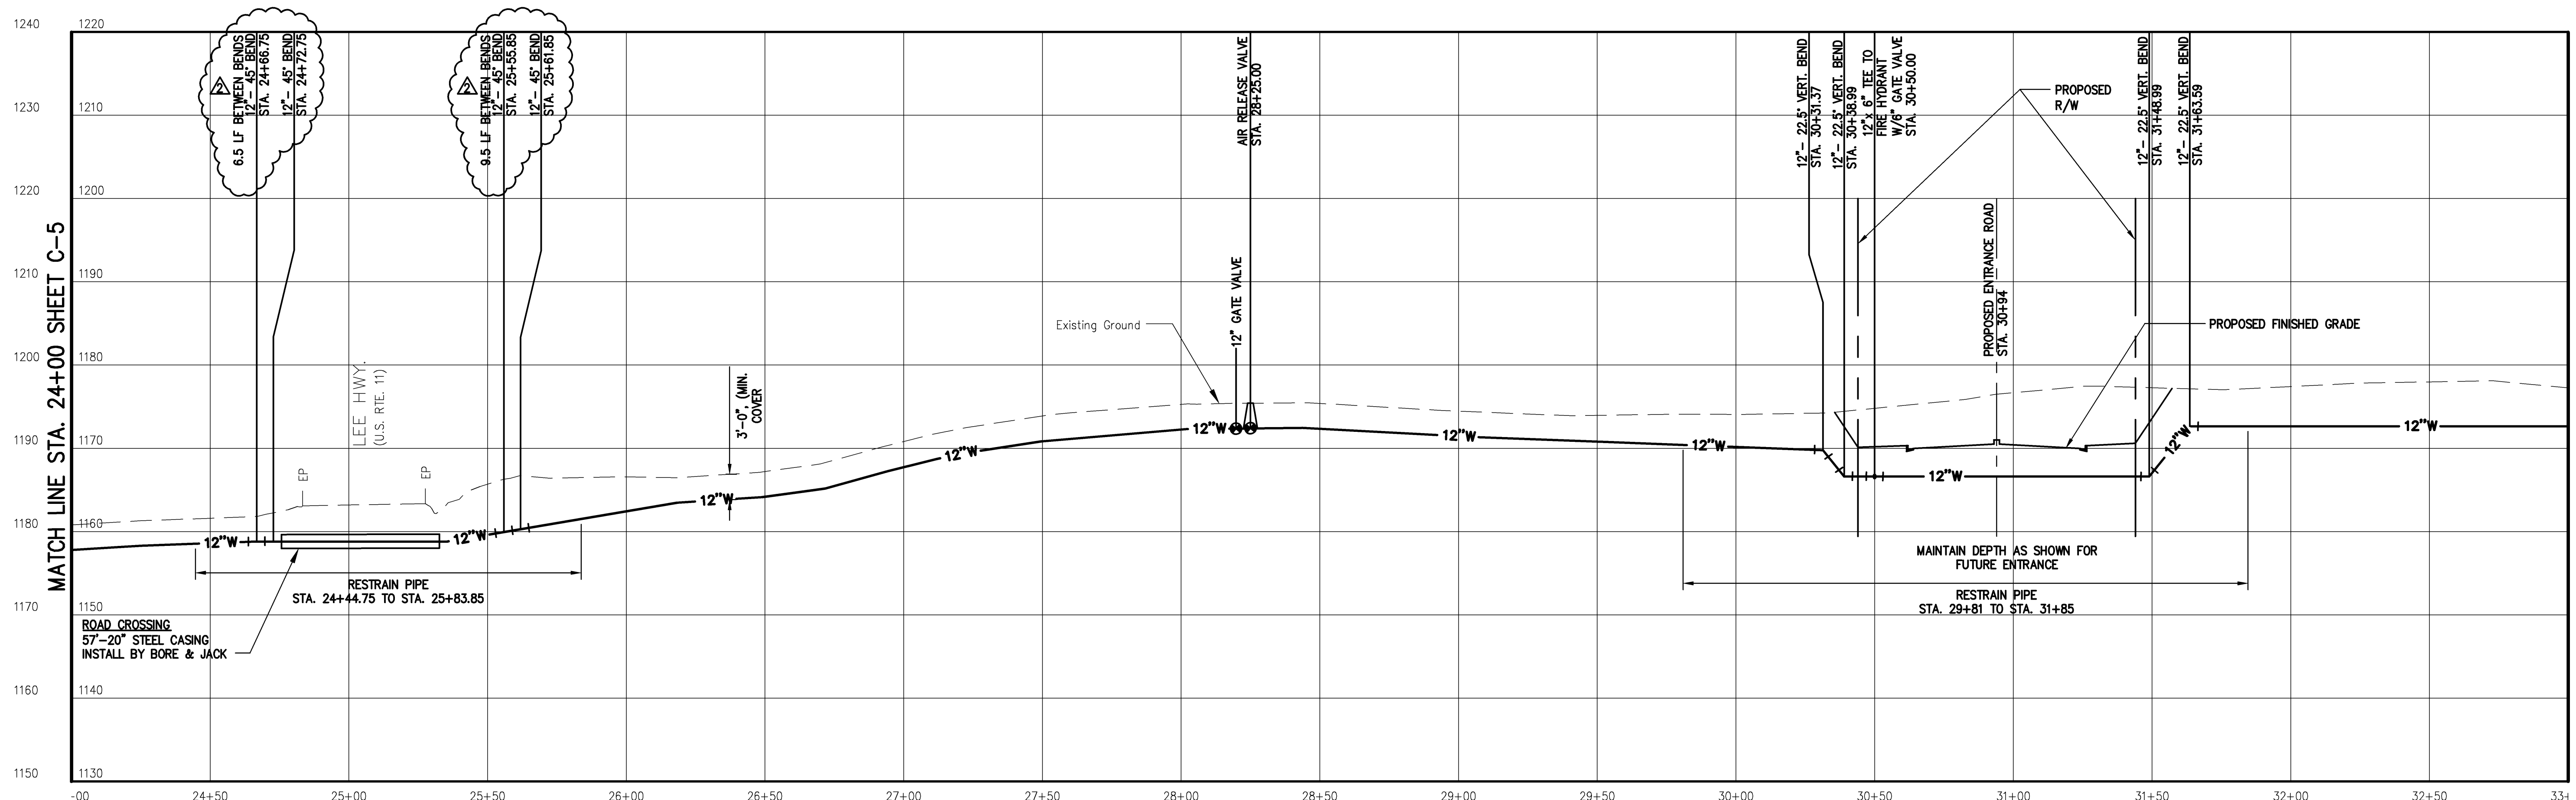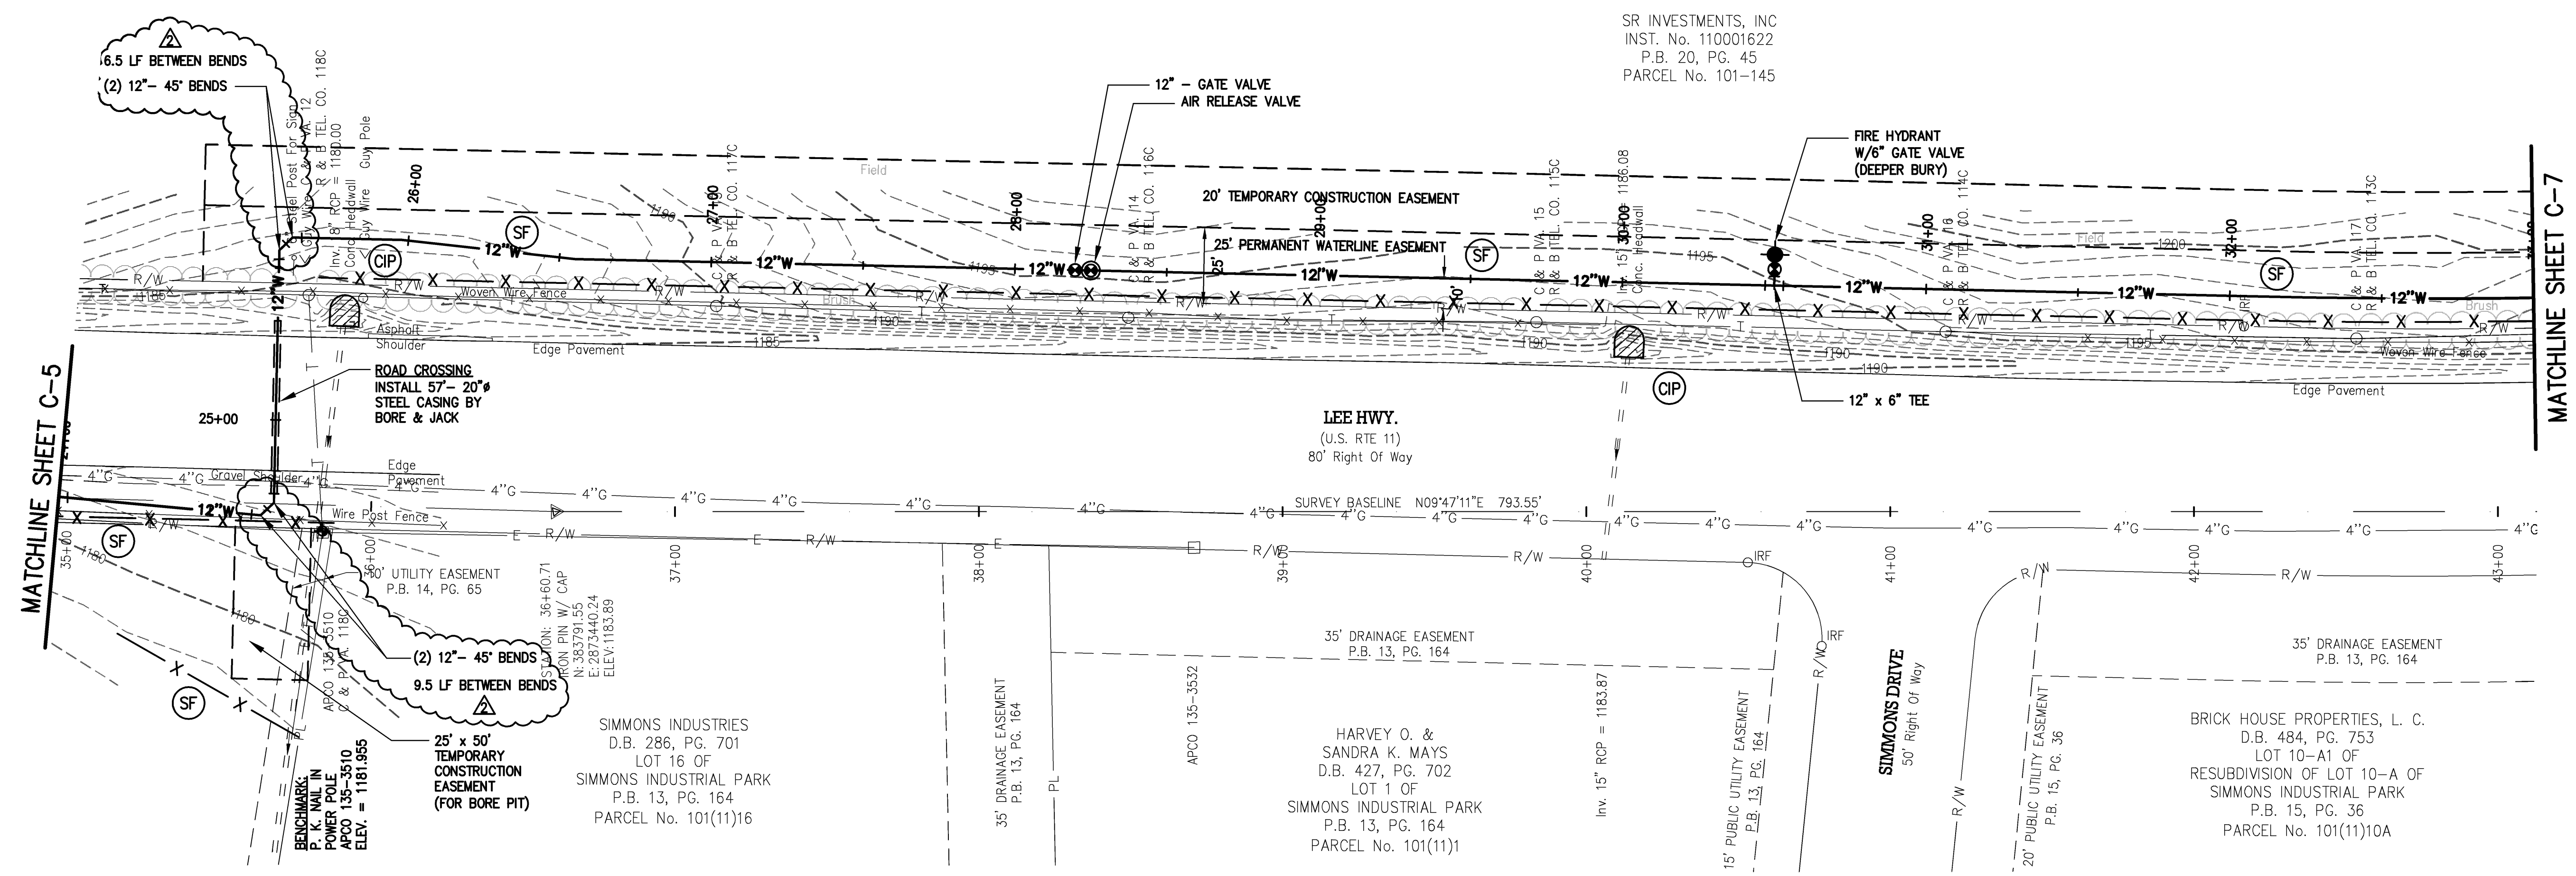

PROFILE- 12" WATERLINE

RECORD DRAWING