

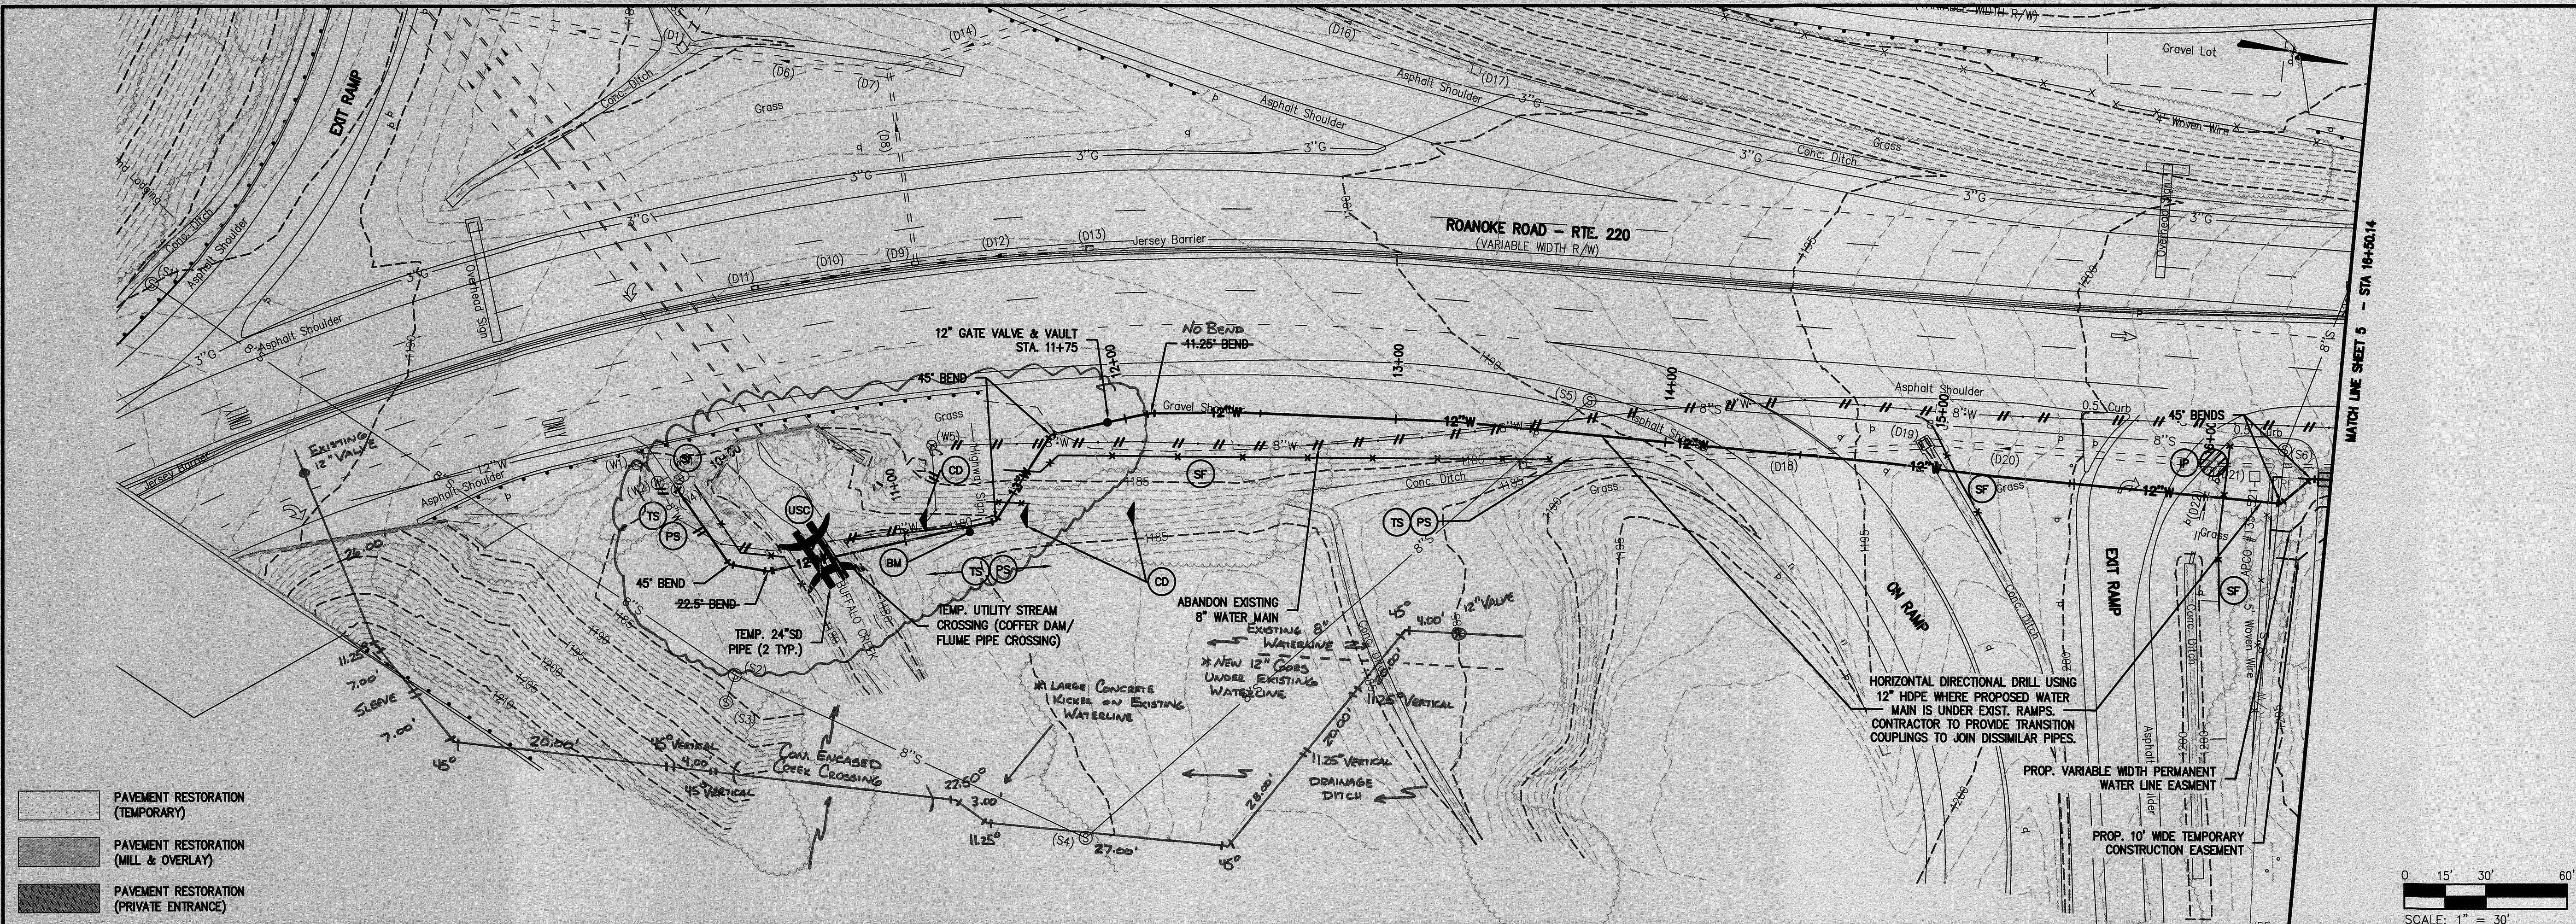


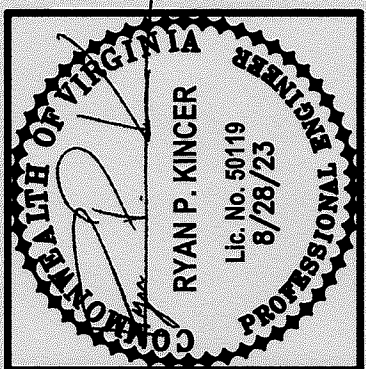

PROP 12" WL PROFILE

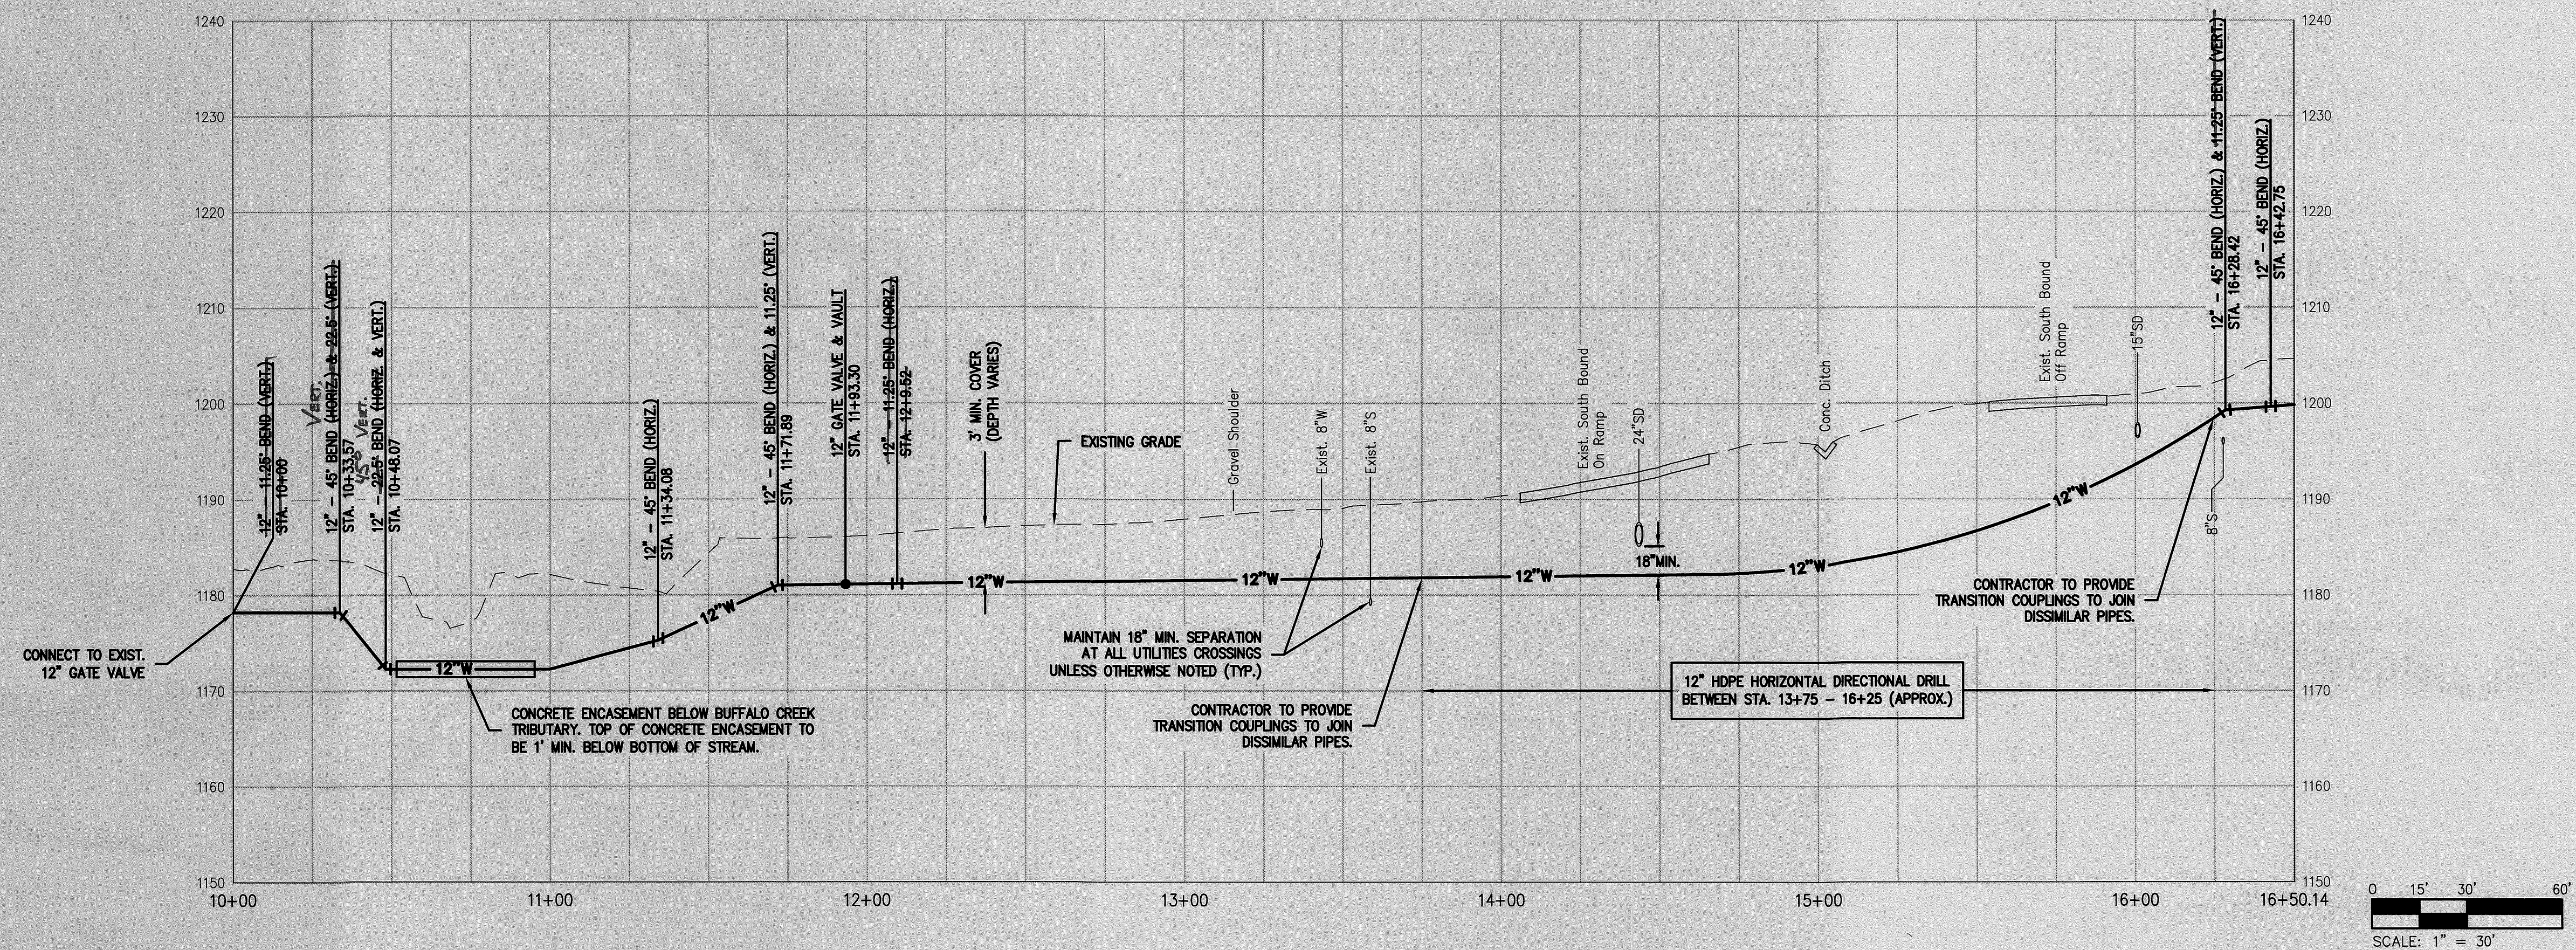

Revisions	Date

Issue Date:	AUG. 28, 2023
Drawn By:	BAO
Designed By:	RPK
Checked By:	RPK
Date:	8/28/2023

Mattern & Craig
ENGINEERS-SURVEYORS
701 FIRST STREET, S.W.
ROANOKE, VA 24004
FAX (540) 346-7691

EXIT 150 WATERLINE REPLACEMENT
PLAN & PROFILE
BOTETOURT COUNTY, VIRGINIA

Vertical Scale:
1"=10'

Horizontal Scale:
1"=30'

Commission Number:
4230A

Sheet No.:
4