
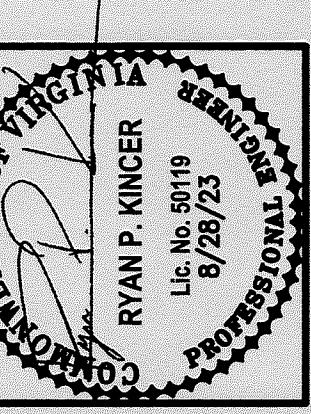


PROP 16" WL PROFILE

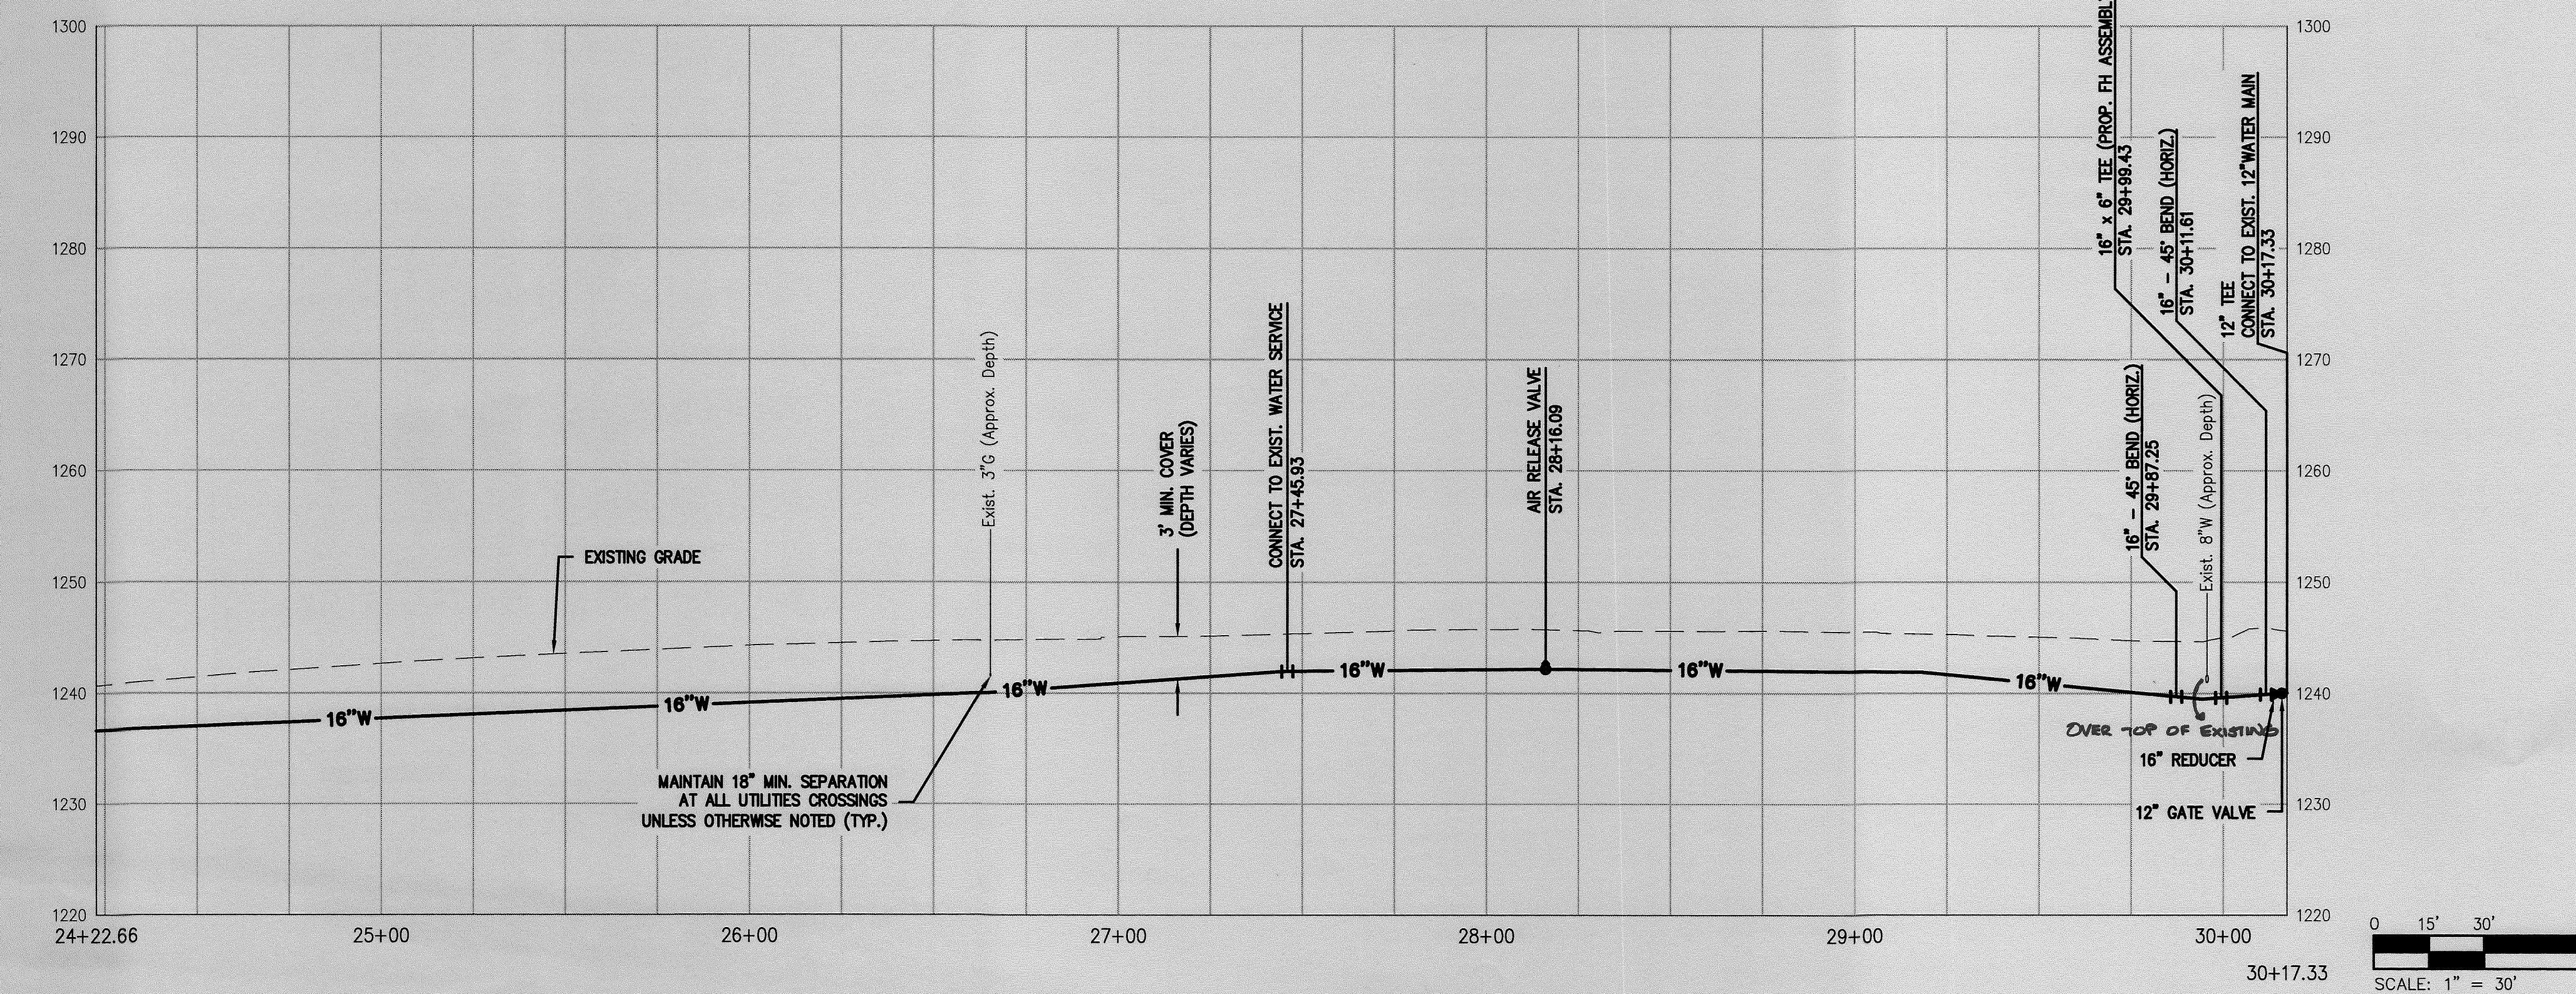

AUG. 28, 2023		
Drawn By:	BAD	
Designed By:	RPK	
Checked By:	RPK	
Date:	8/28/2023	

PLAN & PROFILE

Exit 150 WAVERLINE REPLACEMENT
BOTETOURT COUNTY, VIRGINIA

Vertical Scale:
1"=10'

Horizontal Scale:
1"=30'

Commission Number:
4230A

Street No.: 6