

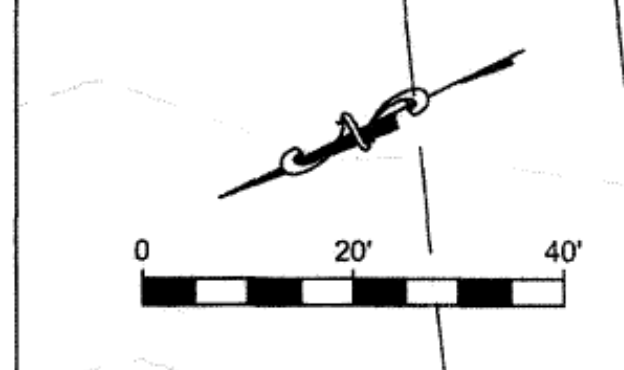


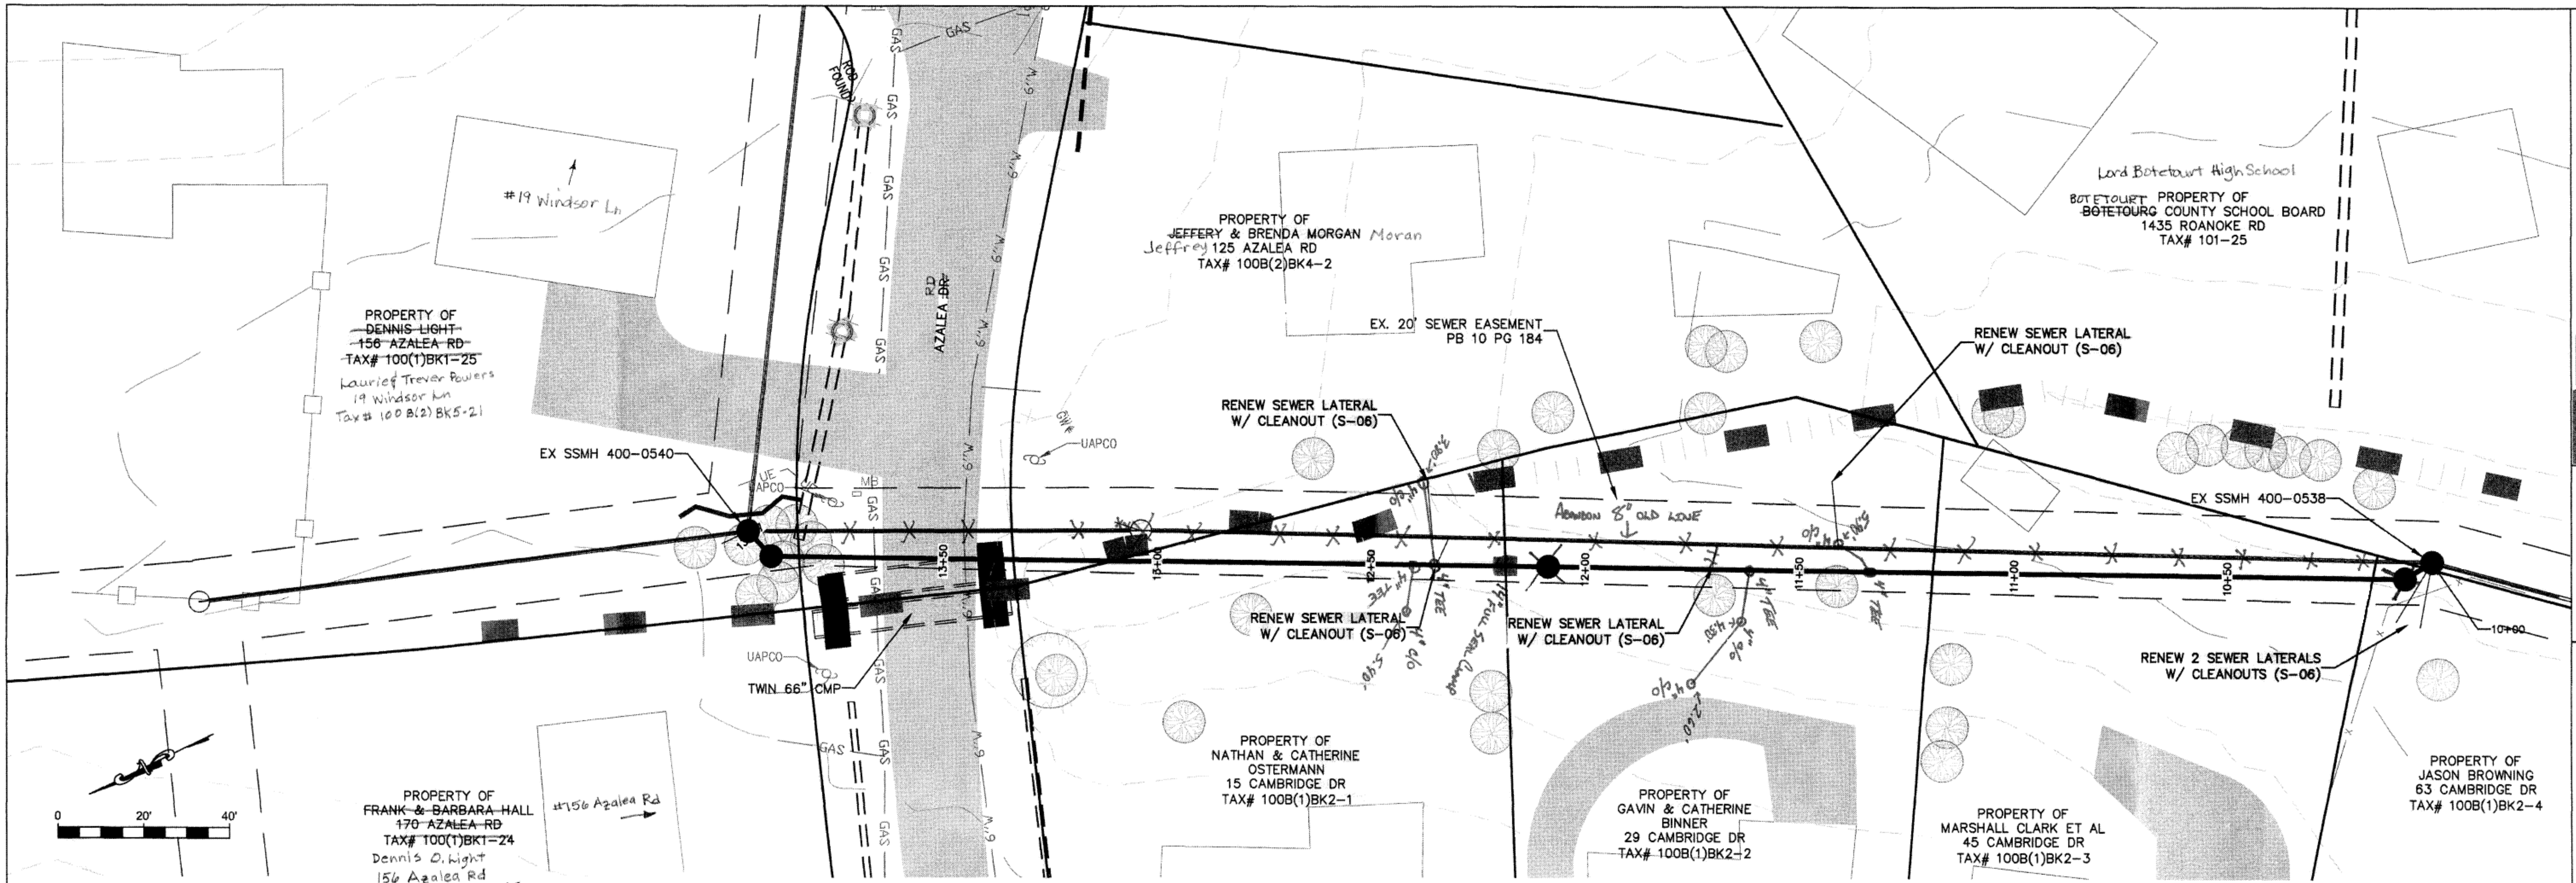

400-0540
STA 13+96.8
INVin = 1202.85 (FROM 400-0541)
INVin = 1198.66 (FROM 400-1641)
(ABANDON) INVout = 1198.66 (TO 400-0539)
INVout = 1198.00 (TO 400-1997)
TOP = 1210.56

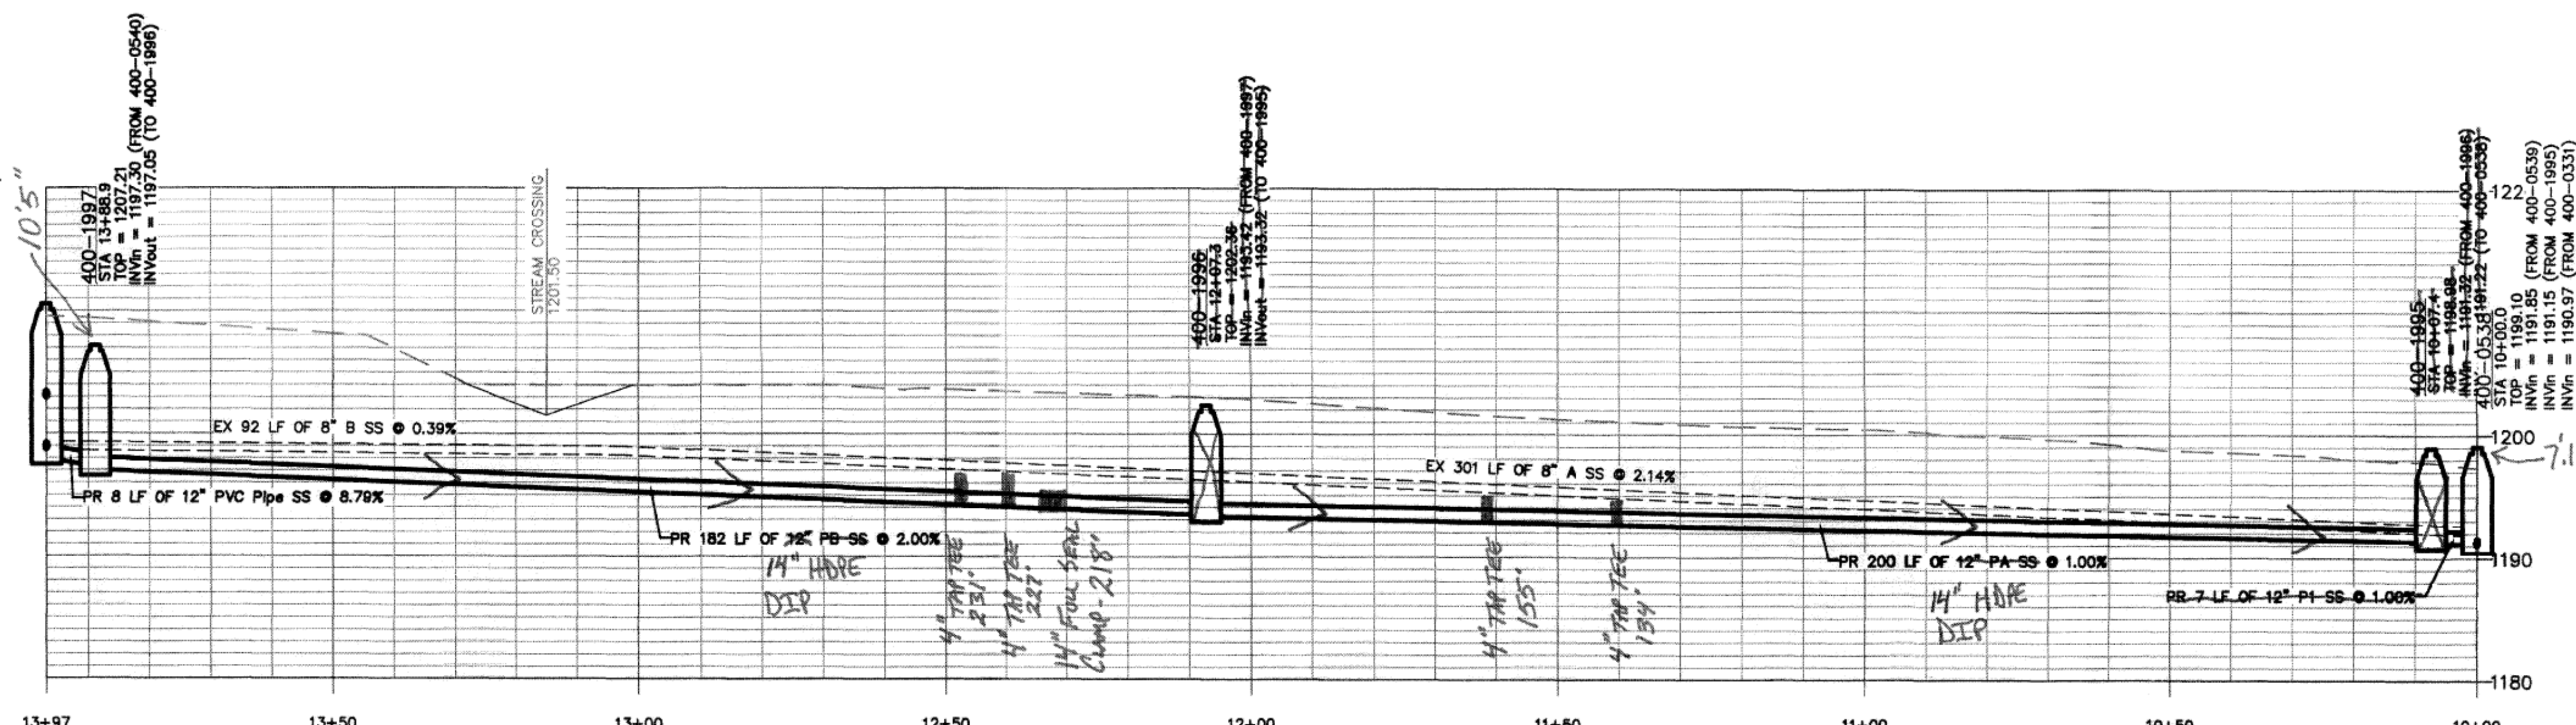

SEWERLINE "A"
SCALE
VERTICAL: 1" = 10'
HORIZONTAL: 1" = 20'

Sewer Replacement
Directional Drill
Installed 14" HDPE Ductile Iron Pipe
Toft Beasley - Field Supt
As-Built 09/05/2019
Botetourt County

WESTERN VIRGINIA

WATER AUTHORITY

ENGINEERING SERVICES
601 S JEFFERSON ST, SUITE 300
ROANOKE, VA 24011
540-853-5700

AZALEA SEWER PLAN &
PROFILE

PLAN & PROFILE

Rev	Description	Date	By
	REVISED TOPS AND INV.	11/30/18	

Designed: AAS

Drawn: AAS

Checked:

Approved:

Date: 11/27/18

Project: SCIP-509

1

Sheet 1 of 1