



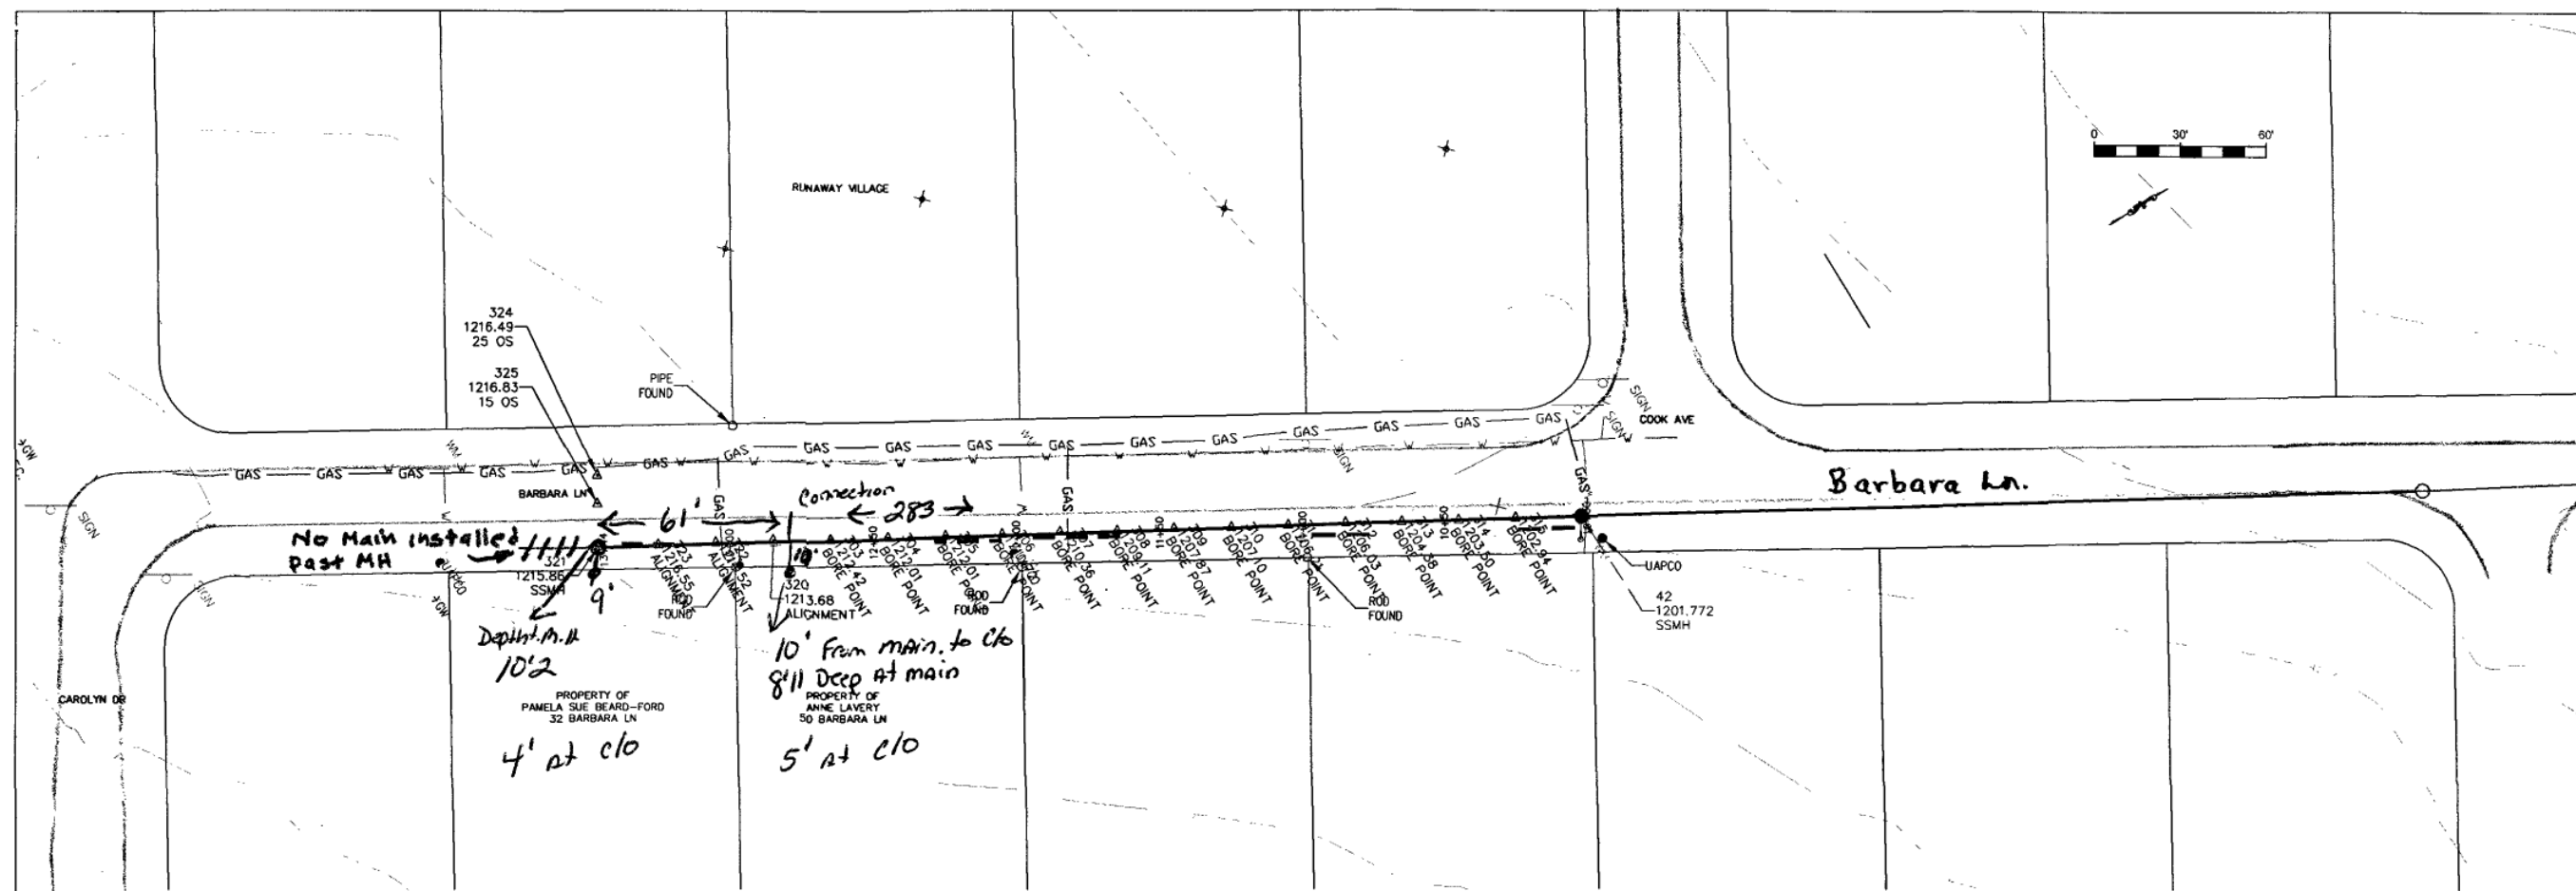

32 BARBARA LN
4" Come's out of New m.H.
Sch 40 3'8" at m.H. 4' at O/O
9' from m.H. to O/O
HAS A inside Drop
4" sch 40 PIPE

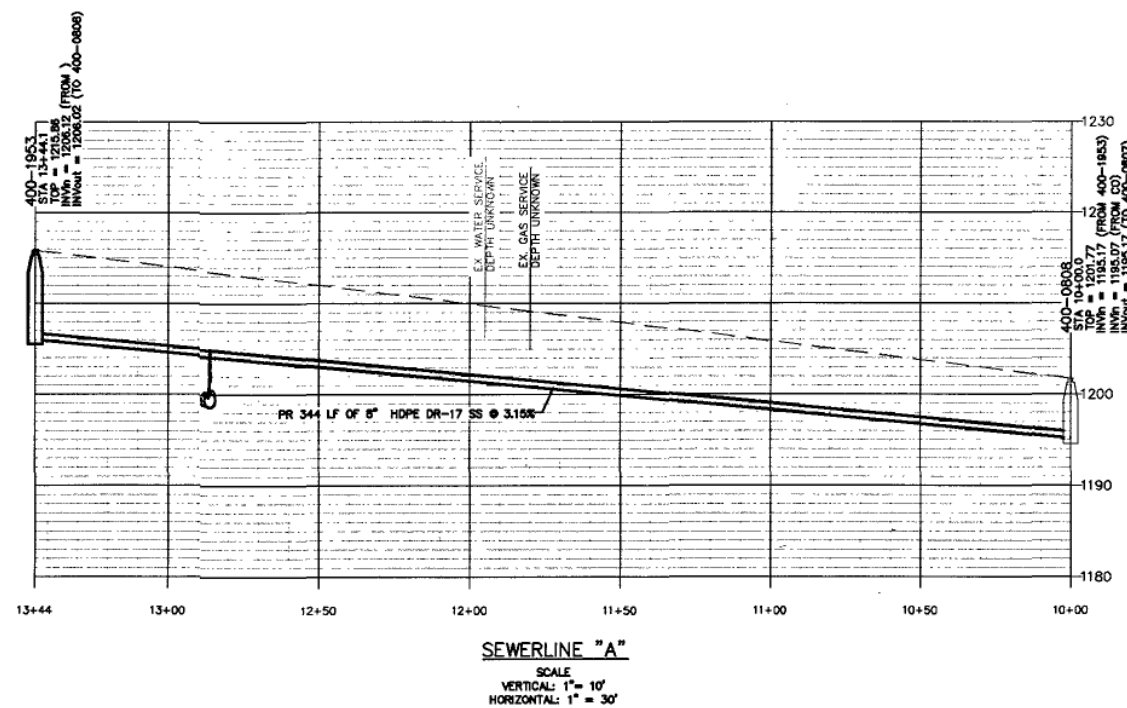

4" Sch 40

50 BARBER LN.

Lateral Connection

283' From Existing m.H.

61' from NEW m.H.

10' 0" from main to clo 5' depth

4" Connection is 8' 11" Deep

BARBARA LANE
BOTETOURT COUNTY, VIRGINIA
INSTALLED BY: Western Virginia Water Authority
Field Operations
Donnie Rowen Crew
As-Built 11/23/2016