


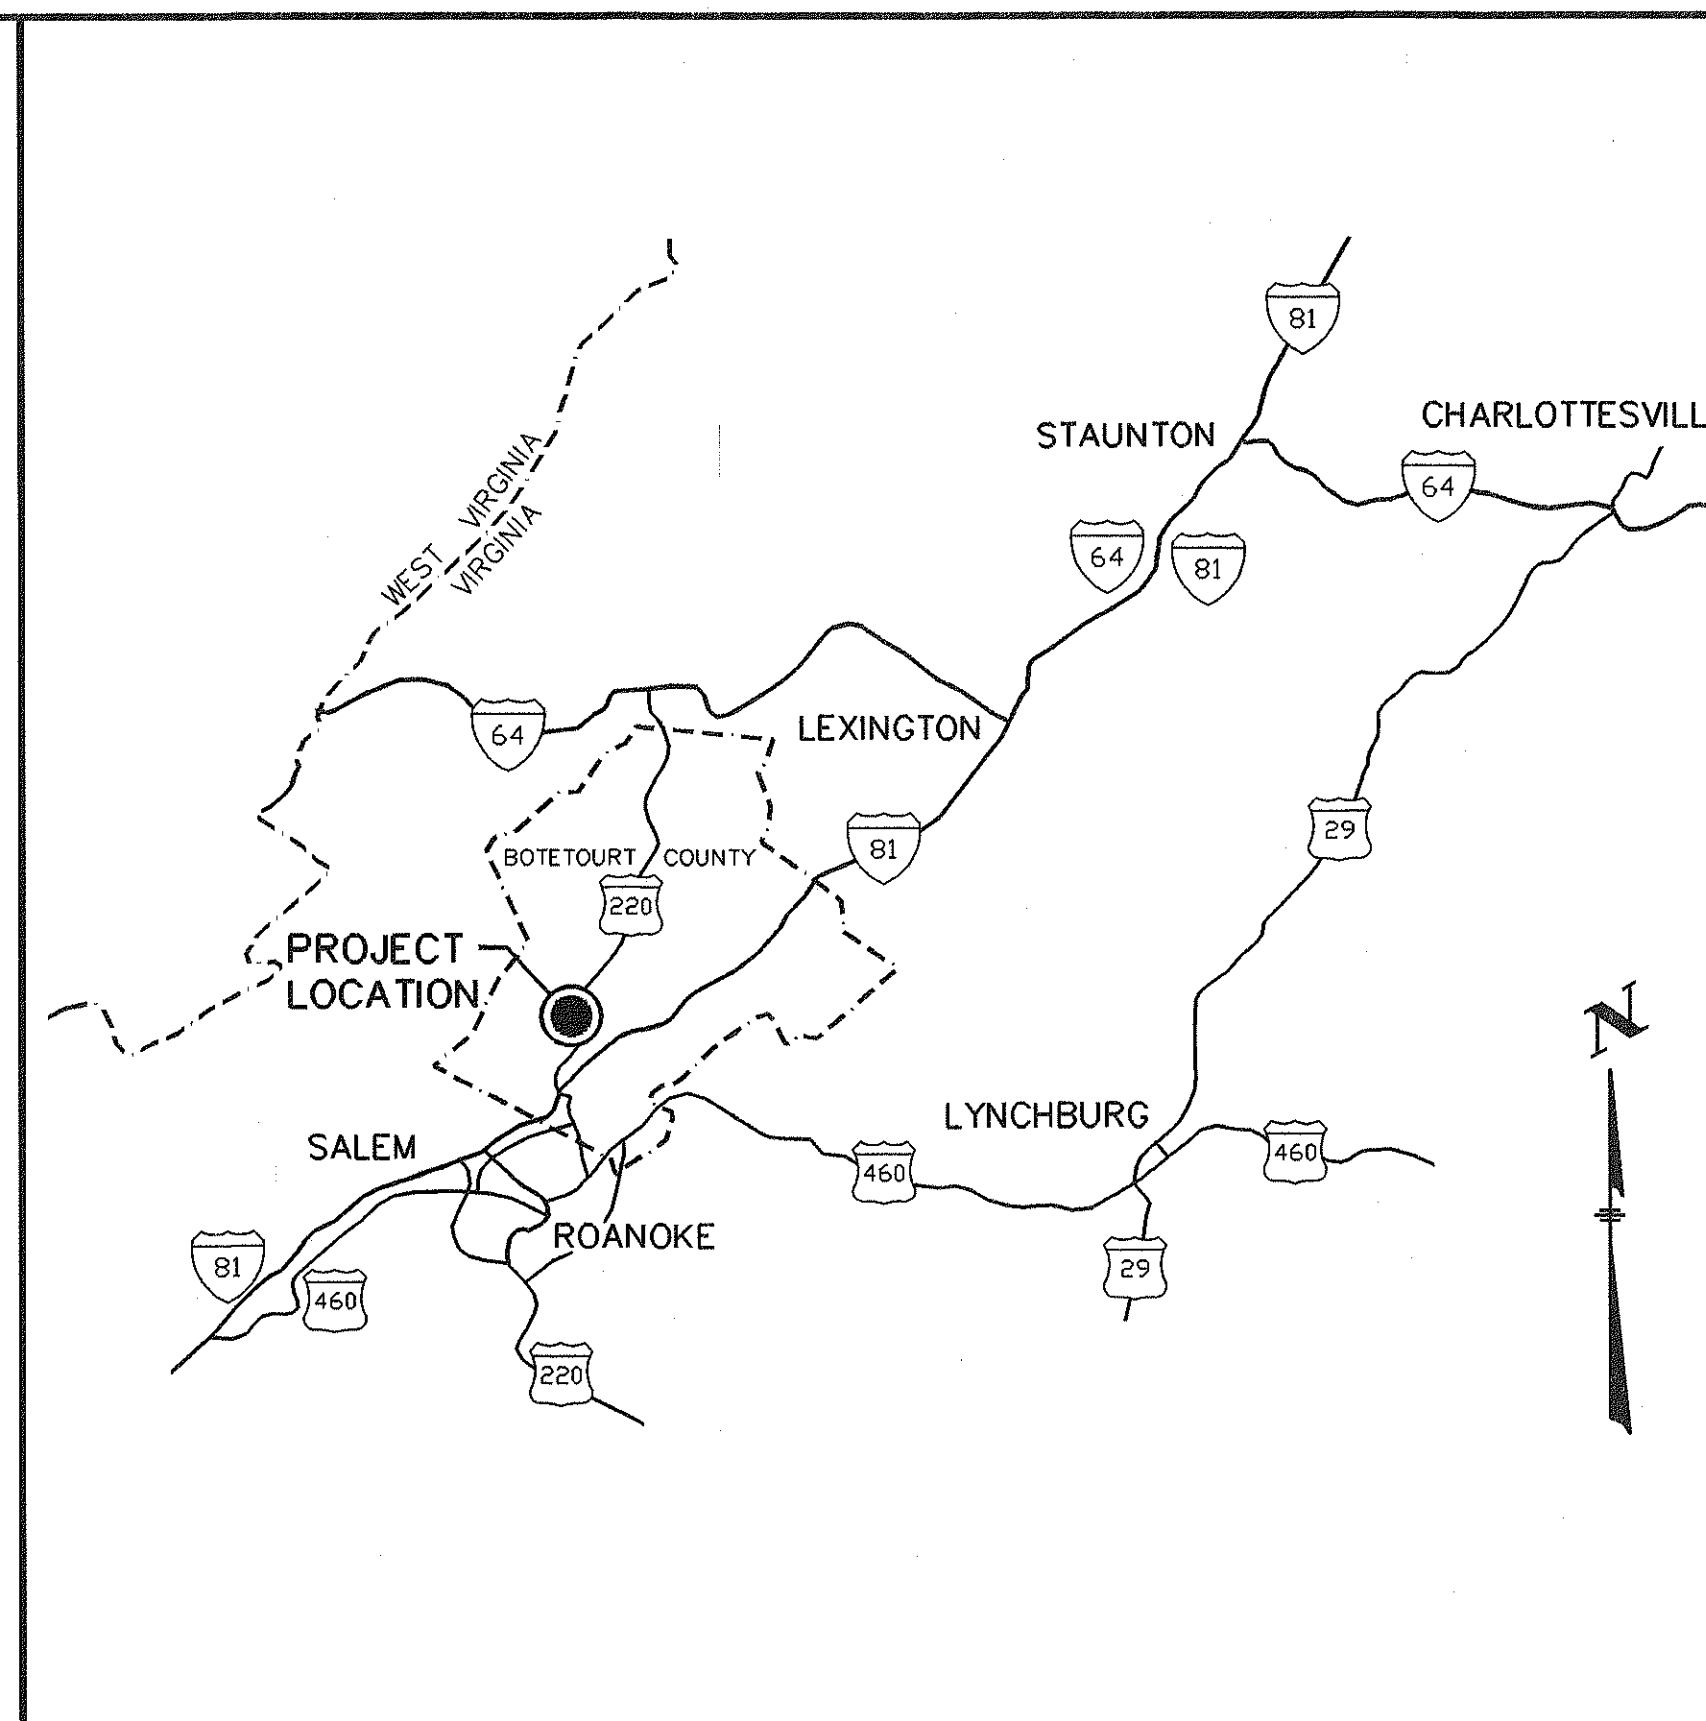


VICINITY MAP
NO SCALE

RECORD DRAWINGS U.S. 220 WATER MAIN BOTETOURT COUNTY, VIRGINIA

FINKBEINER, PETTIS AND STROUT, INC.
ROANOKE, VIRGINIA

1995

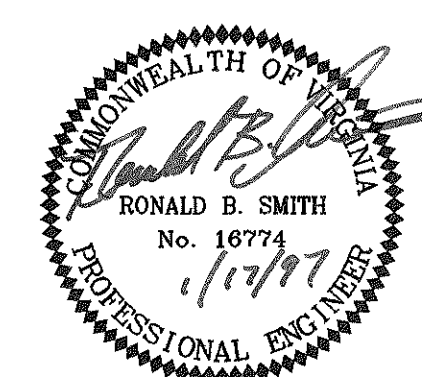

CONTRACTOR : DIXON CONTRACTING, INC.
P.O. BOX 108
FINCASTLE, VA. 24090

SUB-CONTRACTOR : S. R. DRAPER CO. INC.
(PAVING) 4742 OLD ROCKY MOUNT RD.
ROANOKE, VA. 24014

RESIDENT PROJECT REPRESENTATIVE: E. L. PADERICK
BOTETOURT COUNTY

MATERIALS

DUCTILE IRON PIPE:

DUCTILE IRON FITTINGS:

VALVES:

HYDRANTS:

BLOW-OFF HYDRANTS:

STEEL ENCASEMENT PIPE:

RESTRAINED JOINTS:

PIPE ENCASEMENT SPACERS:

MANHOLE FRAME & COVERS

3" COMPOUND METER VAULT:

3" COMPOUND METER:

METER VAULT VALVES:

SUPPLIERS

TYTON JOINTY CLASS 52
by UNION FOUNDRY CO.
P.O. BOX 309
ANNISTON, ALA. 36202

COMPACT MECHANICAL JOINT
by UNION FOUNDRY CO.
P.O. BOX 309
ANNISTON, ALA. 36202

RESILENT WEDGE GATE VALVES-OPEN LEFT
by MUELLER CO.

SUPER CENTURION 200
by MUELLER CO.

NO. 78
by KUPFERLE FOUNDRY CO.

24" x 0.375" STEEL WALL-CR.B
by EMPIRE PIPE AND SUPPLY CO.
2301 ALTON RD.
BIRMINGHAM, ALA. 35210

MEGALUG
by EBBA IRON SALES, INC.
P.O. BOX 857
EASTLAND, TX. 76448

BORE PIPE SUPPORTS
by COLLINS UNDERGROUND CONST.
RT. 1 BOX 265
WESTFIELD, NC. 27053


MH-3000
by CAPITAL FOUNDRY of VA., INC.
2856 CRUSADER CIRCLE
VIRGINIA BEACH, VA. 23456

by THE CLEAR FLOW CO.
1321 N. DELPHINE AVE.
WAYNESBORO, VA. 22980


by SENSUS TECHNOLOGIES, INC.
P.O. BOX 487
UNIONTOWN, PA. 15401

by AMERICAN DARLING

EXISTING STRUCTURES


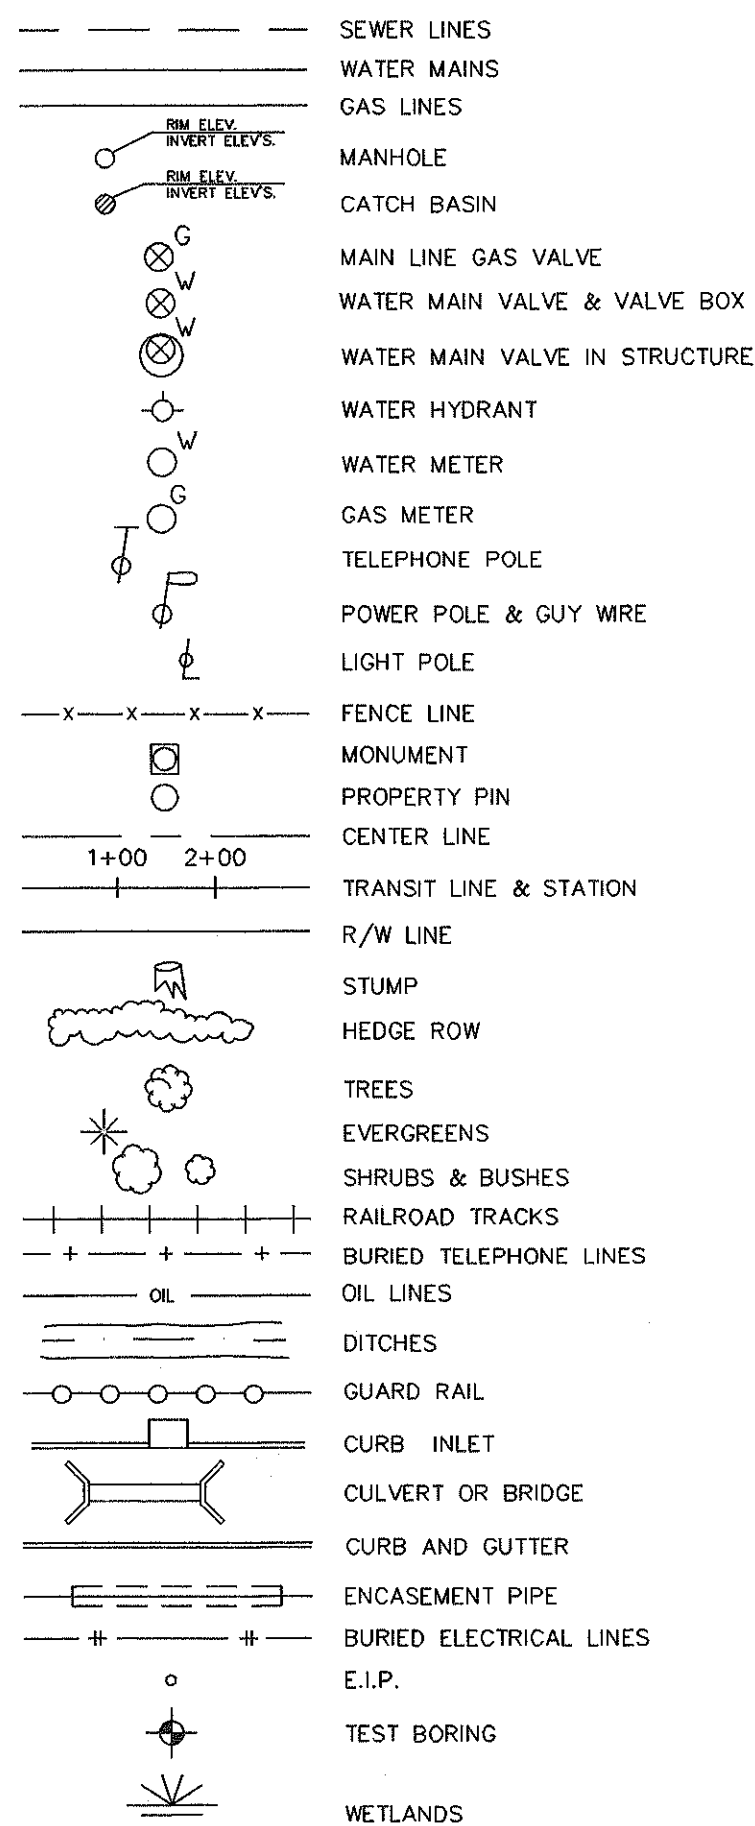


PROPOSED STRUCTURES

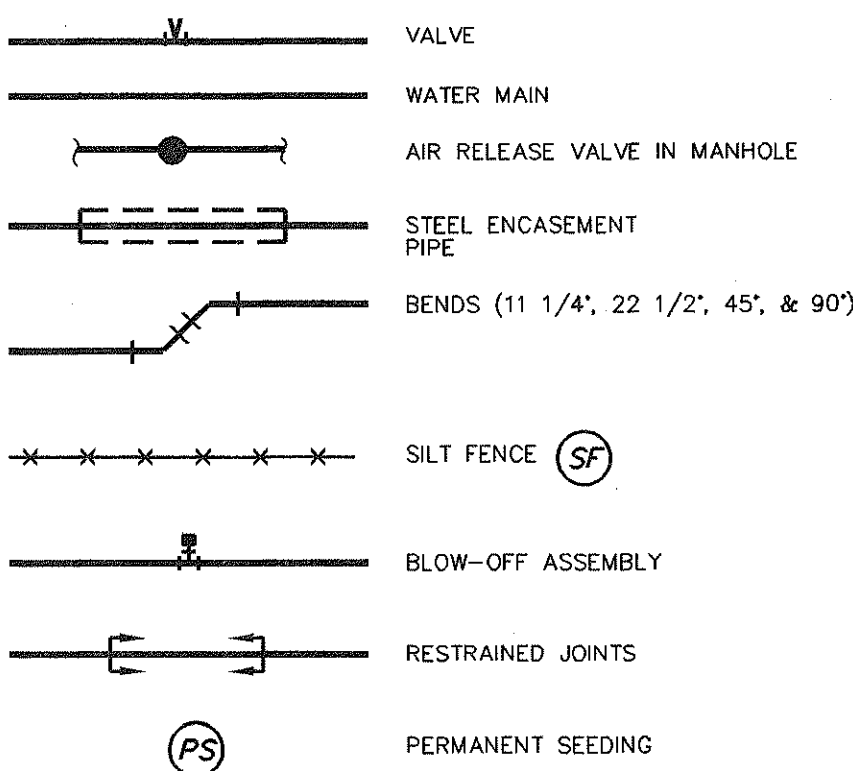

UTILITY CONTACTS

- MISS UTILITY OF VIRGINIA
1-800-552-7001
- ROANOKE GAS COMPANY
3025 TINKER MOUNTAIN ROAD,
DALEVILLE, VA. 24083
(703) 992-3981
ATTN: MR. JOHN C. BLAKE
- APCO
P.O. BOX 2021
ROANOKE, VA. 24022
(703) 427-3773
ATTN: MR. EDDIE GLOVER
- BELL ATLANTIC
4843 OAKLAND BLVD. NE.
ROANOKE, VA. 24012
(703) 982-4937
ATTN: MR. D.C. YOUNG
- DALEVILLE WATER COMPANY
ROUTE 1, BOX 581
DALEVILLE, VA. 24083
(703) 992-1109
ATTN: MR. B. WILLIS HOPKINS
- TINKERVIEW WATER COMPANY
P.O. BOX 428
TROUTVILLE, VA. 24175
ATTN: MRS. NANCY FIRESTONE
CONTACT: MR. STEVE ROSSI
(703) 342-6600
- ROANOKE & BOTETOURT TELEPHONE COMPANY
1000 ROANOKE RD.
DALEVILLE, VA. 24083
(703) 992-2211
ATTN: MR. TOM ORR

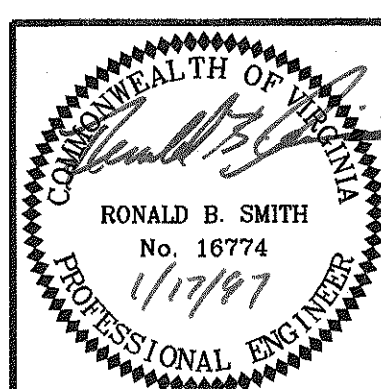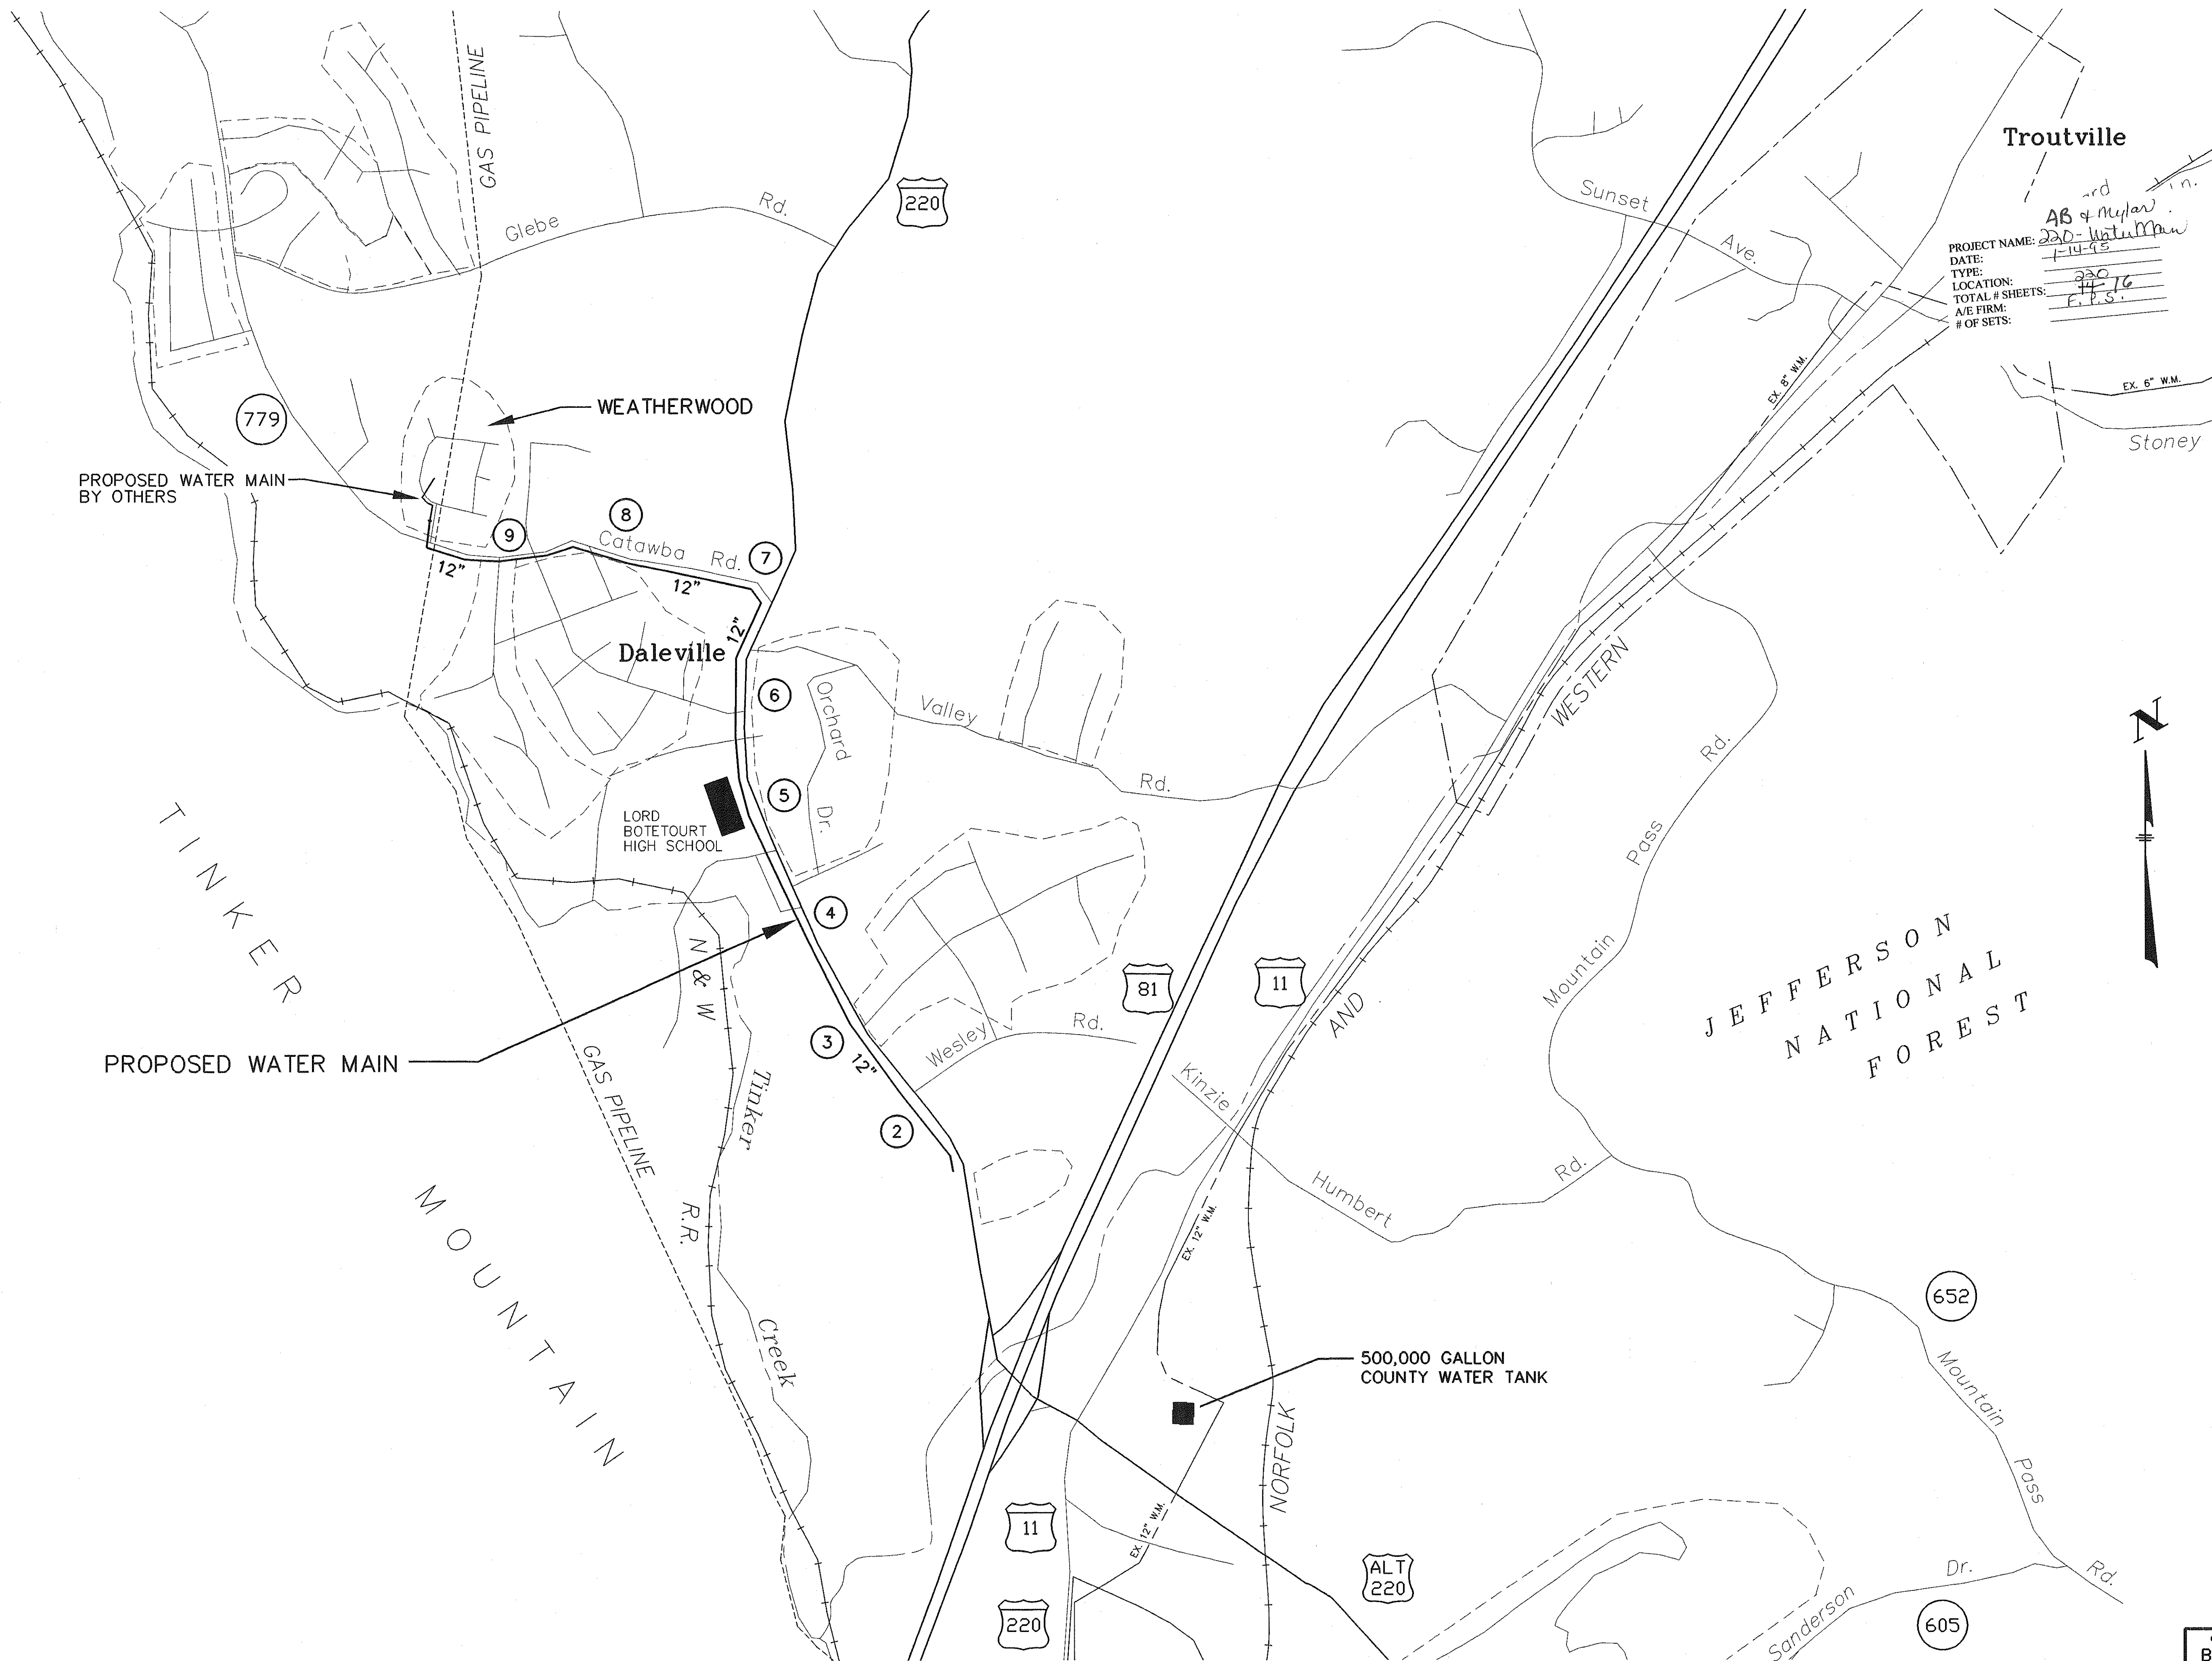




REV. NO.	DESCRIPTION	DATE	BY	APP'D
1	RECORD DRAWING	6-26-96	A.D.C.	R.B.S.

FINKBEINER, PETTIS & STROUT, INC.
CONSULTING ENGINEERS
ROANOKE, VIRGINIA


SCALE
1"=800'
DESIGNED BY
R.B.S.
DRAWN BY
S.R.P.
CHECKED BY
S.A.L./G.G.A.

LOCATION MAP
U.S. 220 WATER MAIN
BOTETOURT COUNTY, VIRGINIA


CAD NUMBER BOTUWLOC
PROJECT NUMBER BOTW 502 B
CONTRACT
DATE 1-14-95
1 OF 14

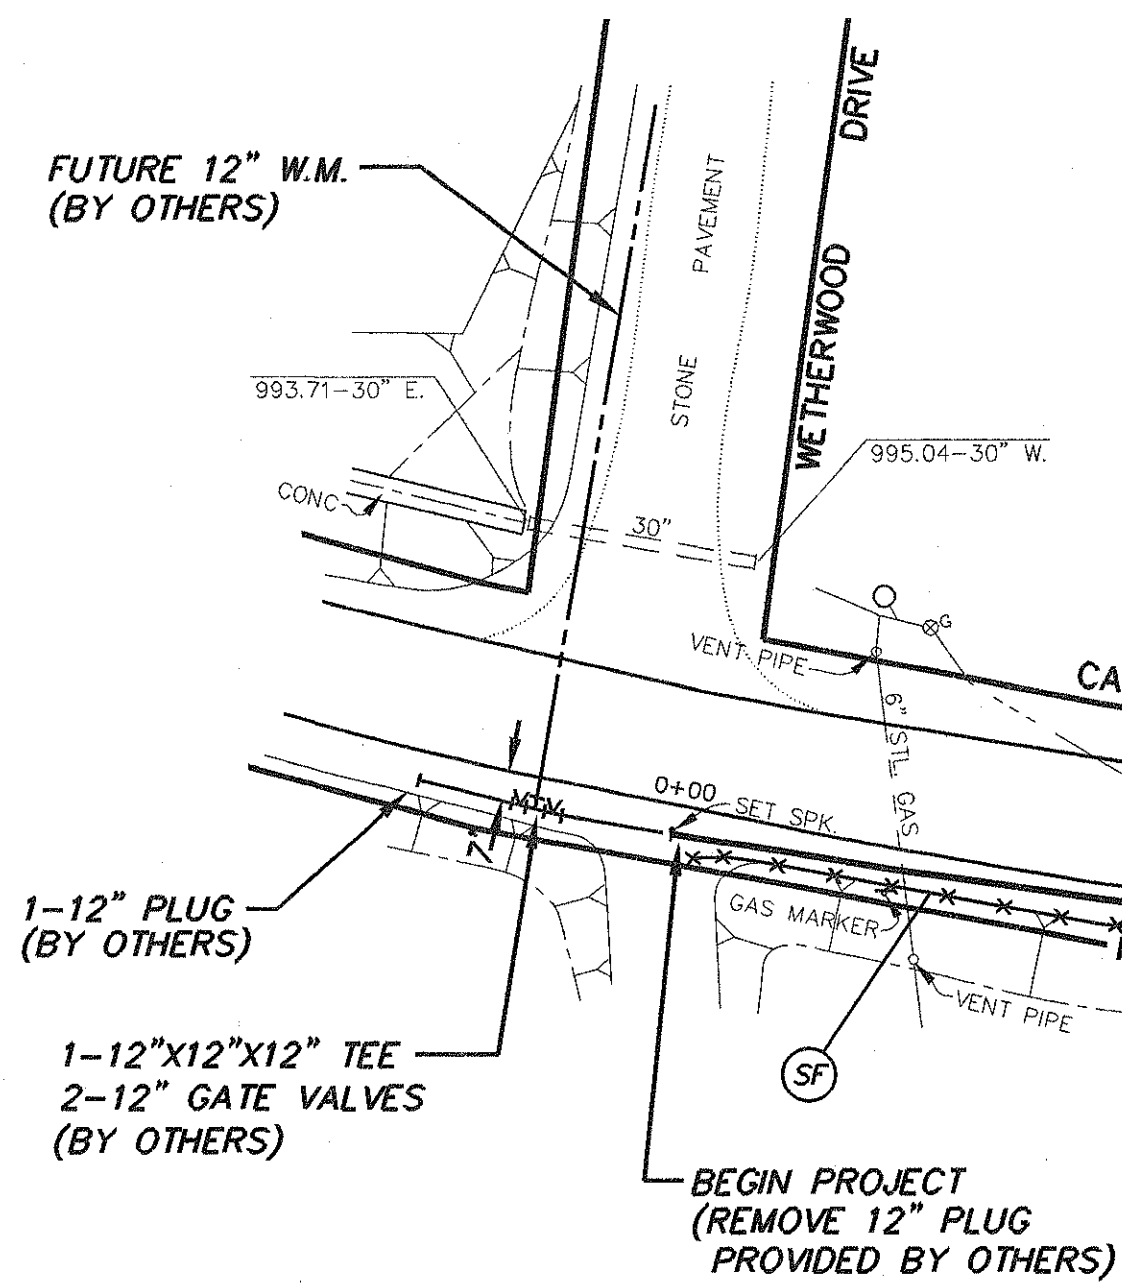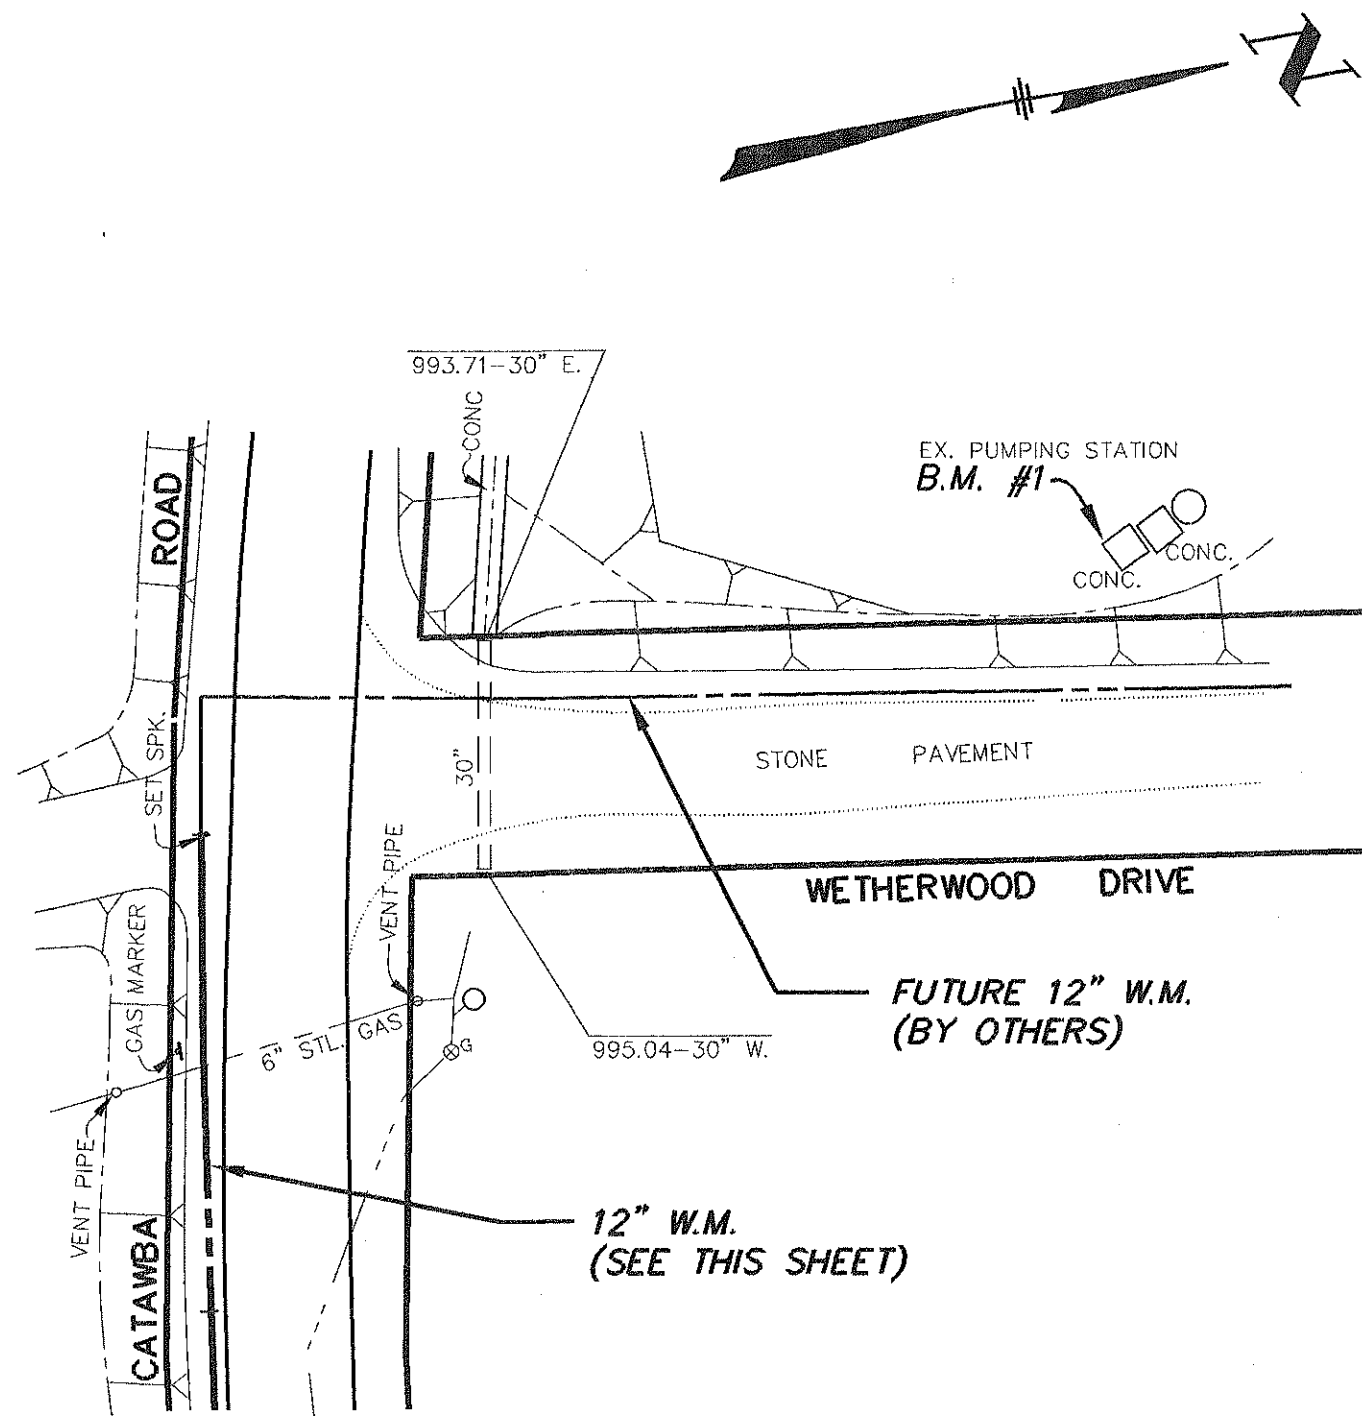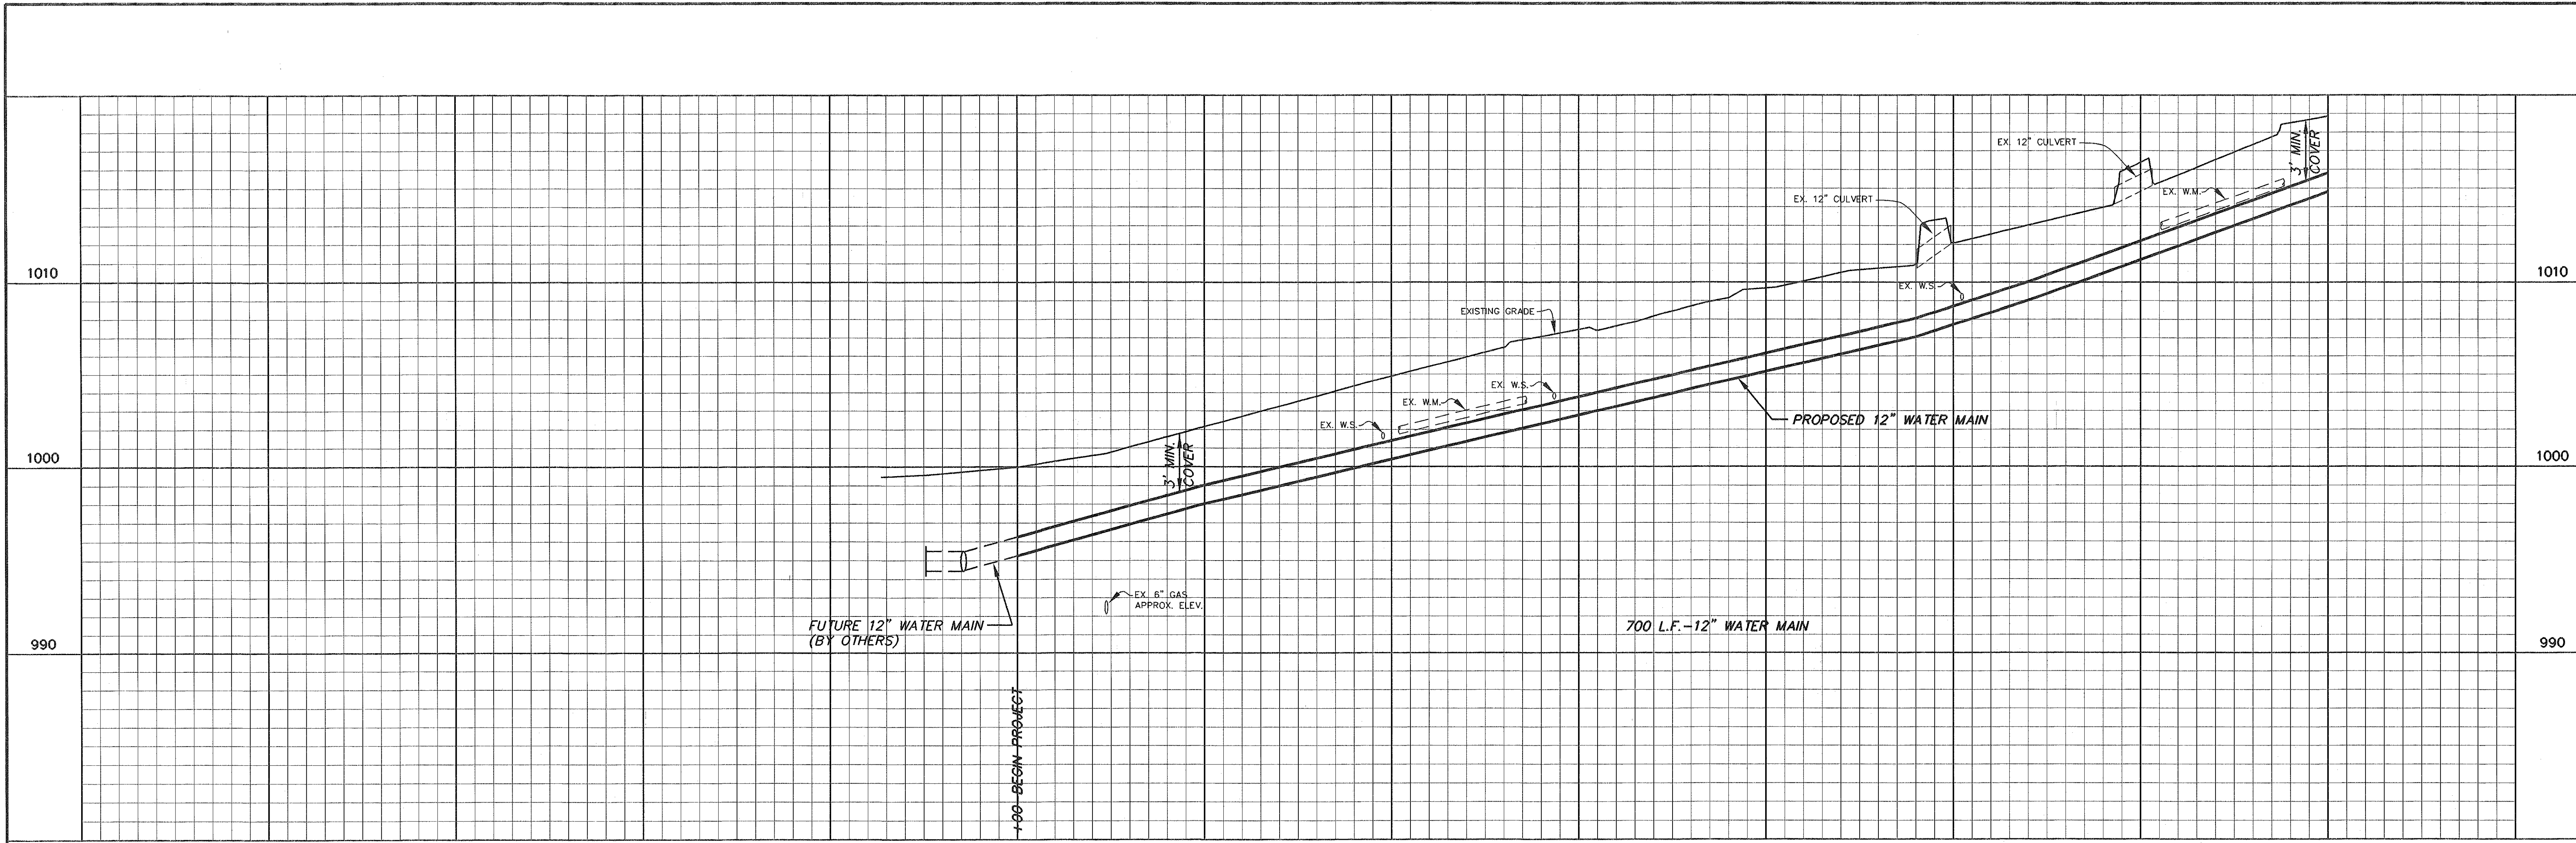

NOTE: EXISTING WATER MAIN TO REMAIN IN SERVICE
AND BE PROTECTED AND SUPPORTED AS
NECESSARY DURING INSTALLATION OF NEW MAIN.

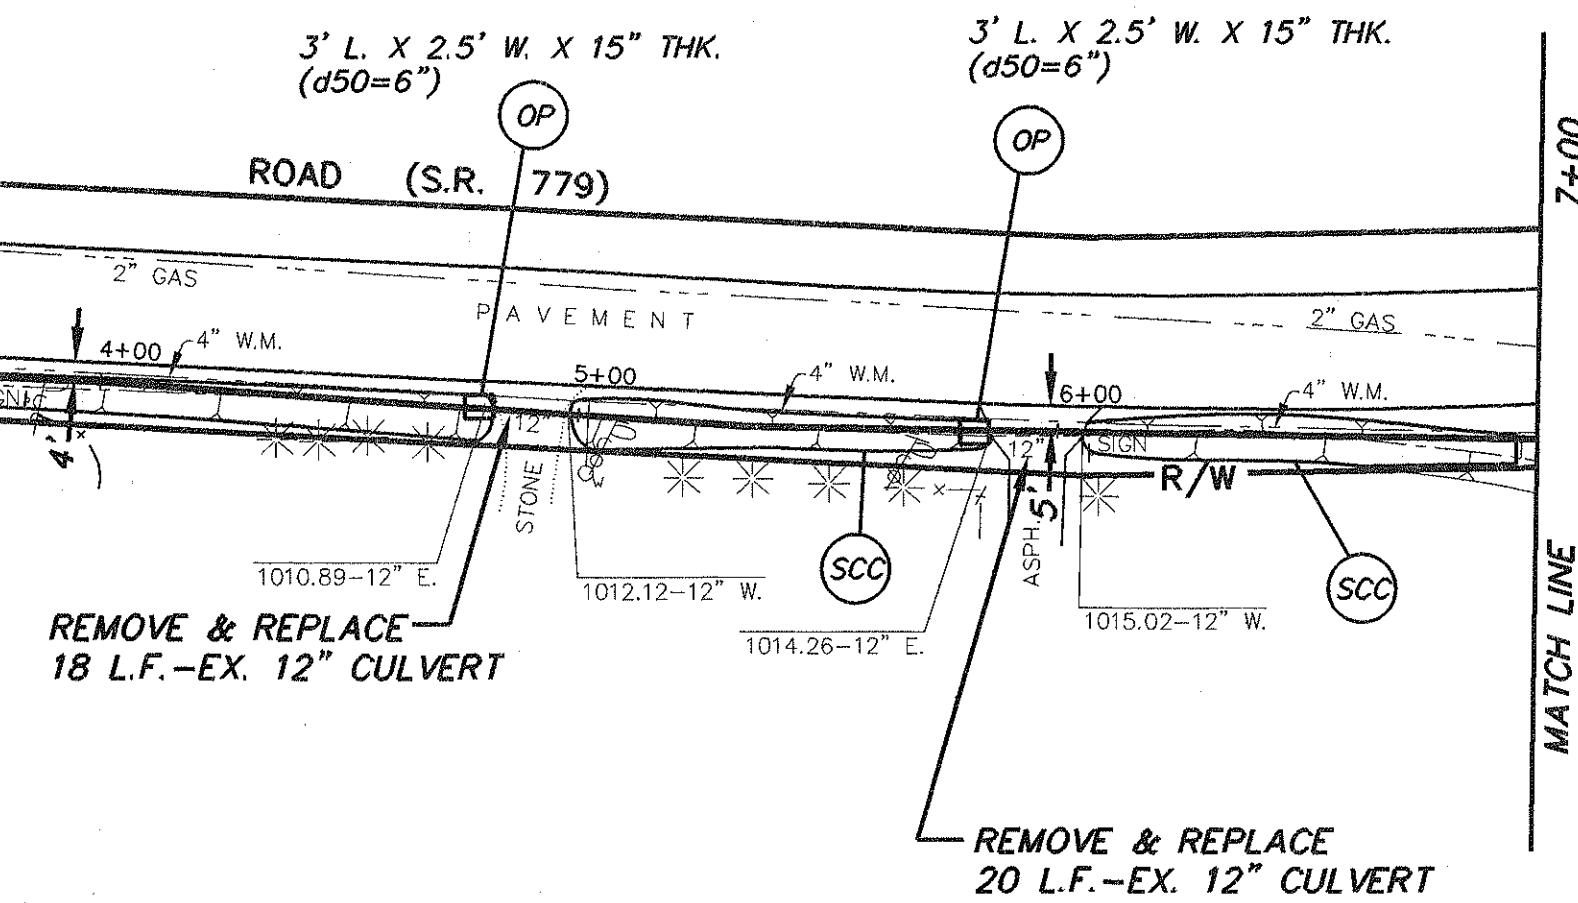

F.P.&S. BENCHMARK #1
SW CORNER OF SOUTHERNMOST STRUCTURE
@ WETHERWOOD PUMPING STATION
ELEV. 1001.13

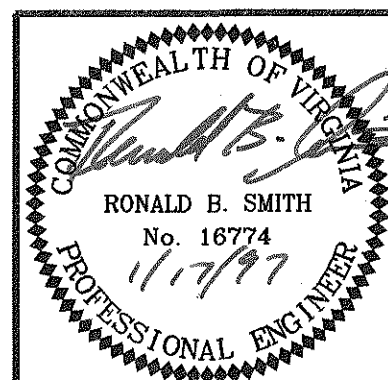



REV. NO.	DESCRIPTION	DATE	BY	APP'D
1	RECORD DRAWING	6-26-96	A.D.C.	R.B.S.

FINKBEINER, PETTIS & SROUT, INC.
CONSULTING ENGINEERS
ROANOKE, VIRGINIA

SCALE
HORIZ. 1"=40'
VERT. 1"=4'
DESIGNED BY
R.B.S.
DRAWN BY
S.R.P.
CHECKED BY
S.A.L./G.G.A.


WETHERWOOD DRIVE & CATAWBA ROAD (S.R. 779)
U.S. 220 WATER MAIN
BOTETOURT COUNTY, VIRGINIA

CAD NUMBER BOTUW001
PROJECT NUMBER BOTW 502 B
CONTRACT
DATE 4-14-95
2 OF 14

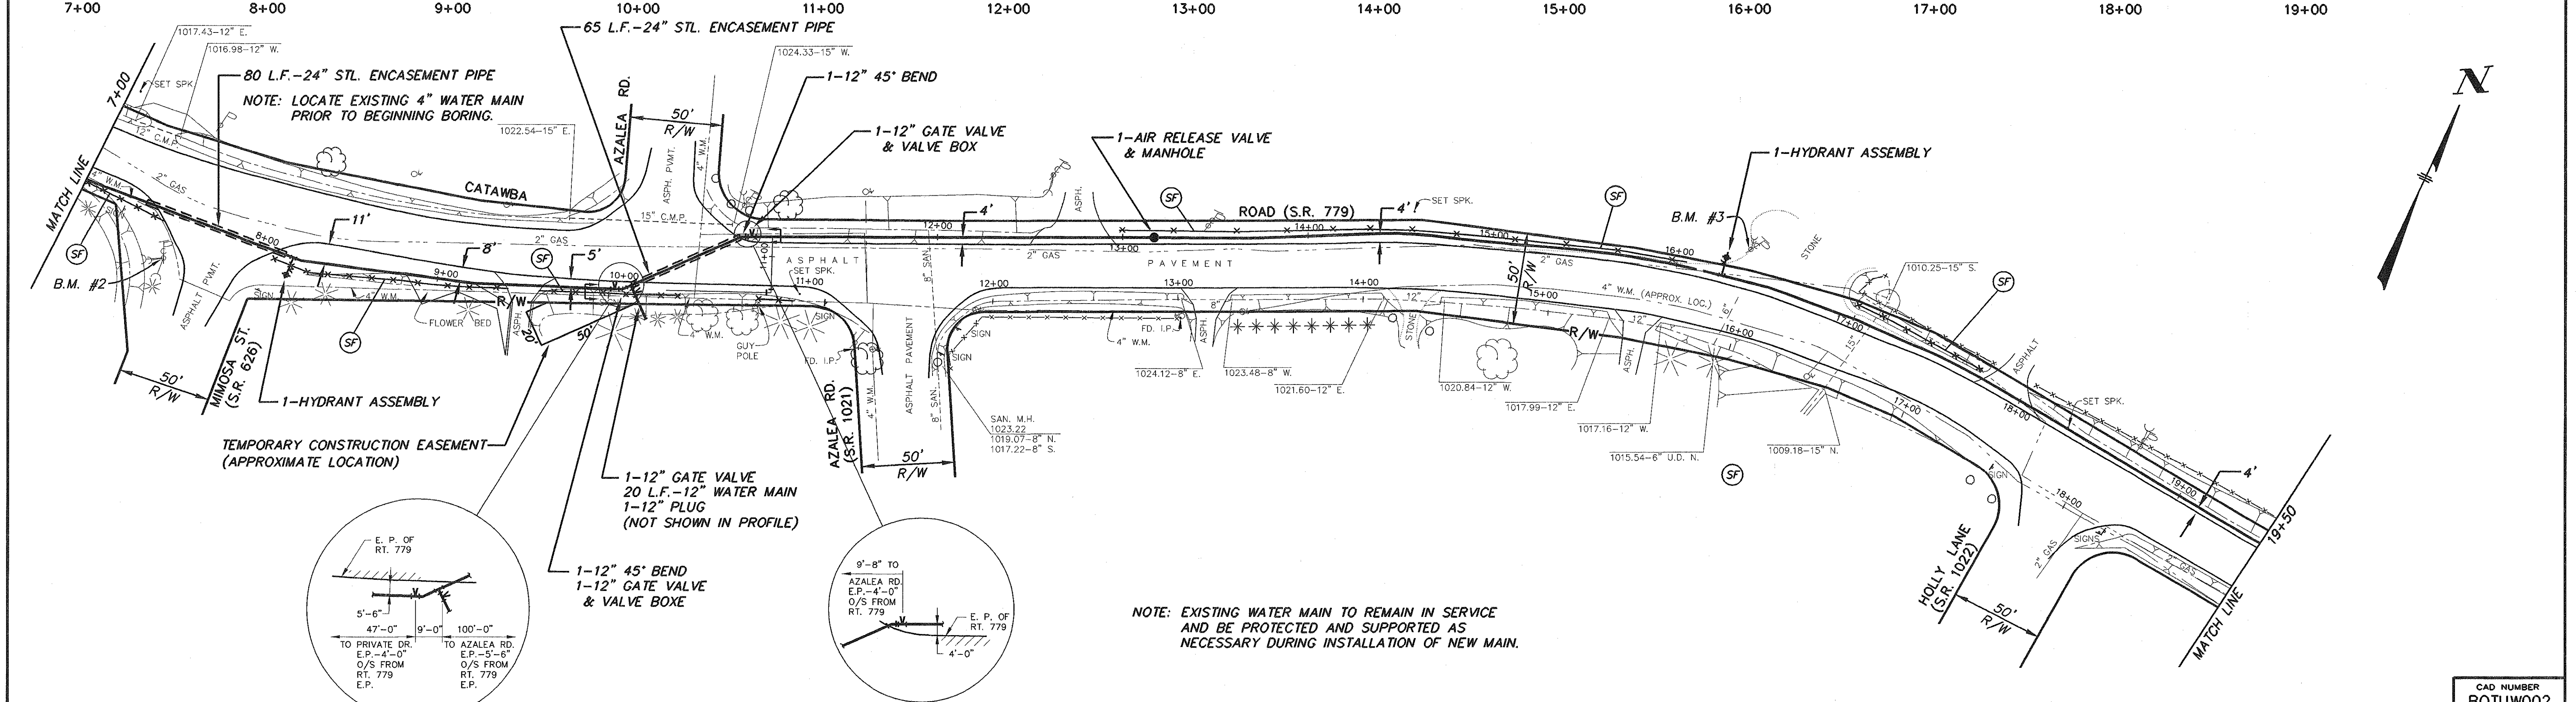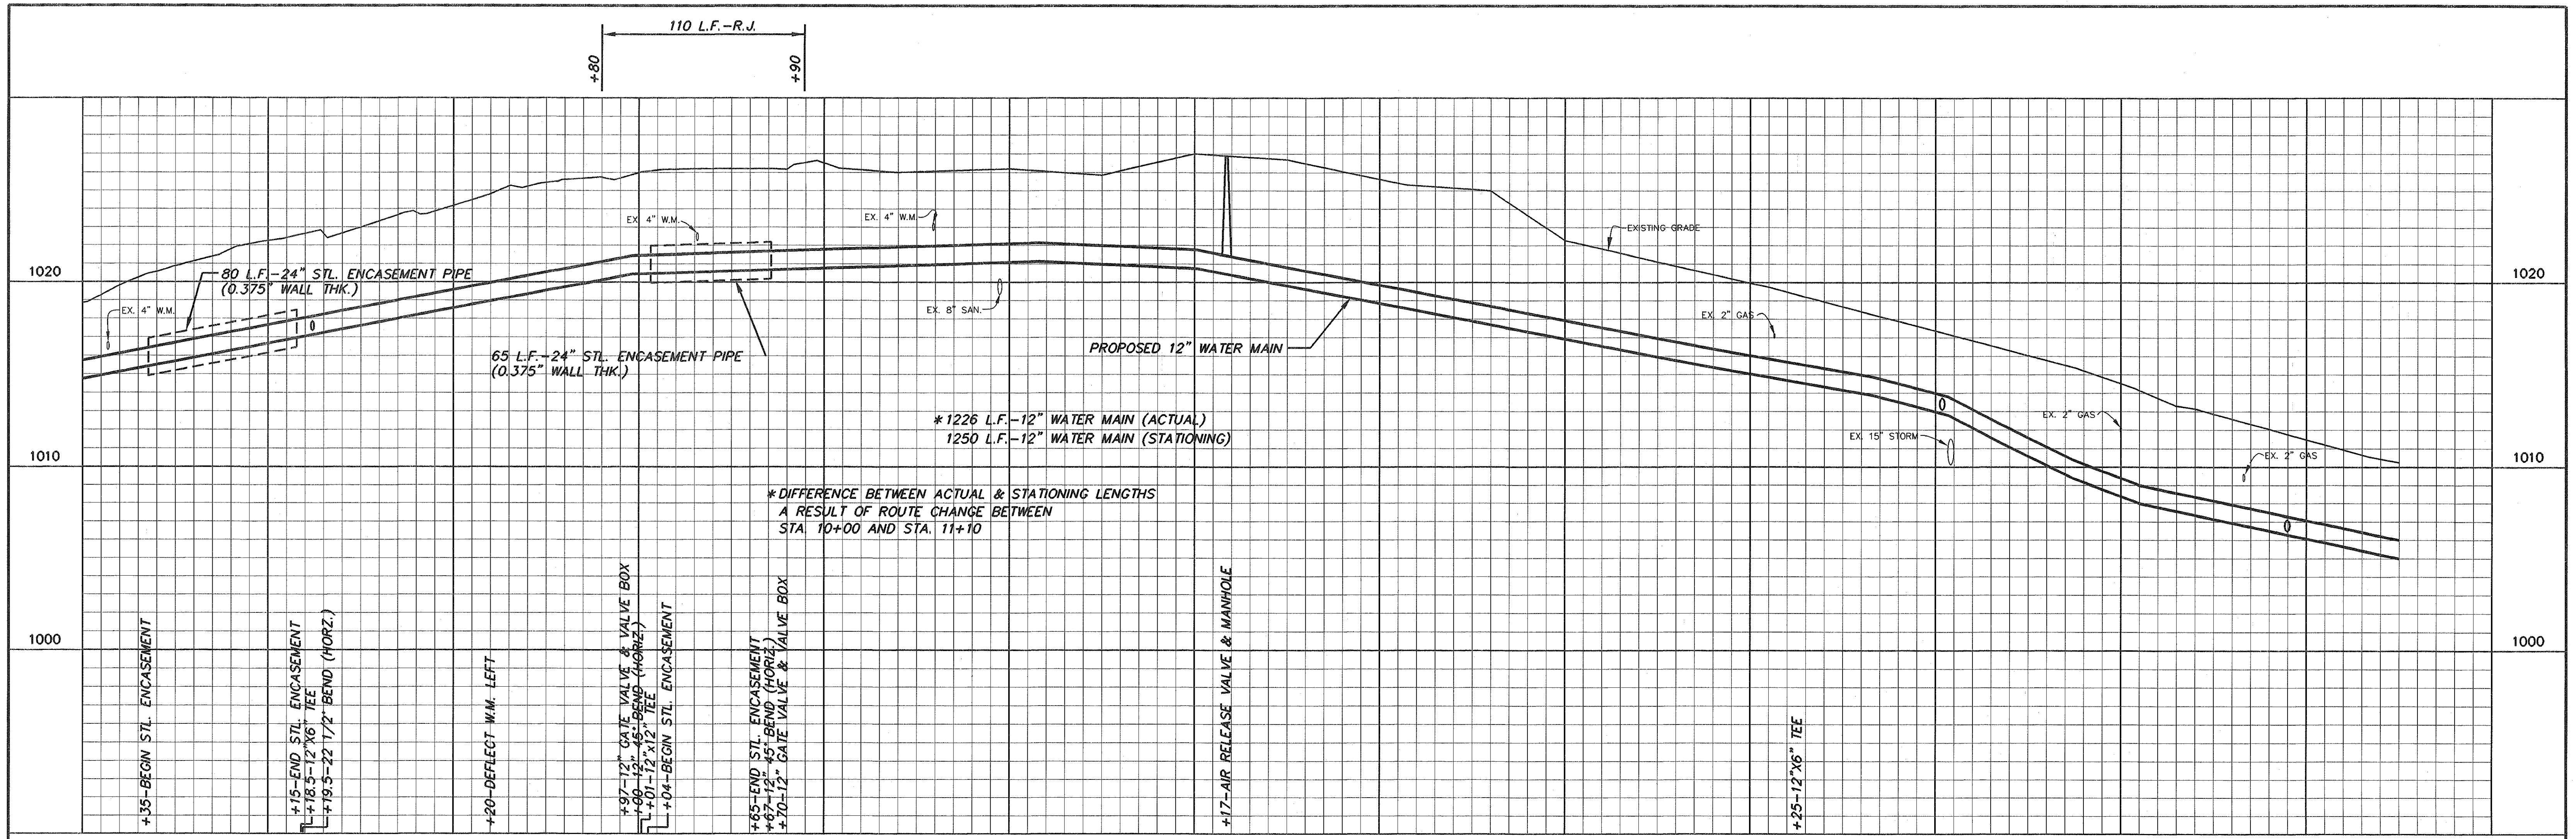

F.P.&S. BENCHMARK #2
SET P.K. NAIL IN TELE/POWER POLE
SW CORNER OF CATAWBA RD. & MIMOSA ST.
ELEV. 1022.00

F.P.&S. BENCHMARK #3
SET P.K. NAIL IN FIRST TELE/POWER POLE
W. OF HOLLY LN. N. SIDE OF CATAWBA RD.
ELEV. 1019.69

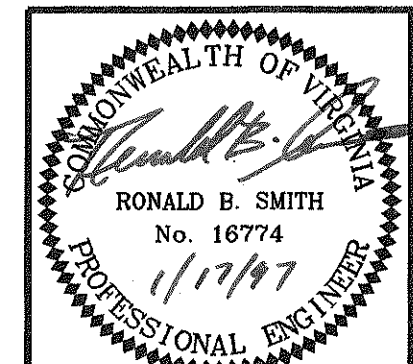



REV. NO.	DESCRIPTION	DATE	BY	APP'D
1	WATER MAIN MOVED TO NORTH SIDE OF ROAD	6-28-95	S.R.P.	R.B.S.
2	RECORD DRAWING	6-26-96	A.D.C.	R.B.S.

FINKBEINER, PETTIS & STROUT, INC.
CONSULTING ENGINEERS
ROANOKE, VIRGINIA


SCALE
HORIZ. 1"=40'
VERT. 1"=4'
DESIGNED BY
R.B.S.
DRAWN BY
S.R.P.
CHECKED BY
S.A.L./G.G.A.

CATAWBA ROAD (S.R. 779)
U.S. 220 WATER MAIN
BOTETOURT COUNTY, VIRGINIA

CAD NUMBER BOTUW002
PROJECT NUMBER BOTW 502 B
CONTRACT
DATE 4-14-95
3 OF 14

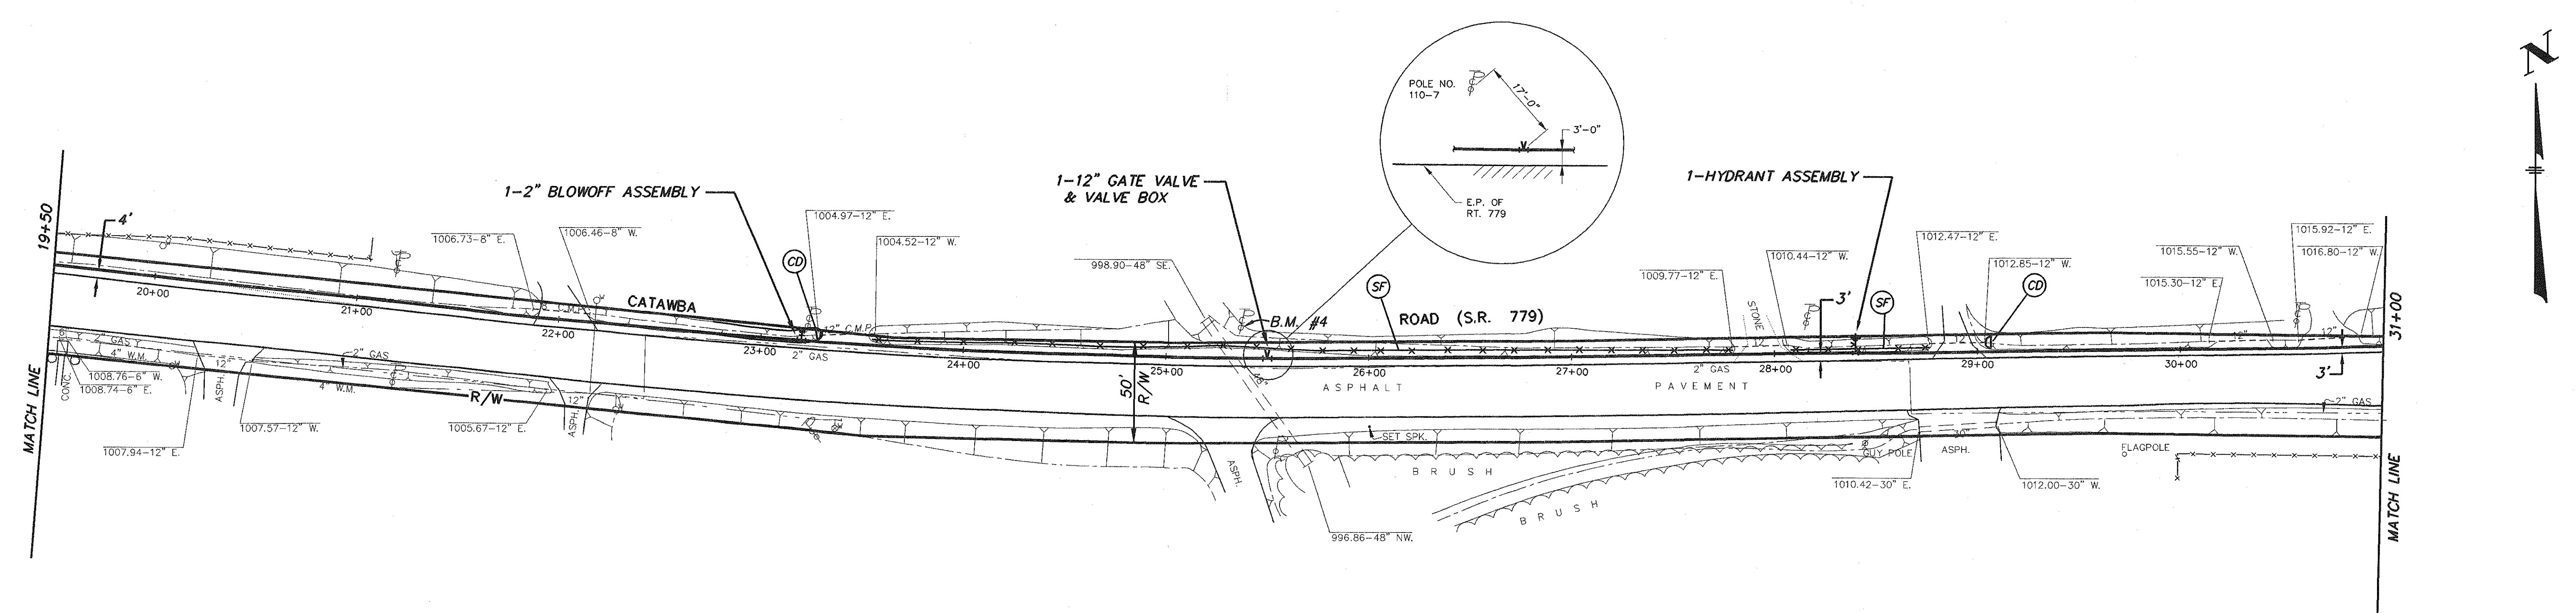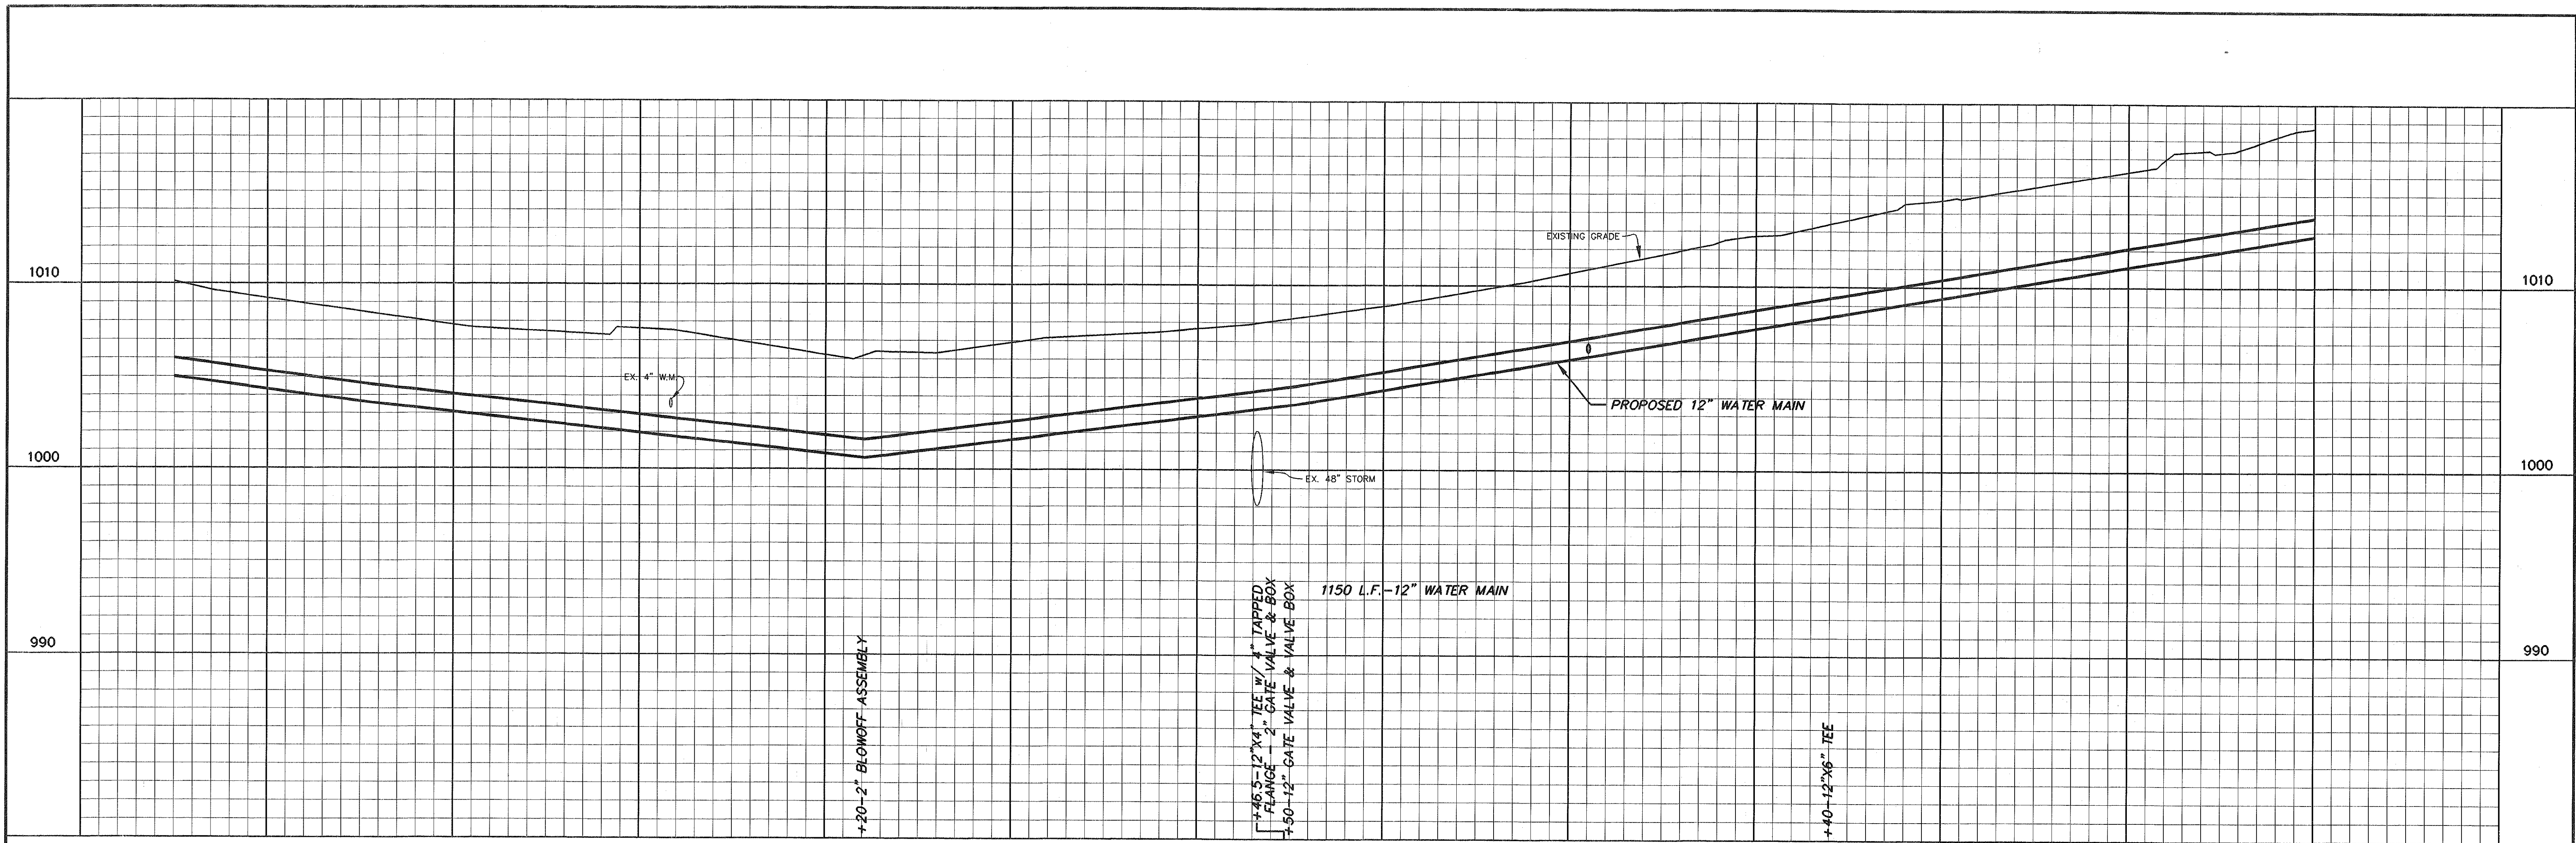

F.P.&S. BENCHMARK #4
SET P.K. NAIL IN TELE/POWER POLE N. SIDE
OF CATAWBA RD., E. SIDE OF CREEK.
ELEV. 1006.92

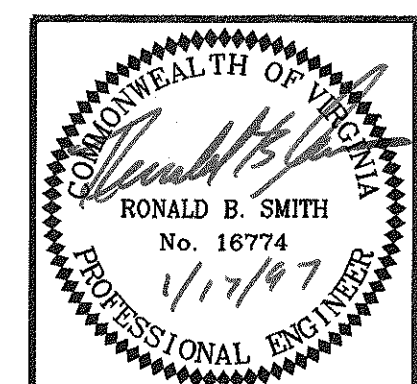


REV. NO.	DESCRIPTION	DATE	BY	APP'D
1	WATER MAIN MOVED TO NORTH SIDE OF ROAD	6-29-95	S.R.P.	R.B.S.
2	RECORD DRAWING	1-18-96	A.D.C.	R.B.S.

FINKBEINER, PETTIS & STROUT, INC.
CONSULTING ENGINEERS
ROANOKE, VIRGINIA


SCALE
HORIZ. 1"=40'
VERT. 1"=4'
DESIGNED BY
R.B.S.
DRAWN BY
S.R.P.
CHECKED BY
S.A.L./G.G.A.

CATAWBA ROAD (S.R. 779)
U.S. 220 WATER MAIN
BOTETOURT COUNTY, VIRGINIA

CAD NUMBER BOTUW003
PROJECT NUMBER BOTW 502 B
CONTRACT
DATE 4-14-95
4 OF 14

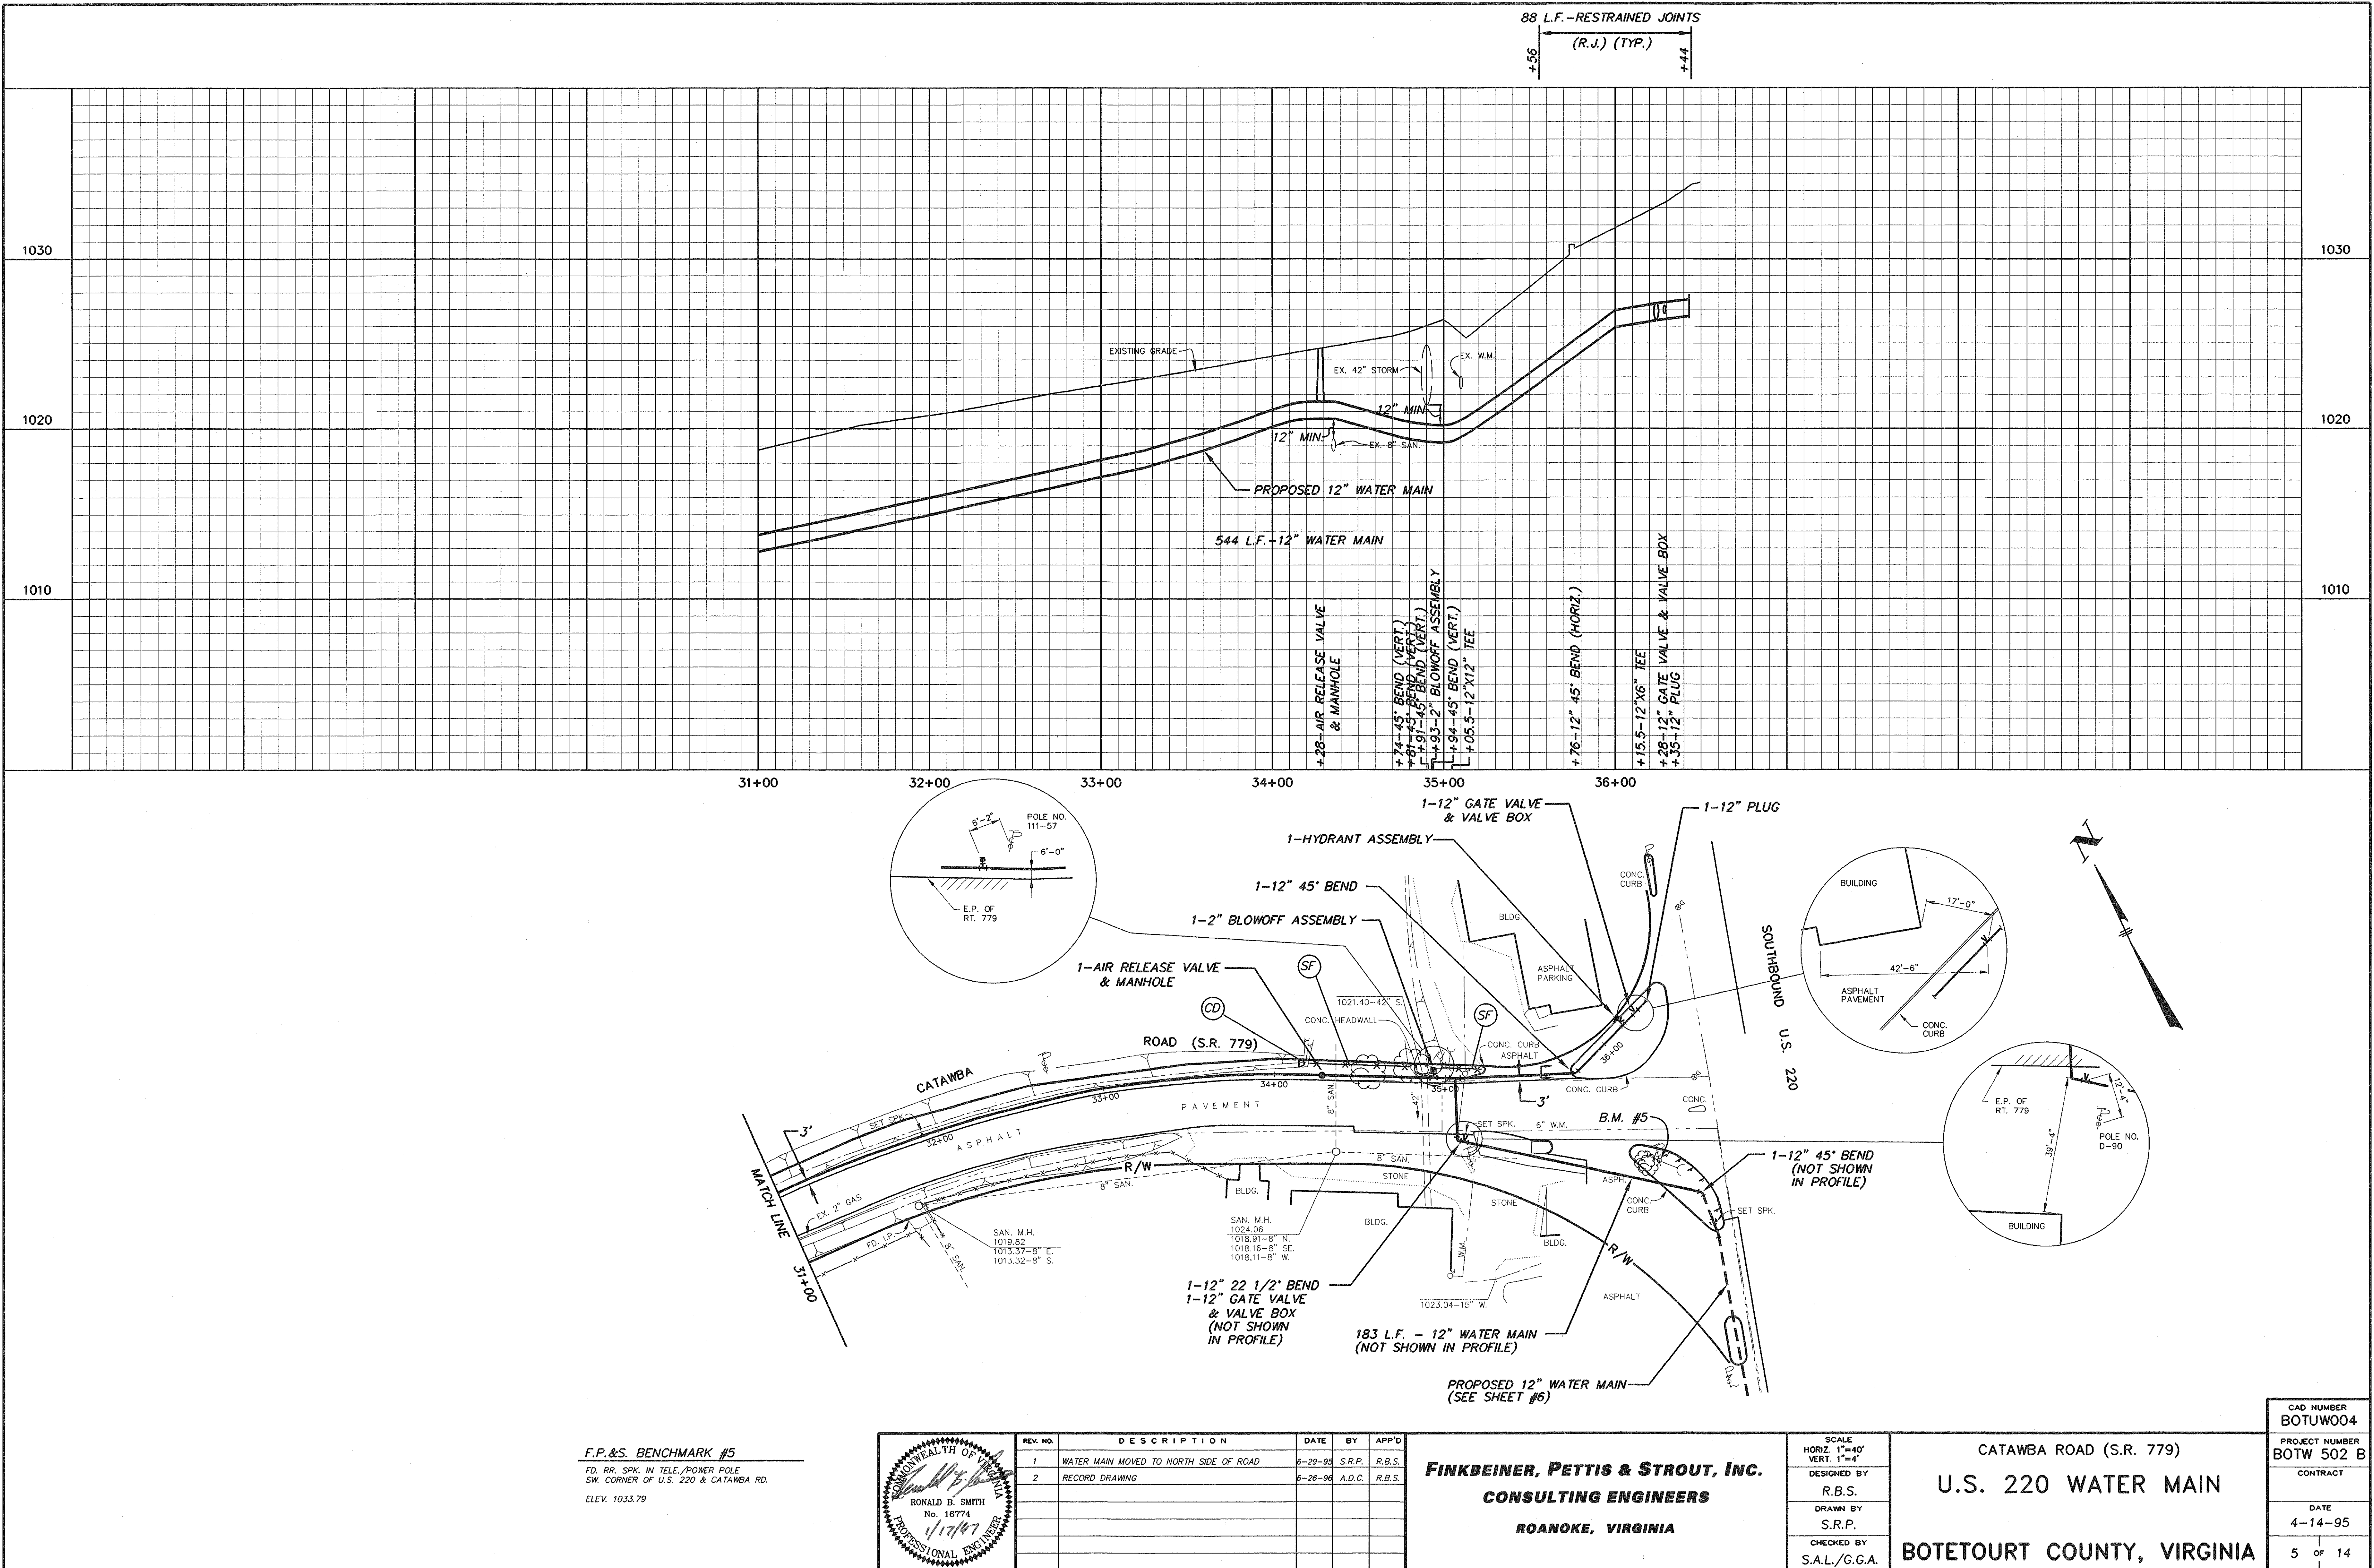

F.P.&S. BENCHMARK #5
FD. RR. SPK. IN TELE. POWER POLE
SW. CORNER OF U.S. 220 & CATAWBA RD.
ELEV. 1033.79

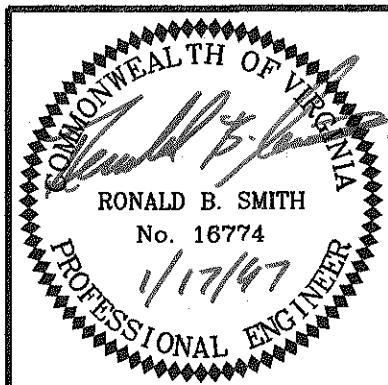



REV. NO.	DESCRIPTION	DATE	BY	APP'D
1	WATER MAIN MOVED TO NORTH SIDE OF ROAD	6-29-95	S.R.P.	R.B.S.
2	RECORD DRAWING	6-26-96	A.D.C.	R.B.S.

FINKBEINER, PETTIS & STROUT, INC.
CONSULTING ENGINEERS
ROANOKE, VIRGINIA


SCALE
HORIZ. 1"=40'
VERT. 1"=4'
DESIGNED BY
R.B.S.
DRAWN BY
S.R.P.
CHECKED BY
S.A.L./G.G.A.

CATAWBA ROAD (S.R. 779)
U.S. 220 WATER MAIN
BOTETOURT COUNTY, VIRGINIA

CAD NUMBER BOTUW004
PROJECT NUMBER BOTW 502 B
CONTRACT
DATE 4-14-95
5 OF 14

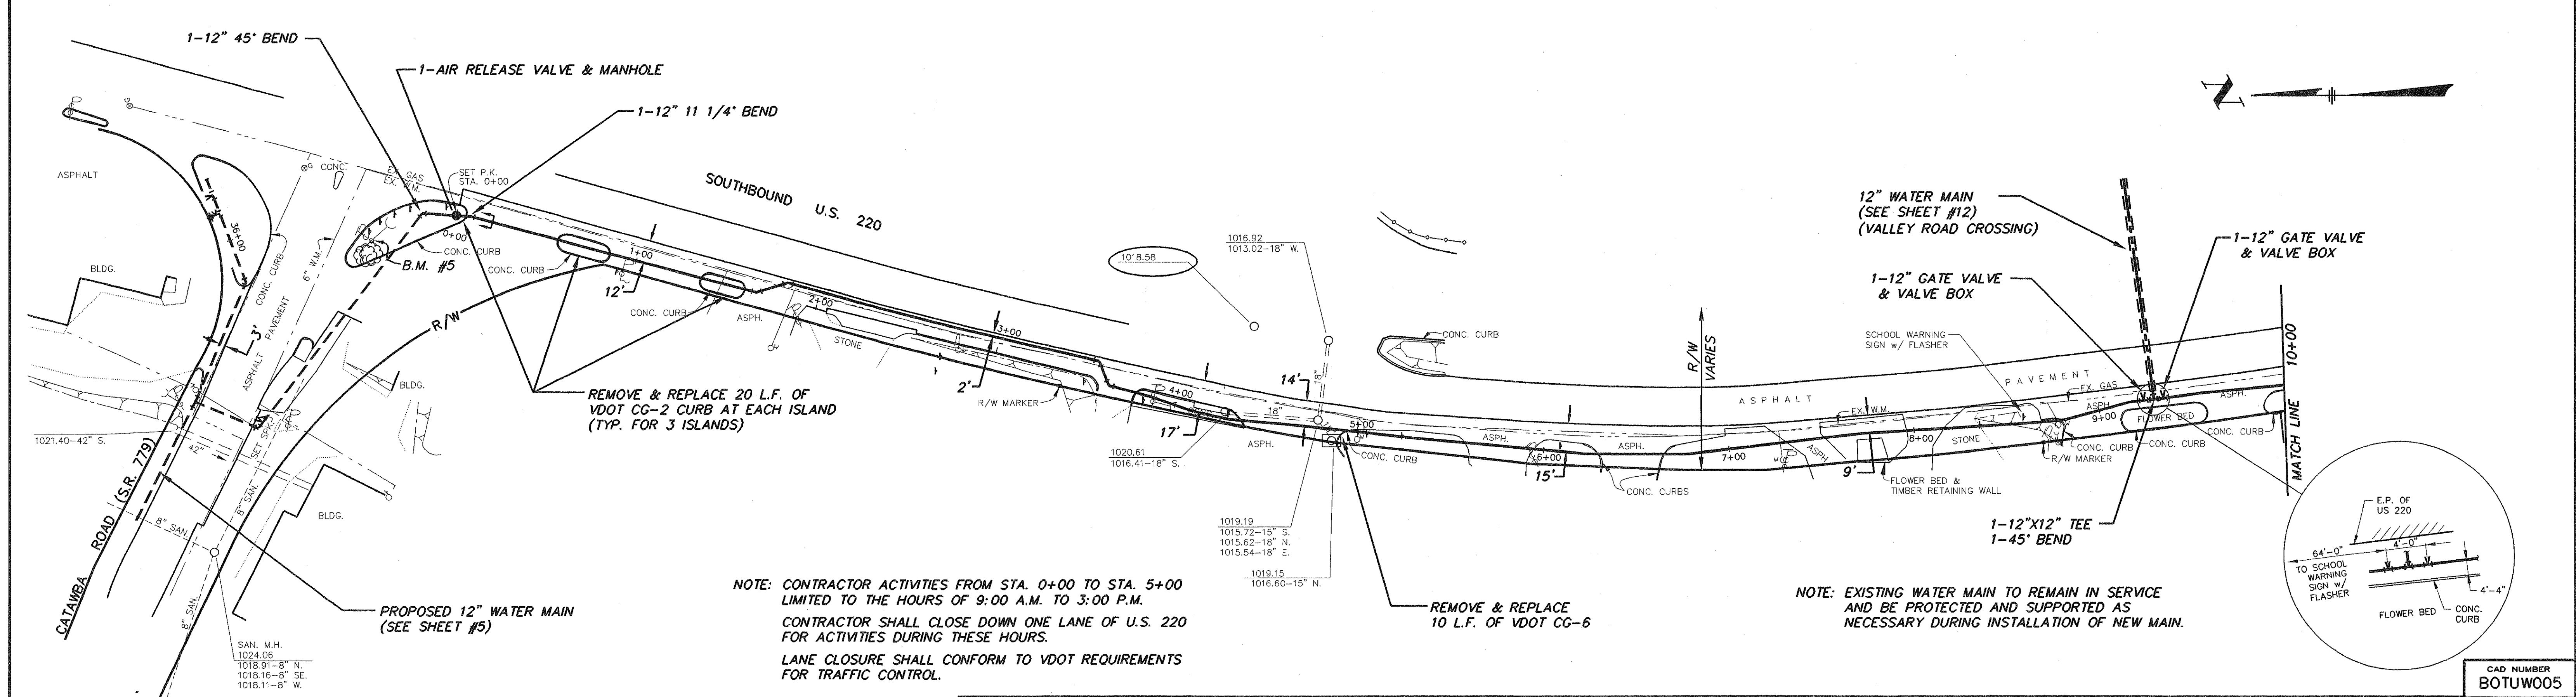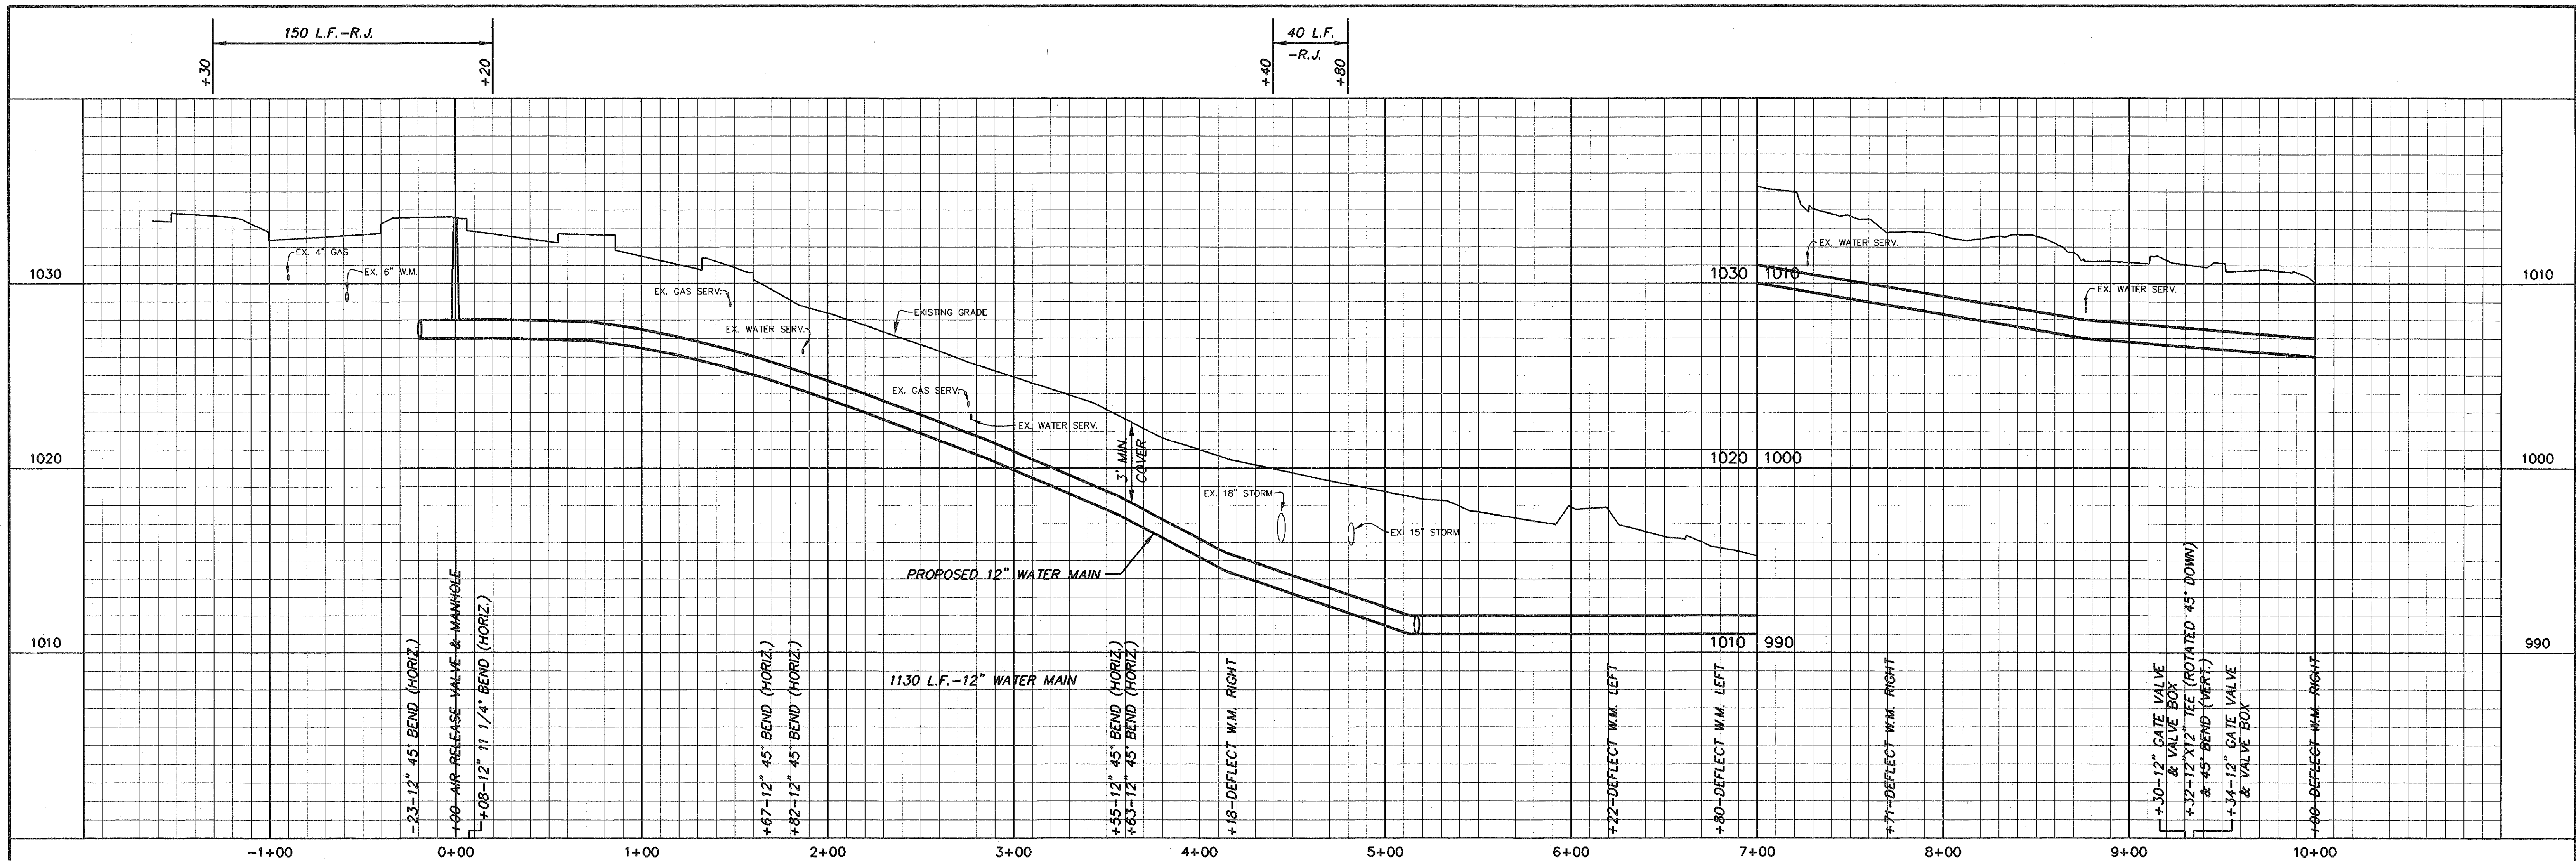

F.P.&S. BENCHMARK #5
 F.D. RR. SPK. IN TELE/POWER POLE
 SW. CORNER OF U.S. 220 & CATAWBA RD.
 ELEV. 1033.79

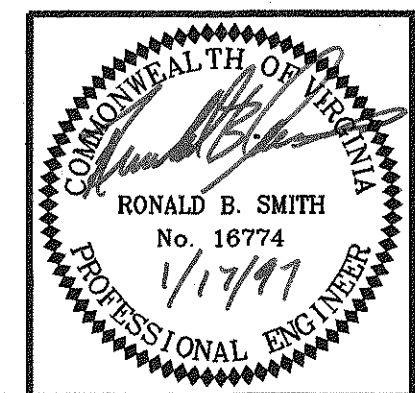



REV. NO.	DESCRIPTION	DATE	BY	APP'D
1	W.M. MOVED TO NORTH SIDE OF CATAWBA ROAD	6-28-95	S.R.P.	R.B.S.
2	RECORD DRAWING	6-26-96	A.D.C.	R.B.S.

FINKBEINER, PETTIS & SROUT, INC.
CONSULTING ENGINEERS
 ROANOKE, VIRGINIA


SCALE
 HORIZ. 1"=40'
 VERT. 1"=4'
 DESIGNED BY
 R.B.S.
 DRAWN BY
 S.R.P.
 CHECKED BY
 S.A.L./G.G.A.

U.S. 220
U.S. 220 WATER MAIN
 BOTETOURT COUNTY, VIRGINIA

CAD NUMBER BOTUW005
PROJECT NUMBER BOTW 502 B
CONTRACT
DATE 4-14-95
6 OF 14

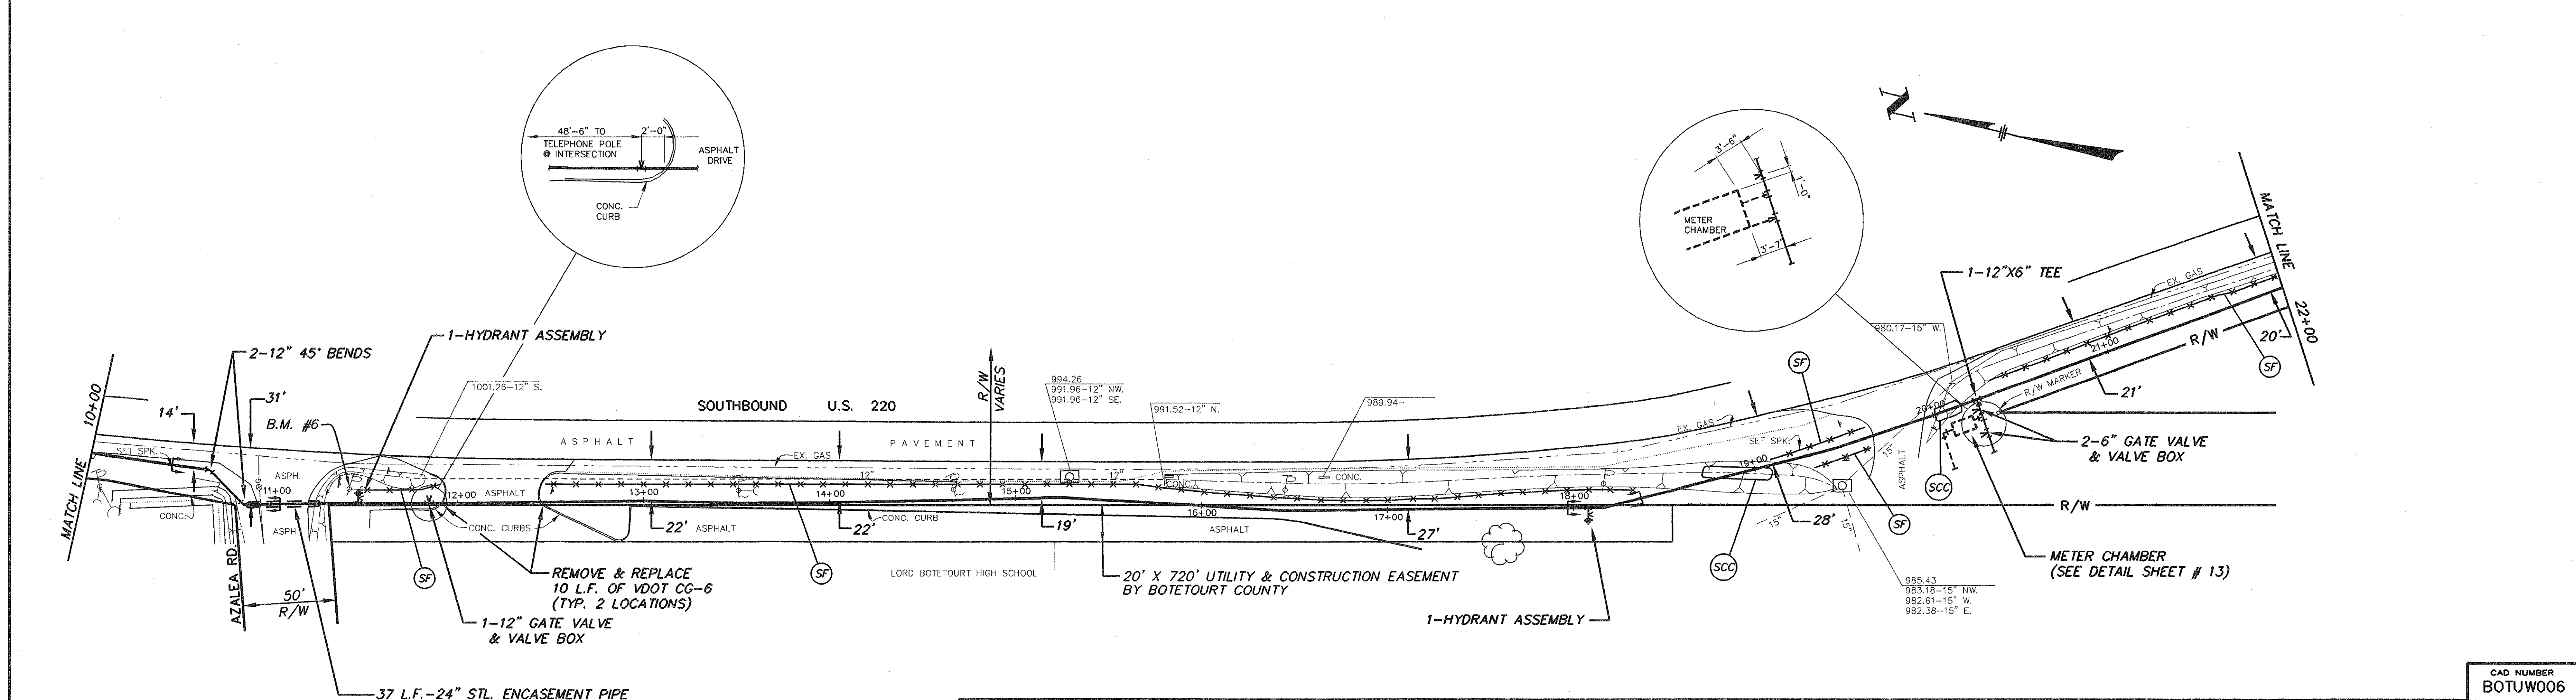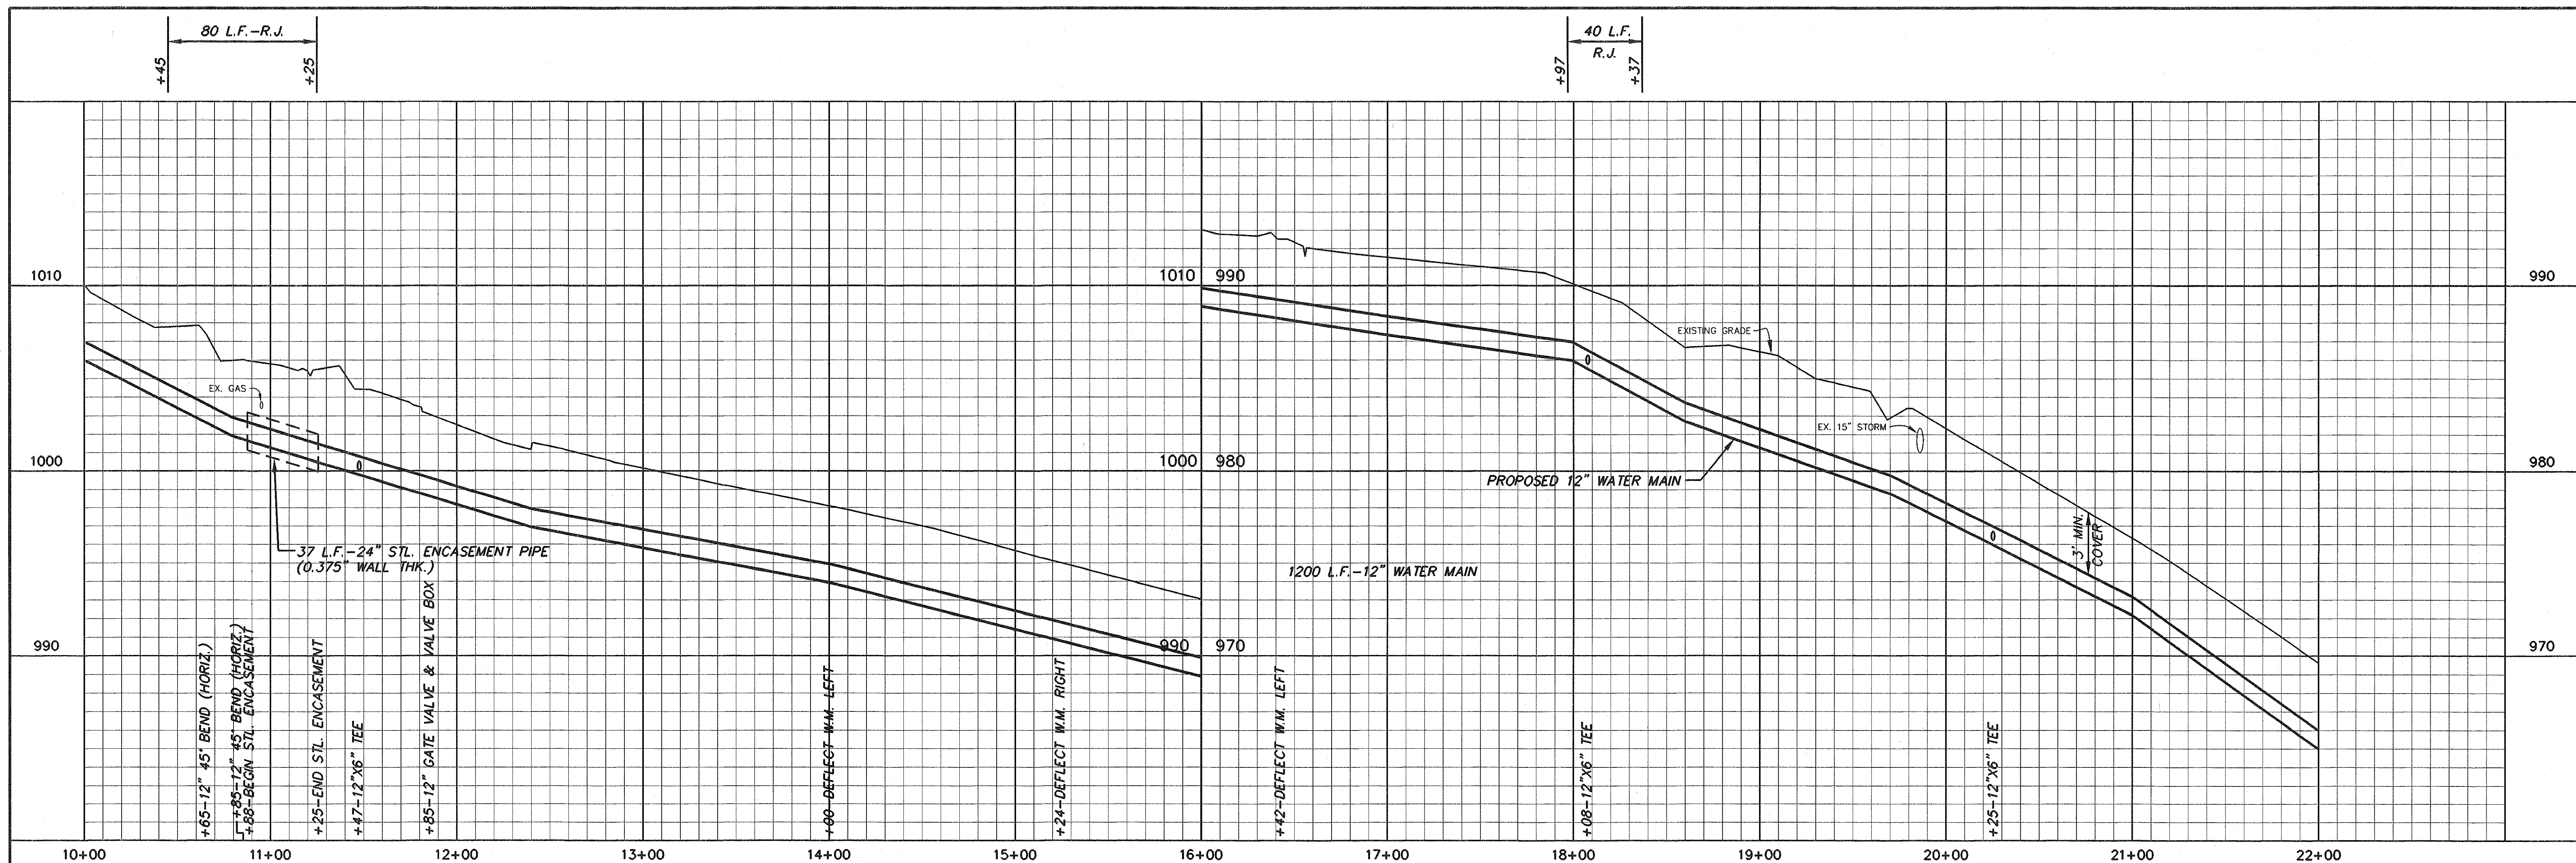

F.P. & S. BENCHMARK #6
TOP OF F.D. RR. SPK. IN TELE/POWER POLE
SW. CORNER OF U.S. 220 & AZALEA RD.
ELEV. 1006.81

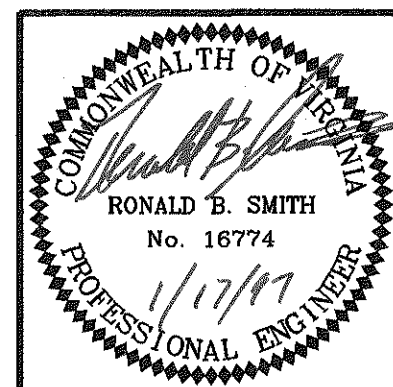



REV. NO.	DESCRIPTION	DATE	BY	APP'D
1	RECORD DRAWING	6-26-96	A.D.C.	R.B.S.

FINKBEINER, PETTIS & SROUT, INC.
CONSULTING ENGINEERS
ROANOKE, VIRGINIA

SCALE
HORIZ. 1"=40'
VERT. 1"=4'
DESIGNED BY
R.B.S.
DRAWN BY
S.R.P.
CHECKED BY
S.A.L./G.G.A.

U.S. 220
U.S. 220 WATER MAIN
BOTETOURT COUNTY, VIRGINIA

CAD NUMBER BOTUW006
PROJECT NUMBER BOTW 502 B
CONTRACT
DATE 4-14-95
7 OF 14

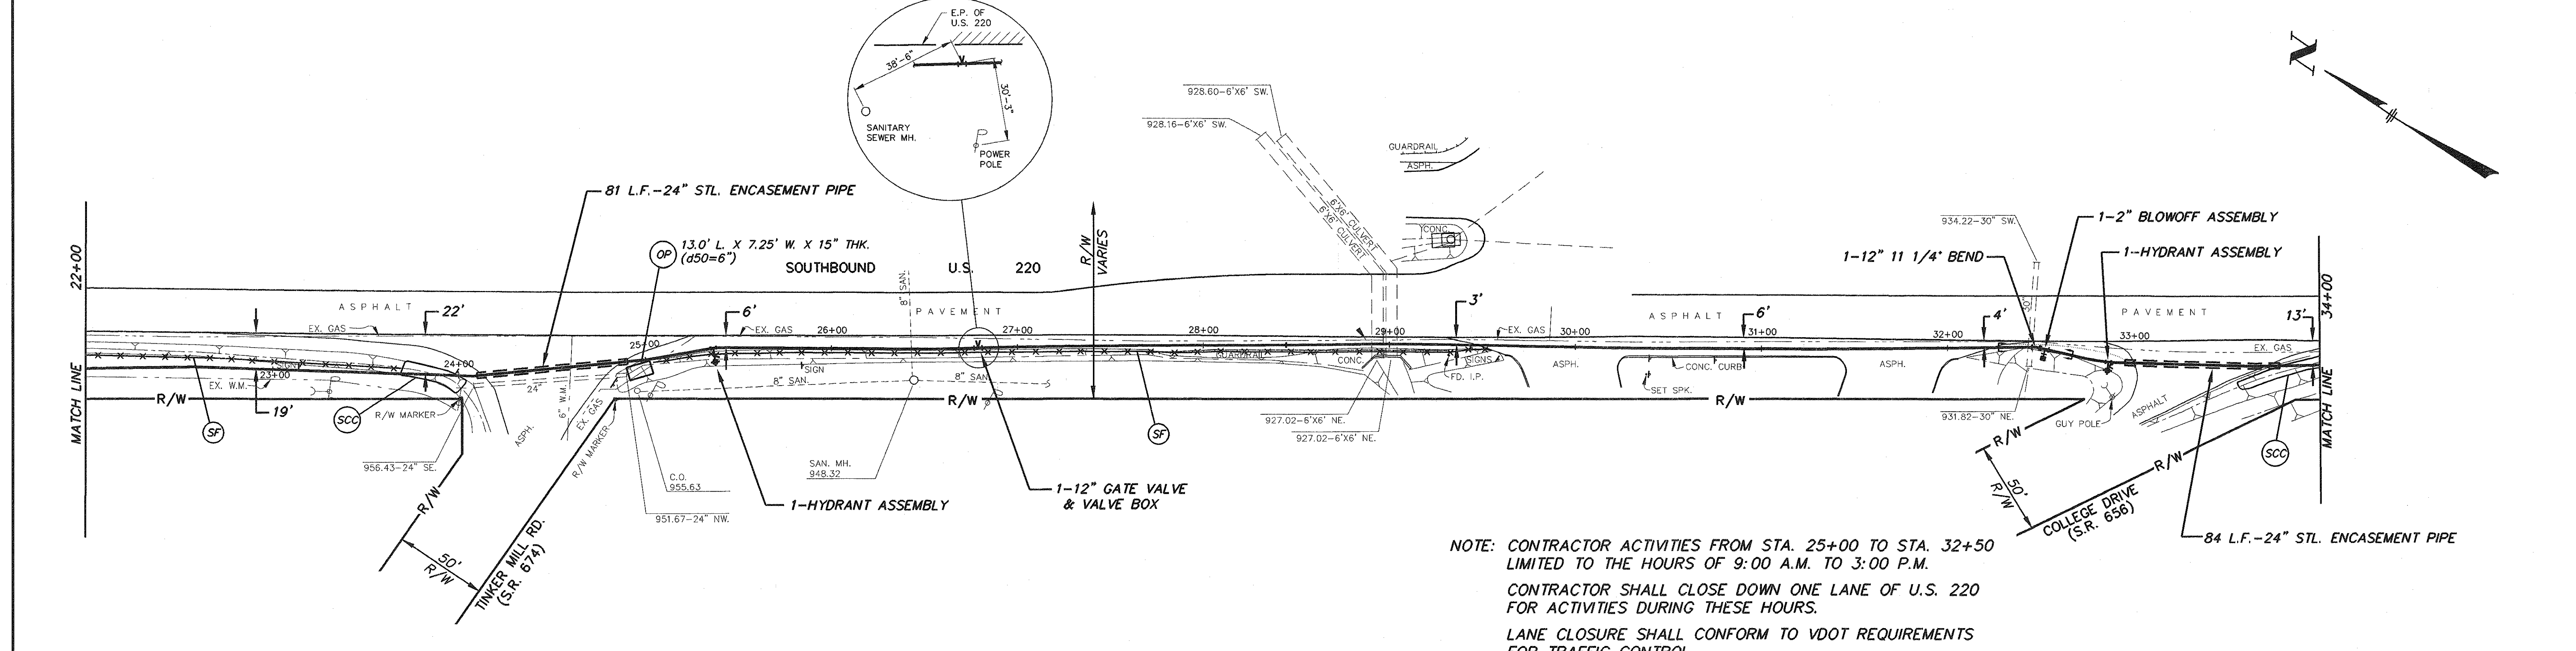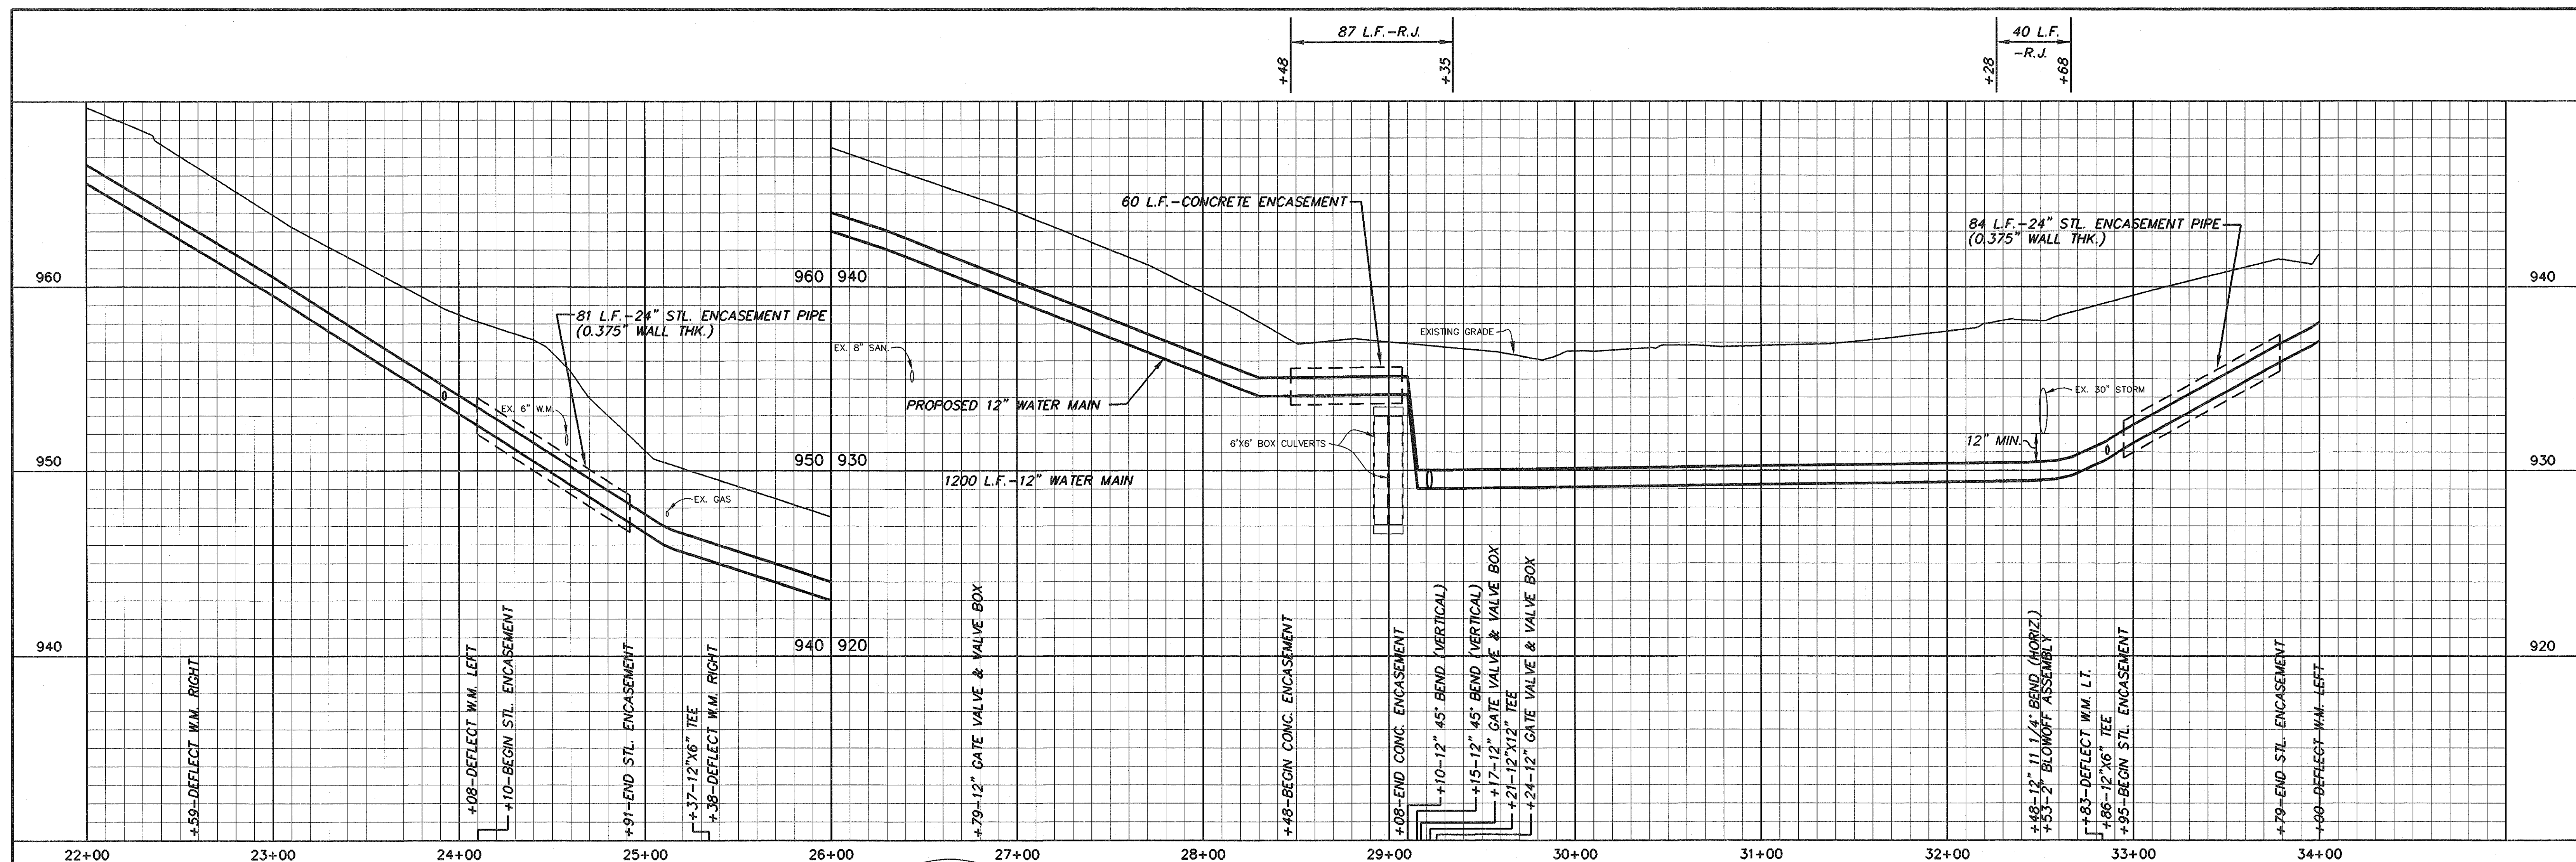

NOTE: CONTRACTOR ACTIVITIES FROM STA. 25+00 TO STA. 32+50 LIMITED TO THE HOURS OF 9:00 A.M. TO 3:00 P.M.
 CONTRACTOR SHALL CLOSE DOWN ONE LANE OF U.S. 220 FOR ACTIVITIES DURING THESE HOURS.
 LANE CLOSURE SHALL CONFORM TO VDOT REQUIREMENTS FOR TRAFFIC CONTROL.

RONALD B. SMITH
No. 16774
PROFESSIONAL ENGINEER

REV. NO.	DESCRIPTION	DATE	BY	APP'D
1	RECORD DRAWING	6-26-96	A.D.C.	R.B.S.

FINKBEINER, PETTIS & SROUT, INC.
 CONSULTING ENGINEERS
 ROANOKE, VIRGINIA

SCALE
 HORIZ. 1"=40'
 VERT. 1"=4'

DESIGNED BY
 R.B.S.

DRAWN BY
 S.R.P.

CHECKED BY
 S.A.L./G.G.A.

U.S. 220
U.S. 220 WATER MAIN
 BOTETOURT COUNTY, VIRGINIA



CAD NUMBER
 BOTUW007

PROJECT NUMBER
 BOTW 502 B

CONTRACT


DATE
 4-14-95

8 OF 14

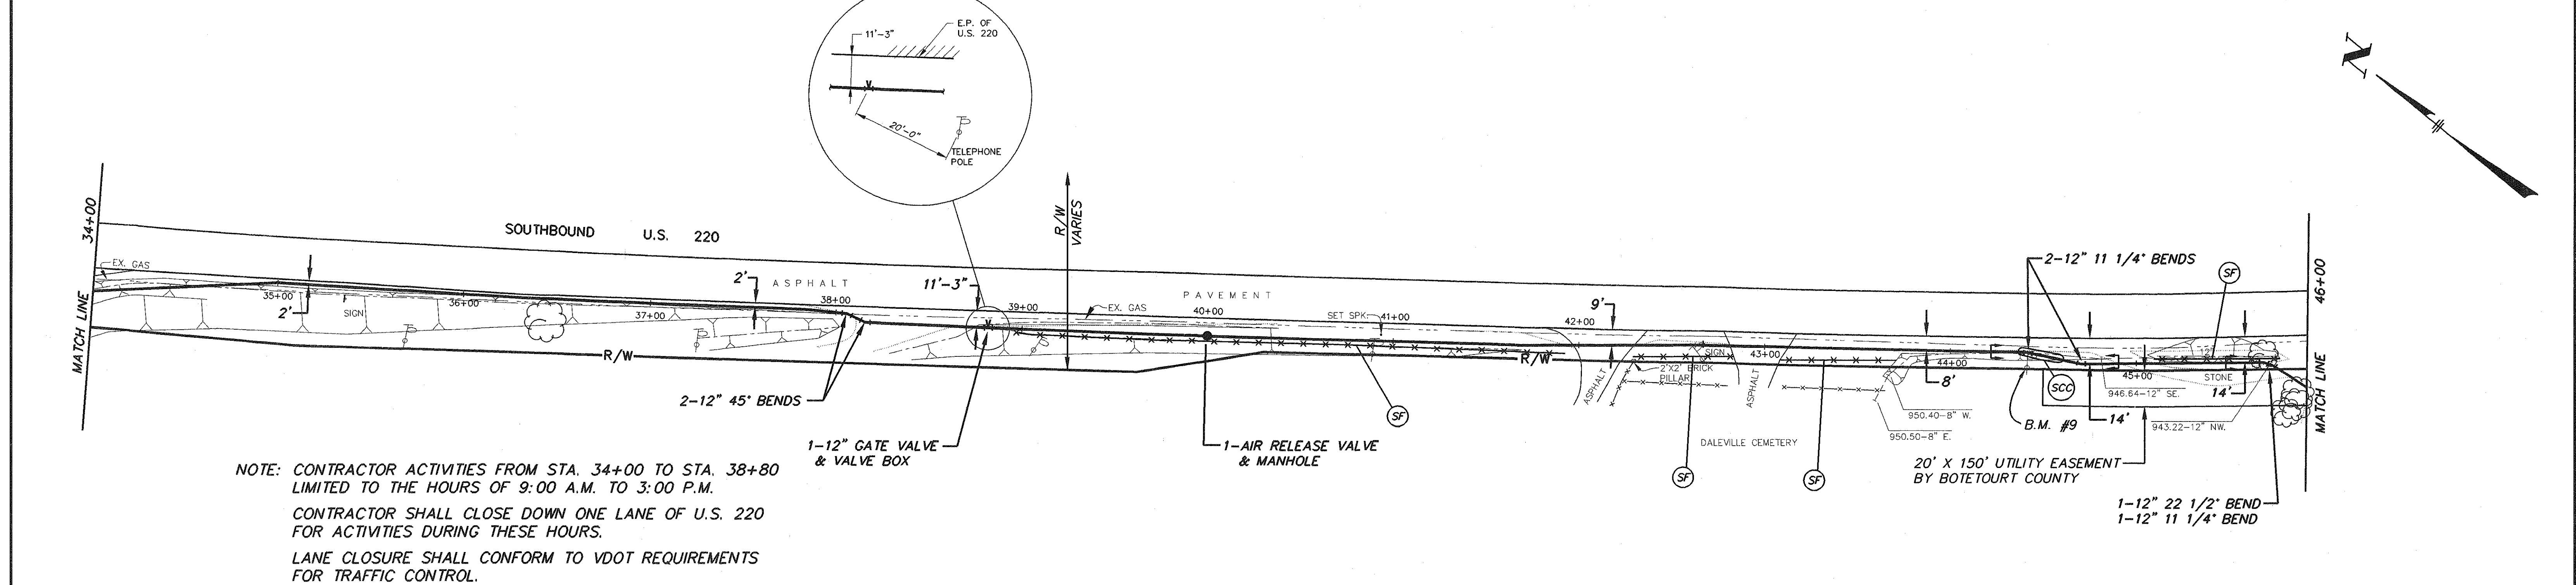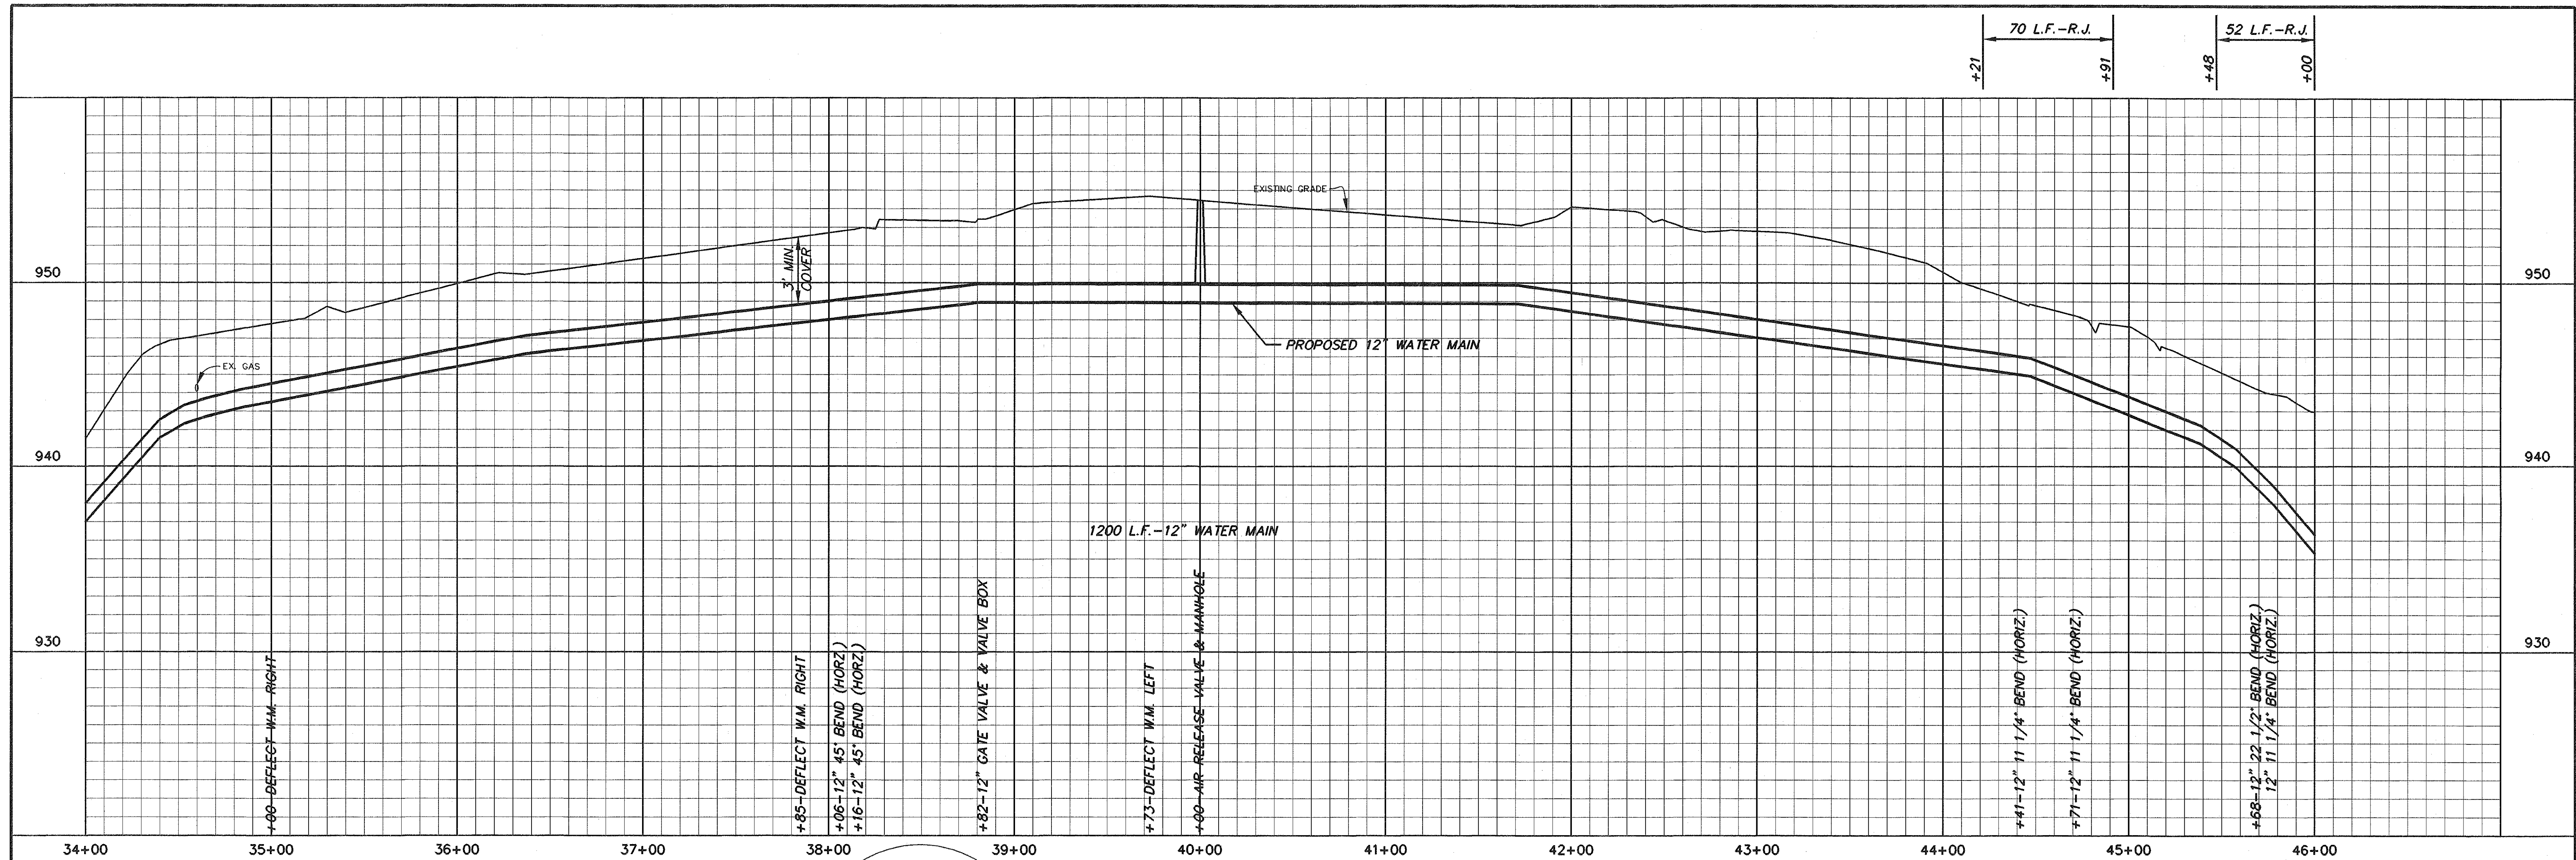

NOTE: CONTRACTOR ACTIVITIES FROM STA. 34+00 TO STA. 38+80 LIMITED TO THE HOURS OF 9:00 A.M. TO 3:00 P.M.
 CONTRACTOR SHALL CLOSE DOWN ONE LANE OF U.S. 220 FOR ACTIVITIES DURING THESE HOURS.
 LANE CLOSURE SHALL CONFORM TO VDOT REQUIREMENTS FOR TRAFFIC CONTROL.

F.P.&S. BENCHMARK #9
 P.K. NAIL 1ST TELE/POWER POLE S. OF SOUTH ENTRANCE TO CEMETERY W. SIDE OF U.S. 220
 ELEV. 950.68

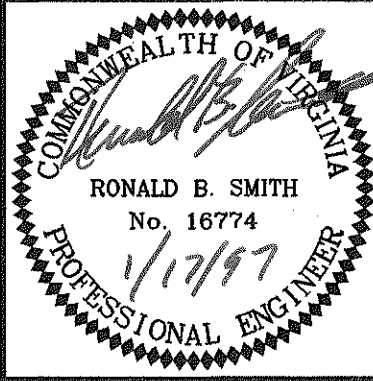



REV. NO.	DESCRIPTION	DATE	BY	APP'D
1	RECORD DRAWING	6-27-96	A.D.C.	R.B.S.

FINKBEINER, PETTIS & SROUT, INC.
 CONSULTING ENGINEERS
 ROANOKE, VIRGINIA


SCALE
 HORIZ. 1"=40'
 VERT. 1"=4'
 DESIGNED BY
 R.B.S.
 DRAWN BY
 S.R.P.
 CHECKED BY
 S.A.L./G.G.A.

U.S. 220
U.S. 220 WATER MAIN
BOTETOURT COUNTY, VIRGINIA

CAD NUMBER BOTUW008
PROJECT NUMBER BOTW 502 B
CONTRACT
DATE 4-14-95
9 OF 14

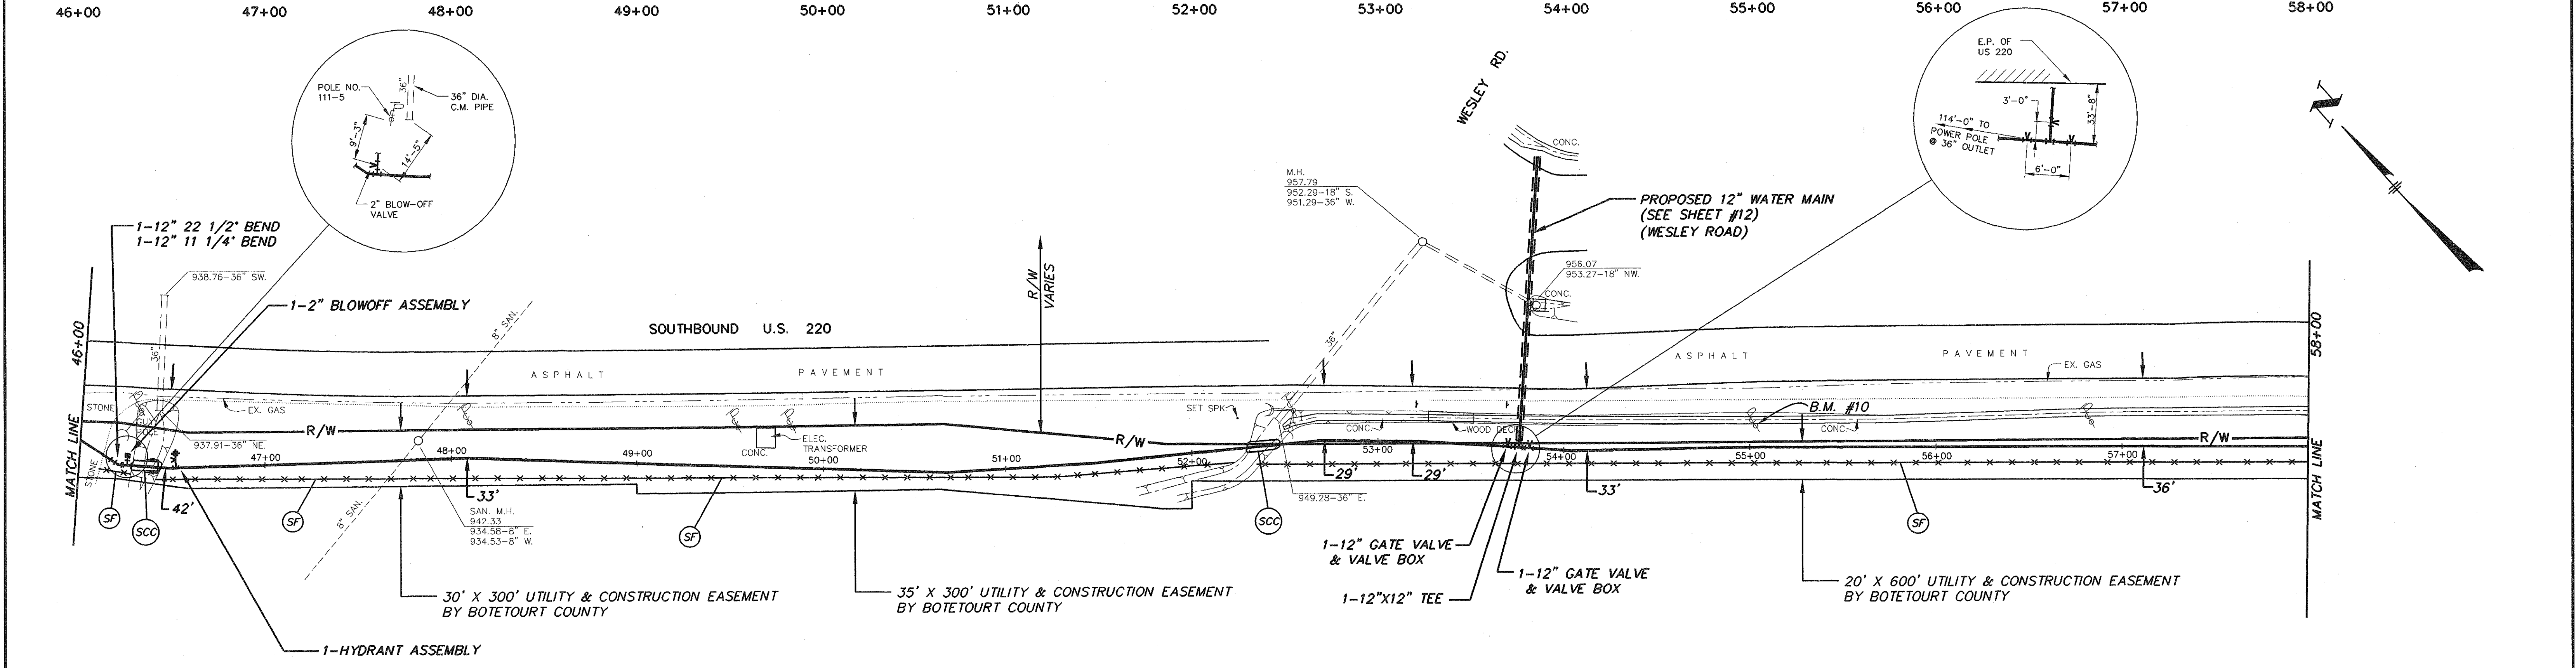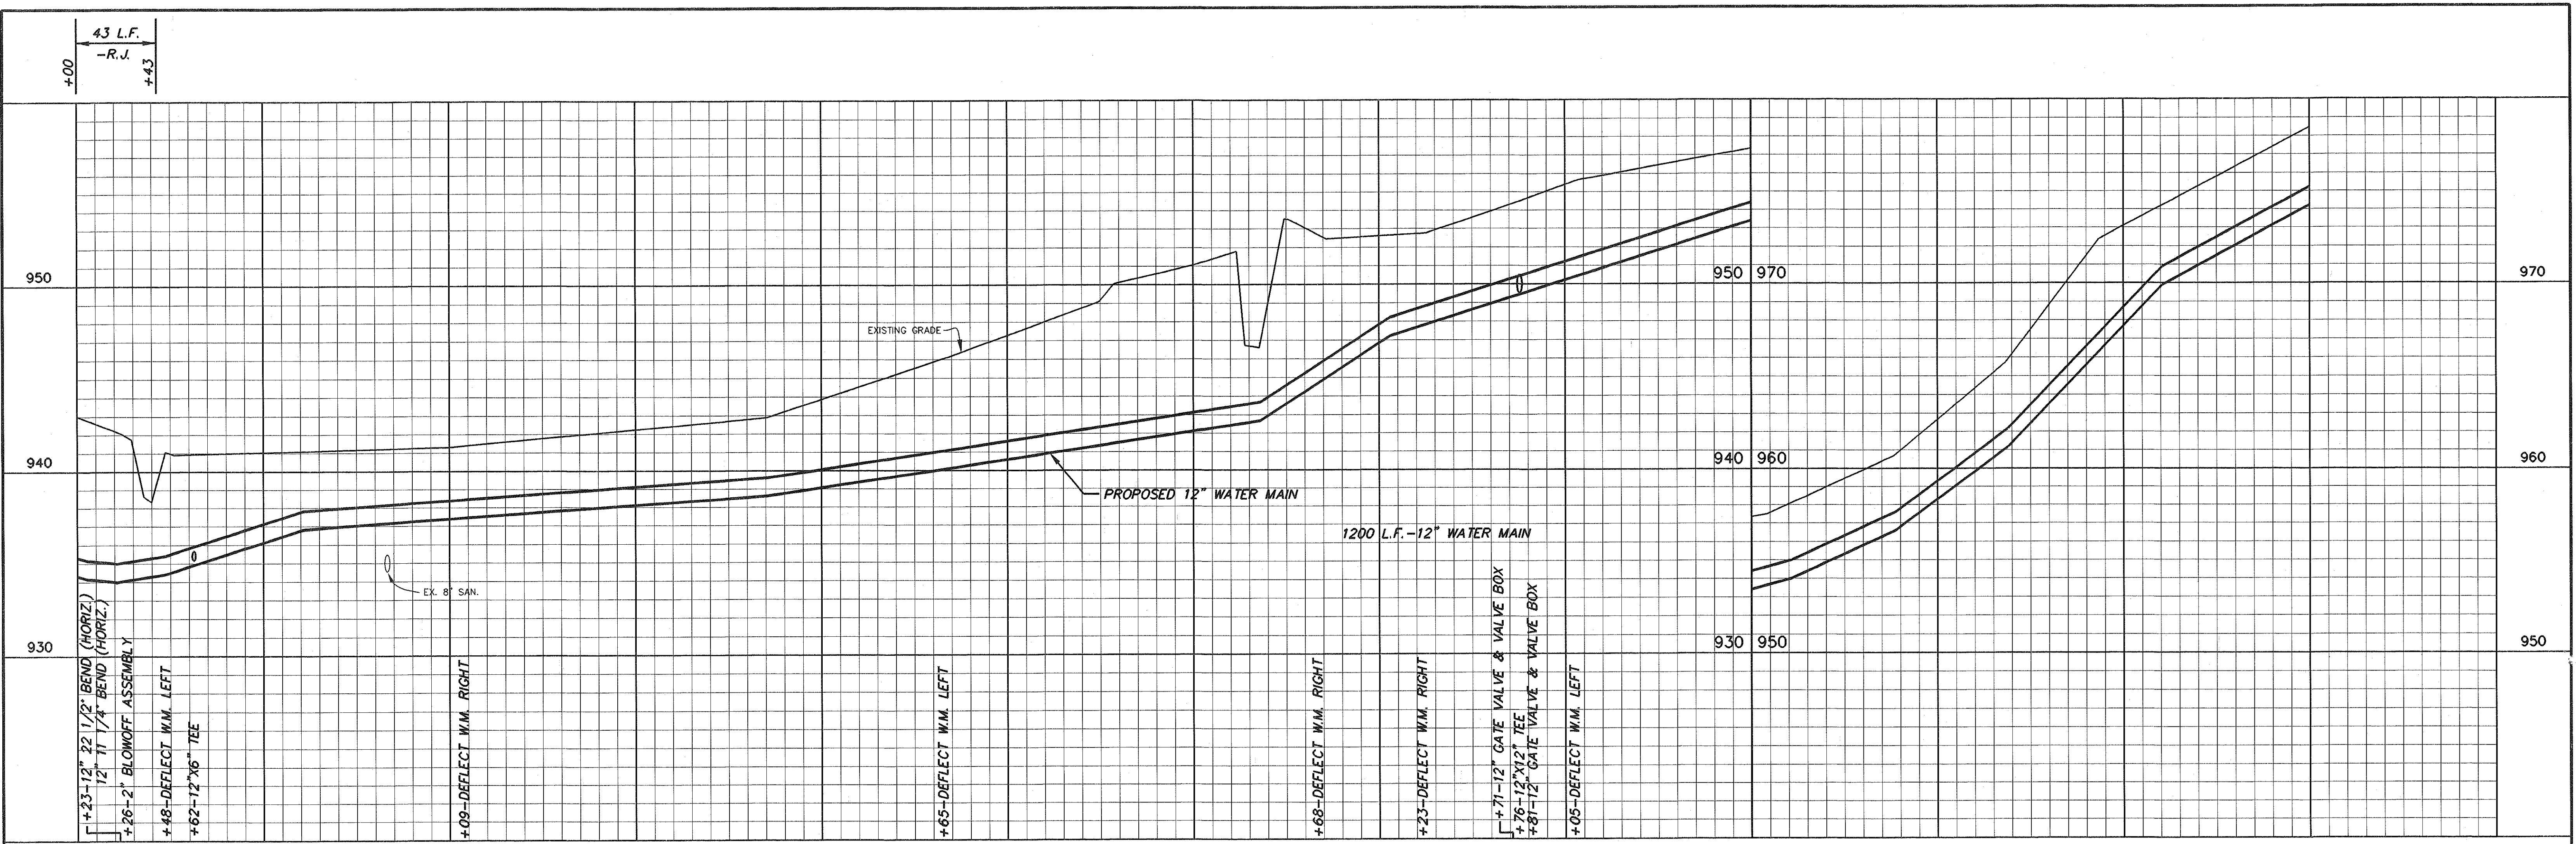

F.P.&S. BENCHMARK #10
SET P.K. NAIL IN TELE/POWER POLE W. SIDE
U.S. 220, 160' SOUTH OF WESLEY RD.
ELEV. 960.49

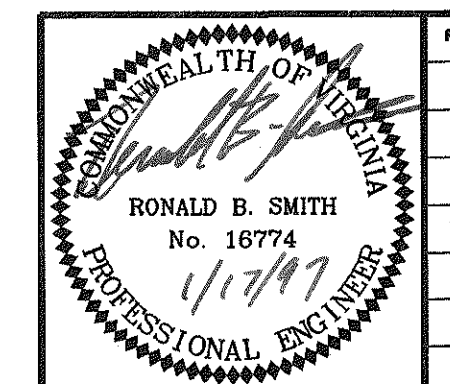



REV. NO.	DESCRIPTION	DATE	BY	APP'D
1	RECORD DRAWING	6-27-96	A.D.C.	R.B.S.

FINKBEINER, PETTIS & STROUT, INC.
CONSULTING ENGINEERS
ROANOKE, VIRGINIA


SCALE
HORIZ. 1"=40'
VERT. 1"=4'
DESIGNED BY
R.B.S.
DRAWN BY
S.R.P.
CHECKED BY
S.A.L./G.G.A.

U.S. 220
U.S. 220 WATER MAIN
BOTETOURT COUNTY, VIRGINIA

CAD NUMBER BOTUW009
PROJECT NUMBER BOTW 502 B
CONTRACT
DATE 4-14-95
10 OF 14

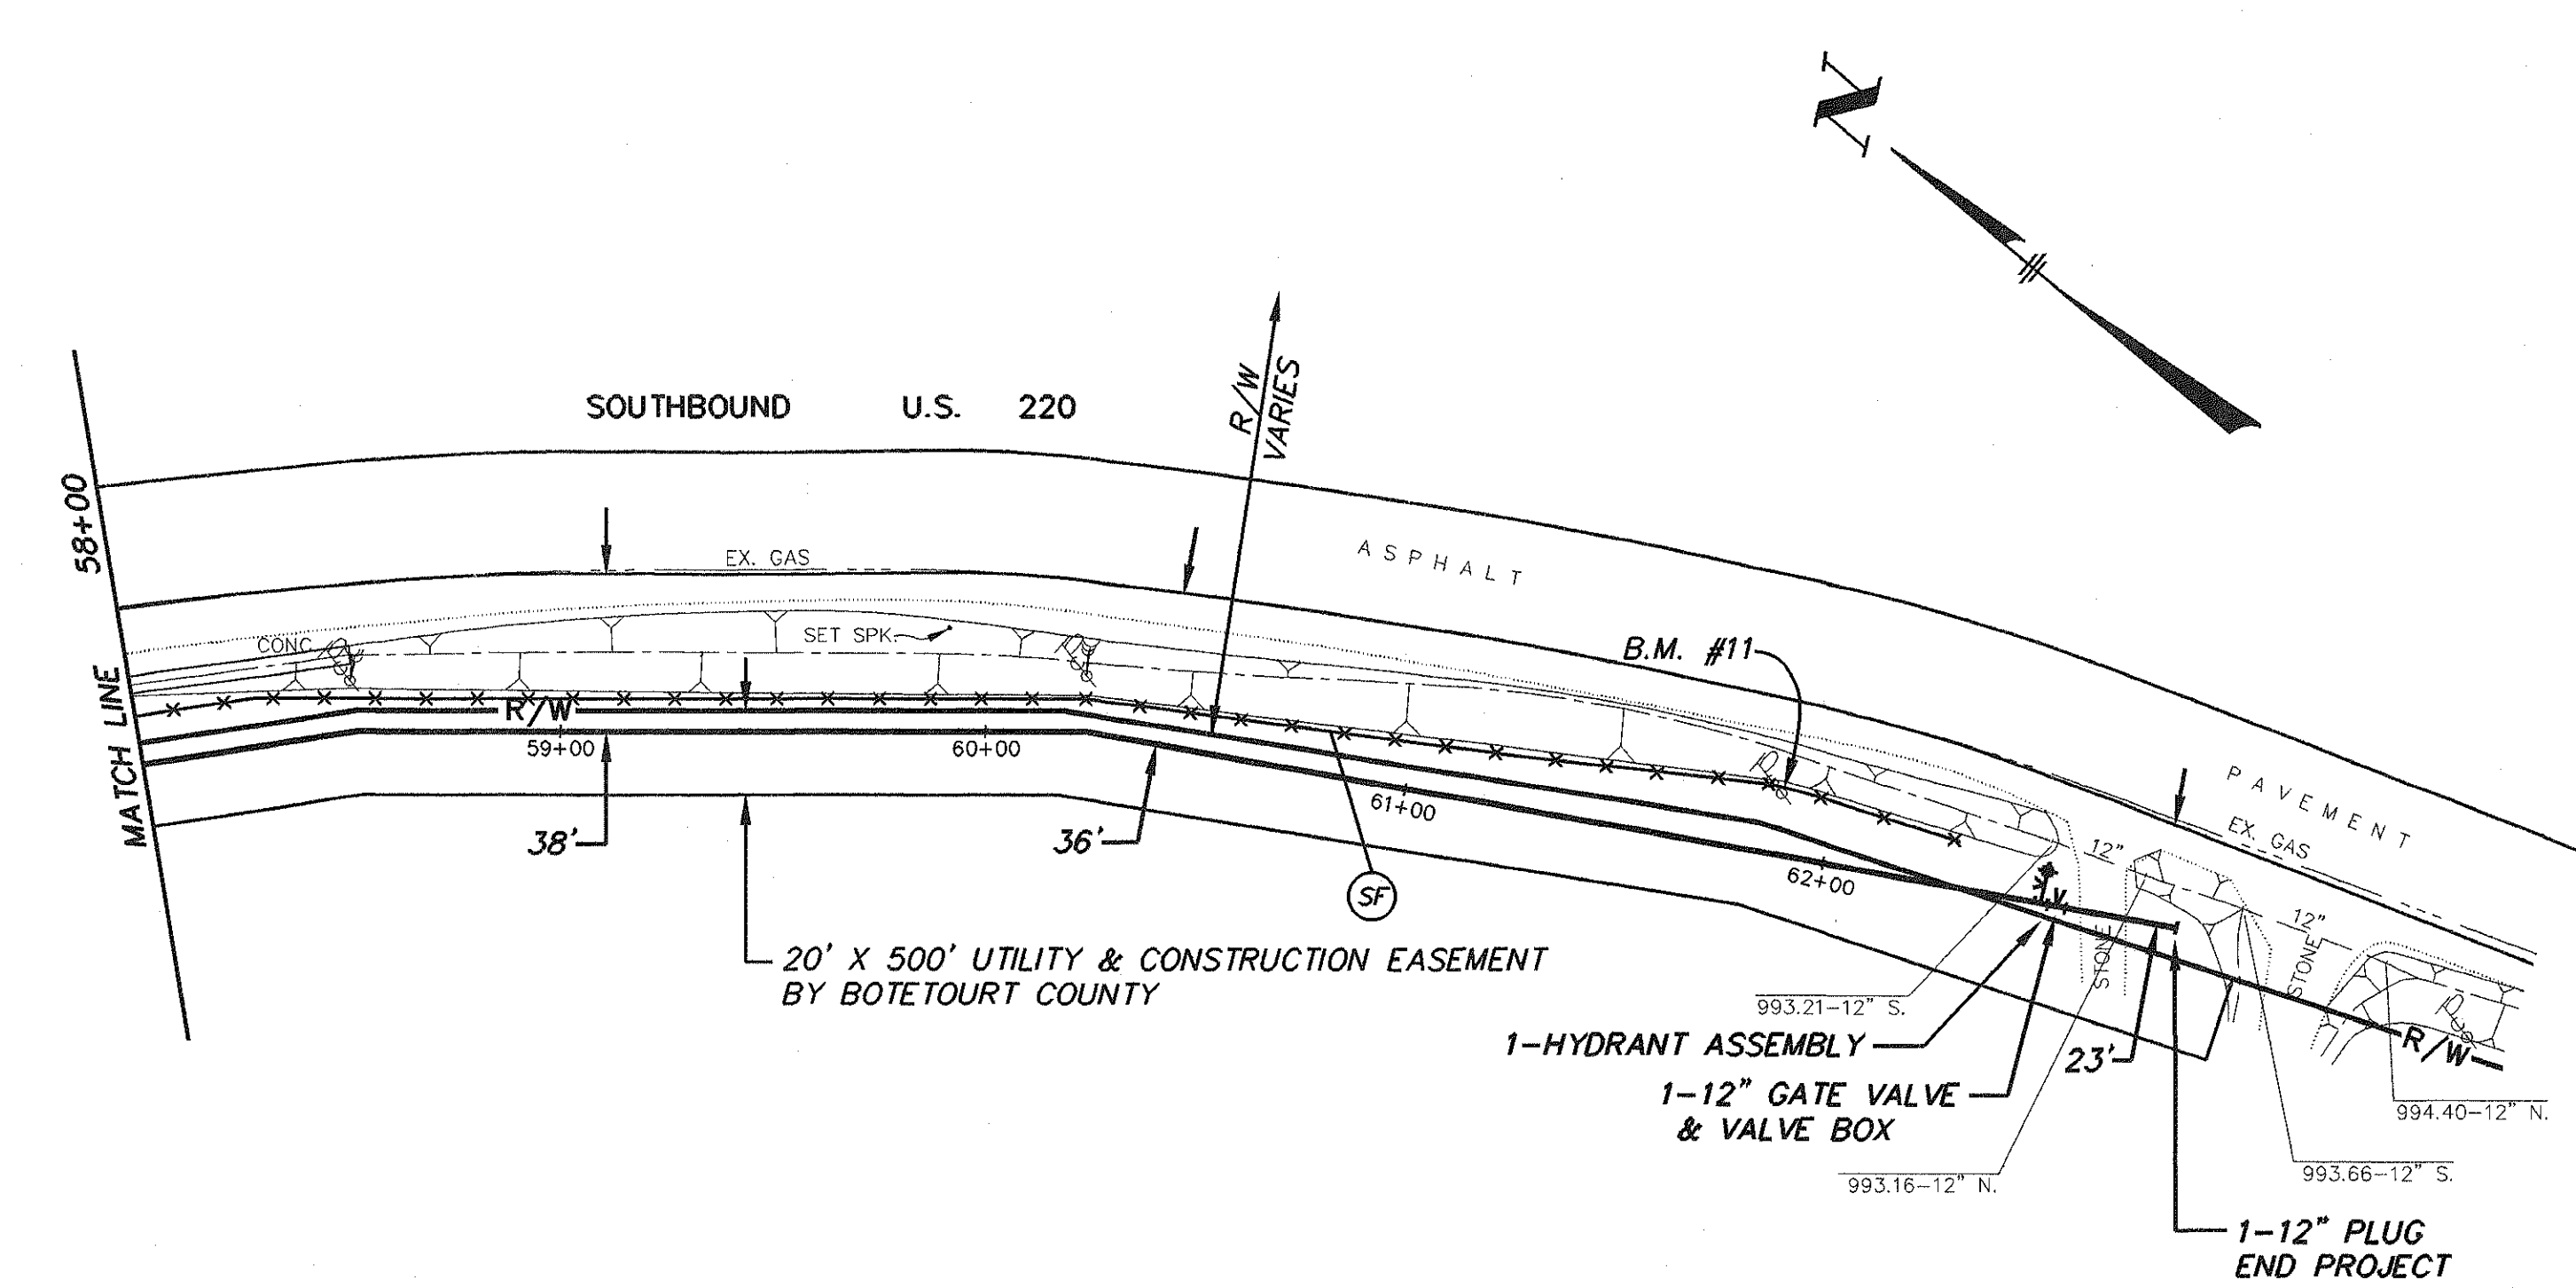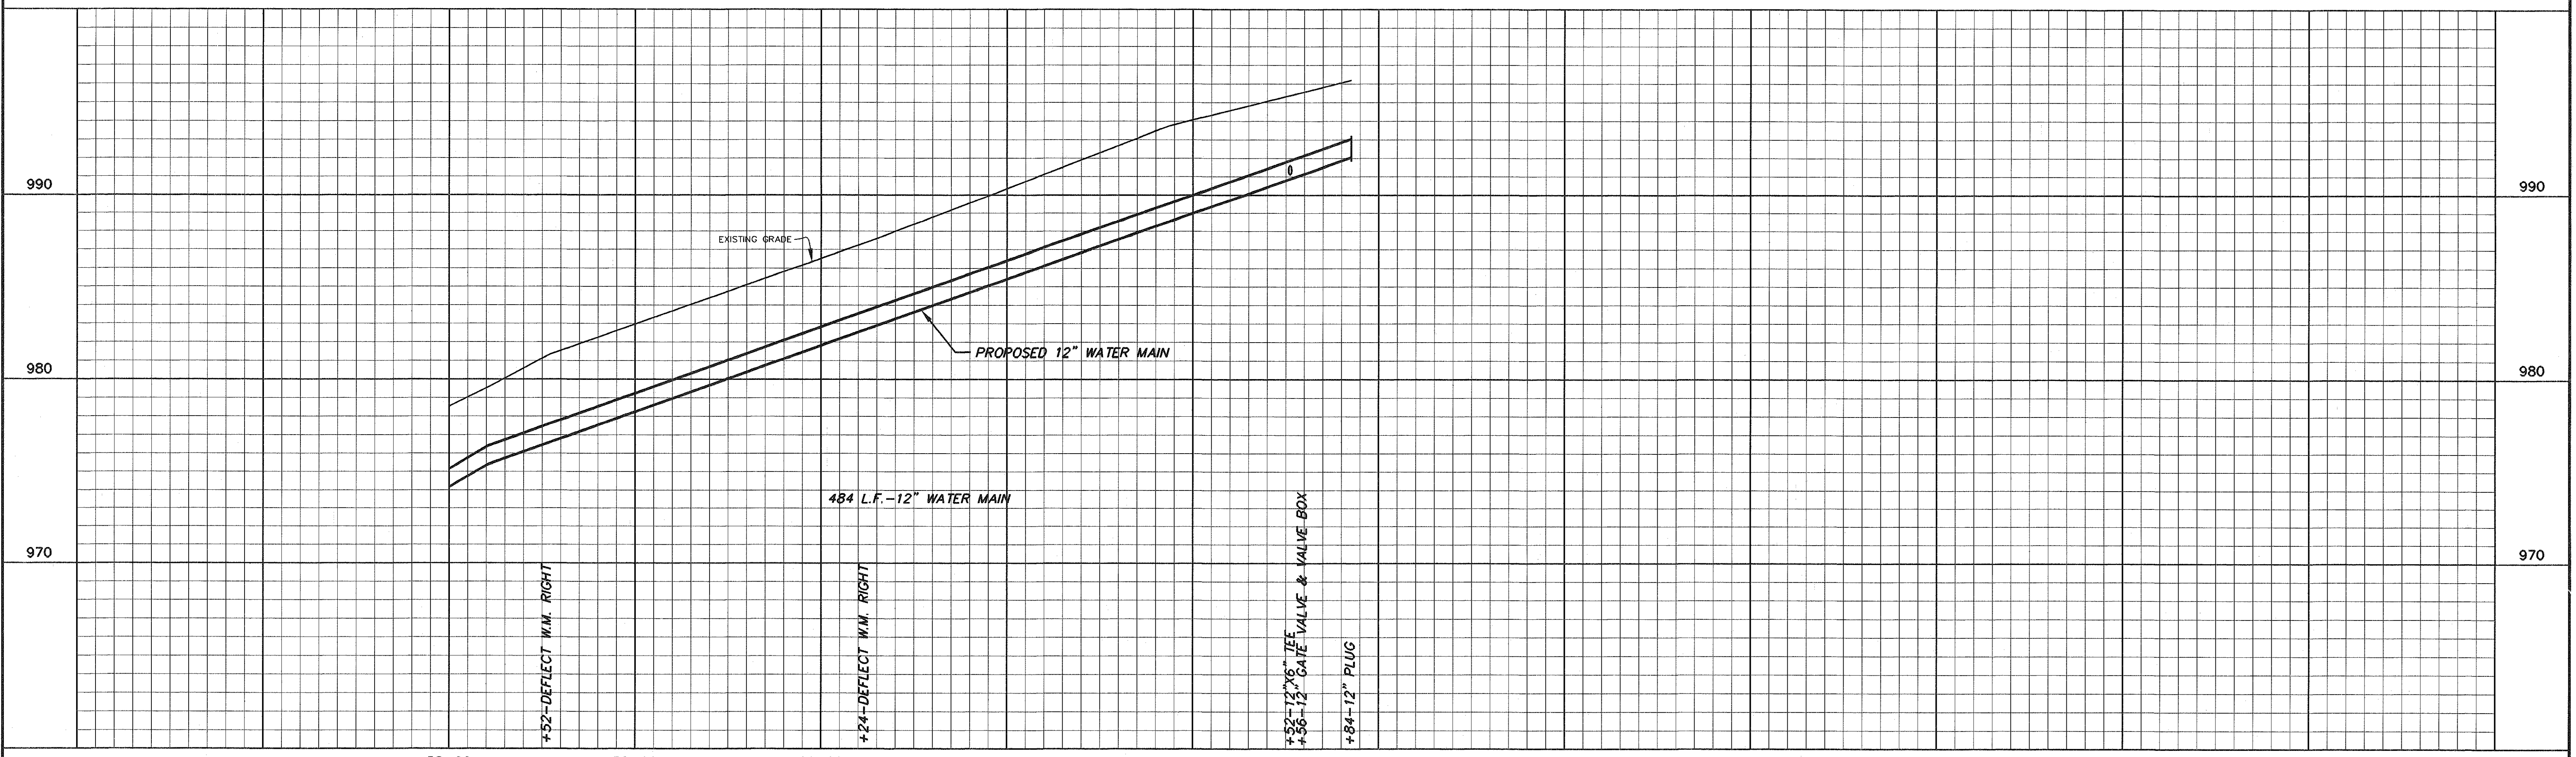

F.P.&S. BENCHMARK #11
 FND. RR. SPK. IN 2ND TELE/POWER POLE
 N. OF APPALACHIAN TRAIL, W. SIDE U.S. 220.
 ELEV. 995.76

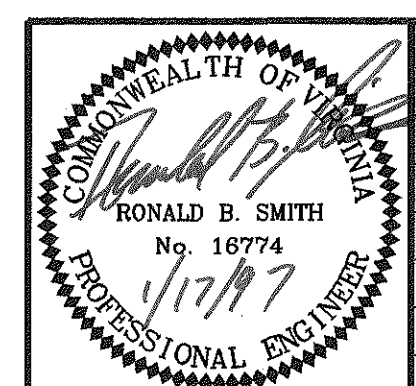

REV. NO.	DESCRIPTION	DATE	BY	APP'D
1	RECORD DRAWING	6-27-96	A.D.C.	R.B.S.



FINKBEINER, PETTIS & STROUT, INC.
CONSULTING ENGINEERS
 ROANOKE, VIRGINIA

SCALE
 HORIZ. 1"=40'
 VERT. 1"=4'
 DESIGNED BY
 R.B.S.
 DRAWN BY
 S.R.P.
 CHECKED BY
 S.A.L./G.G.A.


U.S. 220
U.S. 220 WATER MAIN
 BOTETOURT COUNTY, VIRGINIA

CAD NUMBER BOTUW010
PROJECT NUMBER BOTW 502 B
CONTRACT
DATE 4-14-95
11 OF 14


120 L.F.-R.J. 100 L.F.-R.J. 158 L.F.-R.J.

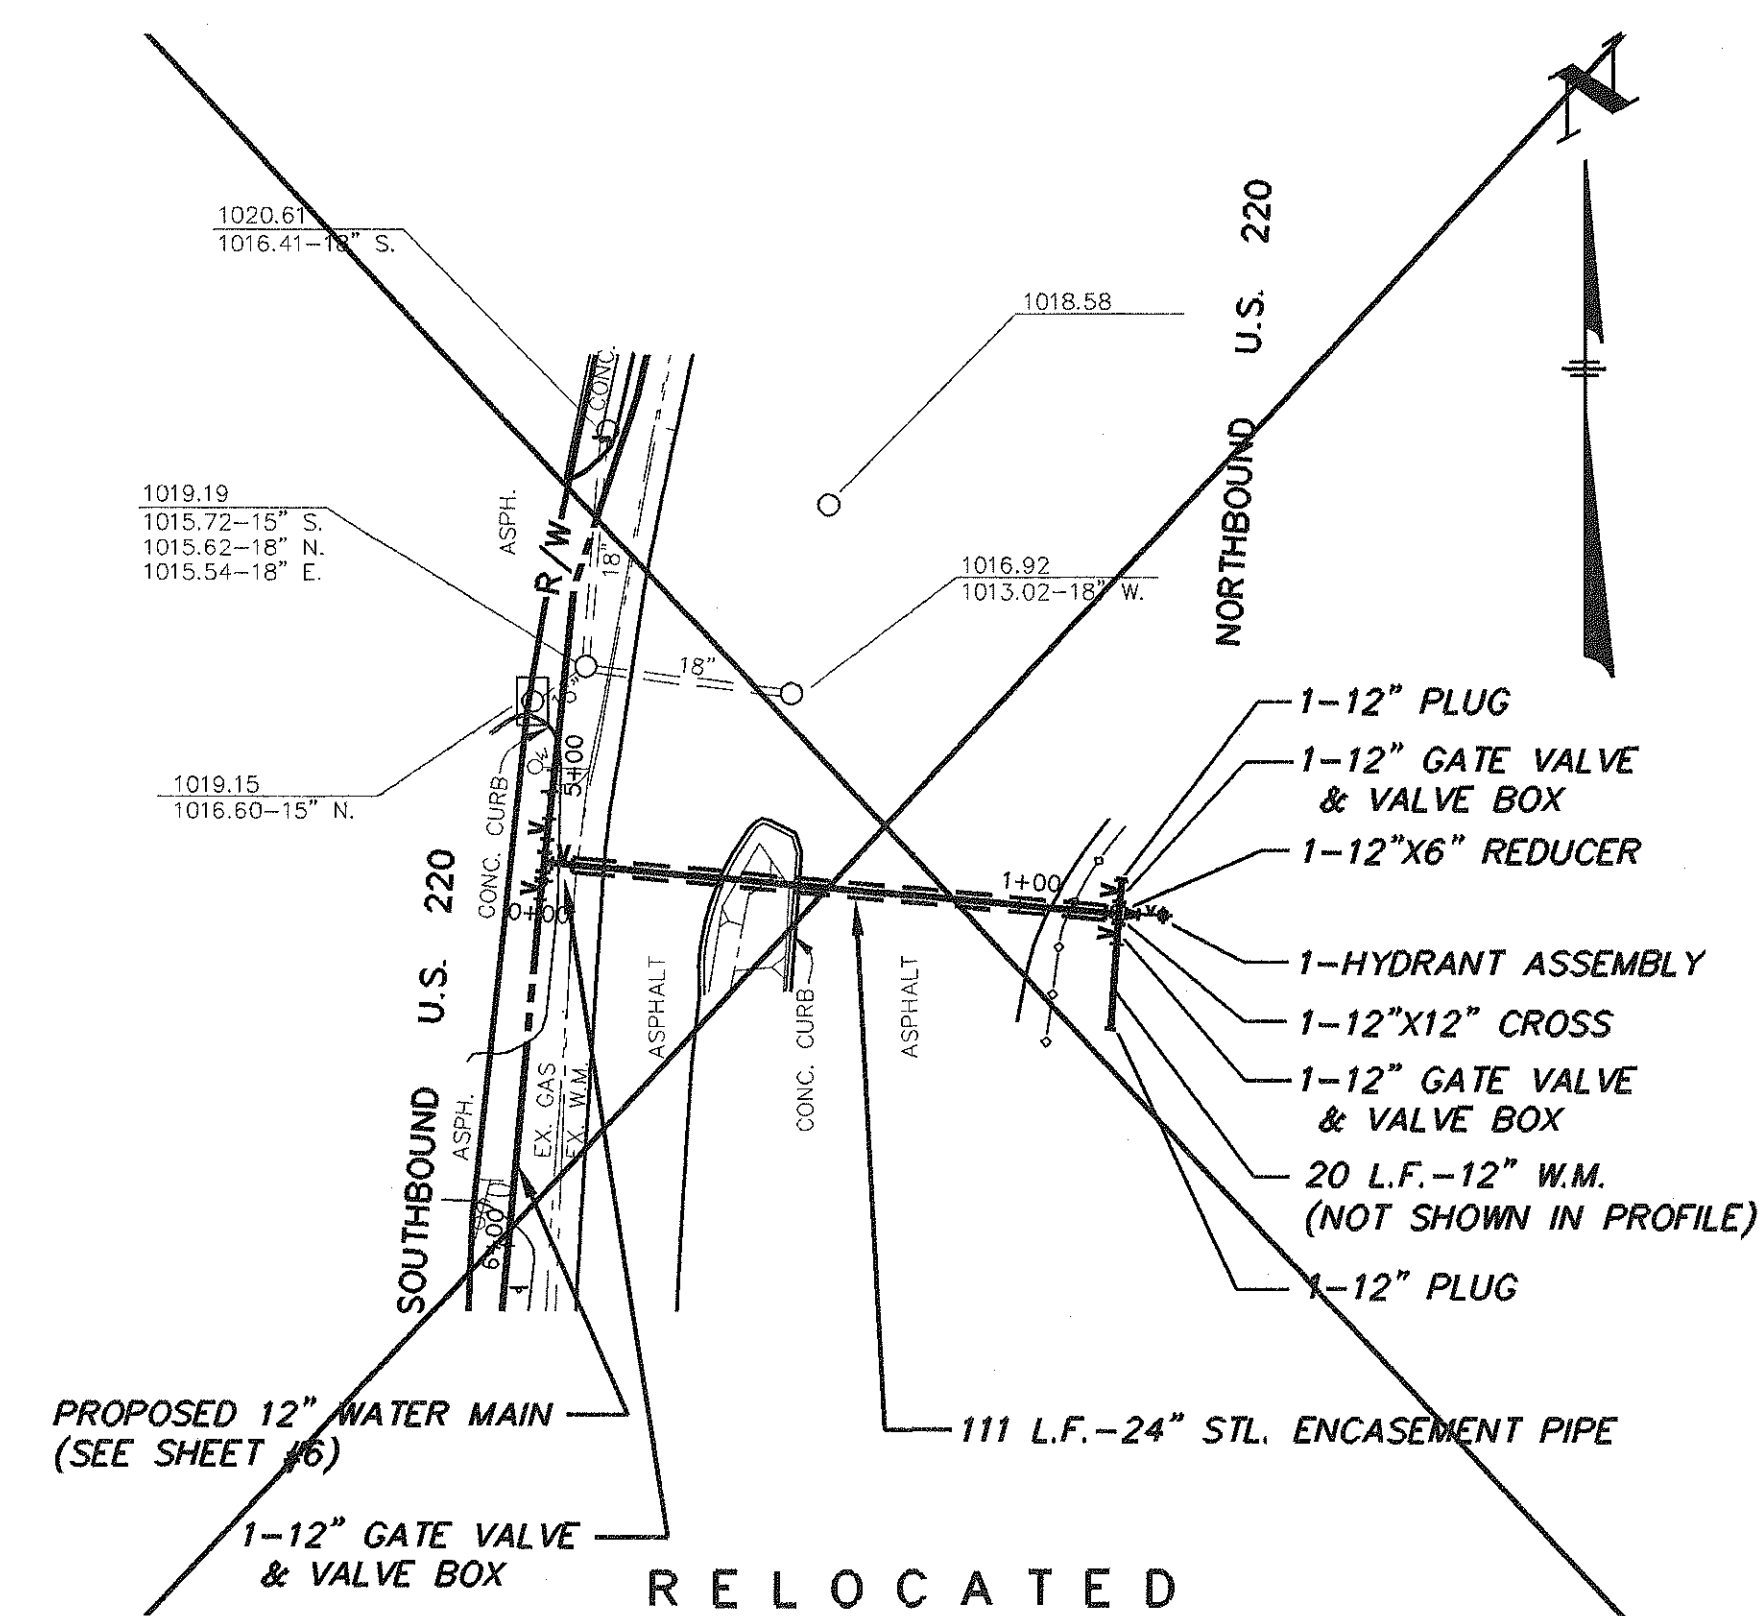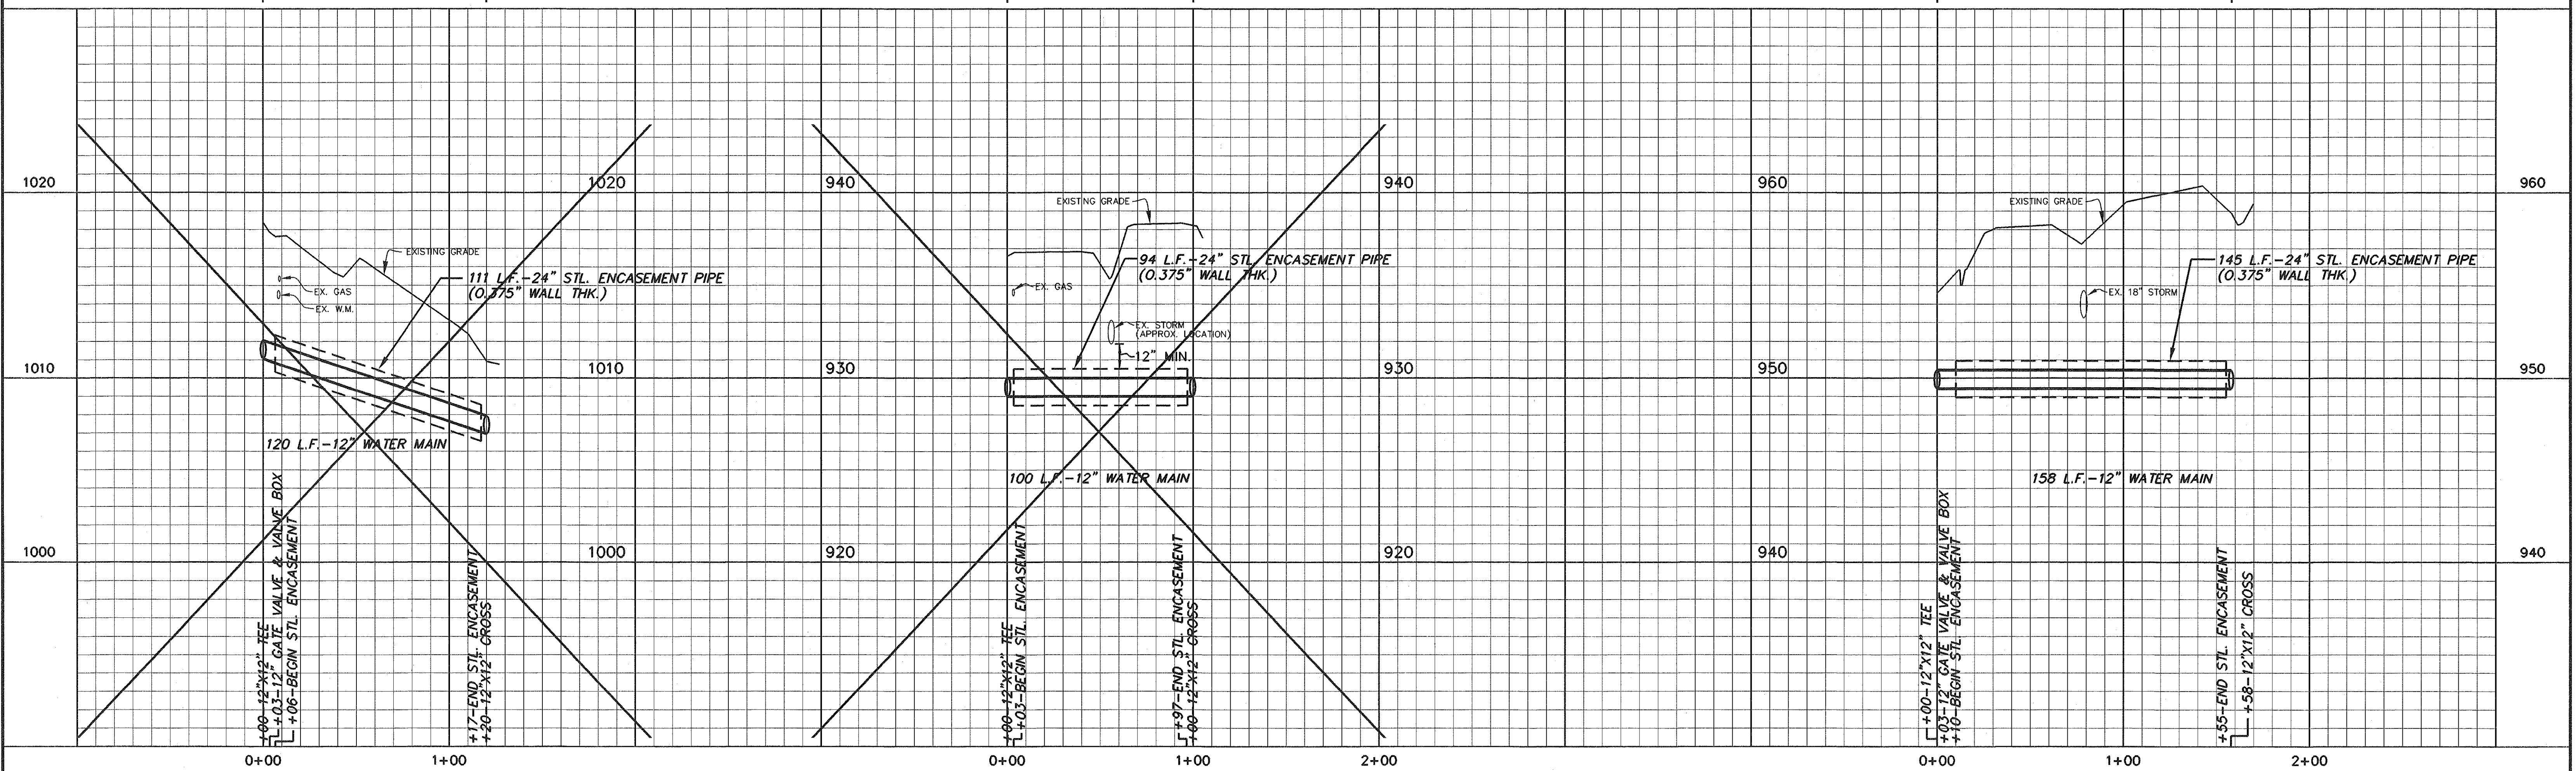

RELOCATED
VALLEY ROAD CROSSING
(RELOCATED 415' SOUTH)
(SEE SHEET 6 FOR NEW LOCATION)

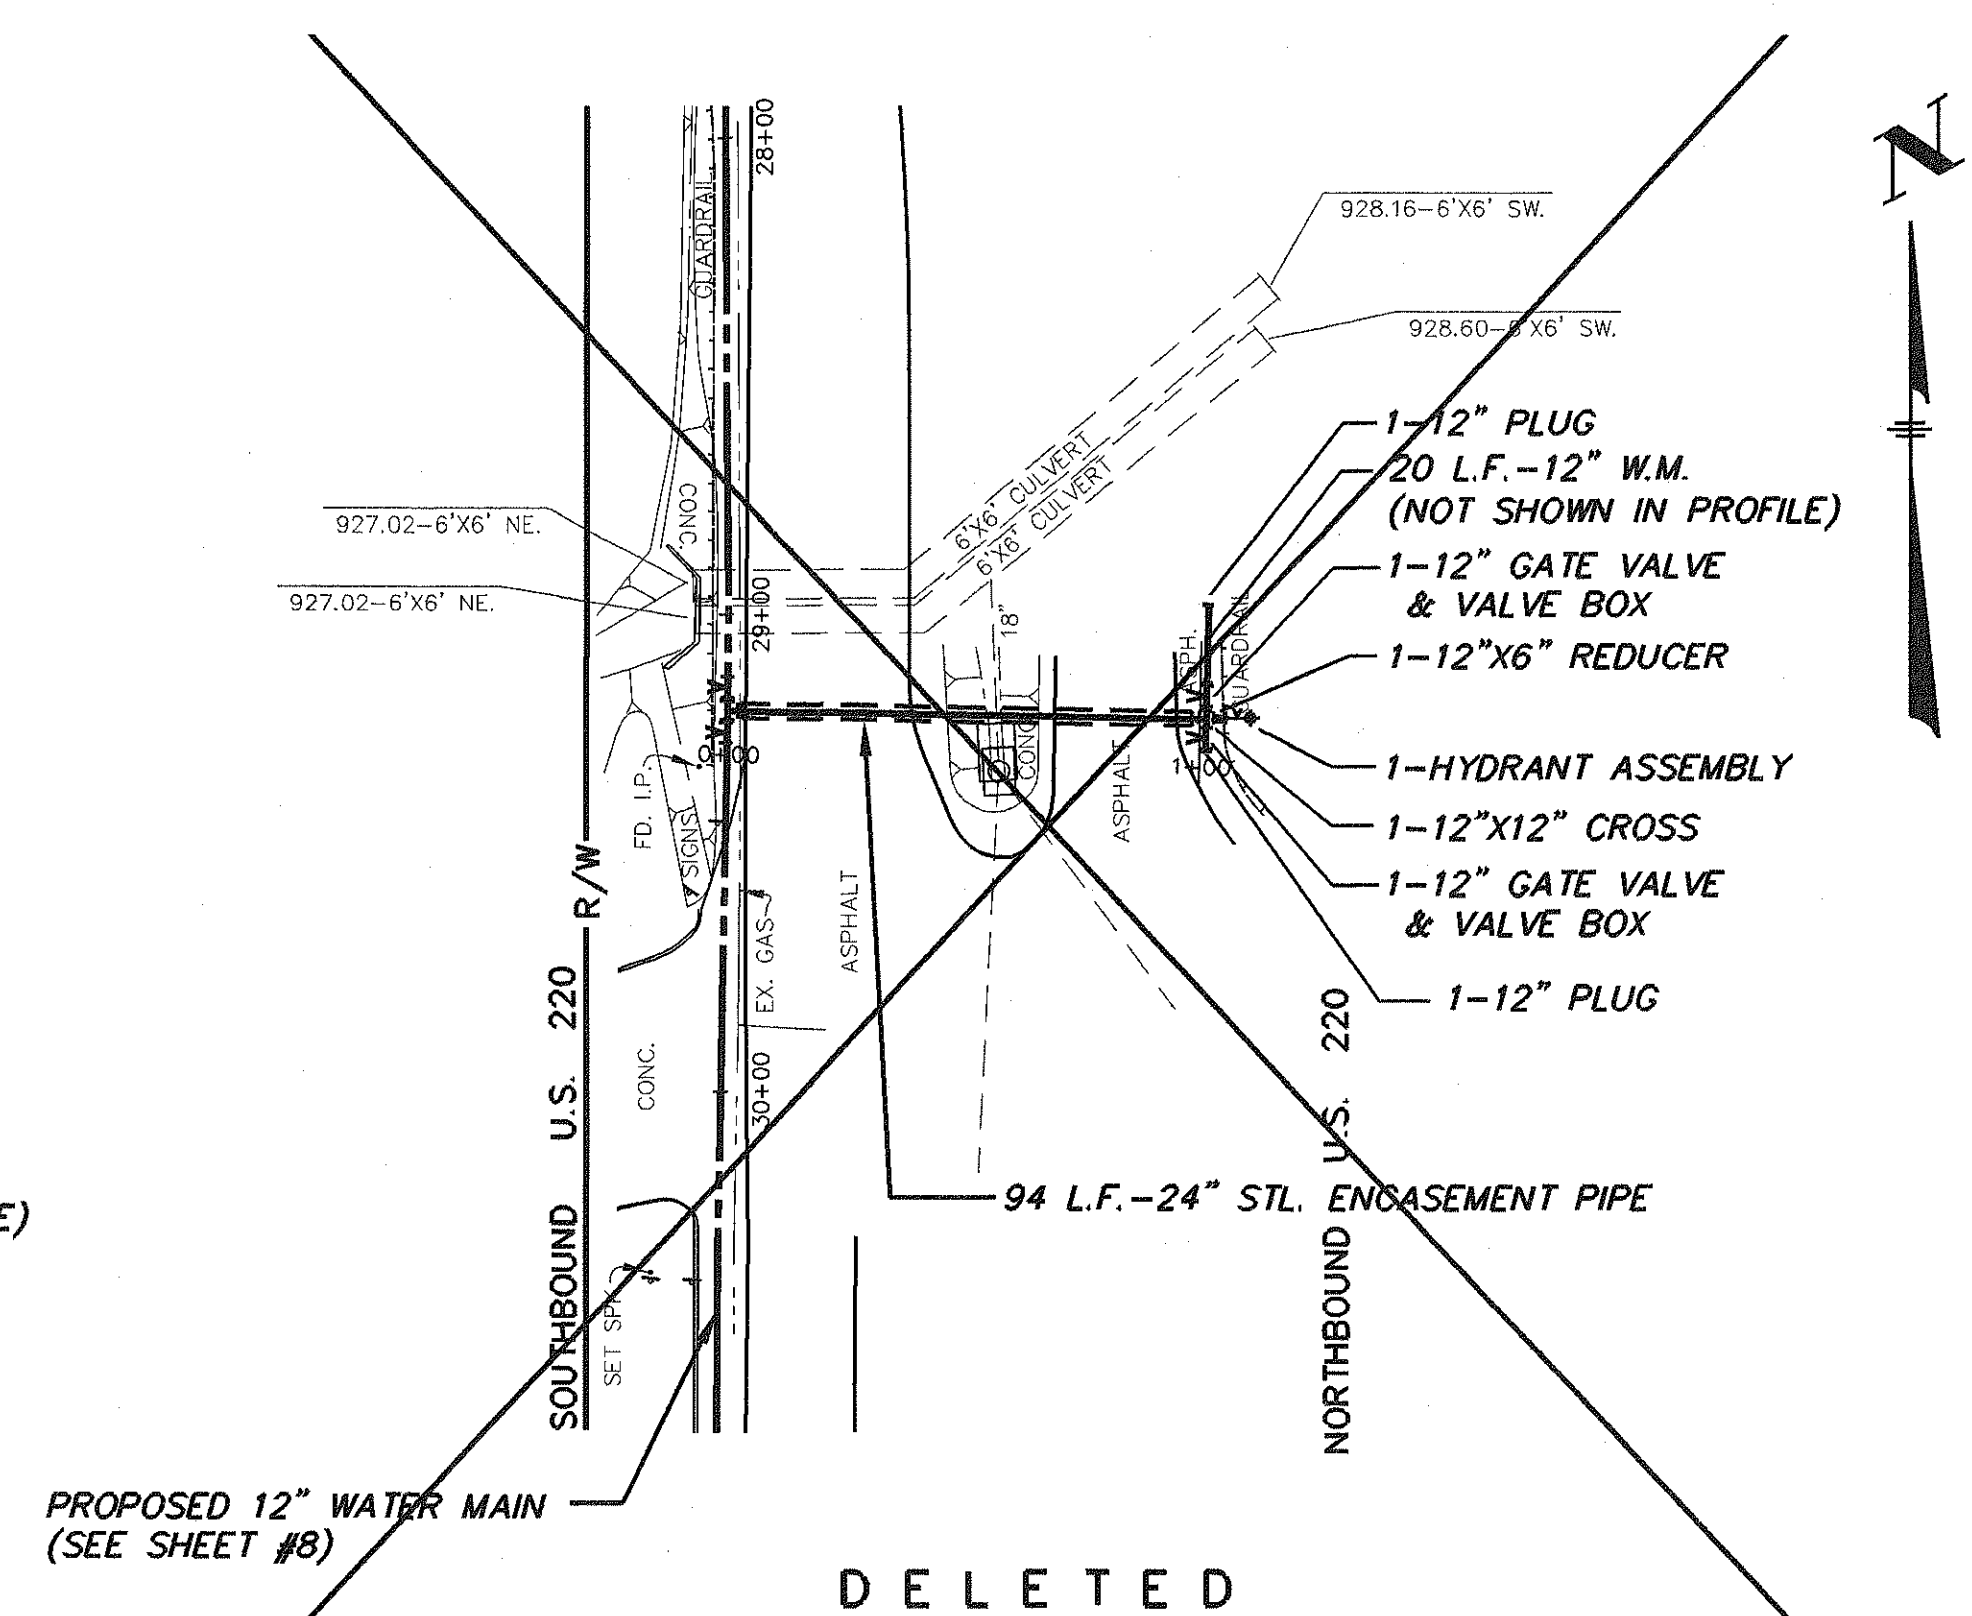


DELETED
WENDOVER ROAD CROSSING

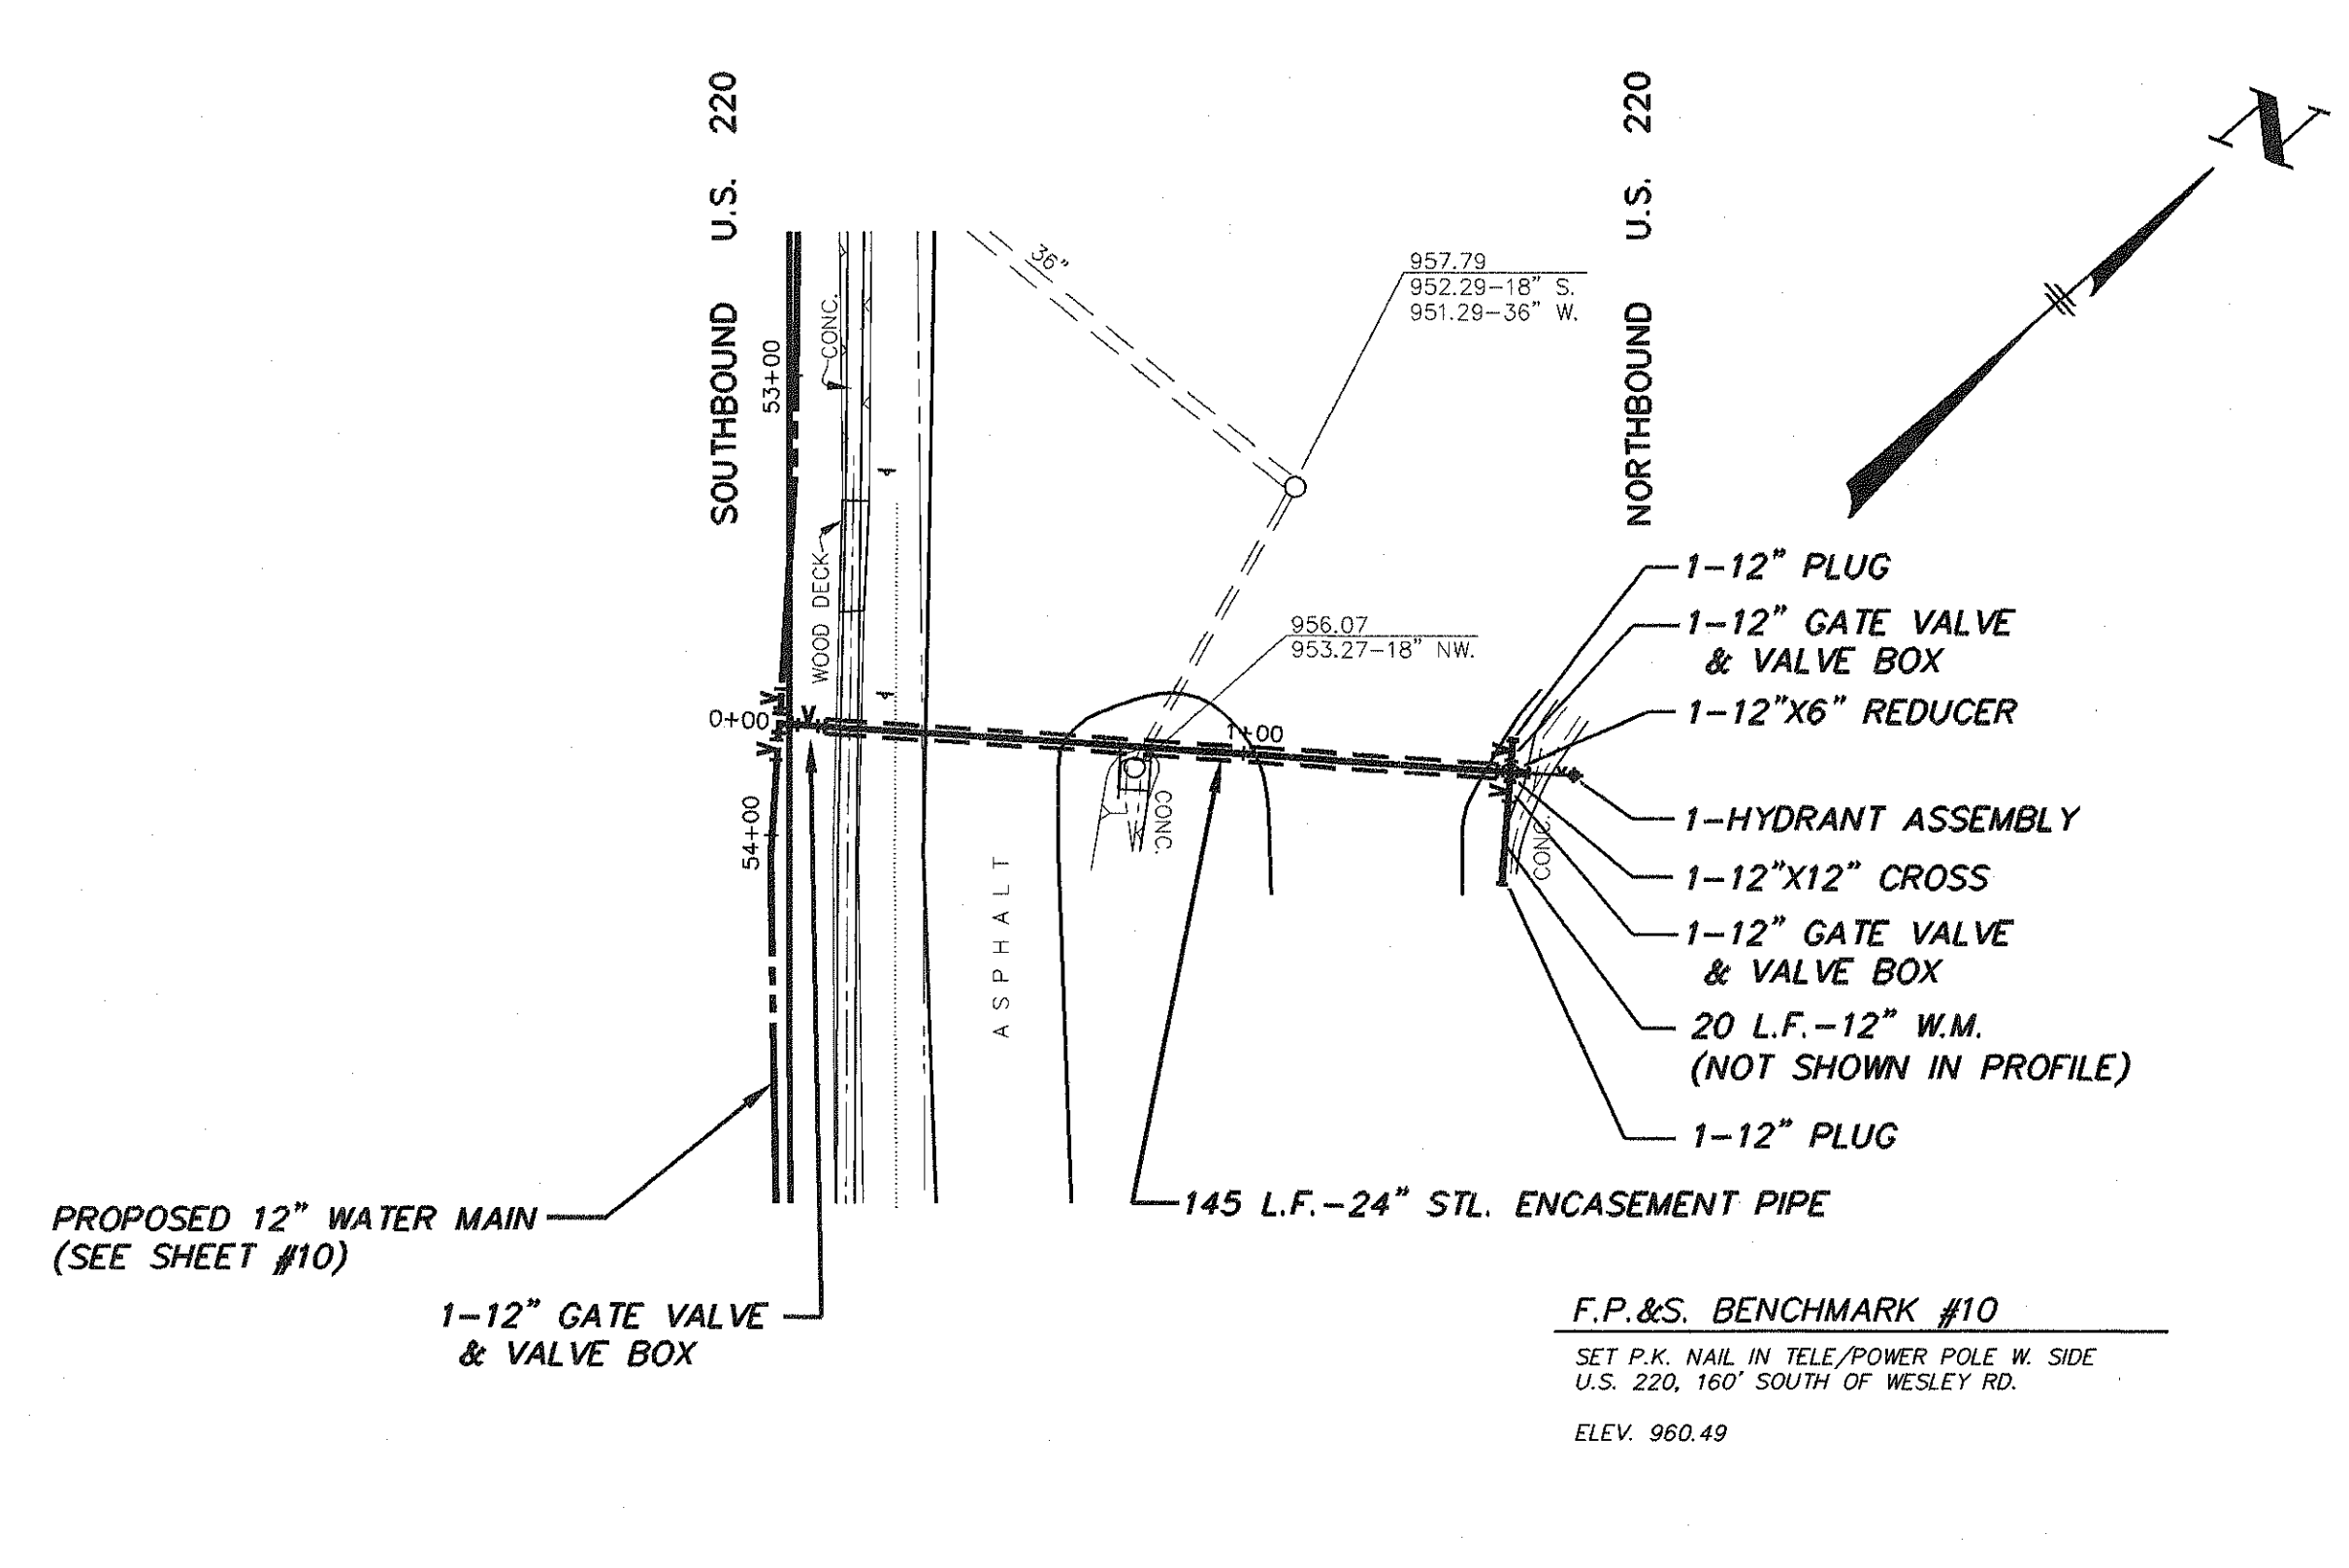

WESLEY ROAD CROSSING

F.P.&S. BENCHMARK #5
FD, RR, SPK, IN TELE/POWER POLE
SW. CORNER OF U.S. 220 & CATAMBA RD.
ELEV. 1033.79

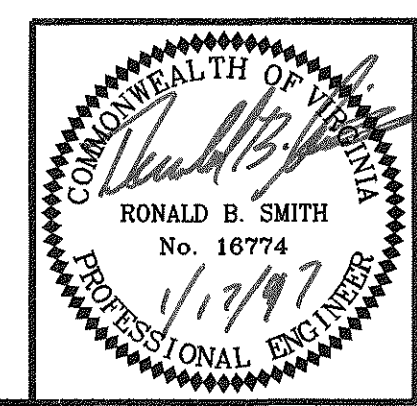



REV. NO.	DESCRIPTION	DATE	BY	APP'D
1	RECORD DRAWING	6-27-96	A.D.C.	R.B.S.

FINKBEINER, PETTIS & SROUT, INC.
CONSULTING ENGINEERS
ROANOKE, VIRGINIA

SCALE
HORIZ. 1"=40'
VERT. 1"=4'
DESIGNED BY
R.B.S.
DRAWN BY
S.R.P.
CHECKED BY
S.A.L./G.G.A.

U.S. 220
U.S. 220 WATER MAIN
BOTETOURT COUNTY, VIRGINIA

CAD NUMBER BOTUW011
PROJECT NUMBER BOTW 502 B
CONTRACT
DATE 4-14-95
12 OF 14

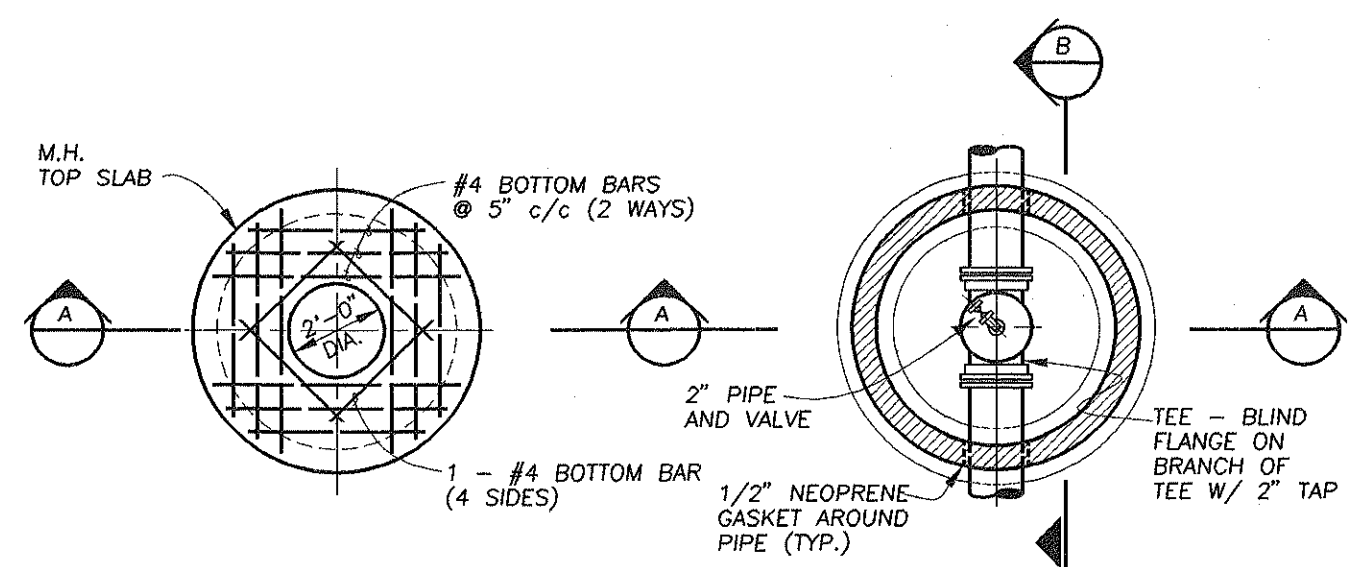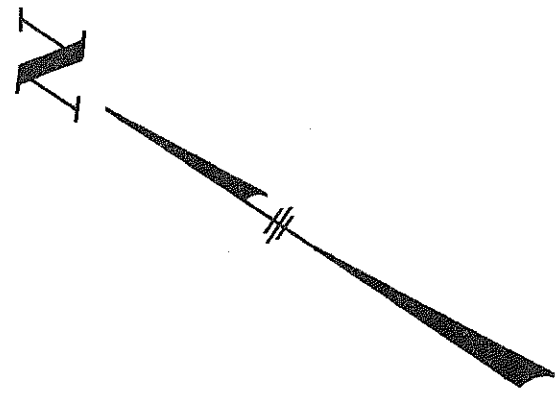


TOP SLAB REINFORCING PLAN

SECTIONAL PLAN


AIR RELEASE & MANHOLE	
LOCATION	STATION
CATAWBA RD. (S.R. 779)	12+05
U.S. 220	0+05
U.S. 220	40+00

NOTE: SEE PLANS FOR SIZE OF TEE.

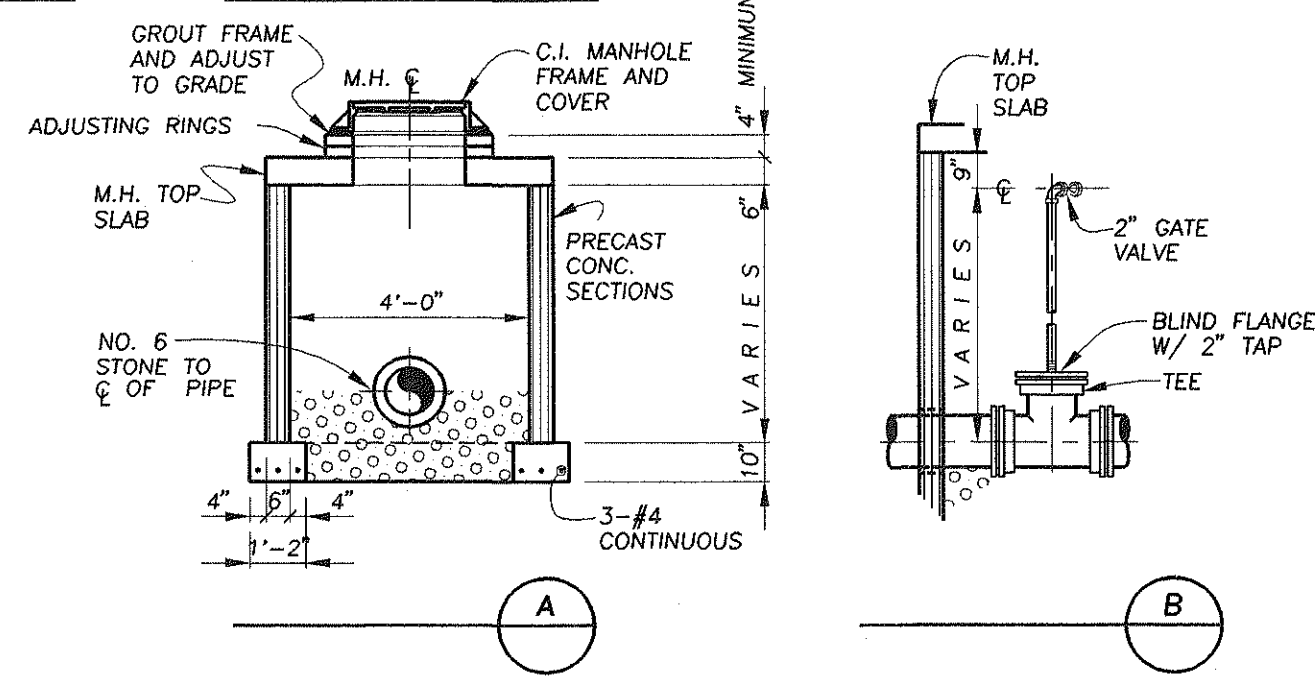


AIR RELEASE & MANHOLE DETAILS

1/4" = 1'-0"

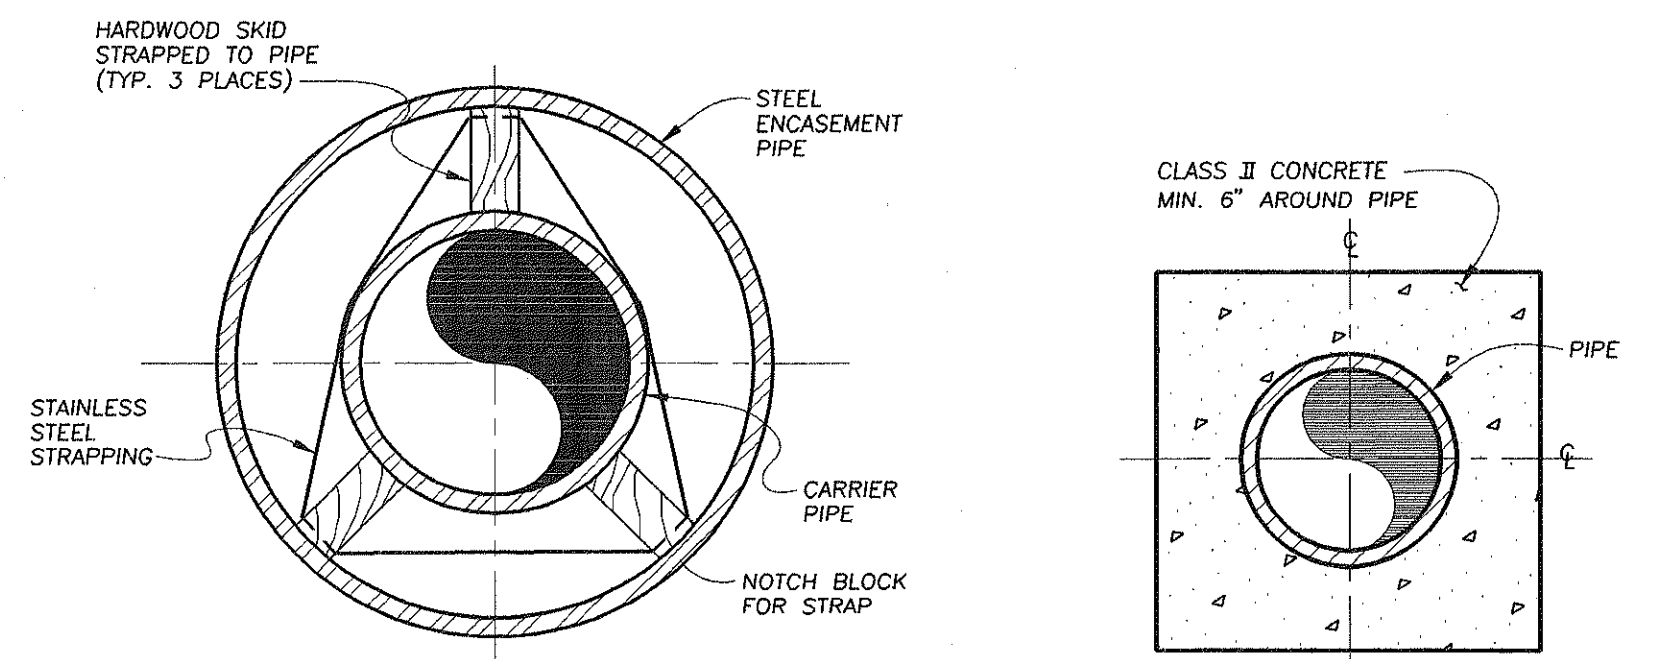


STEEL ENCASEMENT PIPE DETAIL
NO SCALE

CONCRETE PIPE ENCASEMENT
NO SCALE

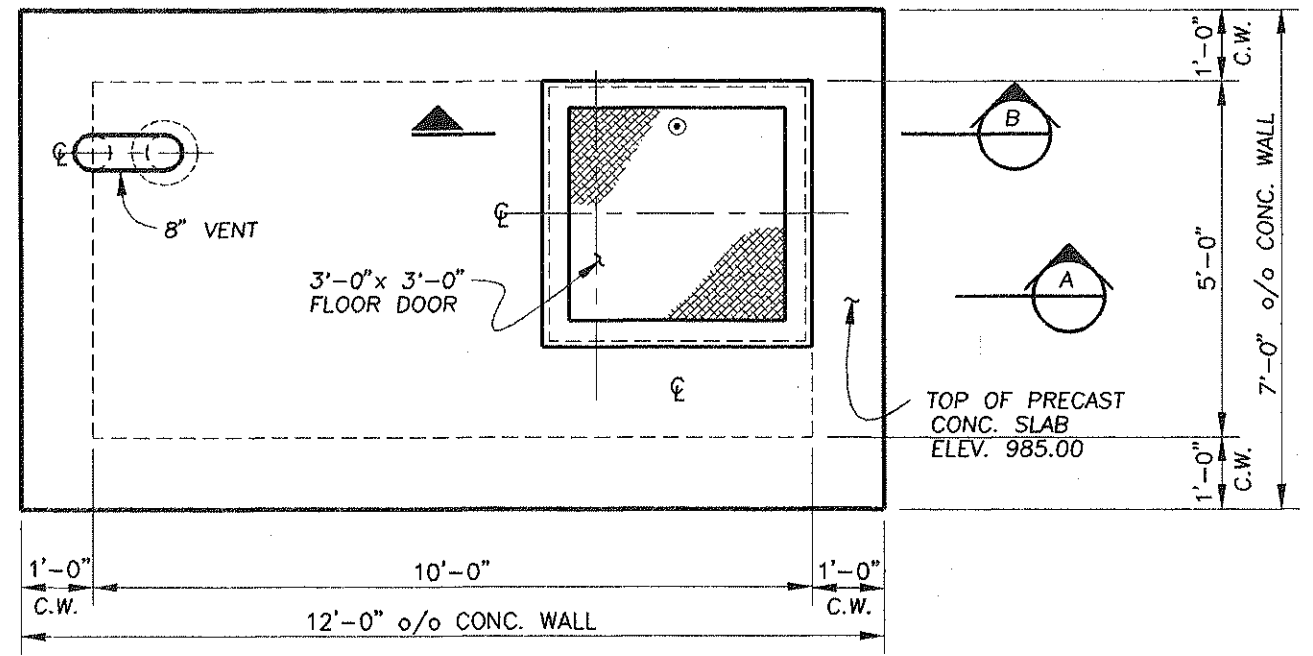


PLAN

SOUTHBOUND U.S. 220

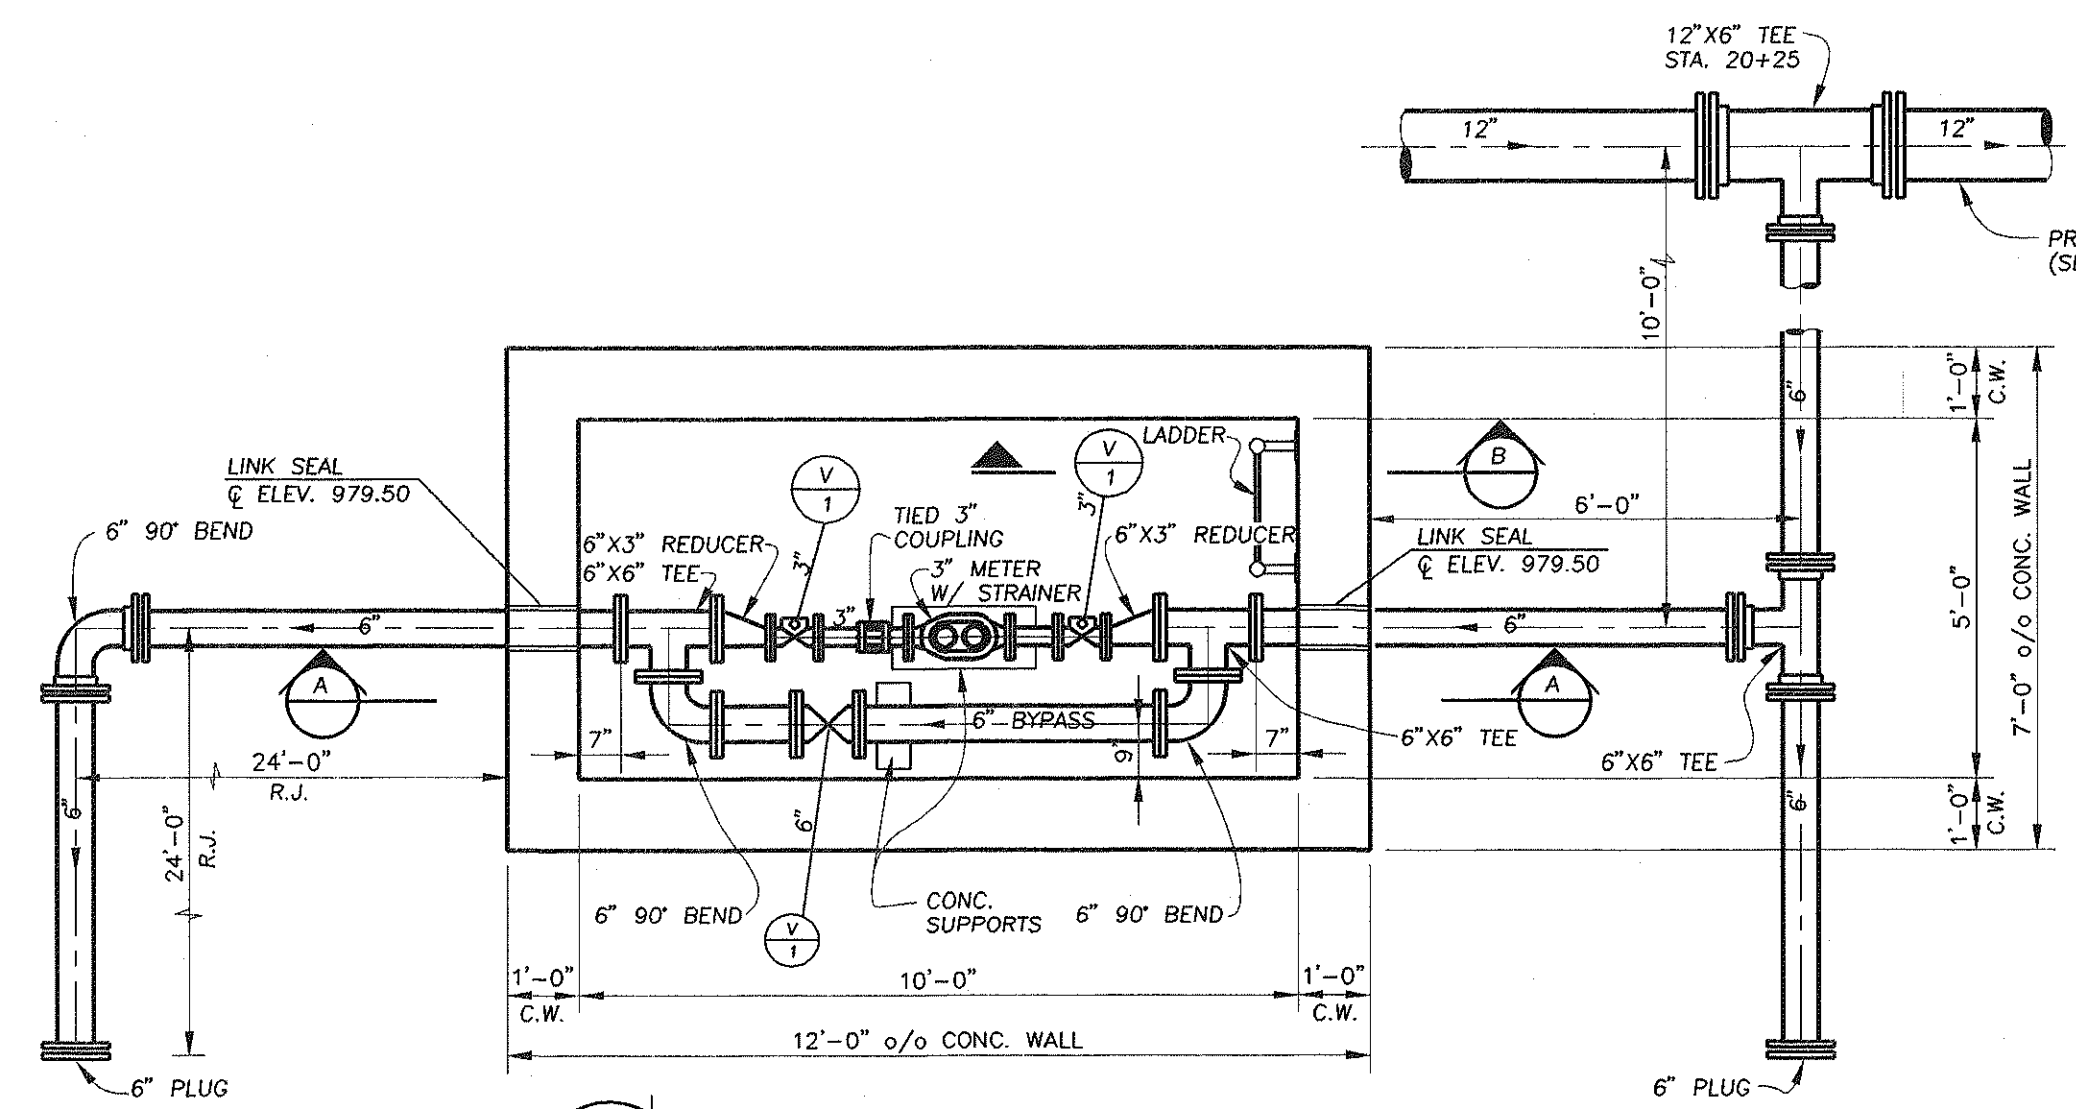


SECTIONAL PLAN

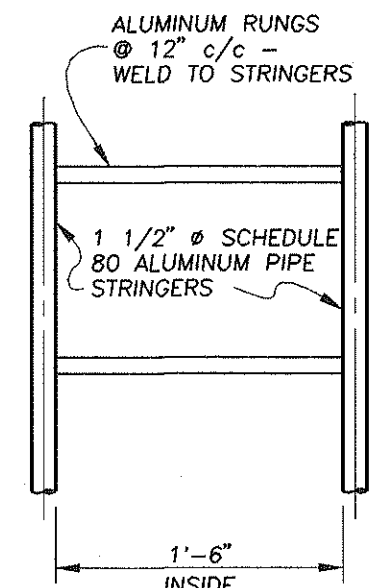


ELEVATION
LADDER DETAIL

1" = 1'-0"

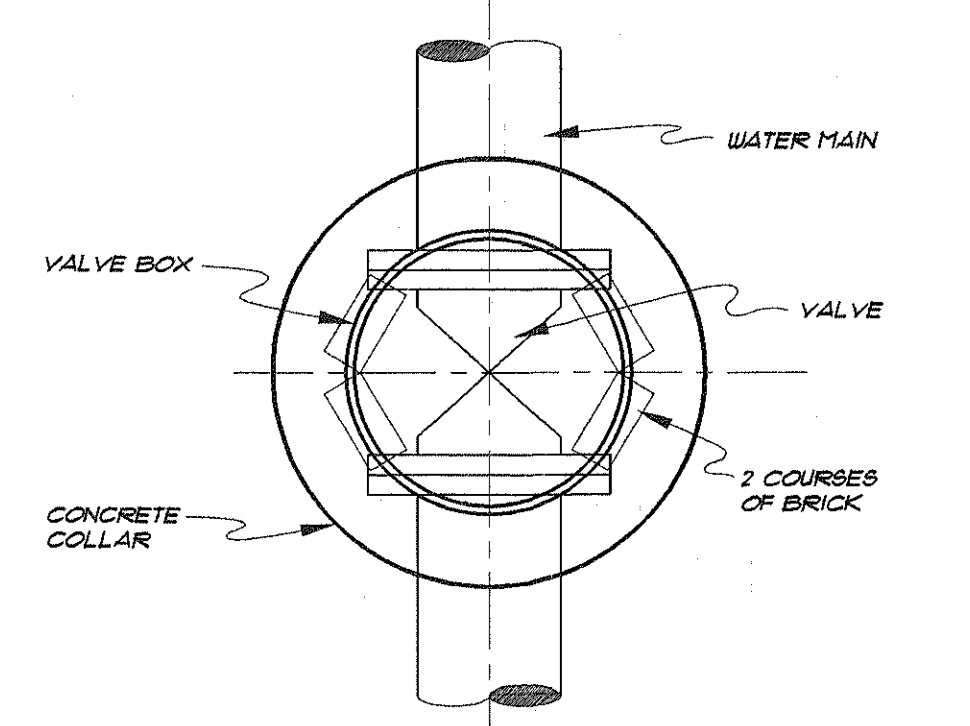


PLAN

NOTE: IN PAVEMENT, RECESS CONCRETE THE DEPTH OF THE FINAL LIFT OF ASPHALT

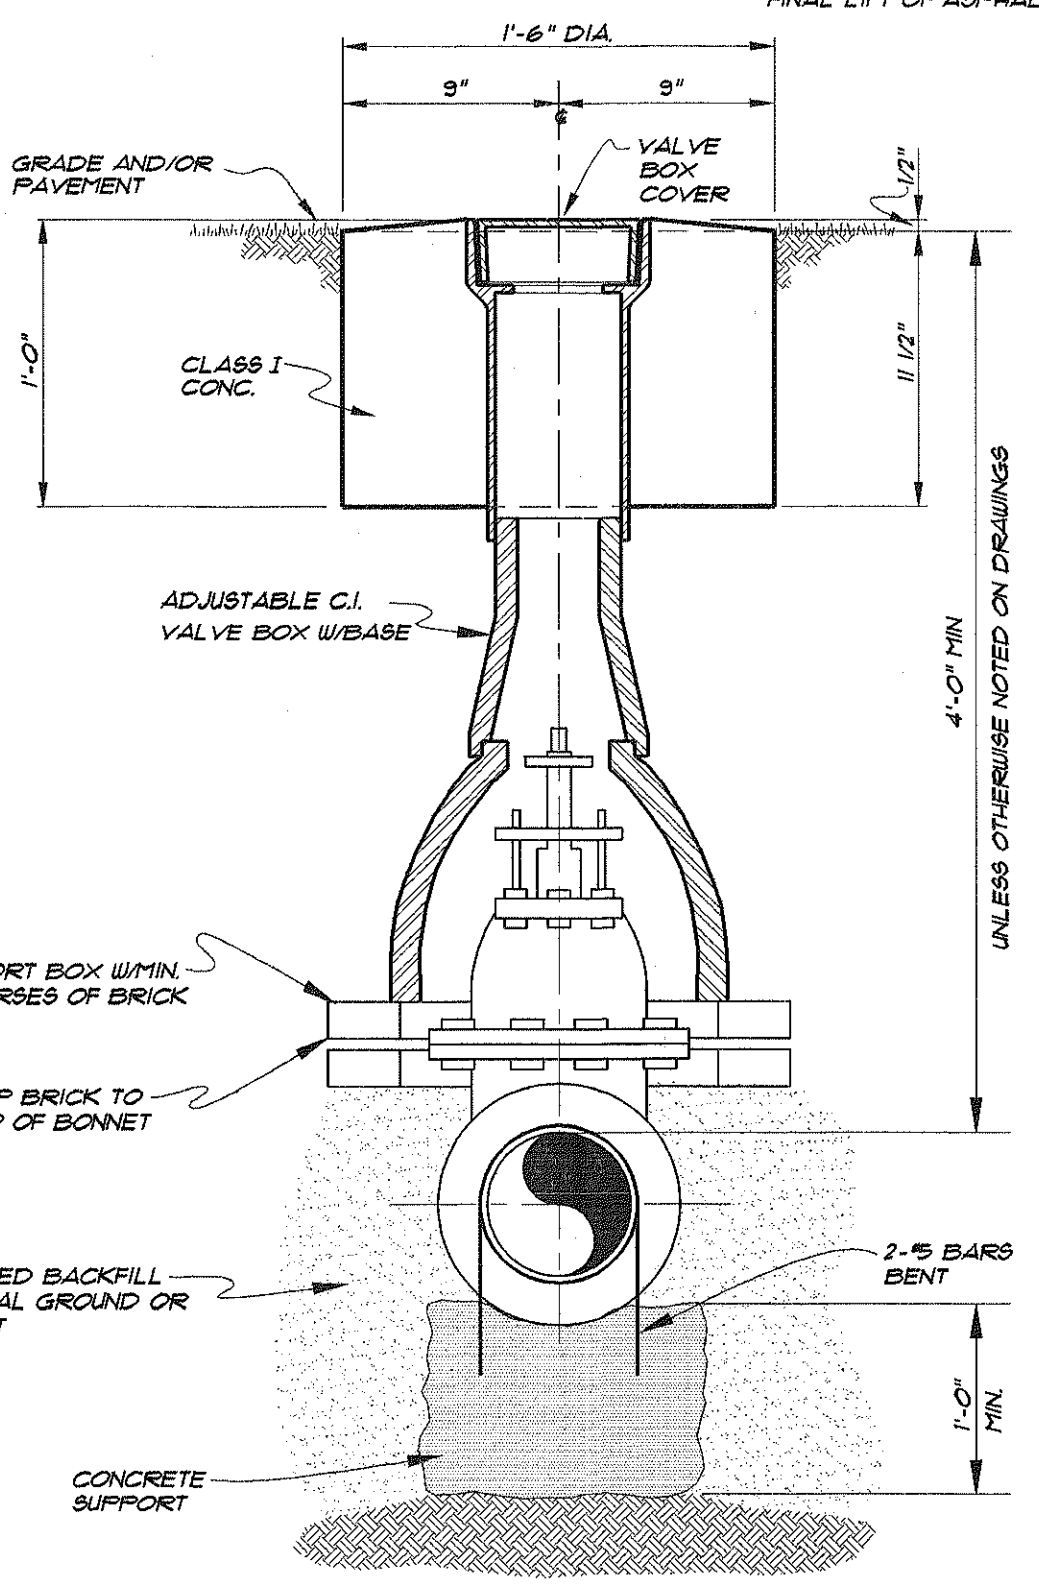


TYPICAL VALVE SETTING DETAIL
NO SCALE

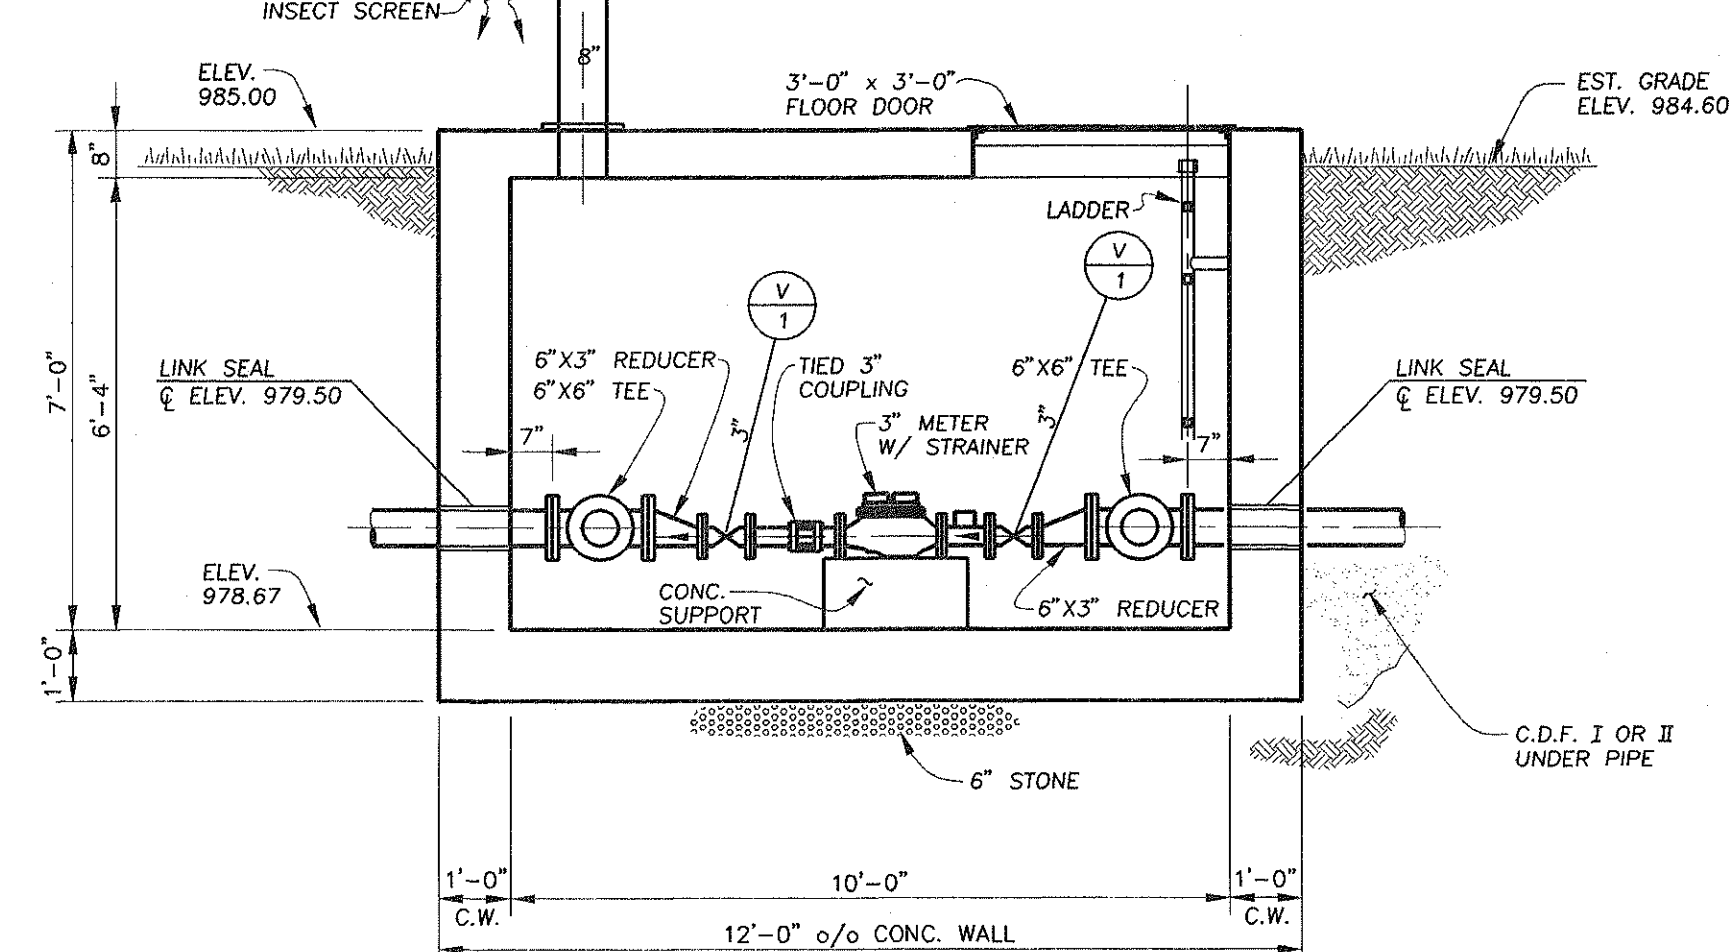


METER CHAMBER DETAILS

3/8" = 1'-0"

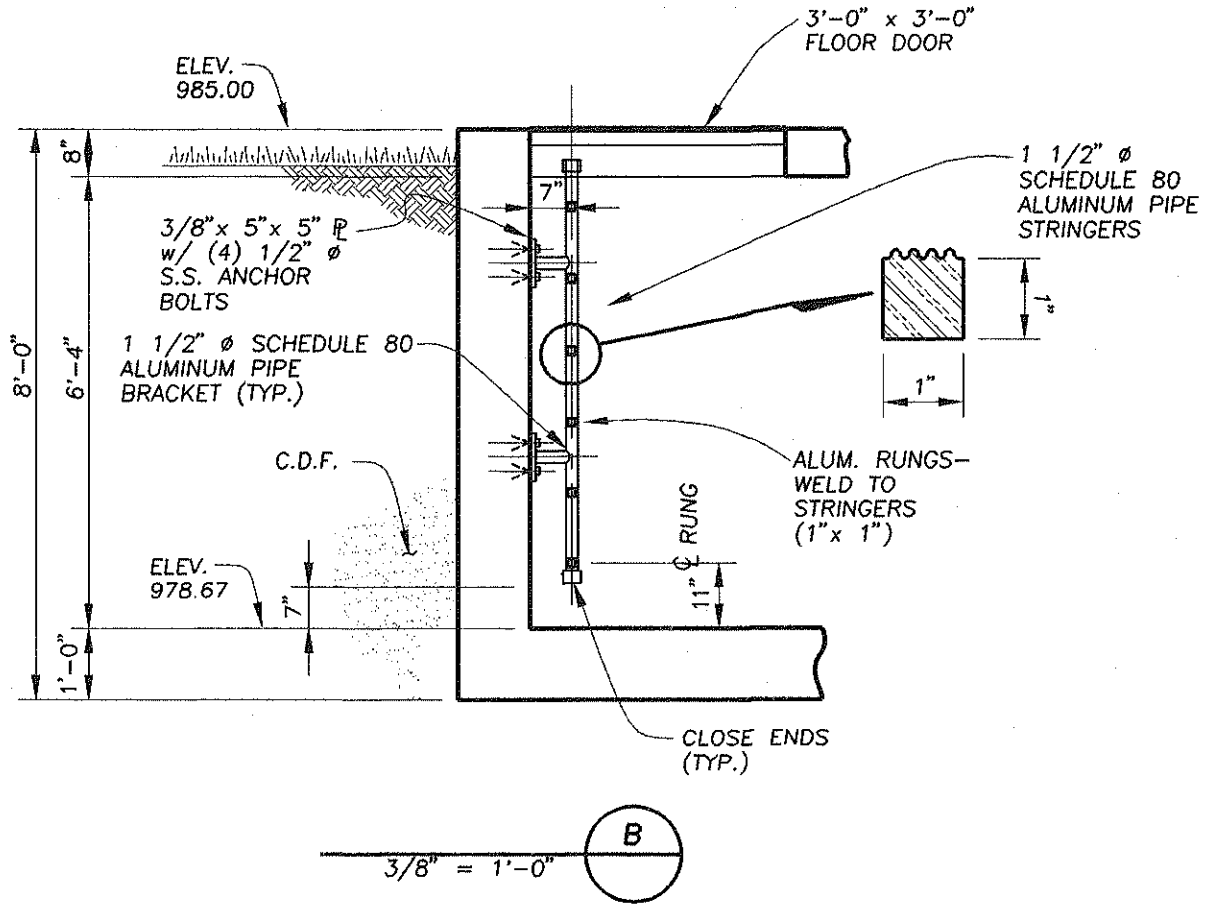

3/8" = 1'-0"

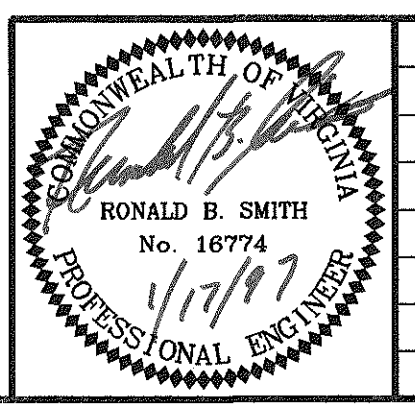


REV. NO.	DESCRIPTION	DATE	BY	APP'D
1	RECORD DRAWING	6-27-96	A.D.C.	R.B.S.

FINKBEINER, PETTIS & SROUT, INC.
CONSULTING ENGINEERS
ROANOKE, VIRGINIA



SCALE
AS NOTED
DESIGNED BY
R.B.S.
DRAWN BY
S.R.P.
CHECKED BY
S.A.L./G.G.A.

MISCELLANEOUS DETAILS
U.S. 220 WATER MAIN
BOTETOURT COUNTY, VIRGINIA

CAD NUMBER BOTUWMD01
PROJECT NUMBER BOTW 502 B
CONTRACT
DATE 4-14-95
13 OF 14

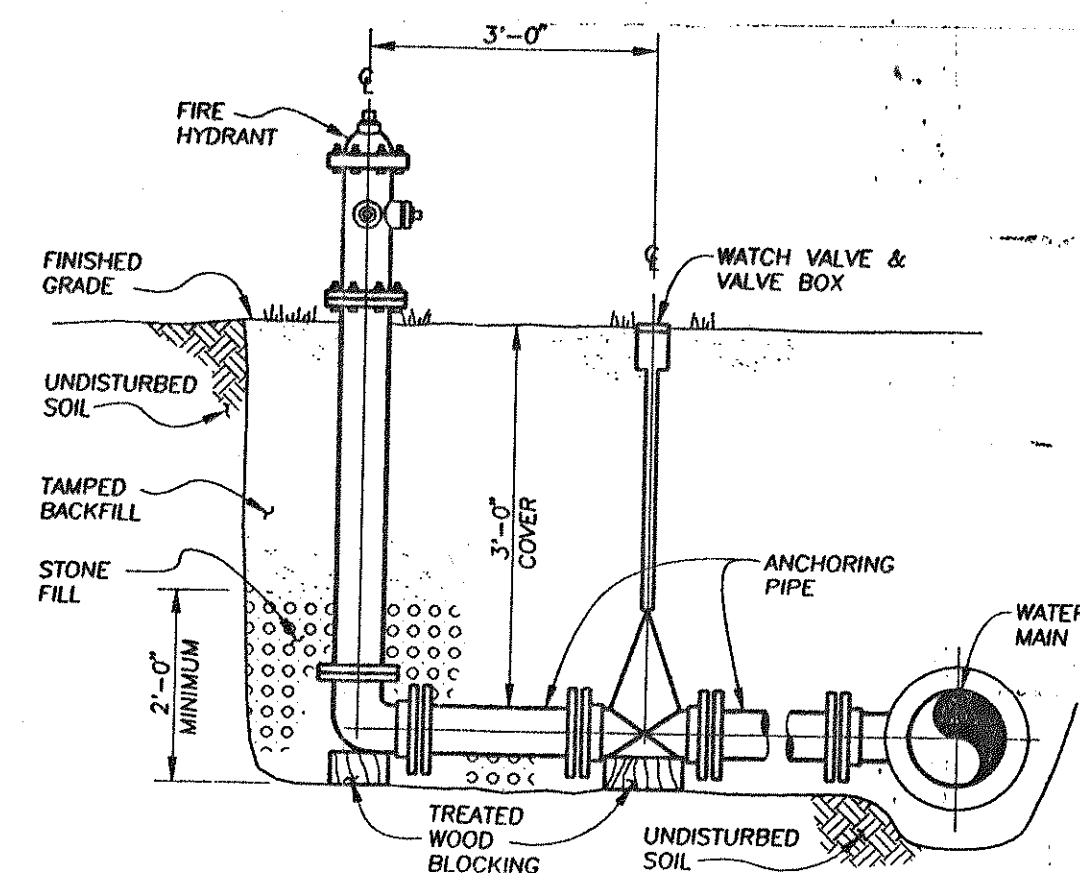


SECTION
HYDRANT PERPENDICULAR TO WATER MAIN DETAIL
1/2" = 1'-0"

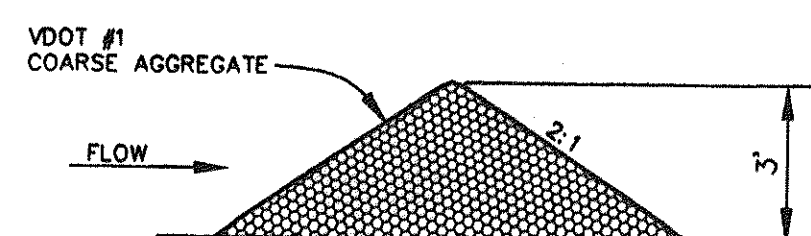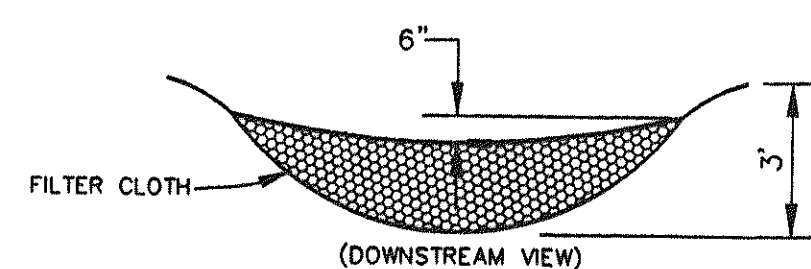

LOCATION	STATION
CATAWBA RD. (S.R. 779)	3+14
CATAWBA RD. (S.R. 779)	15+30
CATAWBA RD. (S.R. 779)	19+70
CATAWBA RD. (S.R. 779)	28+65
U.S. 220	19+10
U.S. 220	33+65
U.S. 220	44+65

CHECK DAM (CD)
NO SCALE

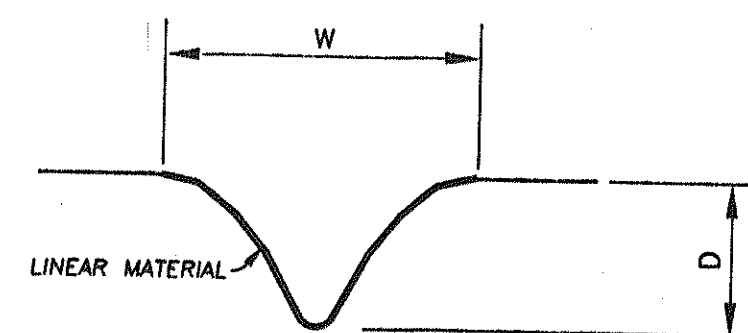


NOTE: VALUES FOR D AND W
TO MATCH EXISTING.

LOCATION	STA. BEGIN	STA. END	MATERIAL
CATAWBA RD. (S.R. 779)	3+10	7+00	JUTE
CATAWBA RD. (S.R. 779)	11+90	15+40	JUTE
CATAWBA RD. (S.R. 779)	18+40	21+50	JUTE
CATAWBA RD. (S.R. 779)	29+30	32+75	JUTE
U.S. 220	18+70	19+10	JUTE
U.S. 220	44+40	44+70	JUTE
U.S. 220	33+55	34+00	STONE
U.S. 220	23+70	24+10	STONE
U.S. 220	46+27	46+44	STONE
U.S. 220	52+30	52+50	STONE

NOTE: STONE SHALL BE VDOT CLASS A1,
AND SHALL BE PLACED 26 IN. THK.
ALL STONE LINERS SHALL HAVE A
GEOTEXTILE FABRIC BEDDING INSTALLED.
GEOTEXTILE BEDDING SHALL CONFORM
TO VDOT SEC. 2 & 5.02 (b) OF ROAD
AND BRIDGE SPECIFICATIONS.

STORM CONVEYANCE CHANNEL (SCC)
NO SCALE

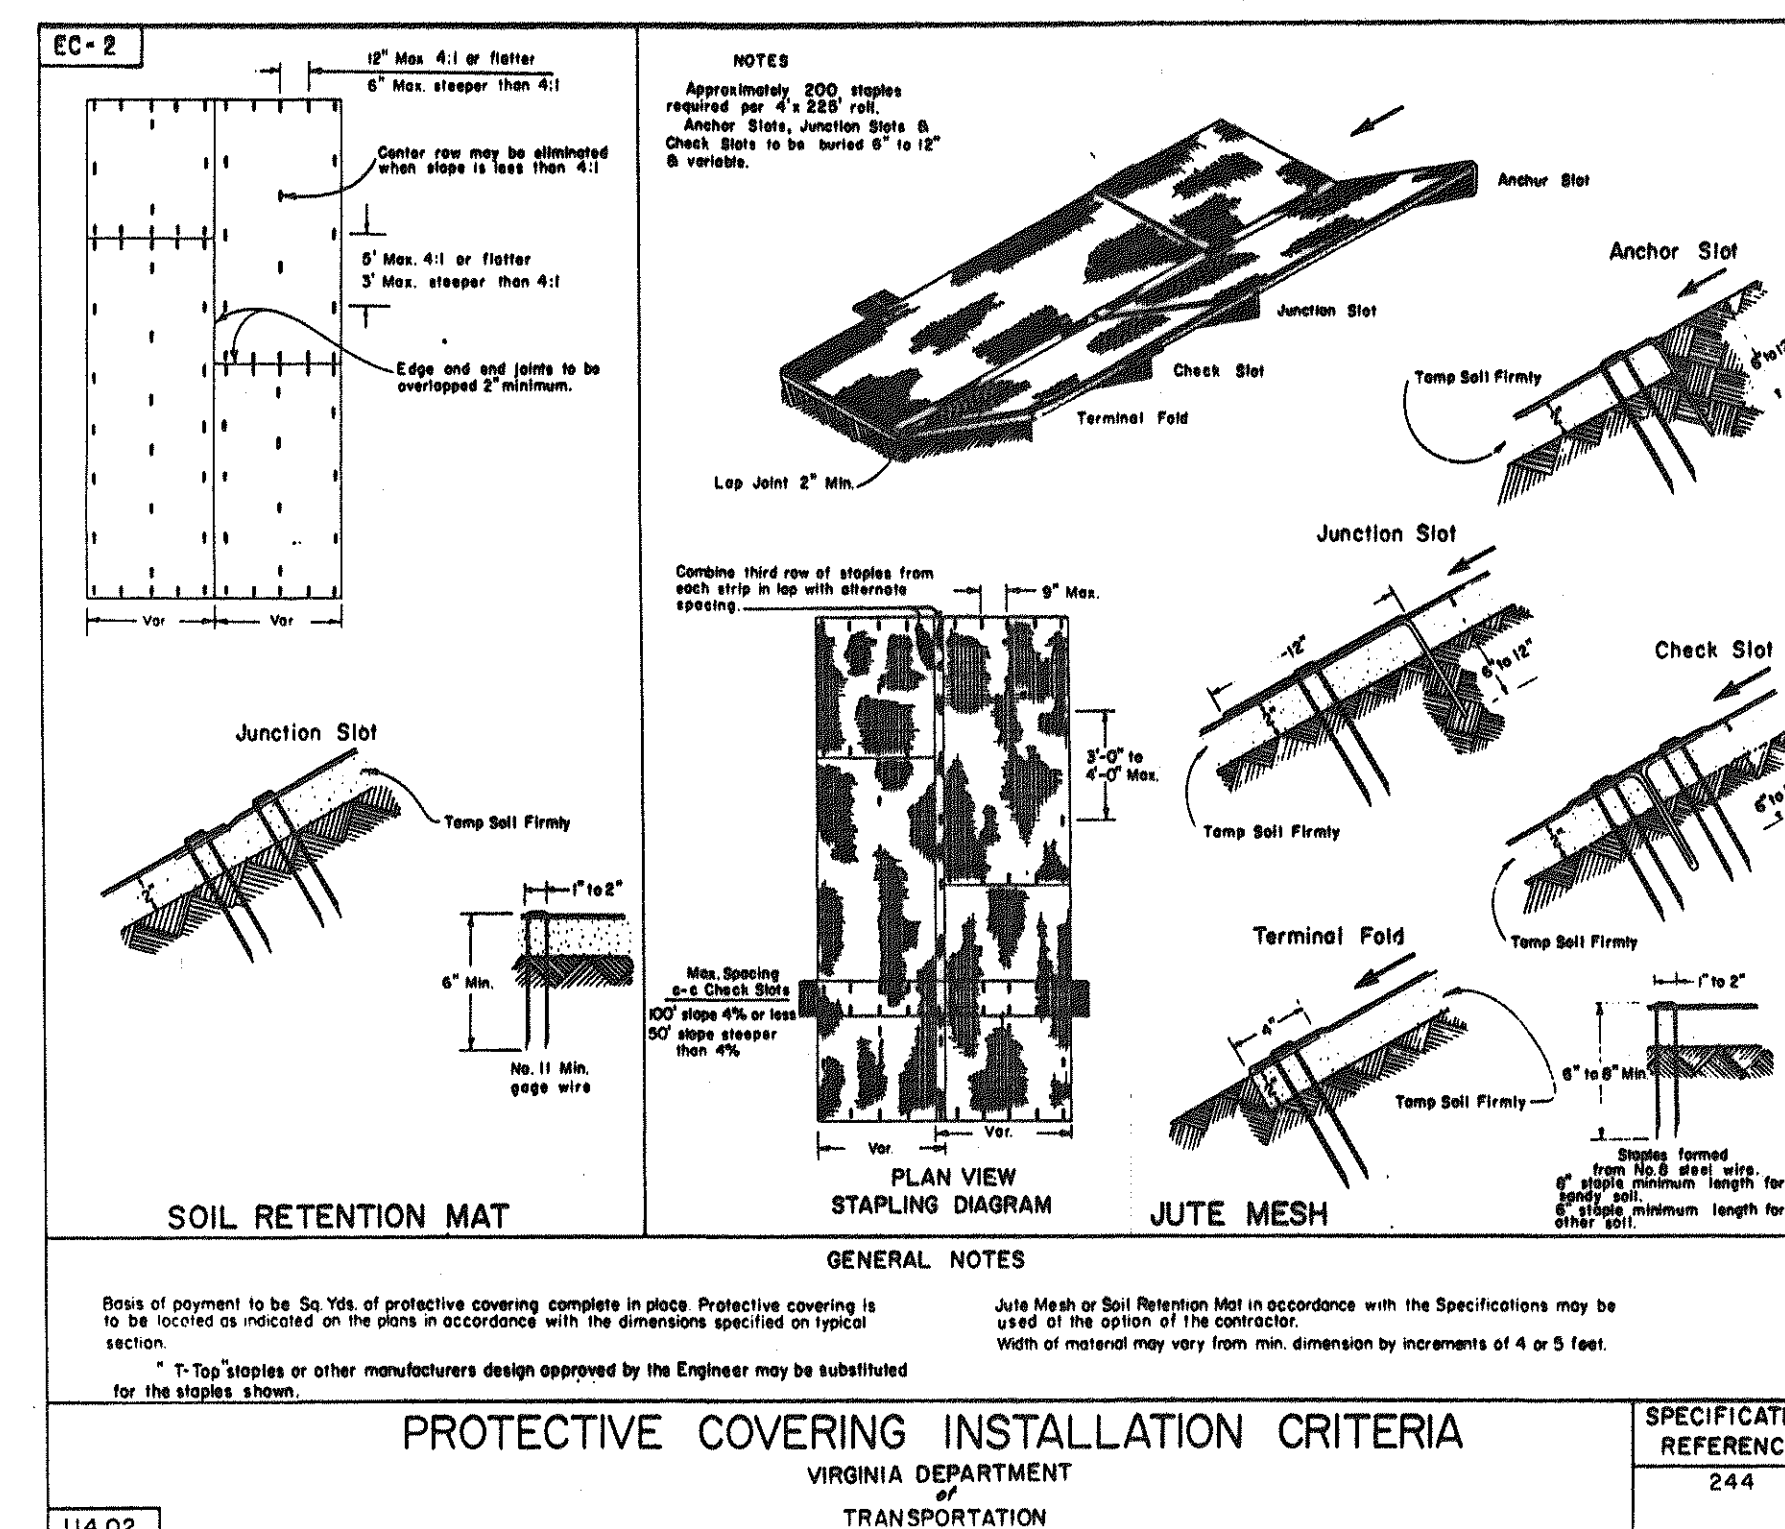


PROTECTIVE COVERING INSTALLATION CRITERIA

VIRGINIA DEPARTMENT
OF
TRANSPORTATION

SPECIFICATION
REFERENCE
244


STORM CONVEYANCE CHANNEL (SCC)

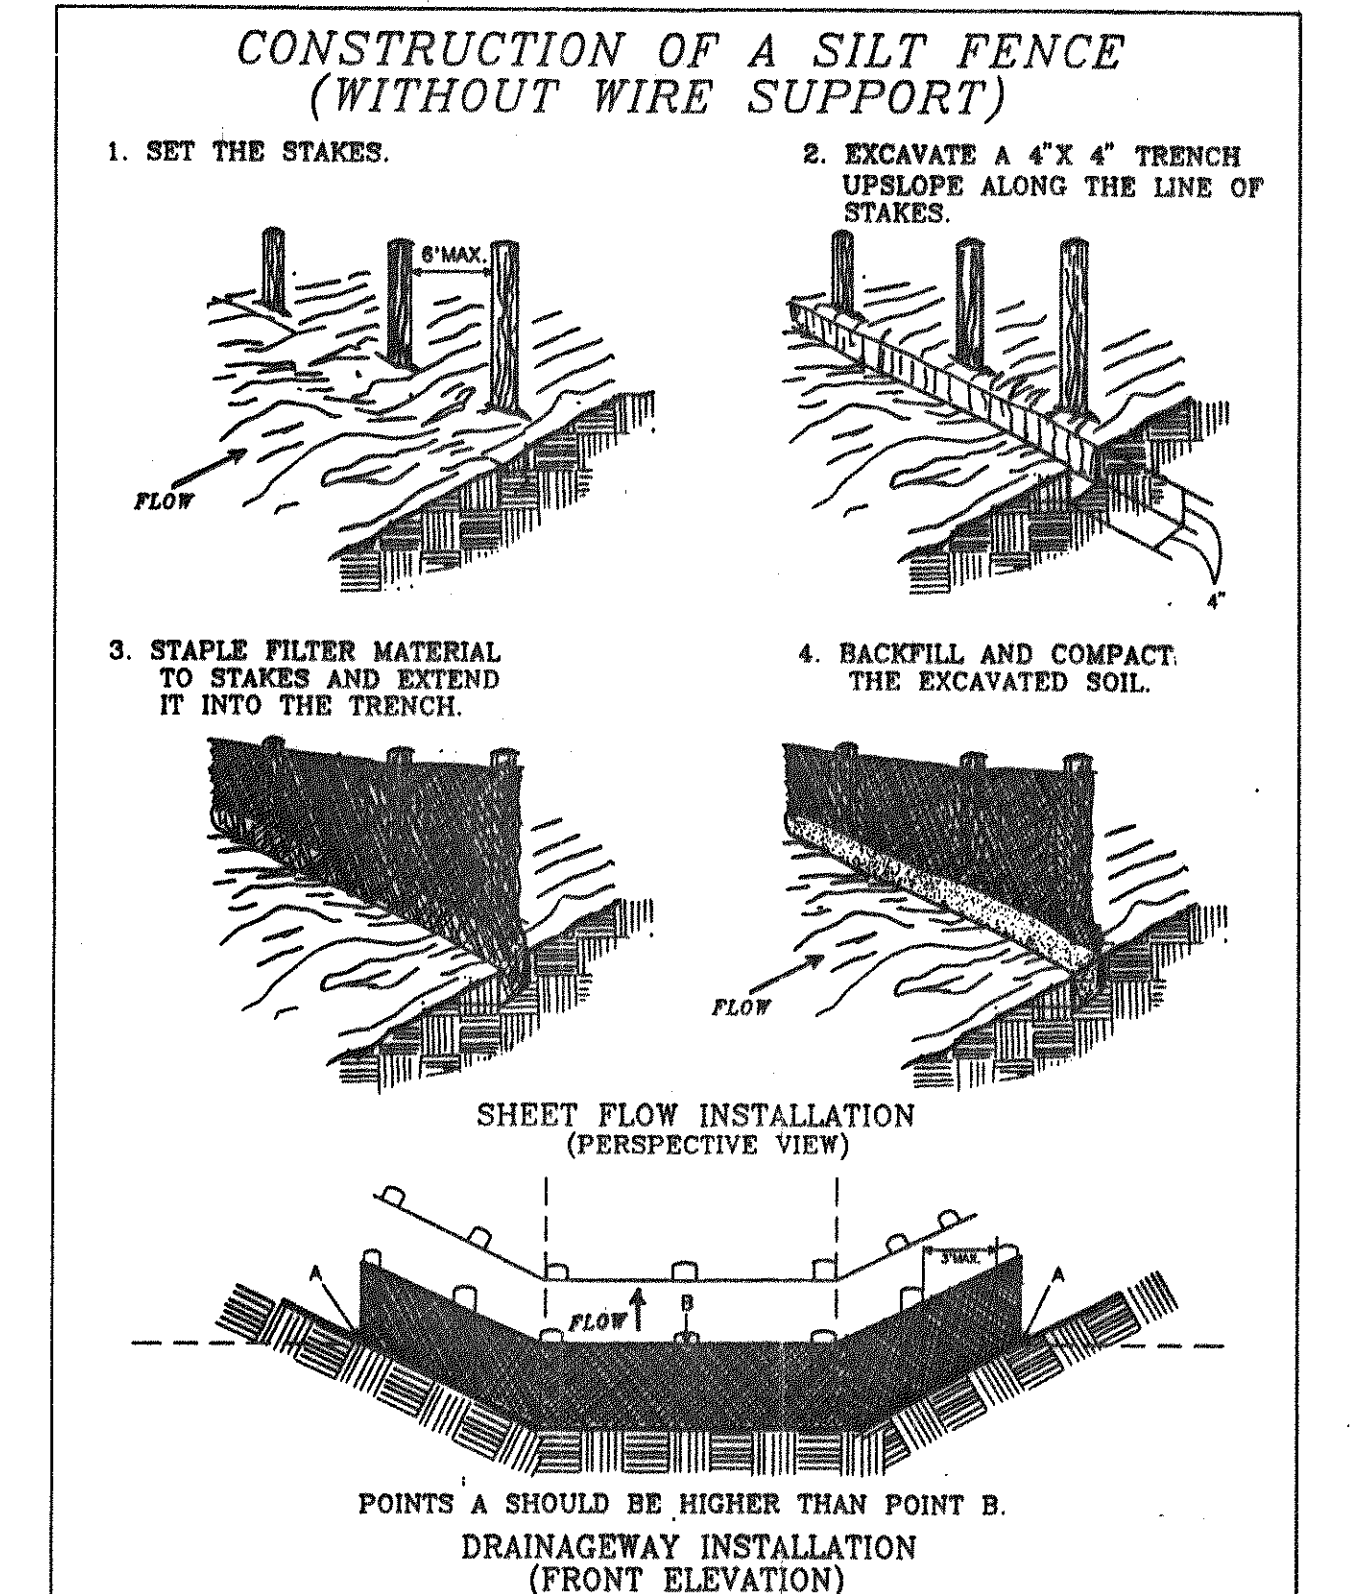


Source: Adapted from Installation of Straw and Fabric Filter
Barriers for Sediment Control, Sherwood and Wyant

Plate 3.05-2


III - 25

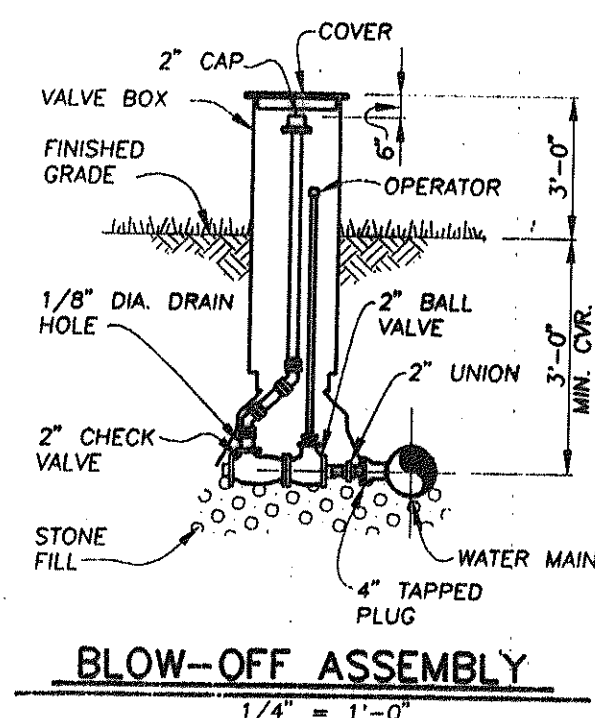


BLOW-OFF ASSEMBLY
1/4" = 1'-0"

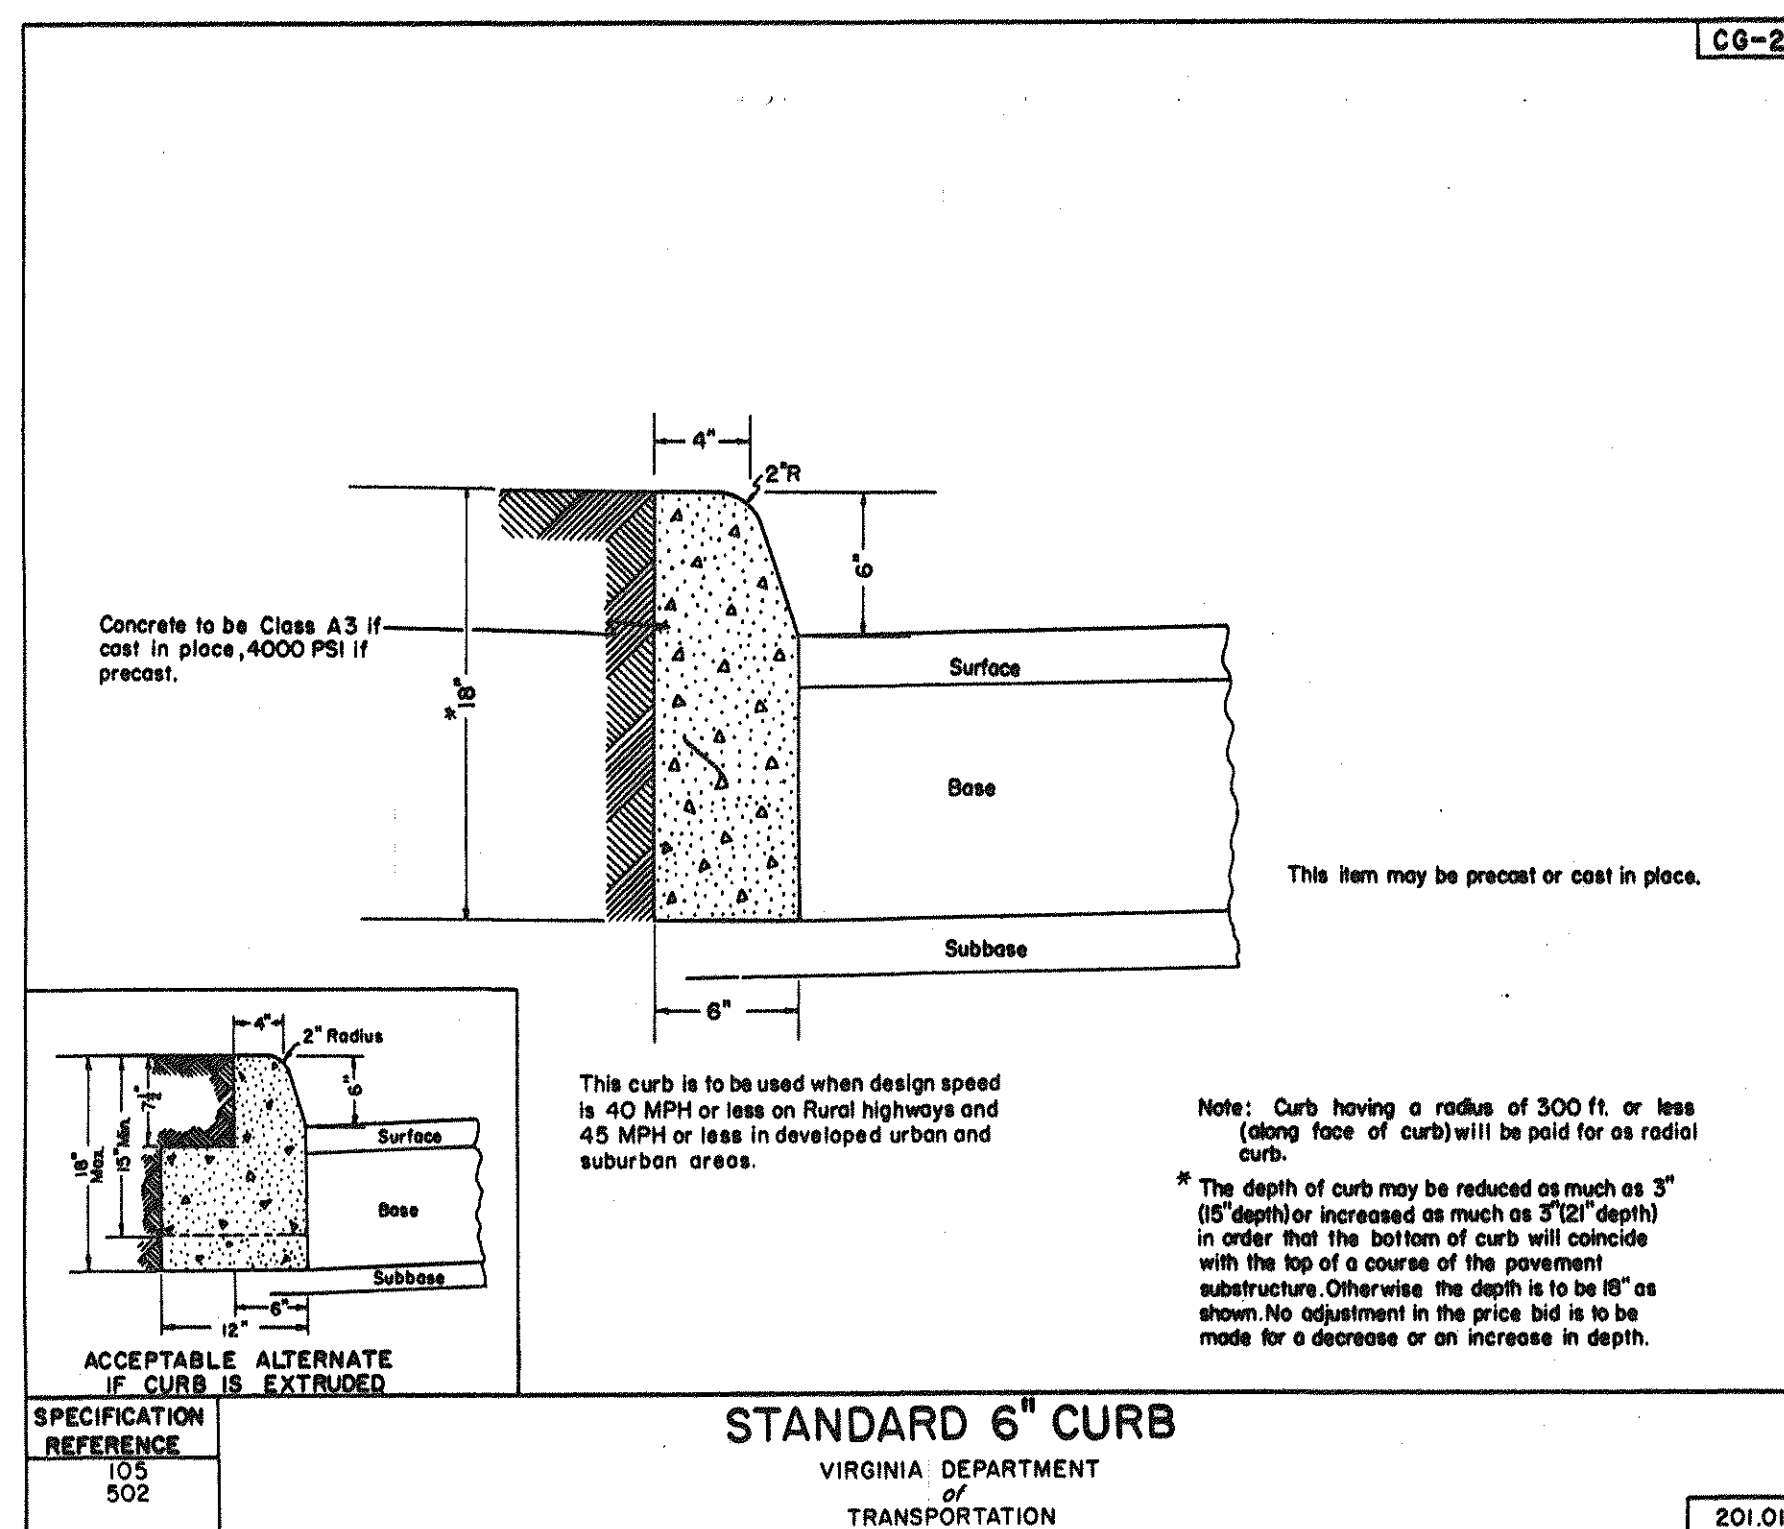


STANDARD 6" CURB
VIRGINIA DEPARTMENT
OF
TRANSPORTATION

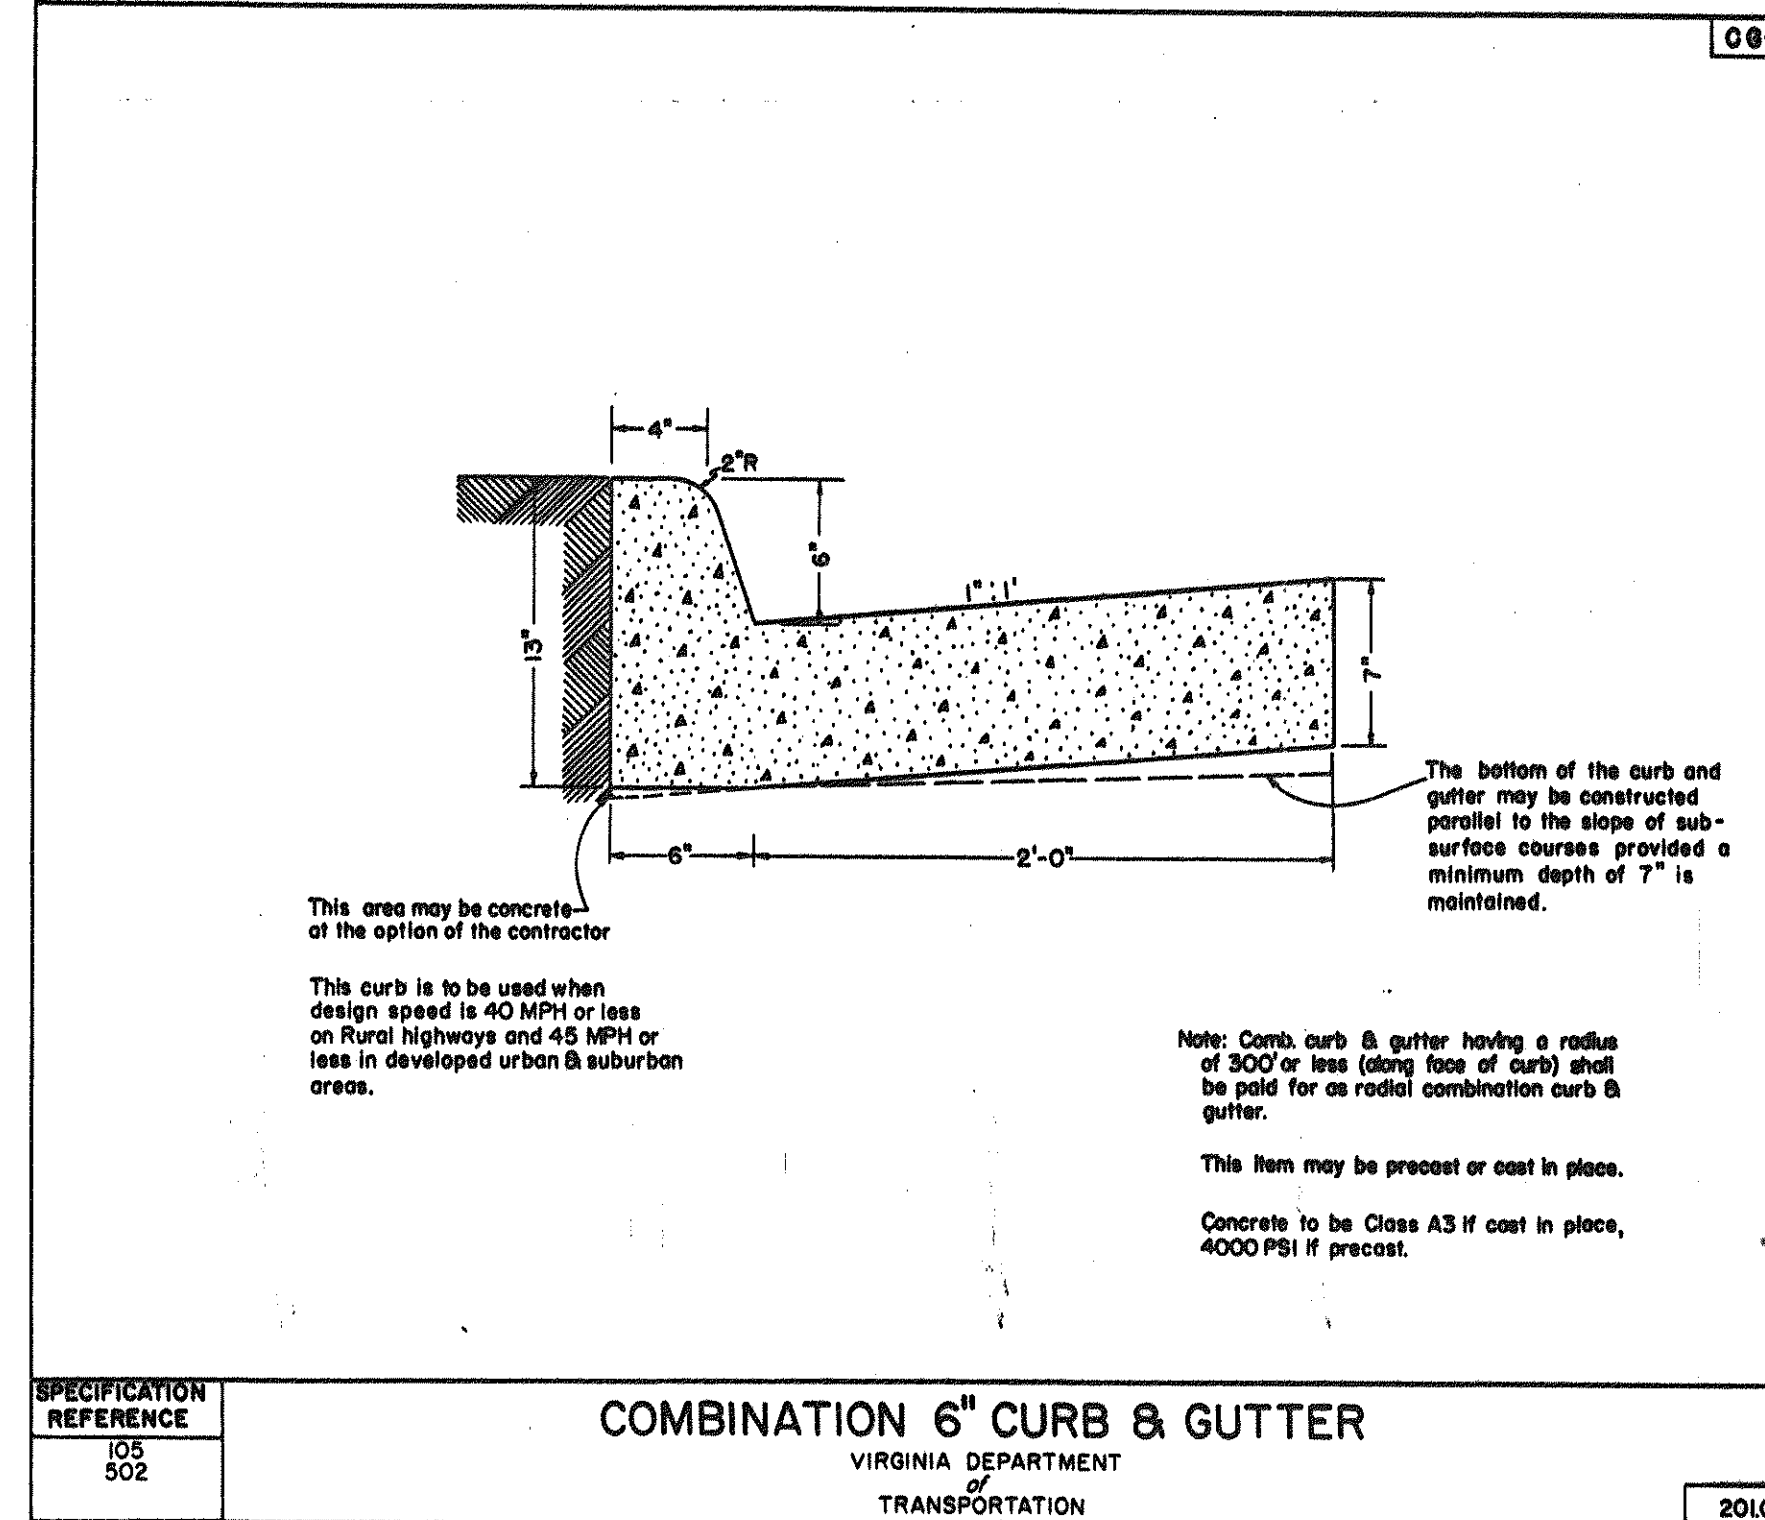

COMBINATION 6" CURB & GUTTER
VIRGINIA DEPARTMENT
OF
TRANSPORTATION

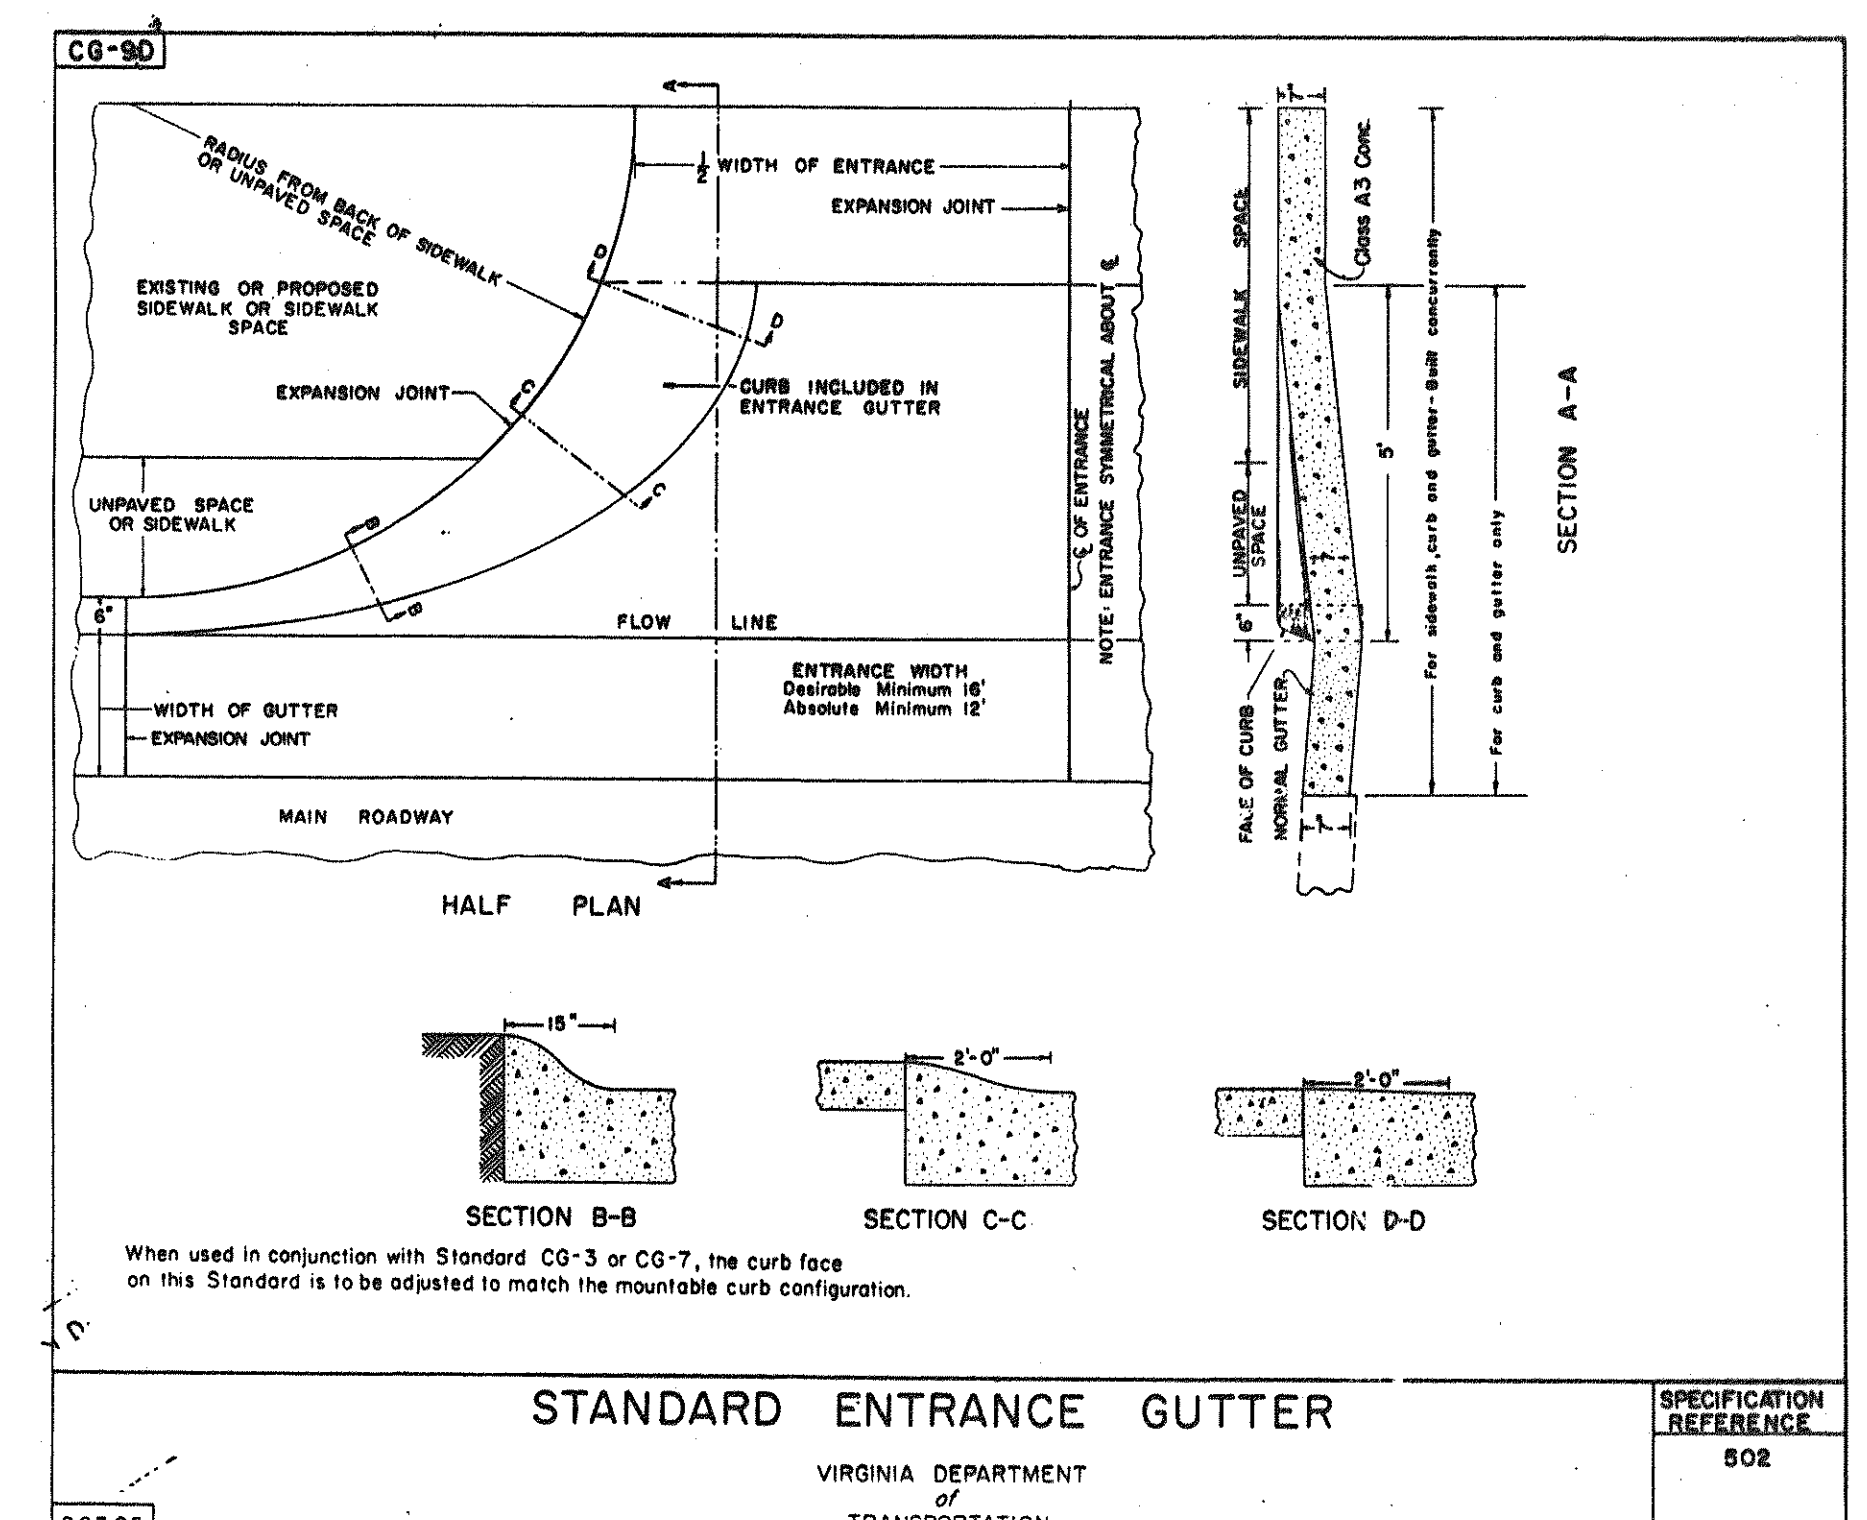

STANDARD ENTRANCE GUTTER
VIRGINIA DEPARTMENT
OF
TRANSPORTATION

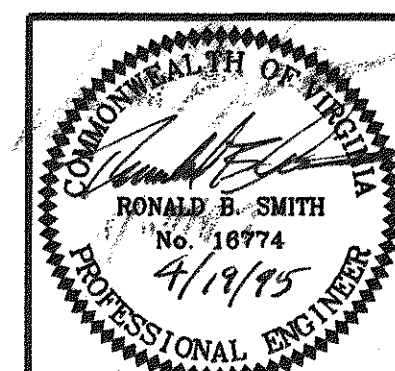

REV. NO.	DESCRIPTION	DATE	BY	APP'D
1	RECORD DRAWING	6-26-95	R.D.C.	R.B.S.



FINKBEINER, PETTIS & STROUT, INC.
CONSULTING ENGINEERS
ROANOKE, VIRGINIA

SCALE
AS NOTED
DESIGNED BY
R.B.S.
DRAWN BY
S.R.P.
CHECKED BY
S.A.L./G.G.A.

MISCELLANEOUS DETAILS
U.S. 220 WATER MAIN
BOTETOURT COUNTY, VIRGINIA


CAD NUMBER
BOTUWMD2
PROJECT NUMBER
BOTW 502 B
SECTION
DATE
4-14-95
14 of 14

PROJECT NAME: Water Main
DATE: 10-27-95
TYPE: _____
LOCATION: _____
TOTAL # SHEETS: _____
A/E FIRM: F.P.S.
OF SETS: _____

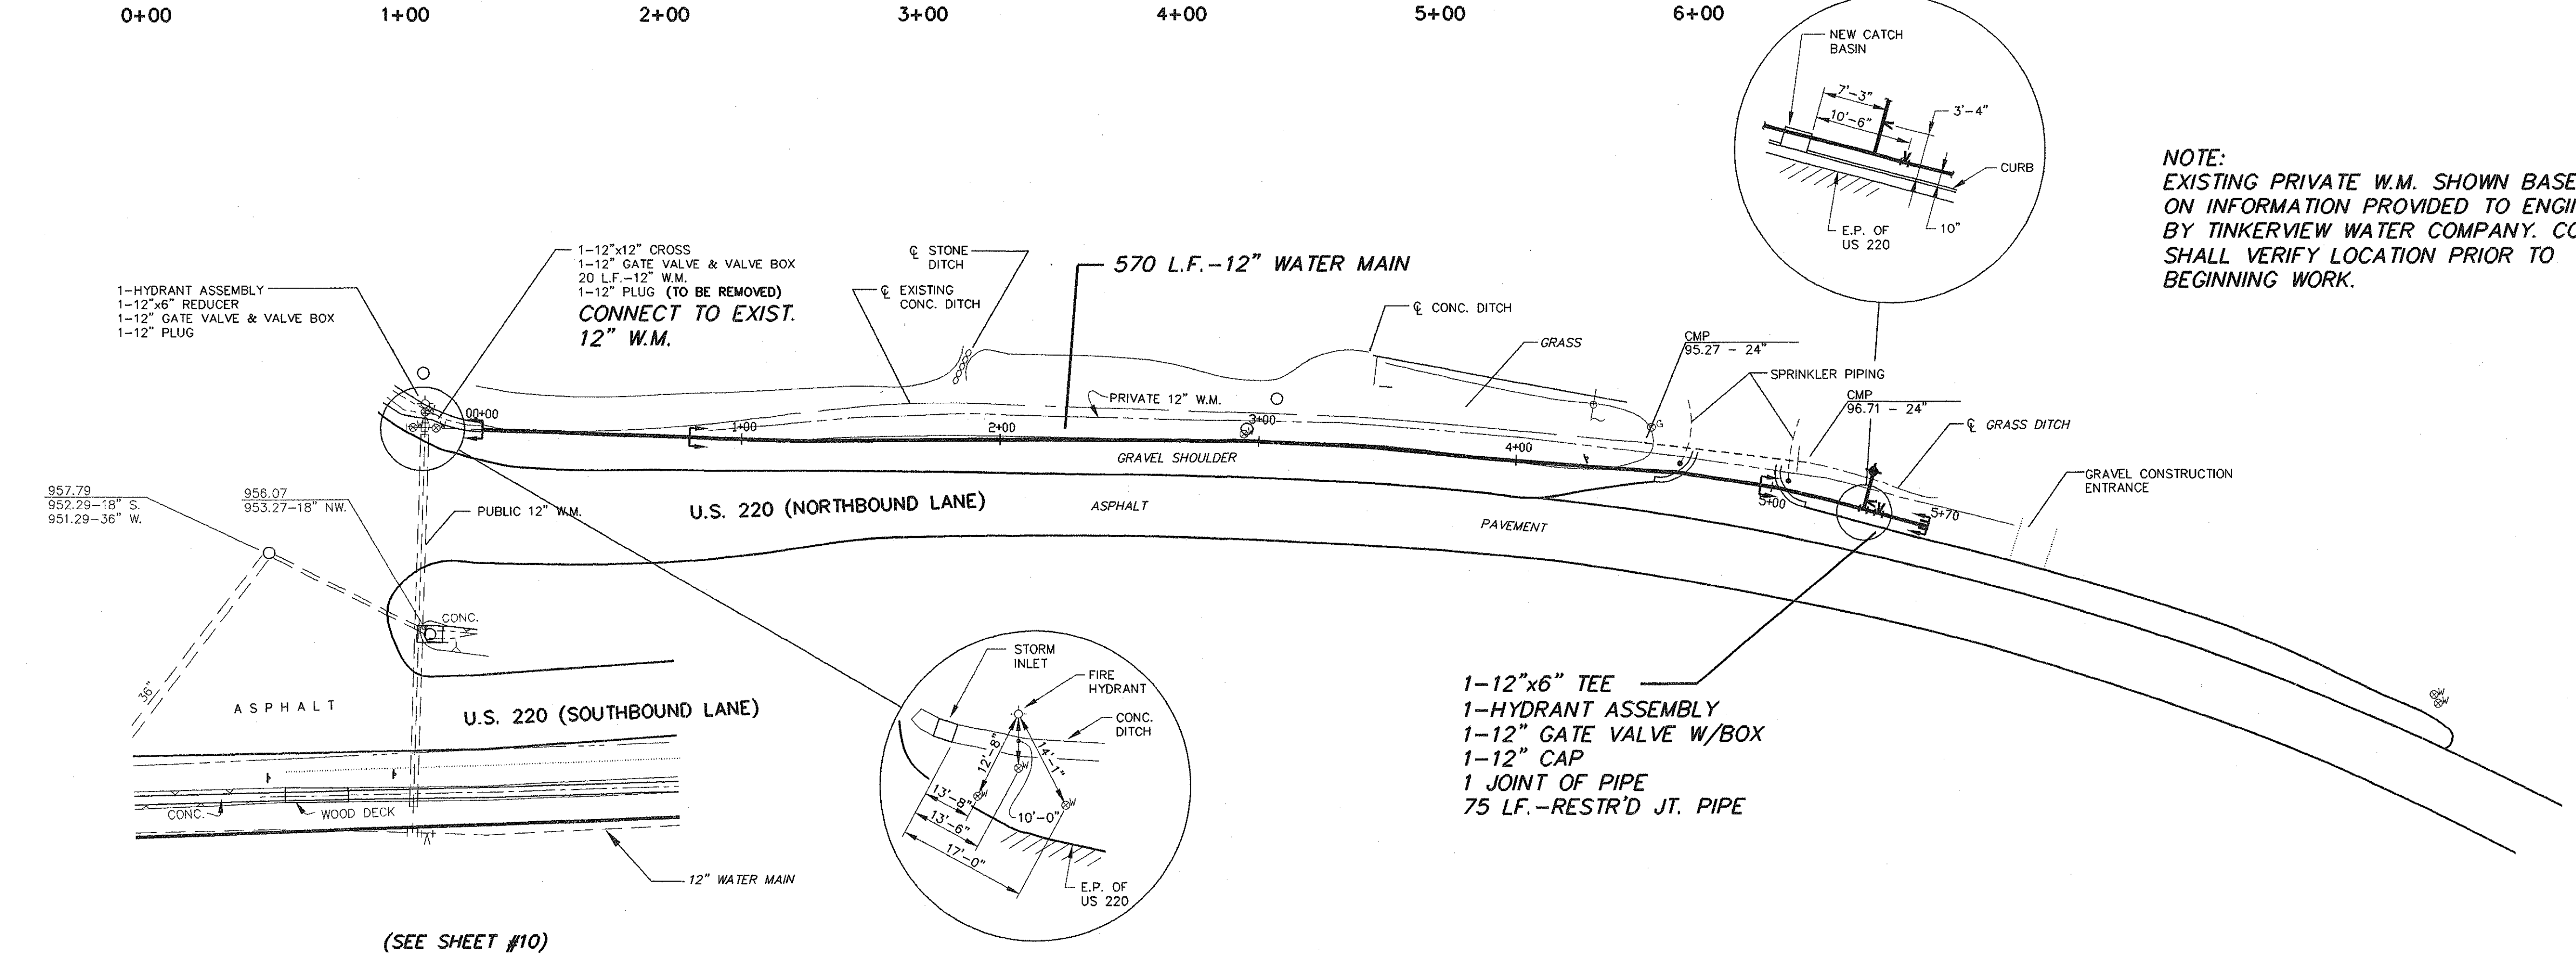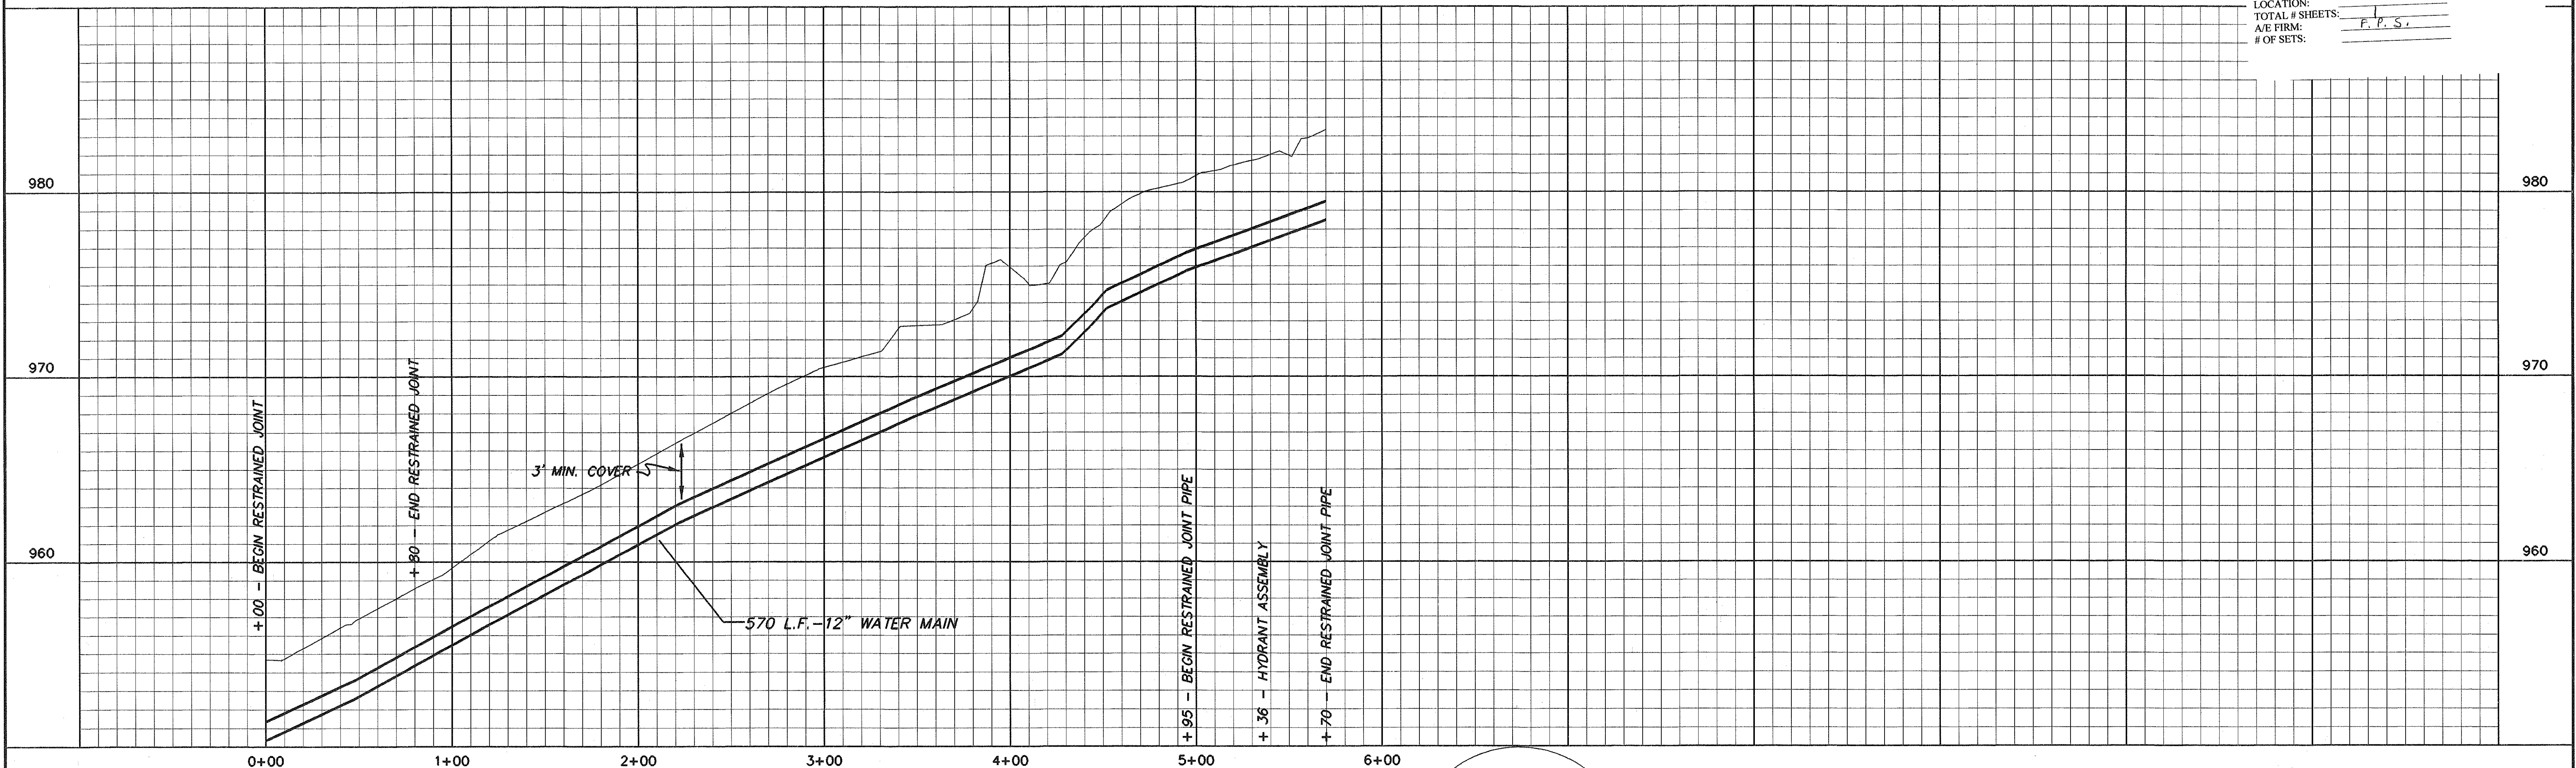

NOTE:
EXISTING PRIVATE W.M. SHOWN BASED
ON INFORMATION PROVIDED TO ENGINEER
BY TINKERVIEW WATER COMPANY. CONTRACTOR
SHALL VERIFY LOCATION PRIOR TO
BEGINNING WORK.

(SEE SHEET #10)

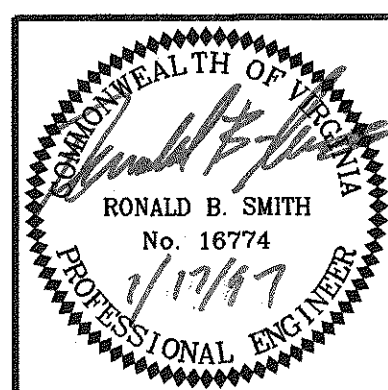

REV. NO.	DESCRIPTION	DATE	BY	APP'D
1	RECORD DRAWING	6-27-96	A.D.C.	R.B.S.

FINKBEINER, PETTIS & STROUT, INC.
CONSULTING ENGINEERS
ROANOKE, VIRGINIA

SCALE
HORIZ. 1" = 4'
VERT. 1" = 40'
DESIGNED BY
R.B.S.
DRAWN BY
D.P.
CHECKED BY
S.A.L./G.G.A.

RADER FUNERAL HOME EXTENSION
U.S. 220 WATER MAIN
BOTETOURT COUNTY, VIRGINIA

CAD NUMBER BOTUW012
PROJECT NUMBER BOTW 505 B
SECTION
DATE 10-27-95
1 OF 1