


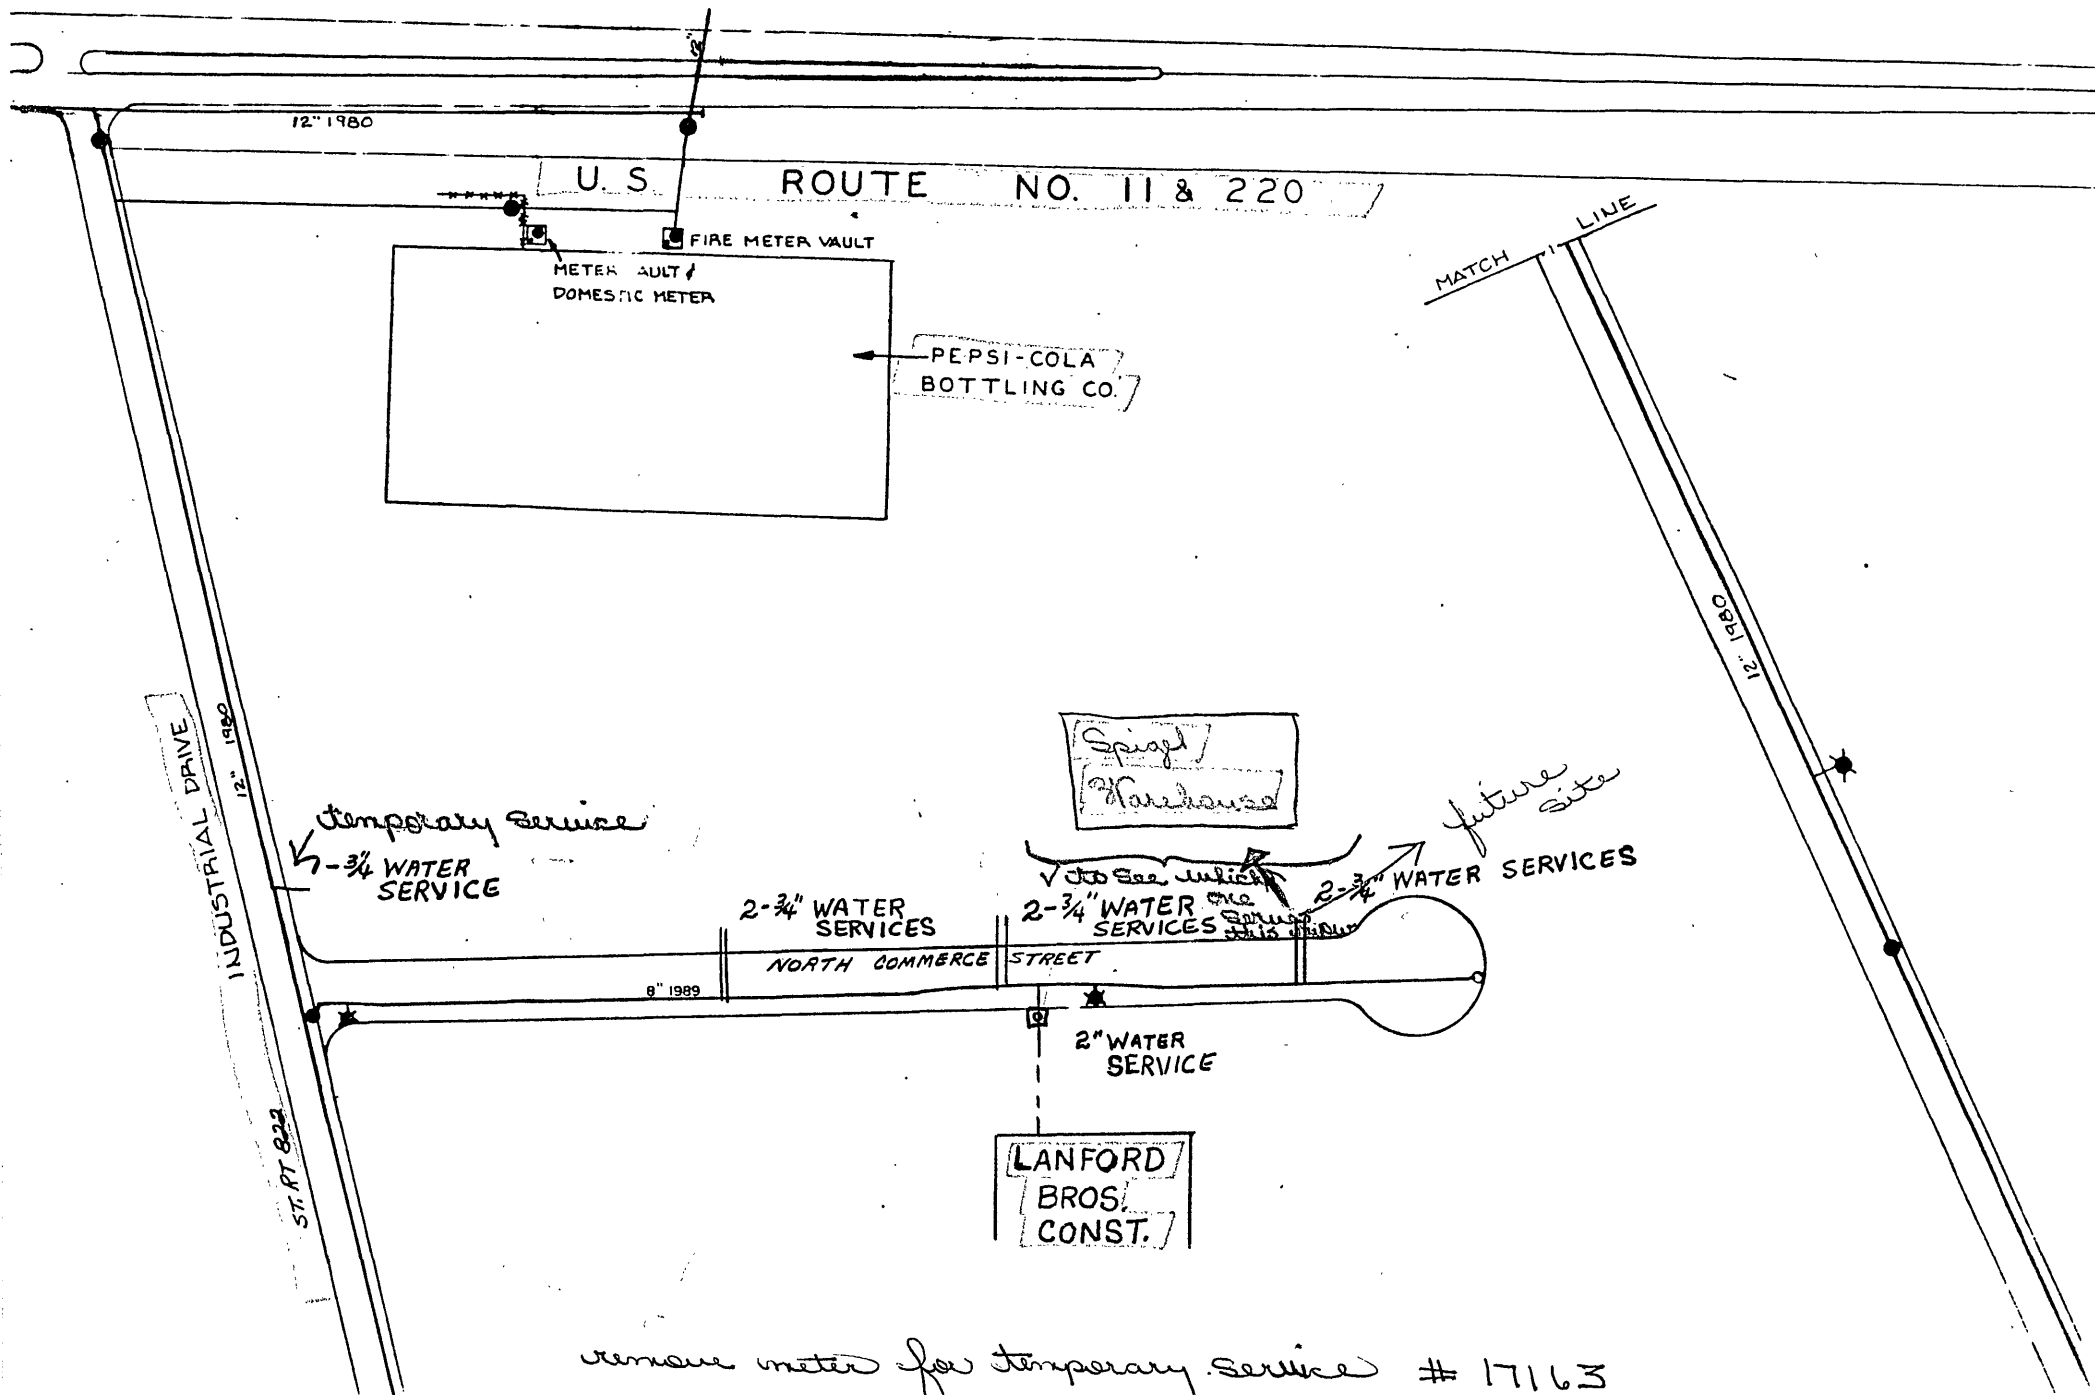

remove meter for temporary service # 17163
 which service will now serve the warehouse
 meter # 7441