


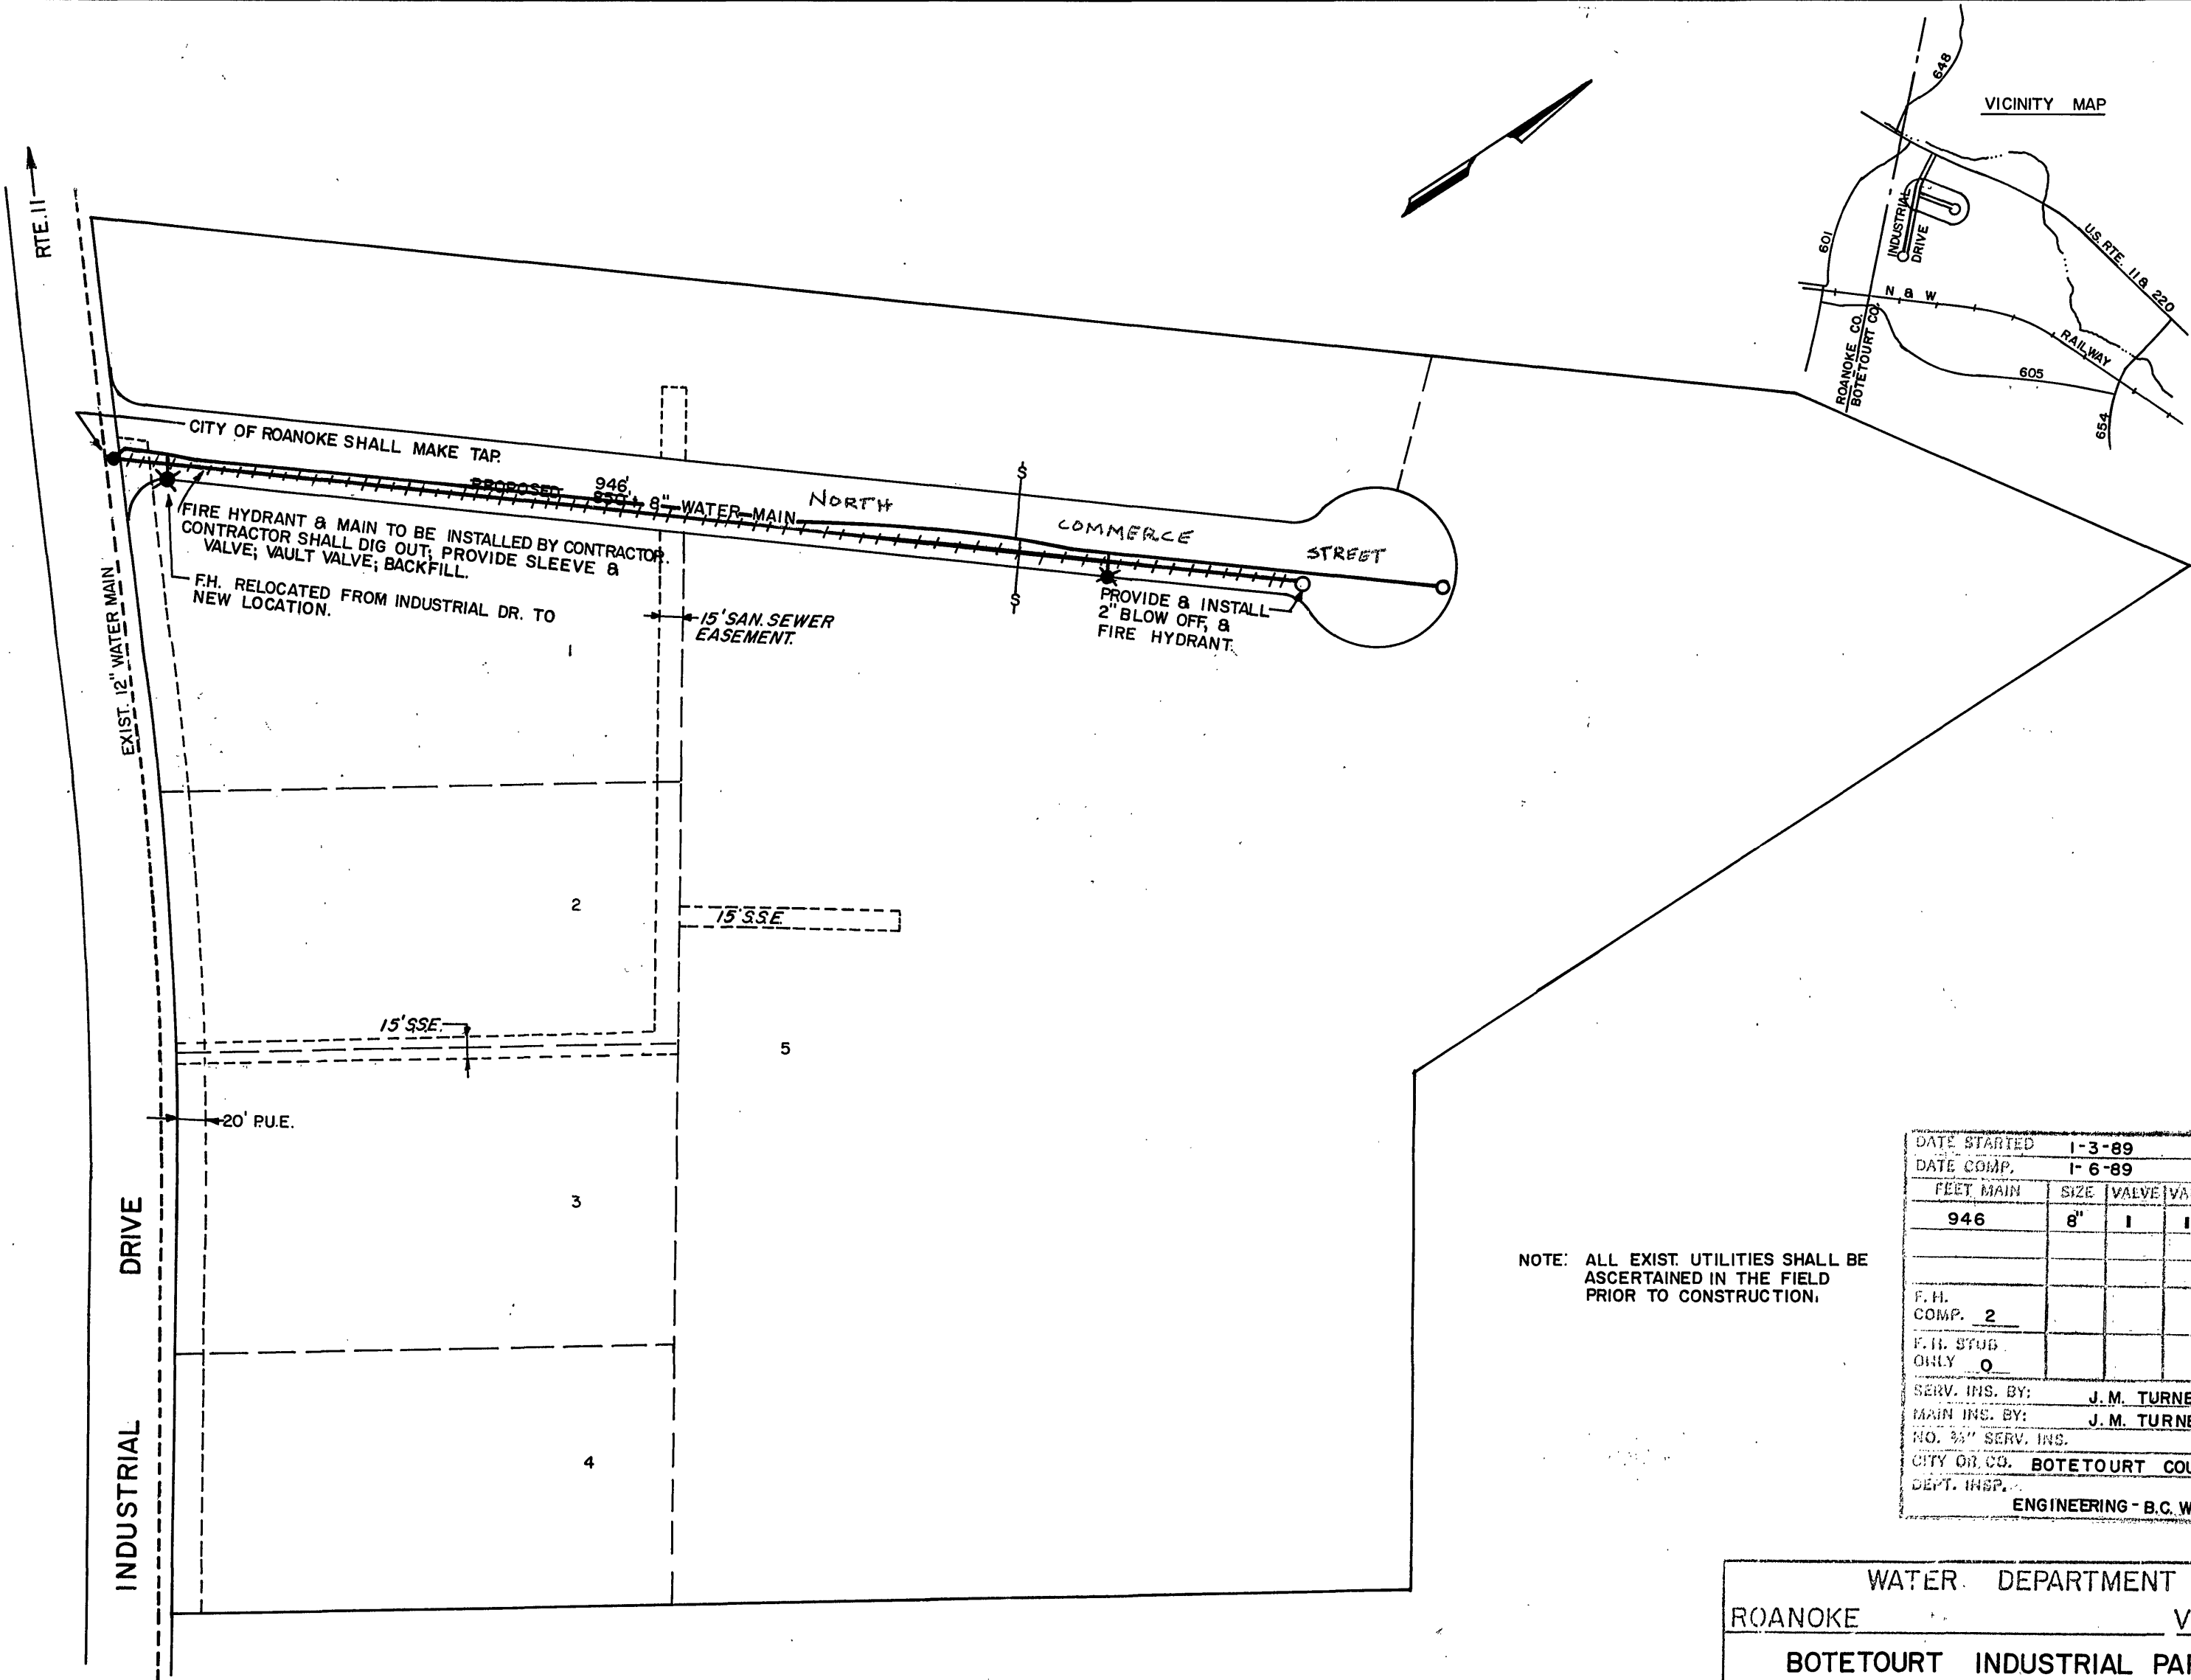

VICINITY MAP

DATE STARTED					1-3-89
DATE COMP.					1-6-89
FEET MAIN	SIZE	VALVE	VAULT	BOX	
946	8"	1	1		
F.H.					
COMP. 2					
F.H. STUB					
ONLY 0					
SERV. INS. BY:		J. M. TURNER			
MAIN INS. BY:		J. M. TURNER			
NO. 3/4" SERV. INS.					
CITY OR CO. BOTETOURT COUNTY					
DEPT. INSP.					
ENGINEERING - B.C. WHITE					

WATER DEPARTMENT
ROANOKE VIRGINIA

BOTETOURT INDUSTRIAL PARK
INDUSTRIAL DRIVE &
LANFORD BROS. CO., INC.
BOTETOURT COUNTY, VIRGINIA

SCALE: 1" = 100'

DATE: 12/21/88

DIST. MAP: 20 COUNTY

PLAN NO.: 88-19

1/20/89

DIRECTOR UTILITIES & OPERATIONS DATE

1-20-89

DIRECTOR OF PUBLIC WORKS DATE

James H. Paul
MANAGER UTILITY LINE SERVICES