



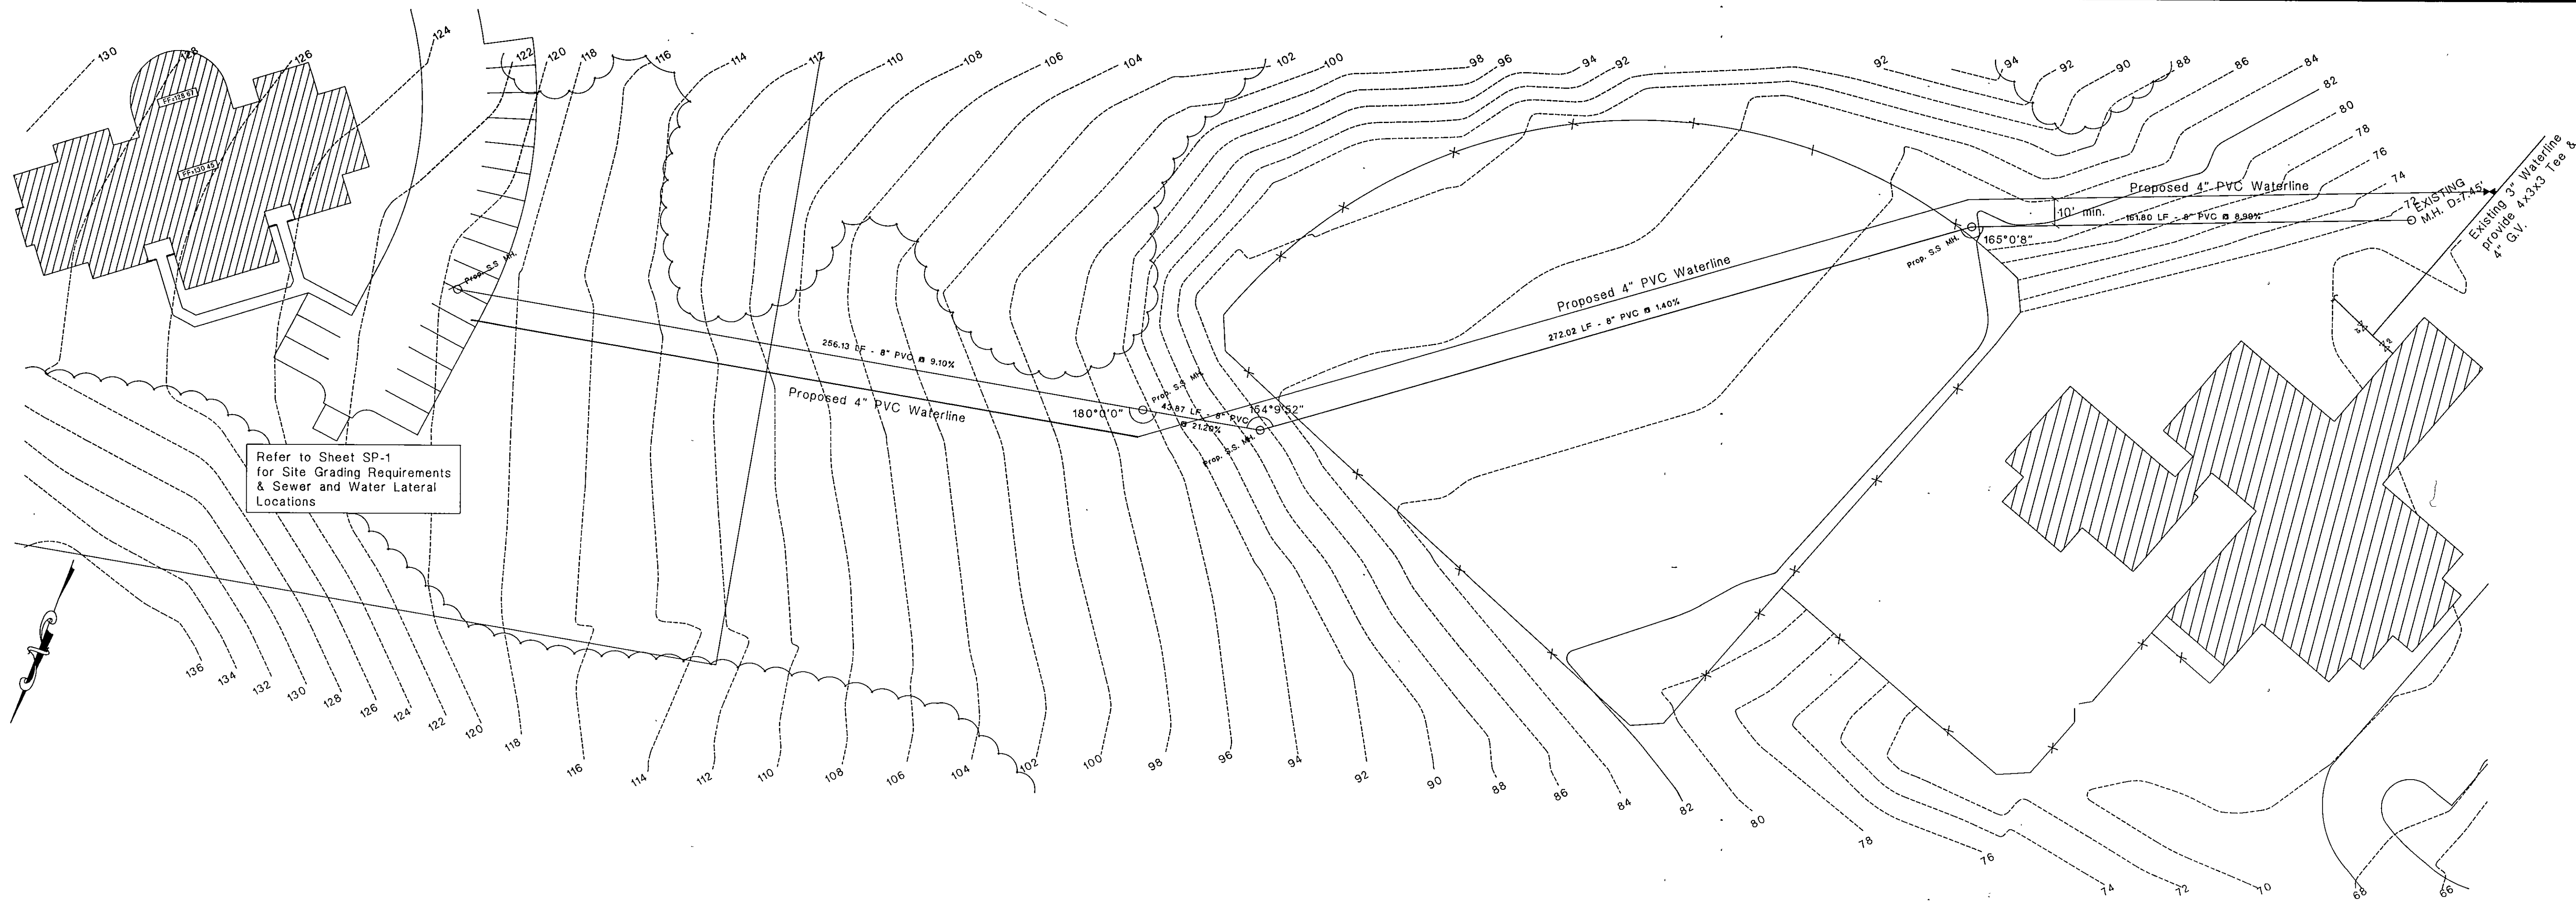

Refer to Sheet SP-1
for Site Grading Requirements
& Sewer and Water Lateral
Locations

RECORD DRAWING

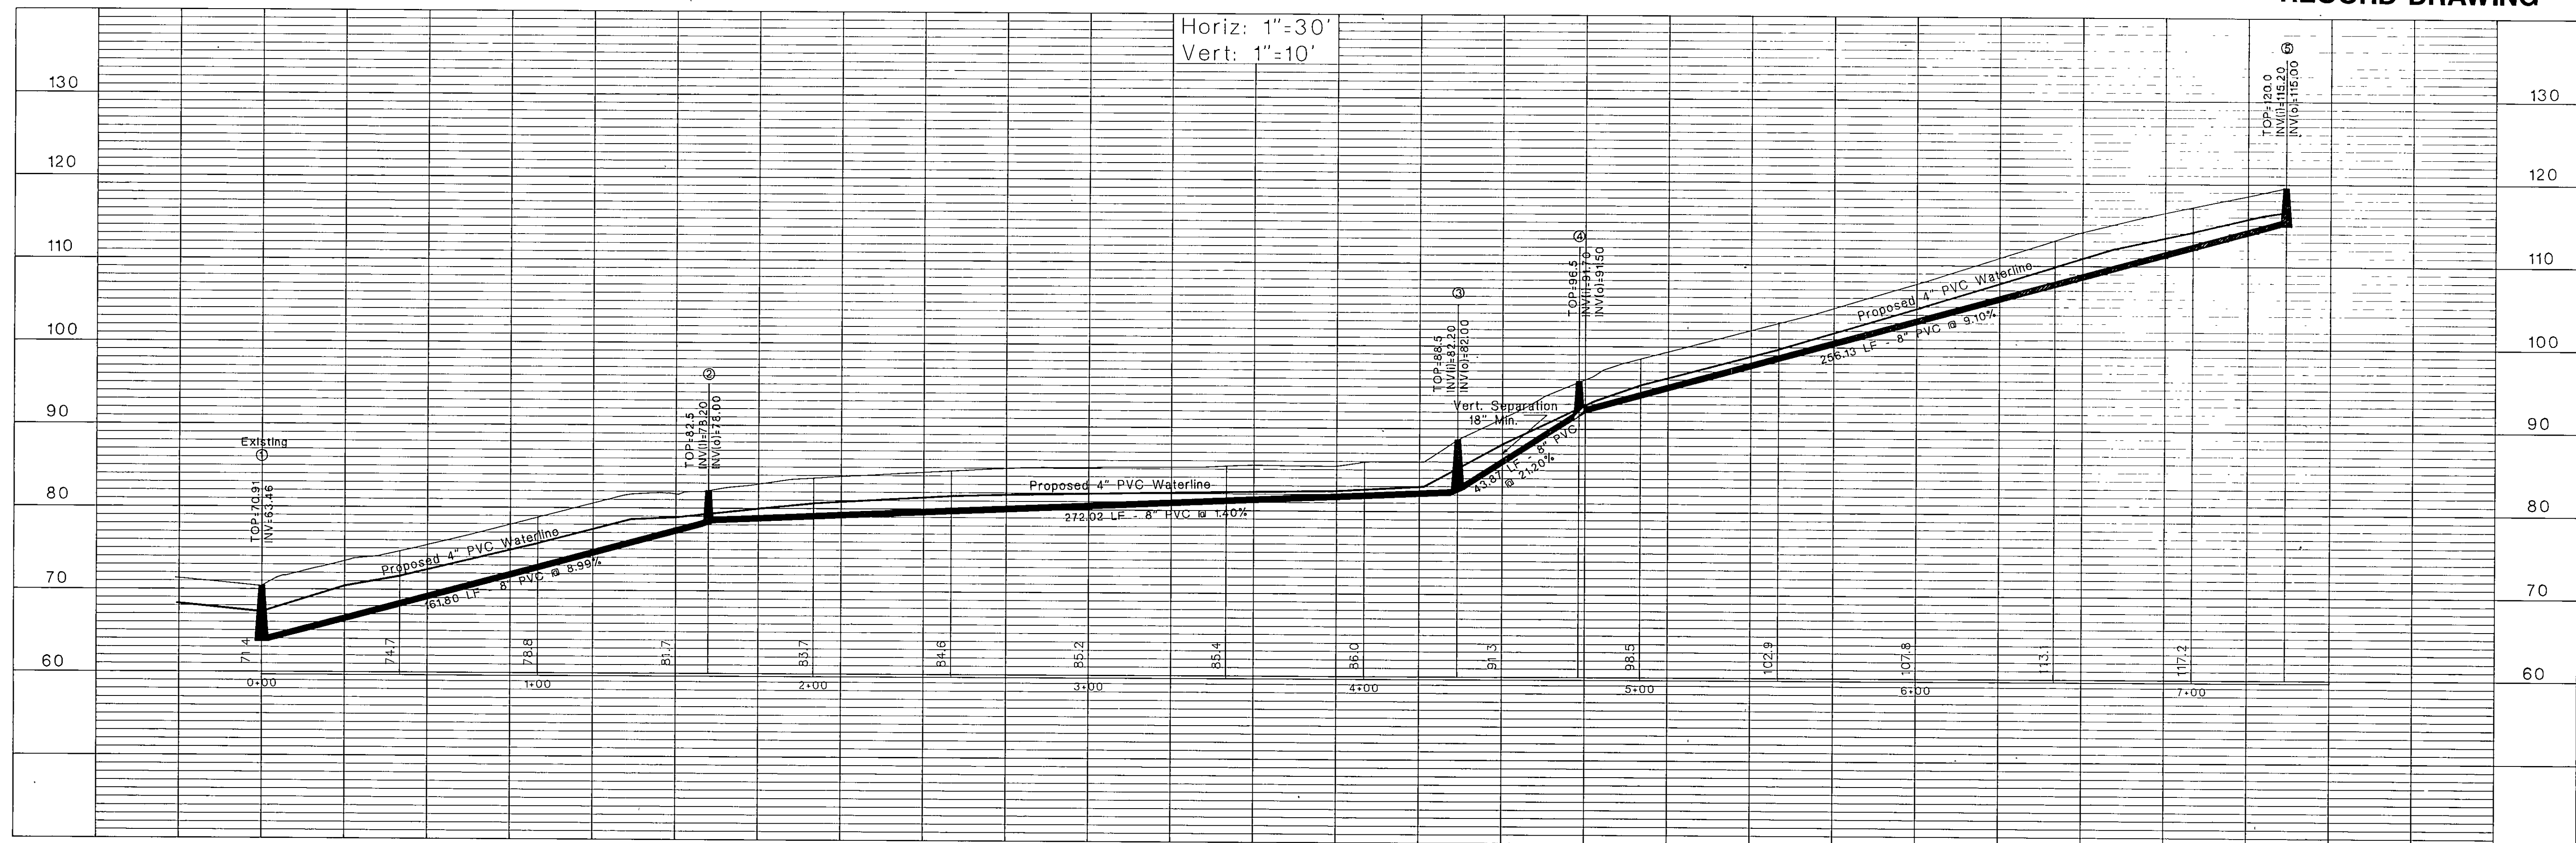

City of Roanoke
Office of City Engineer
215 W. Church Avenue
Room 350
Roanoke, VA 24011
(703) 981-2731

Crisis Intervention Center
at Coyner Springs

Drawn By	DWD
Designed By	DWD
Checked By	JAP III
Date	April 5, 1991
Scale	As Shown
Plan Number	6171
Sheet	SP-3