

DATE: 11/15/2012

REVISIONS
 ▲
 ▲

**PIERSON
ENGINEERING
&
SURVEYING**

P.O. BOX 311
44 CATAWBA ROAD
DALEVILLE, VA 24083


(540) 966-3027 TEL
(540) 966-5906 FAX
e-mail: rpierson@bnet.com

**DALECOURT WATER SYSTEM
NEW WATERLINE CONNECTION**
BOTETOURT COUNTY, VIRGINIA

PLAN SHEET

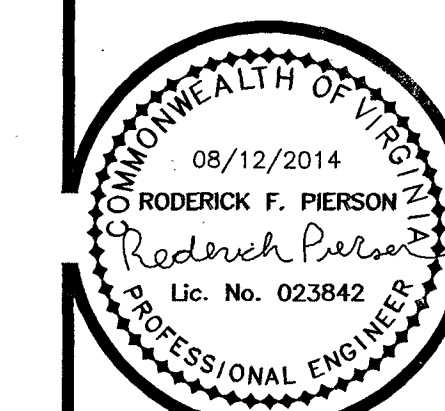

COMMISSION No.
R201250
SHEET
C2

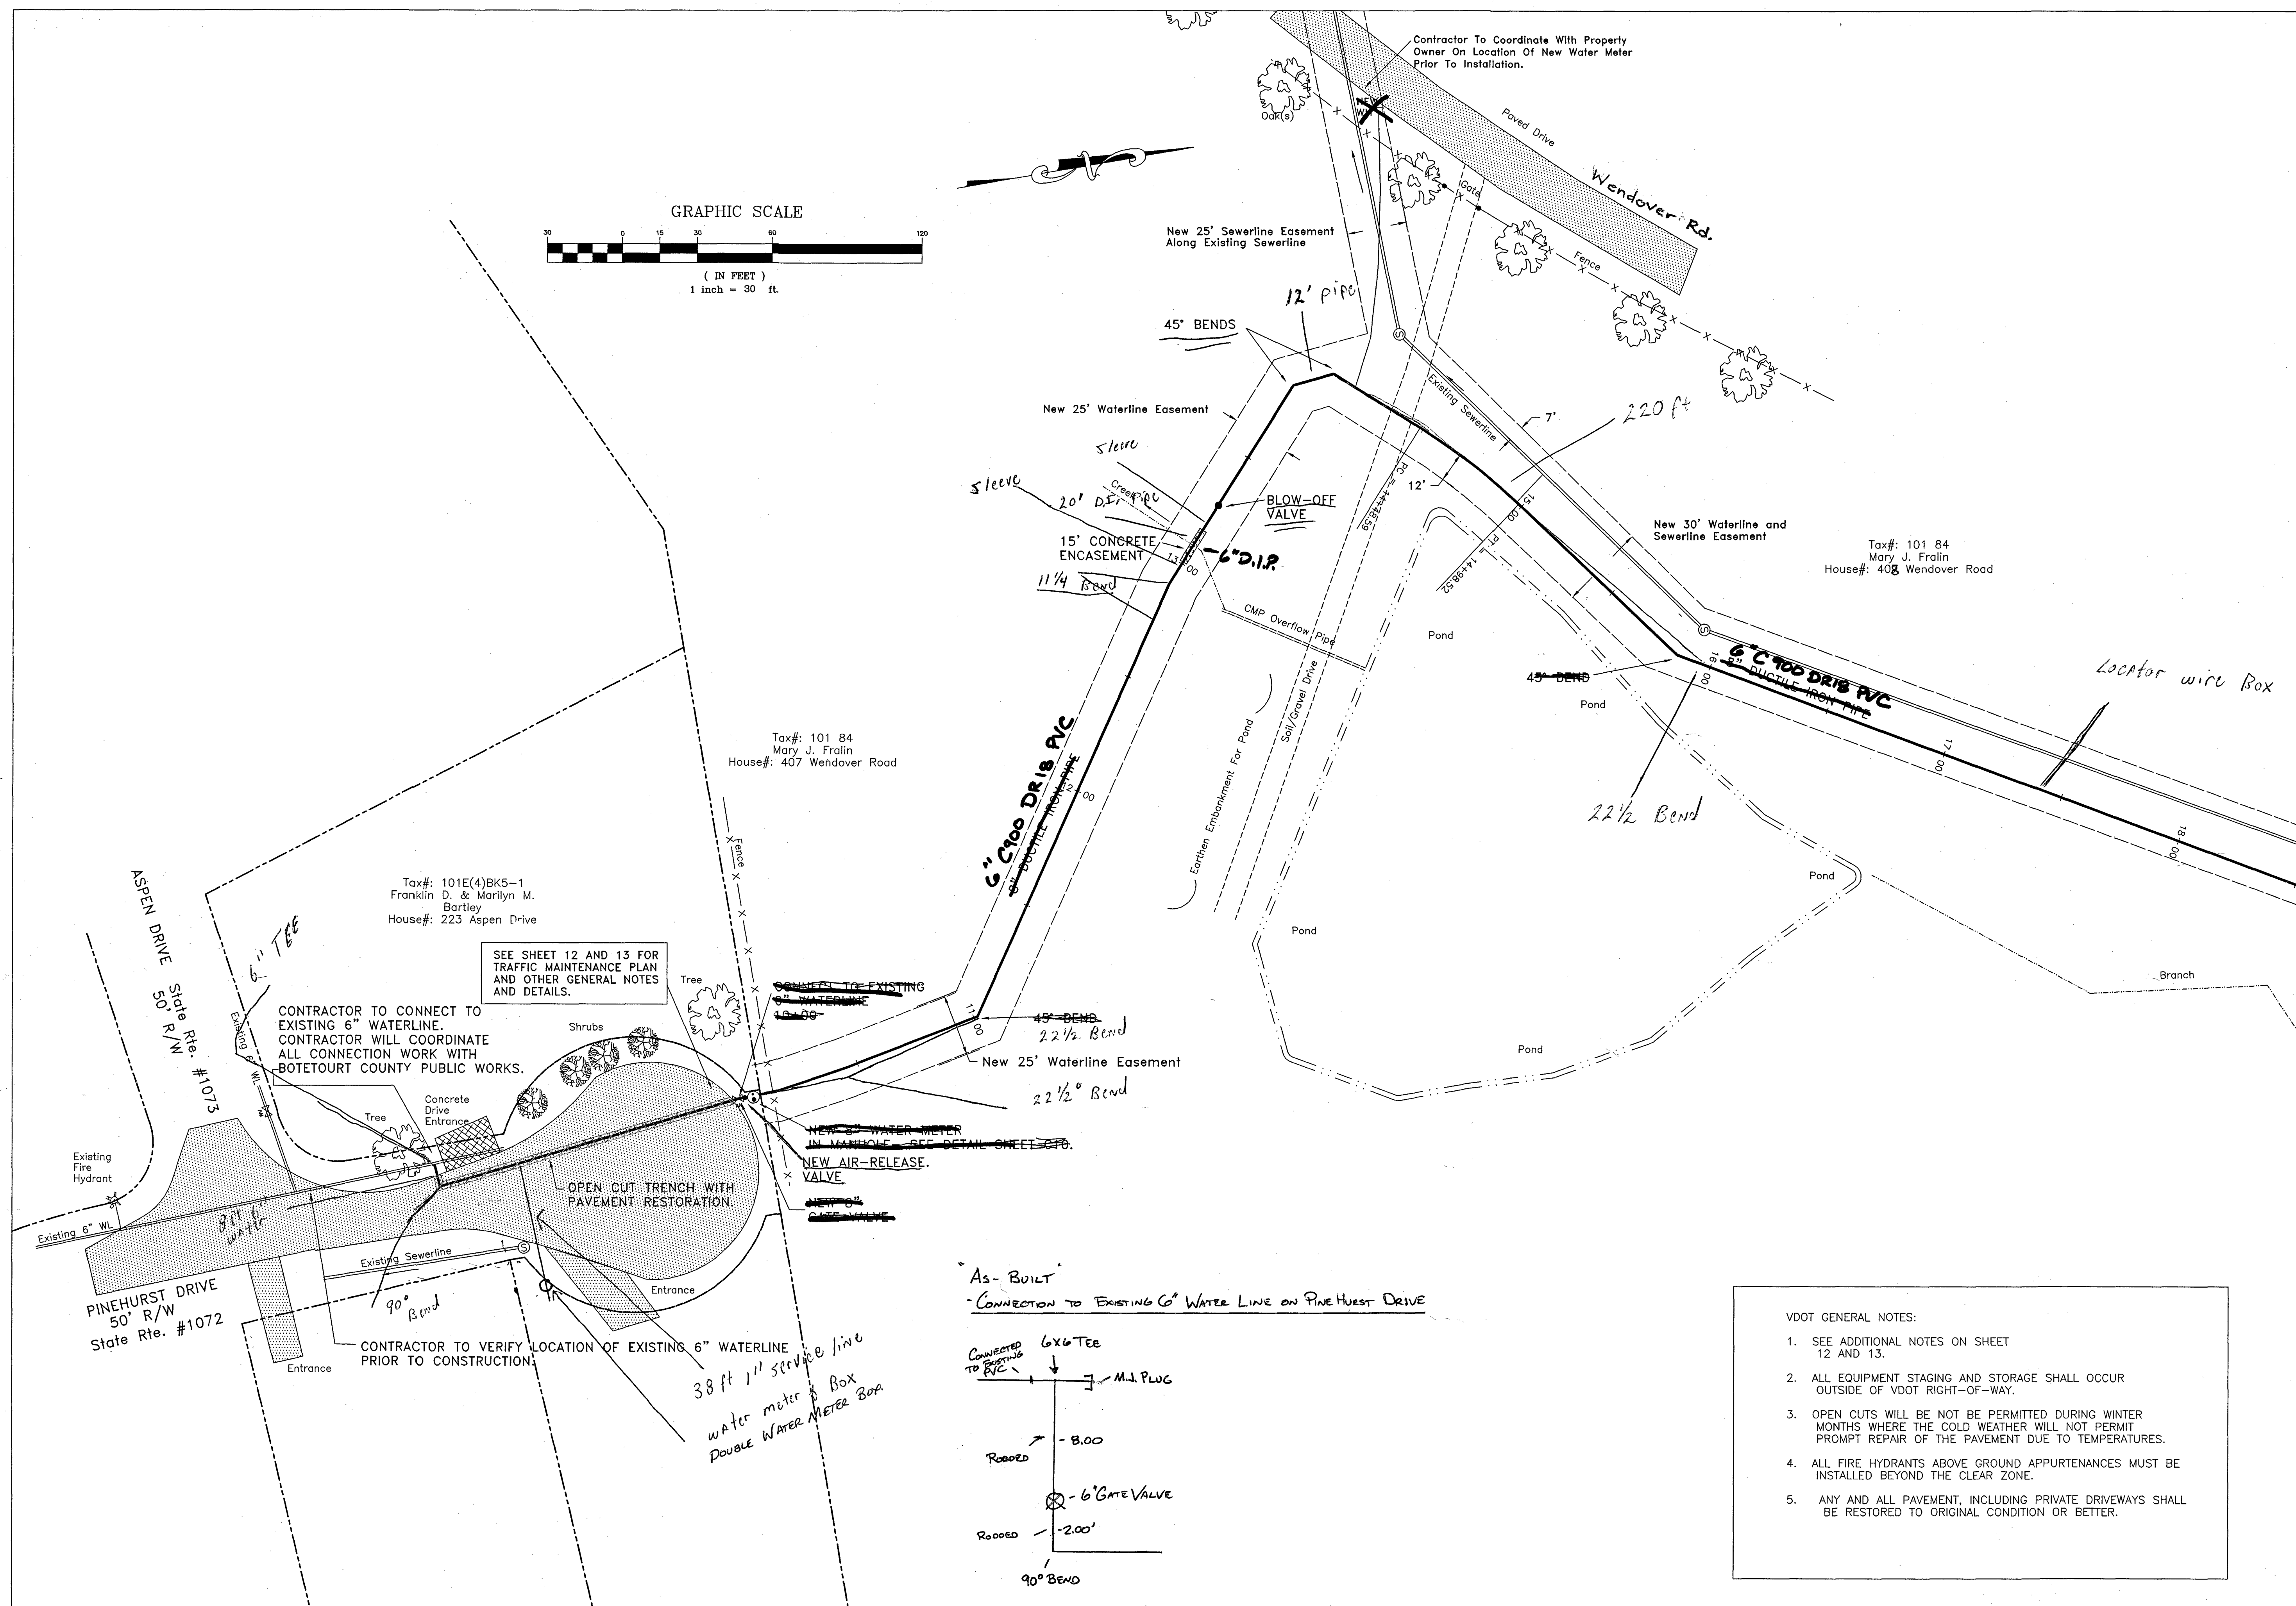

MATCHLINE SHEET C3