
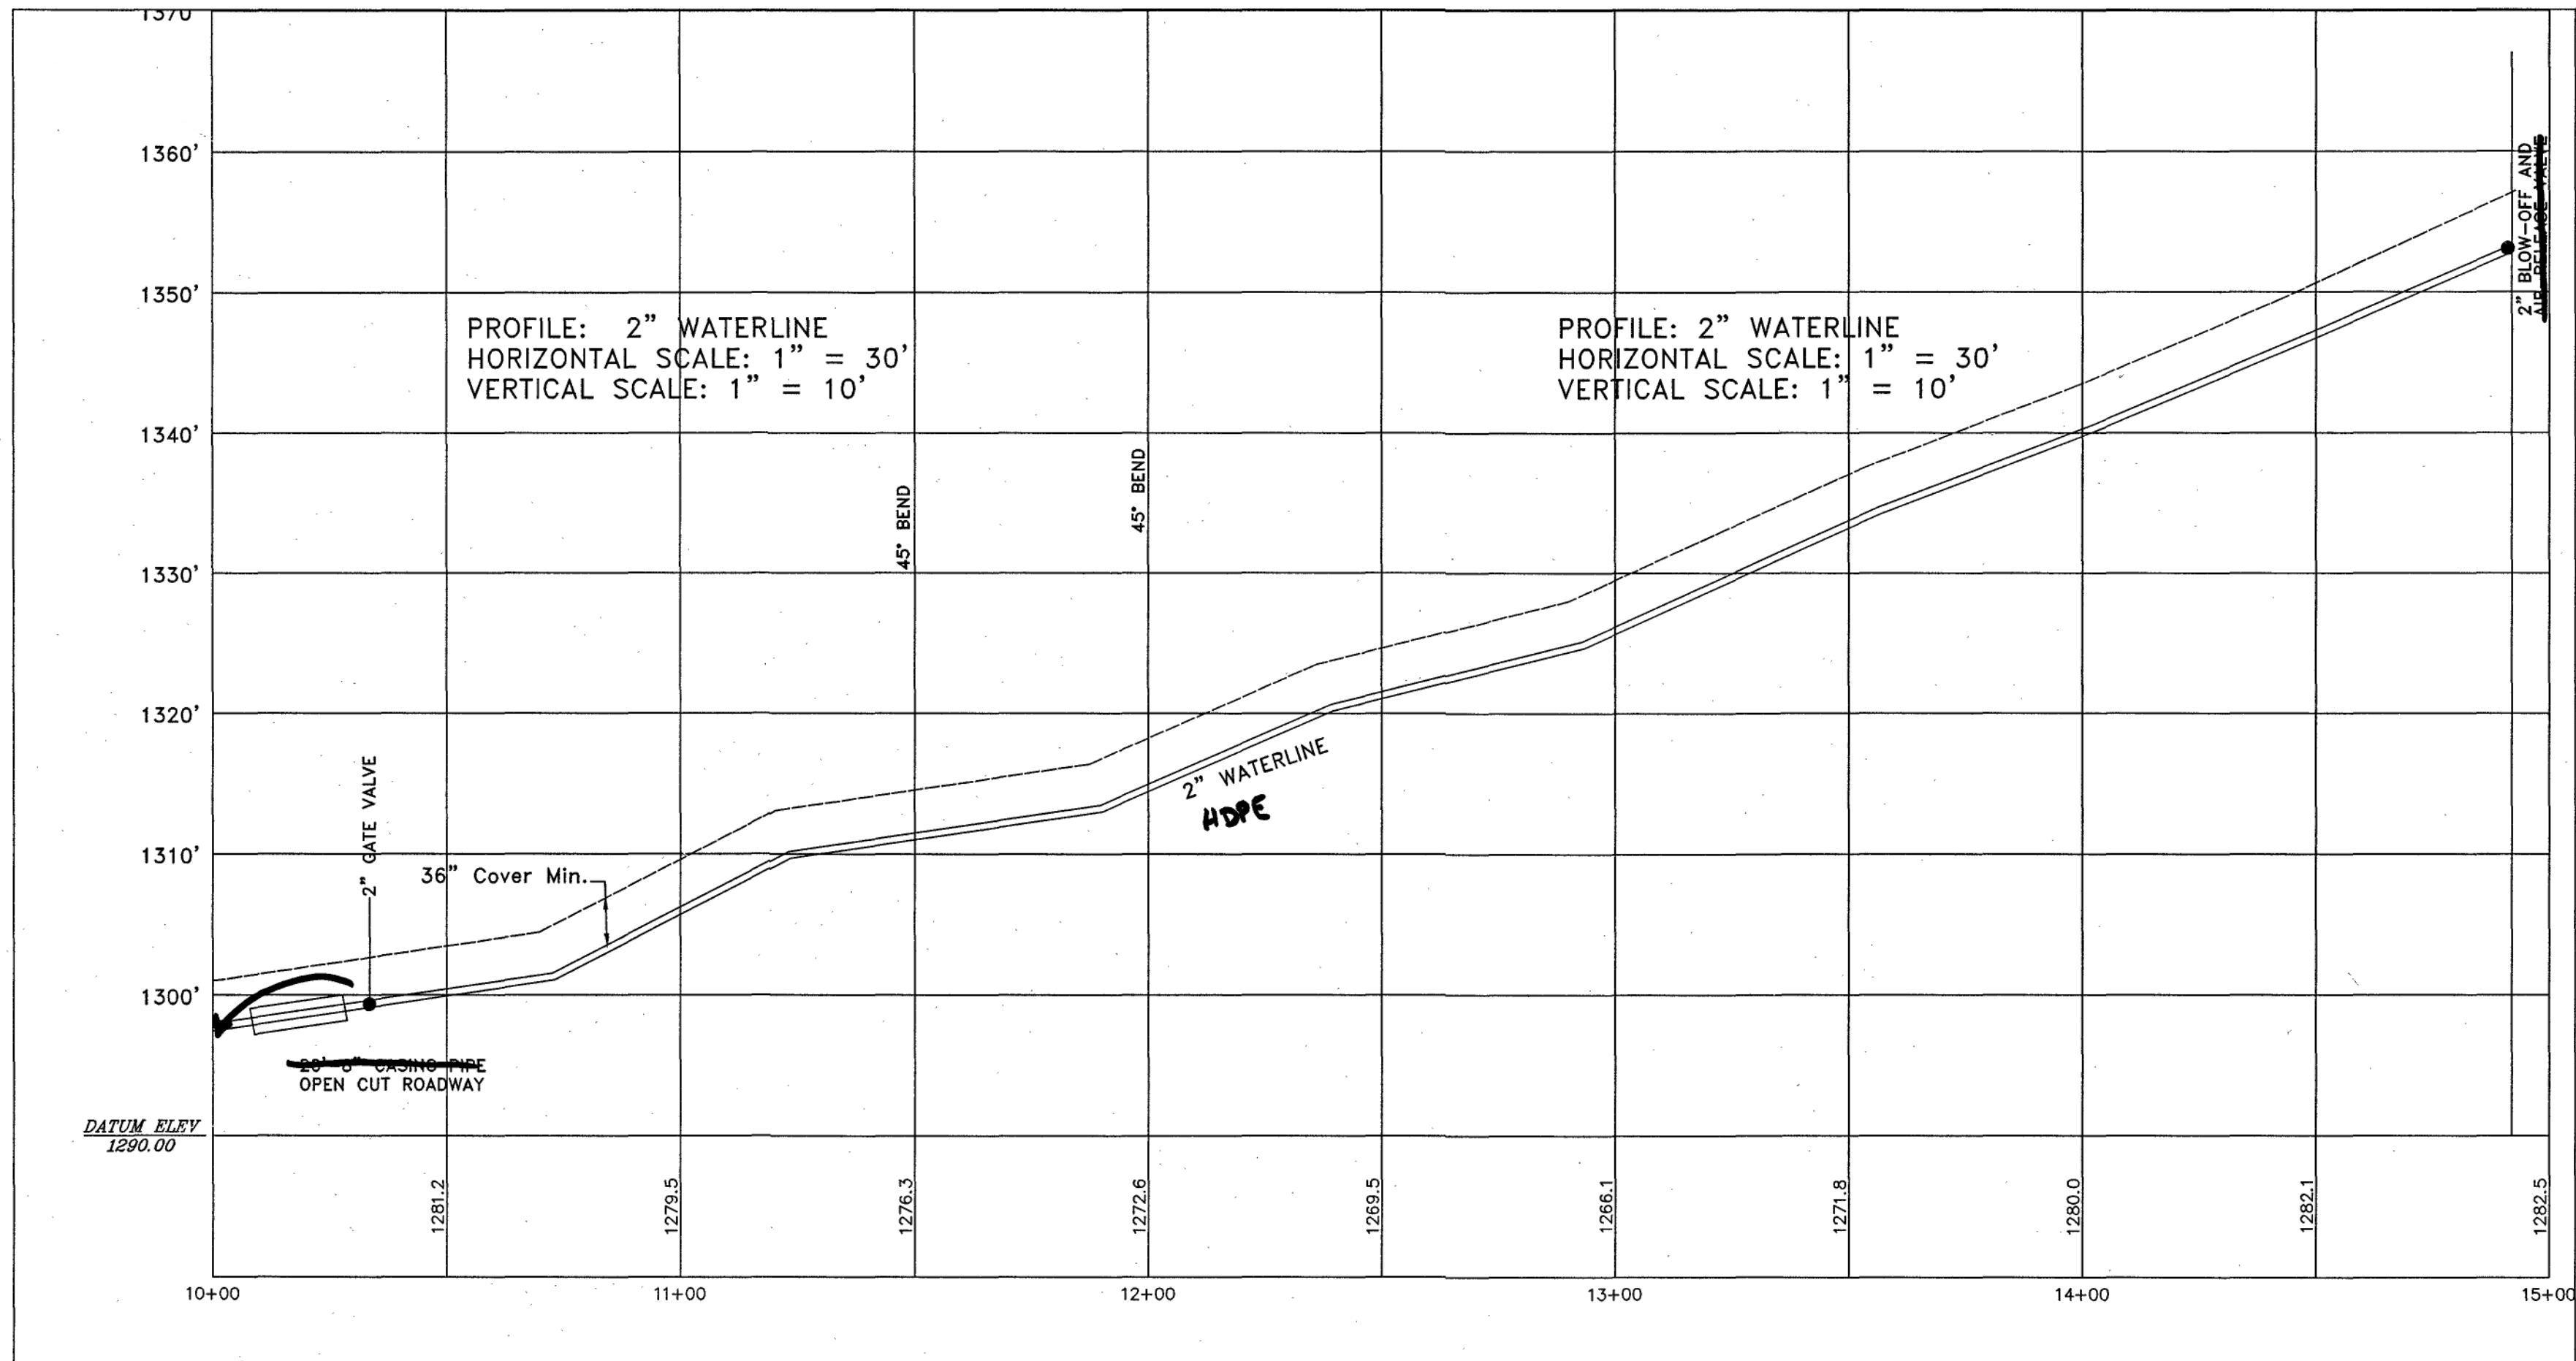


MATCHLINE SHEET C8

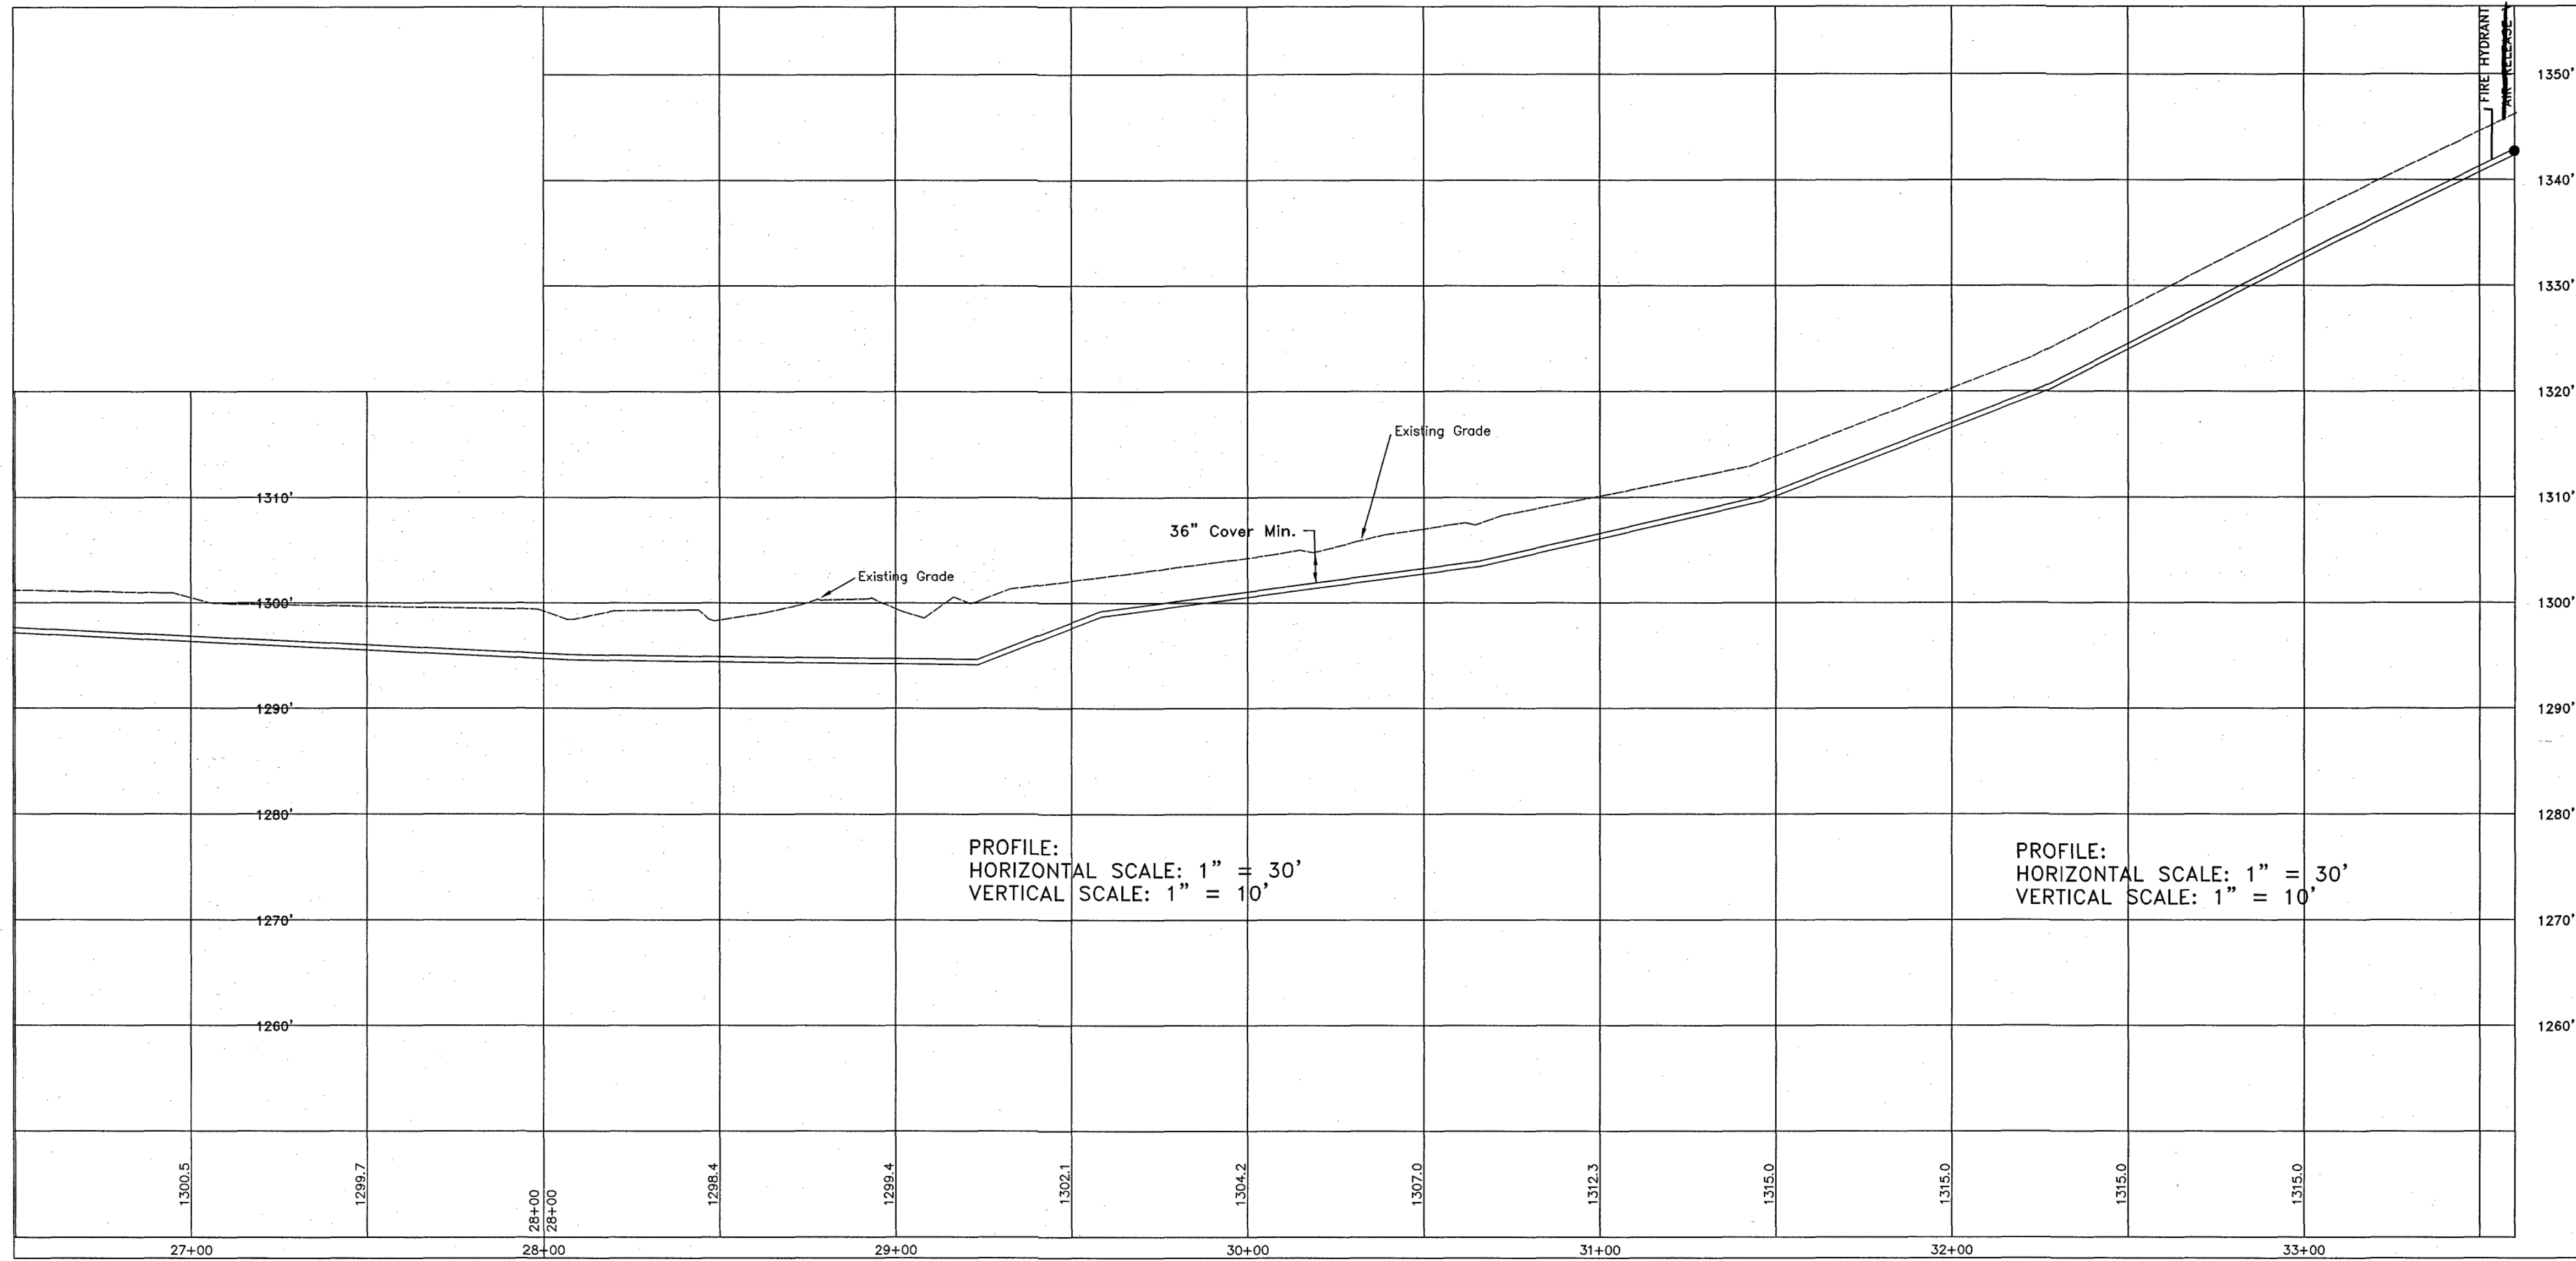

DATE: 11/15/2012

REVISIONS


PIERSON
ENGINEERING
&
SURVEYING

P.O. BOX 311
44 CATAWBA ROAD
DALEVILLE, VA 24083

(540) 966-3027 TEL
(540) 966-5906 FAX
e-mail: rpierson@rnbnet.com

DALECOURT WATER SYSTEM
NEW WATERLINE CONNECTION
BOTETOURT COUNTY, VIRGINIA

PROFILES

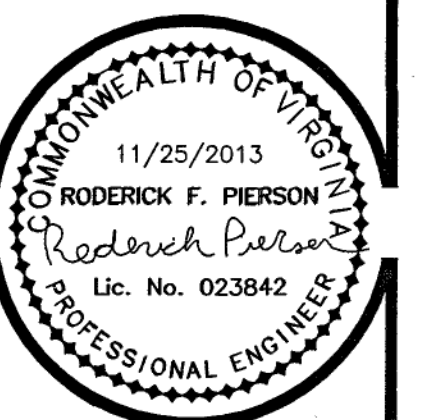

COMMISSION No.
R201250
SHEET
C9