
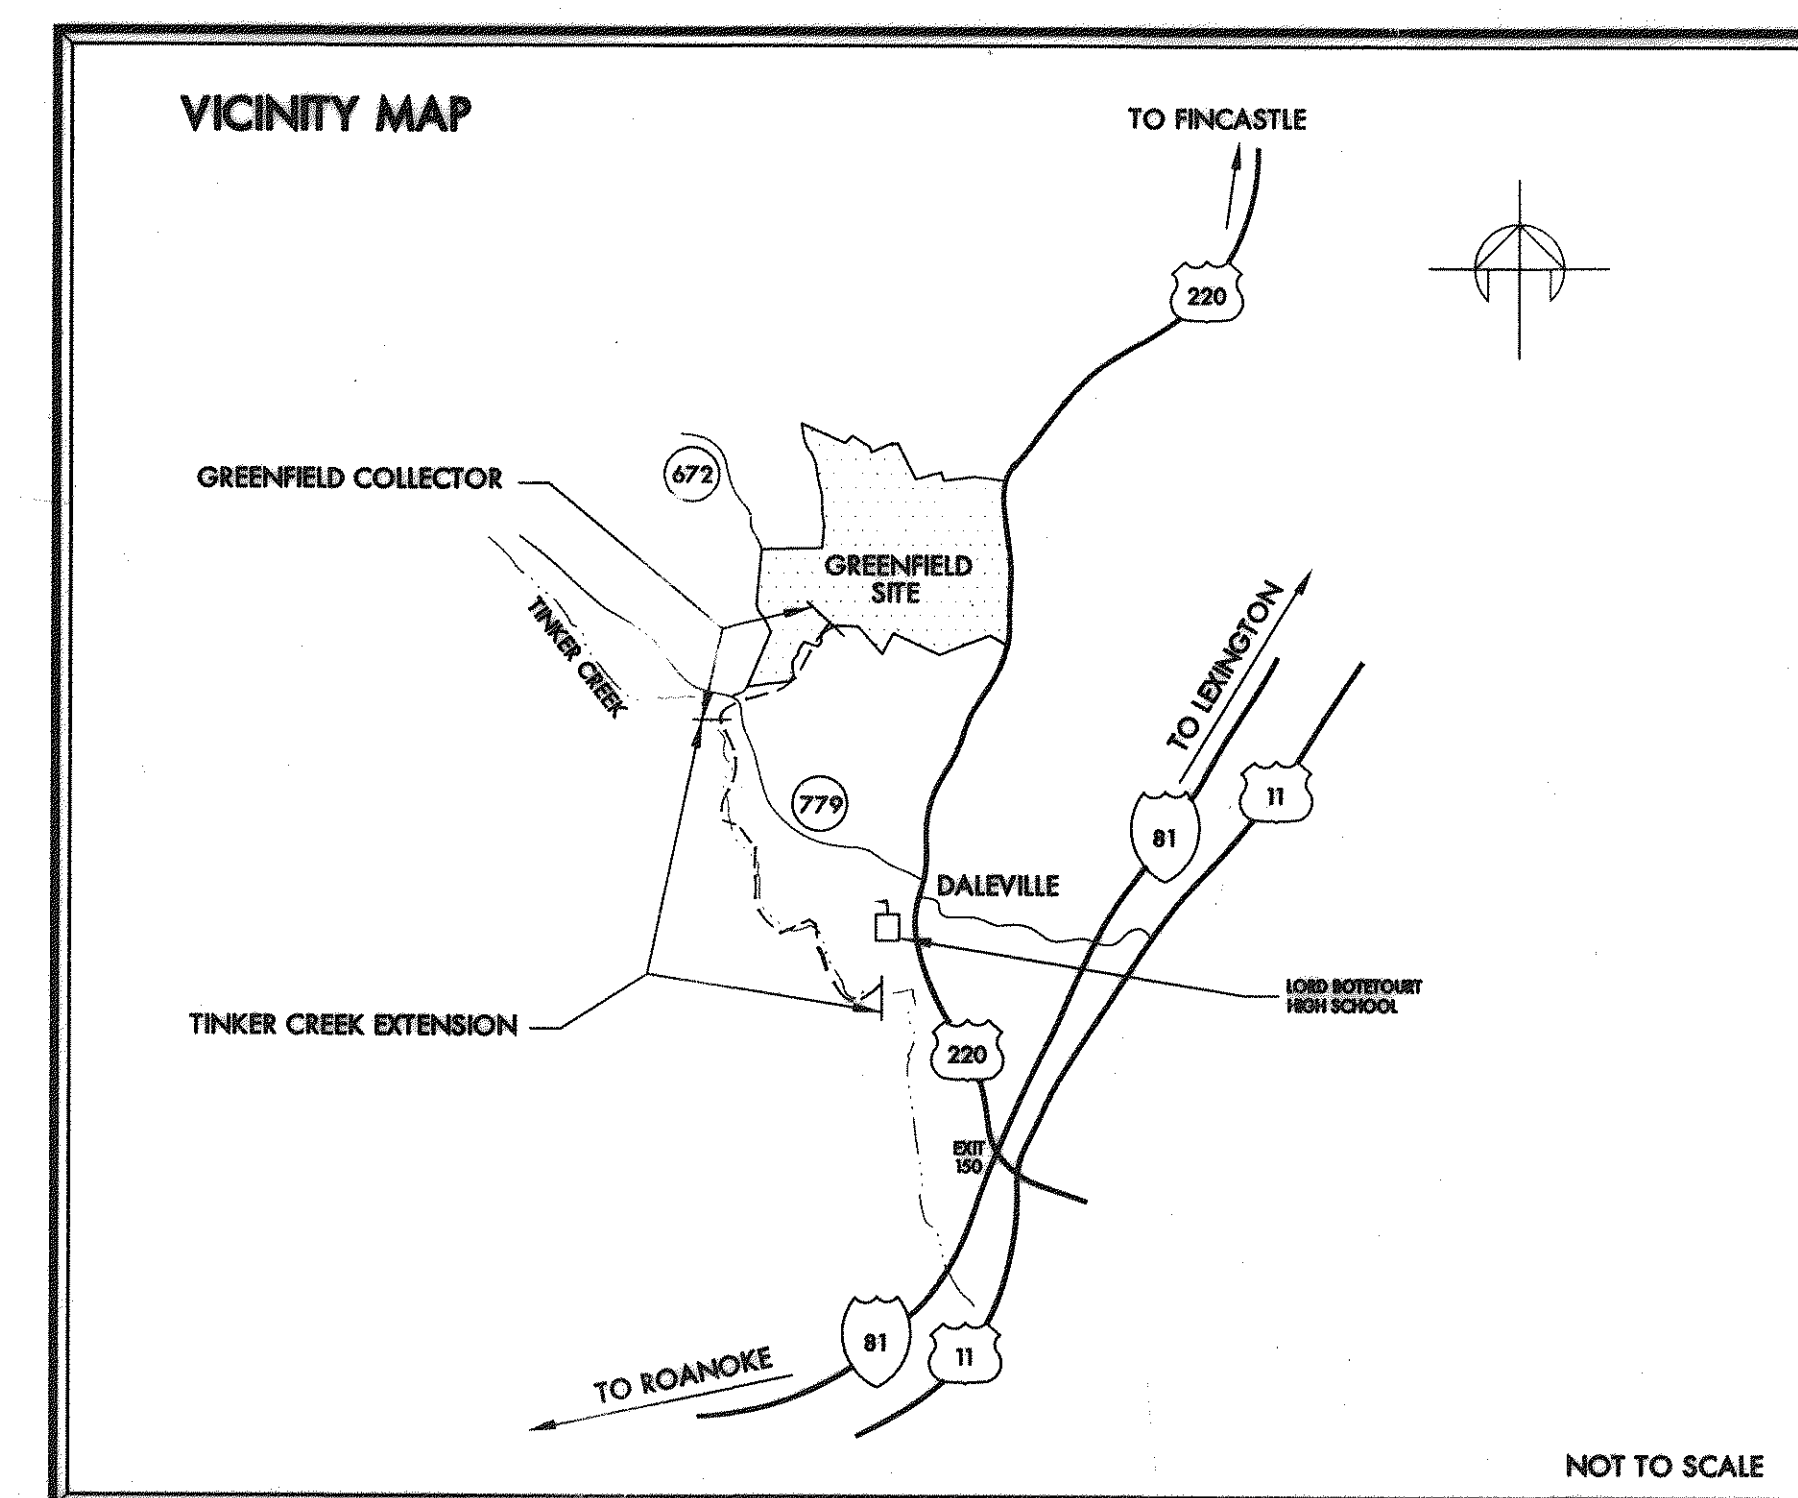


GREENFIELD COLLECTOR AND TINKER CREEK EXTENSION SANITARY SEWER PROJECT


BOTETOURT COUNTY
DEPARTMENT OF PUBLIC WORKS

BOTETOURT COUNTY, VIRGINIA
DECEMBER, 1996

PROJECT NAME: Greenfield Collector and
Tinker Creek Extension
DATE: Dec. 1996
TYPE: Sewer
LOCATION: 672
TOTAL # SHEETS: 27
OF SETS: 621

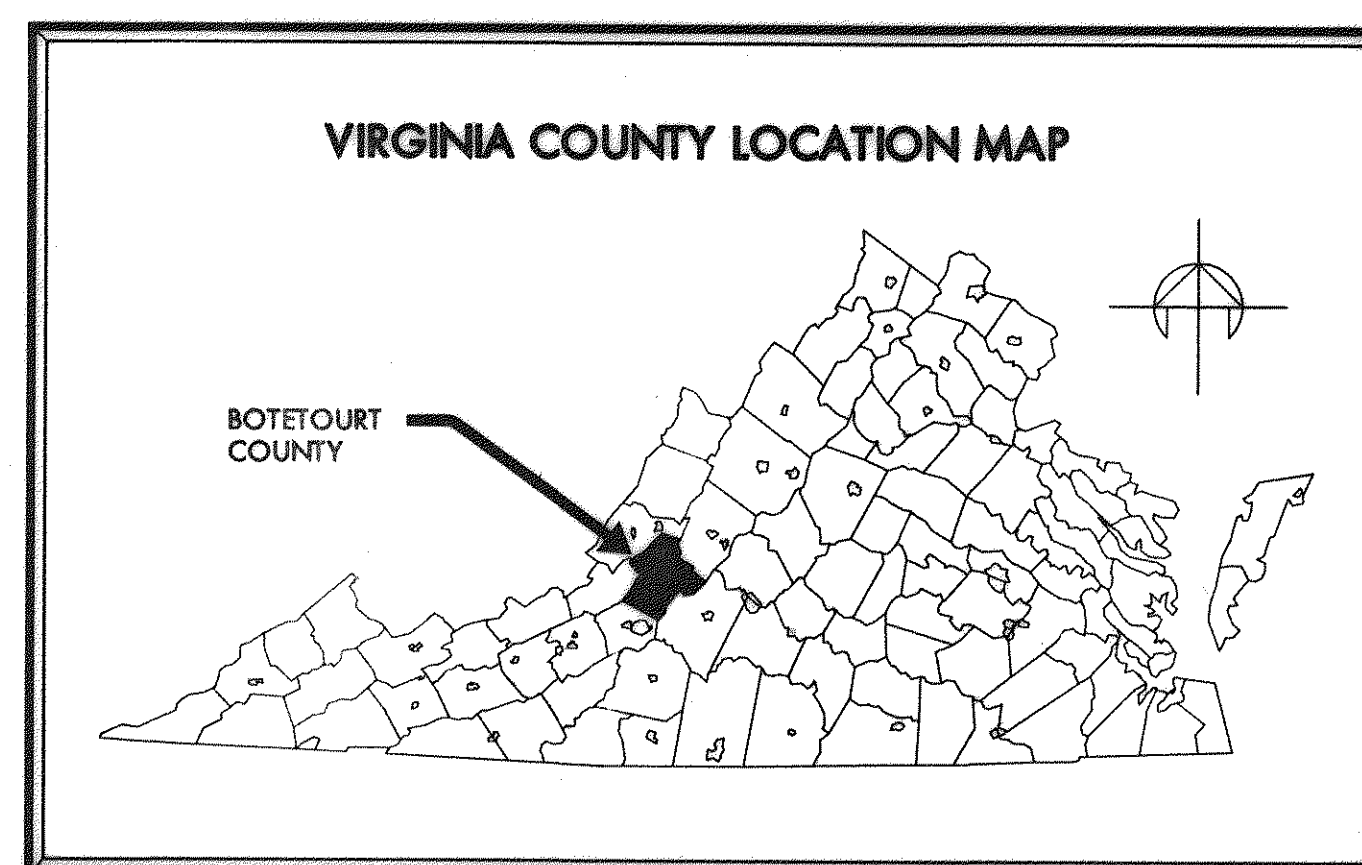

AS-BUILT

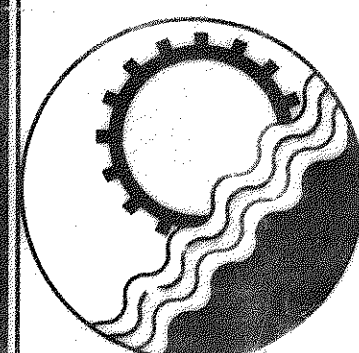

ENGINEERING CONCEPTS, INC.

20 S. ROANOKE ST., PO BOX 619
FINCASTLE, VIRGINIA 24090
540.473.1253 FAX: 540.473.1254

OWNER: BOTETOURT COUNTY

DEPARTMENT OF PUBLIC WORKS
1 WEST MAIN ST., BOX 4
FINCASTLE, VIRGINIA 24090
540.473.8316

