
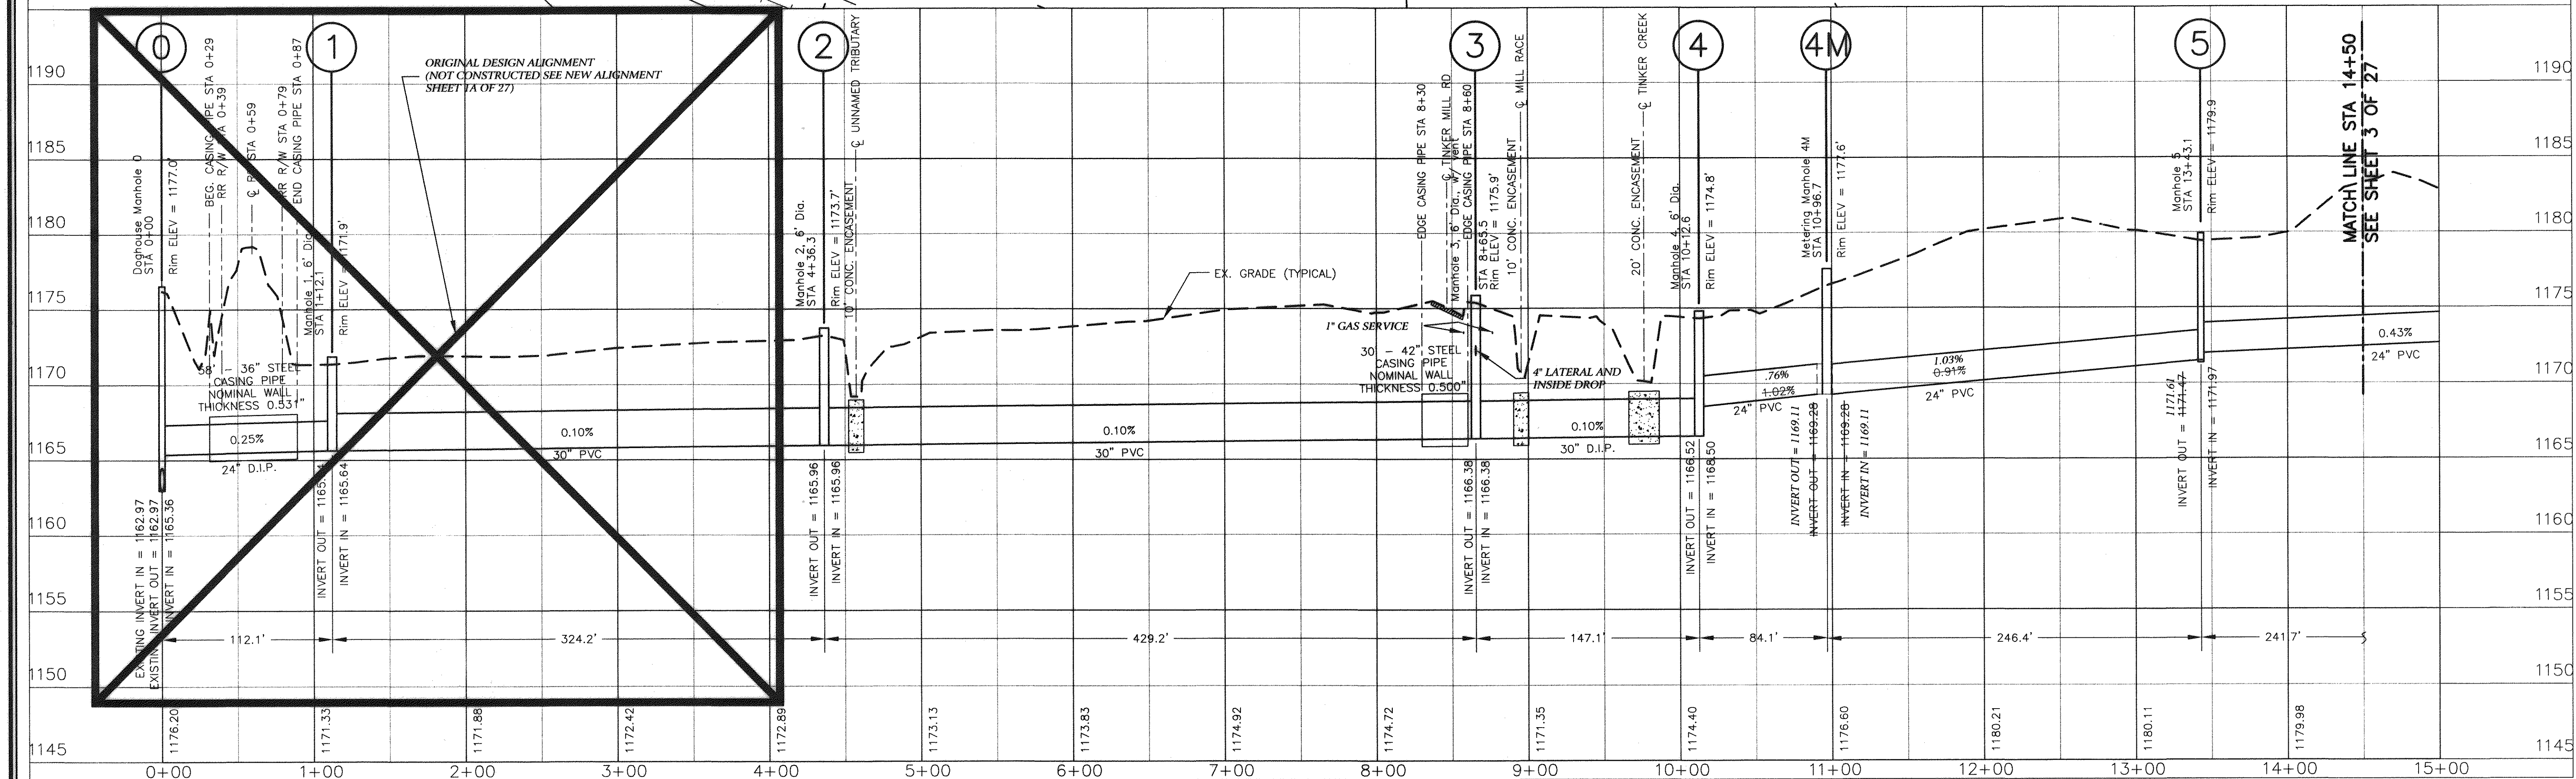


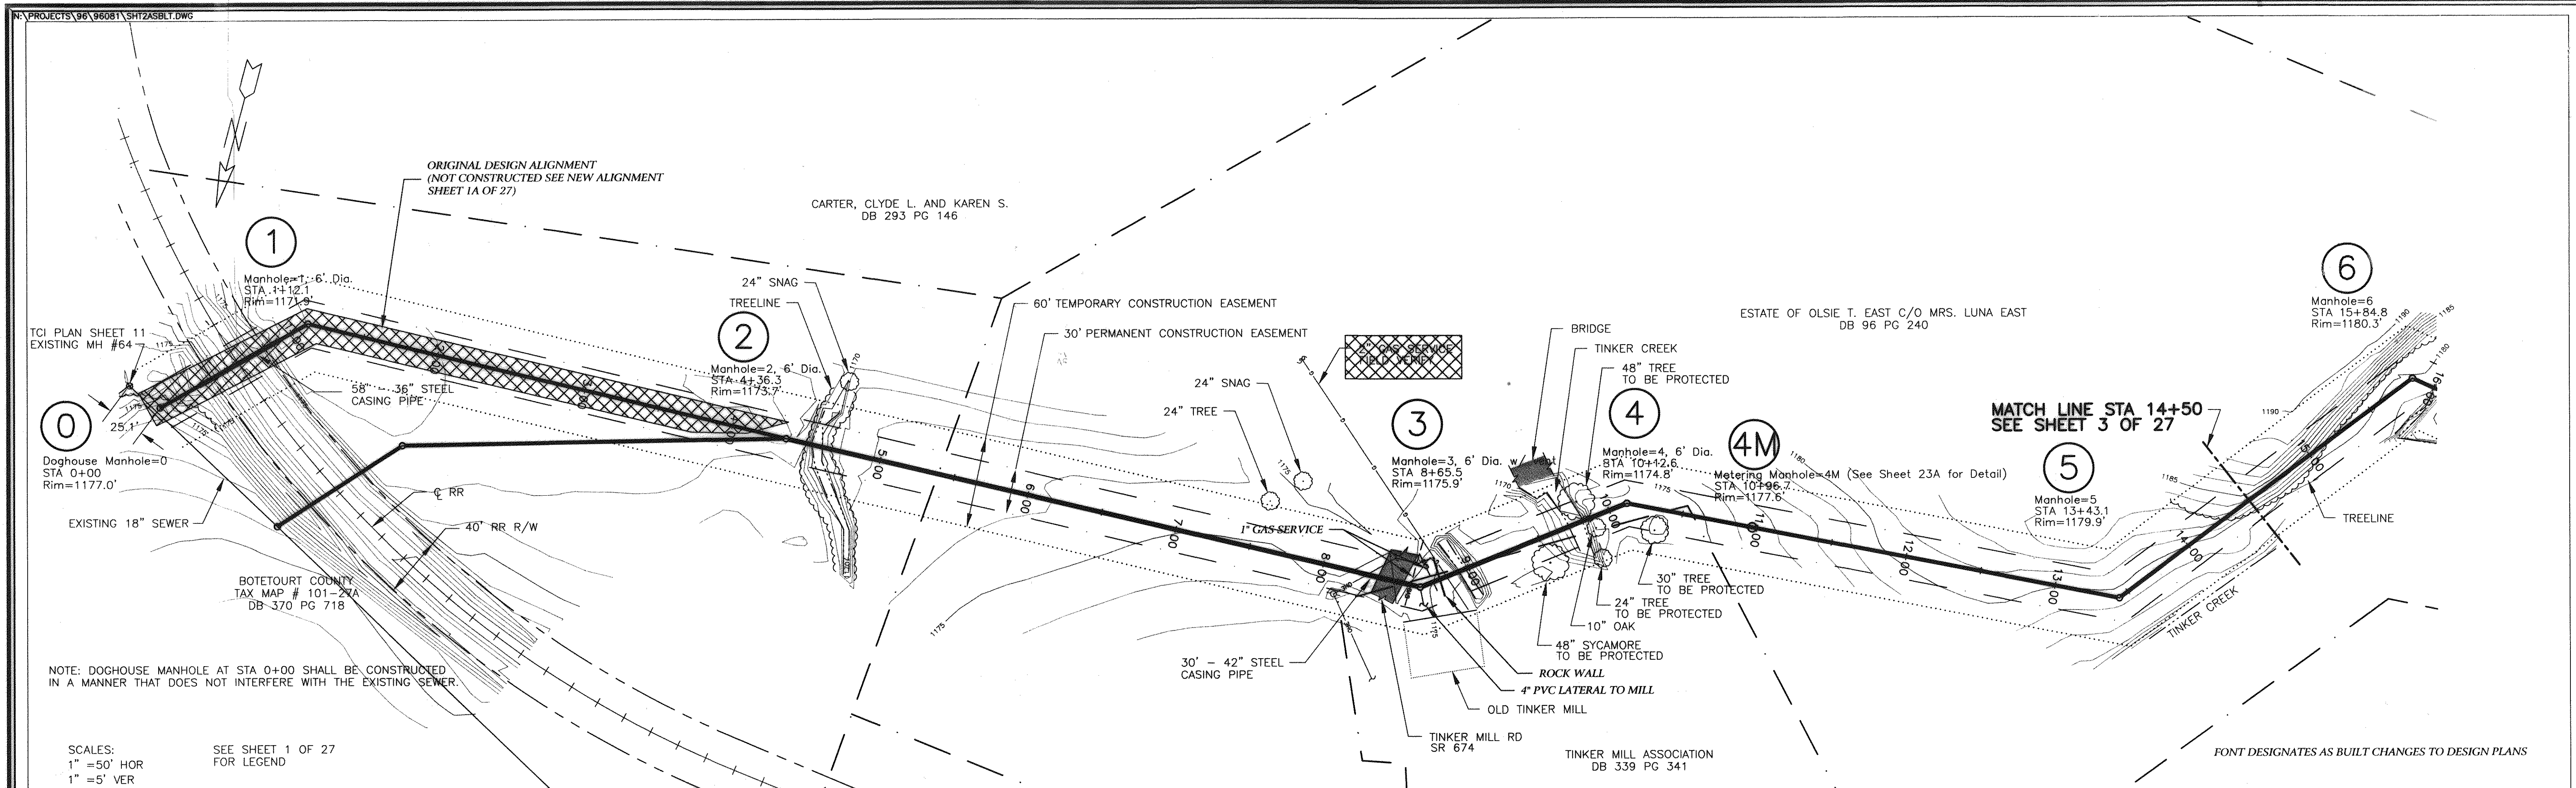

No.	Revision	By	Appd.	Date	Drawn
1	RR Steel Casing Length	SCG	WPJ	Feb. 1997	SCG
2	Metering MH 4M	SCG	WPJ	May 1997	Designed SCG
3	Raised RR Bore & pipe to MH4	SCG	WPJ	July 1997	Checked WPJ/UST
					Approved WPJ