


MATCH LINE STA 42+50
SEE SHEET 5 OF 27


MATCH LINE STA 28+50
SEE SHEET 3 OF 27

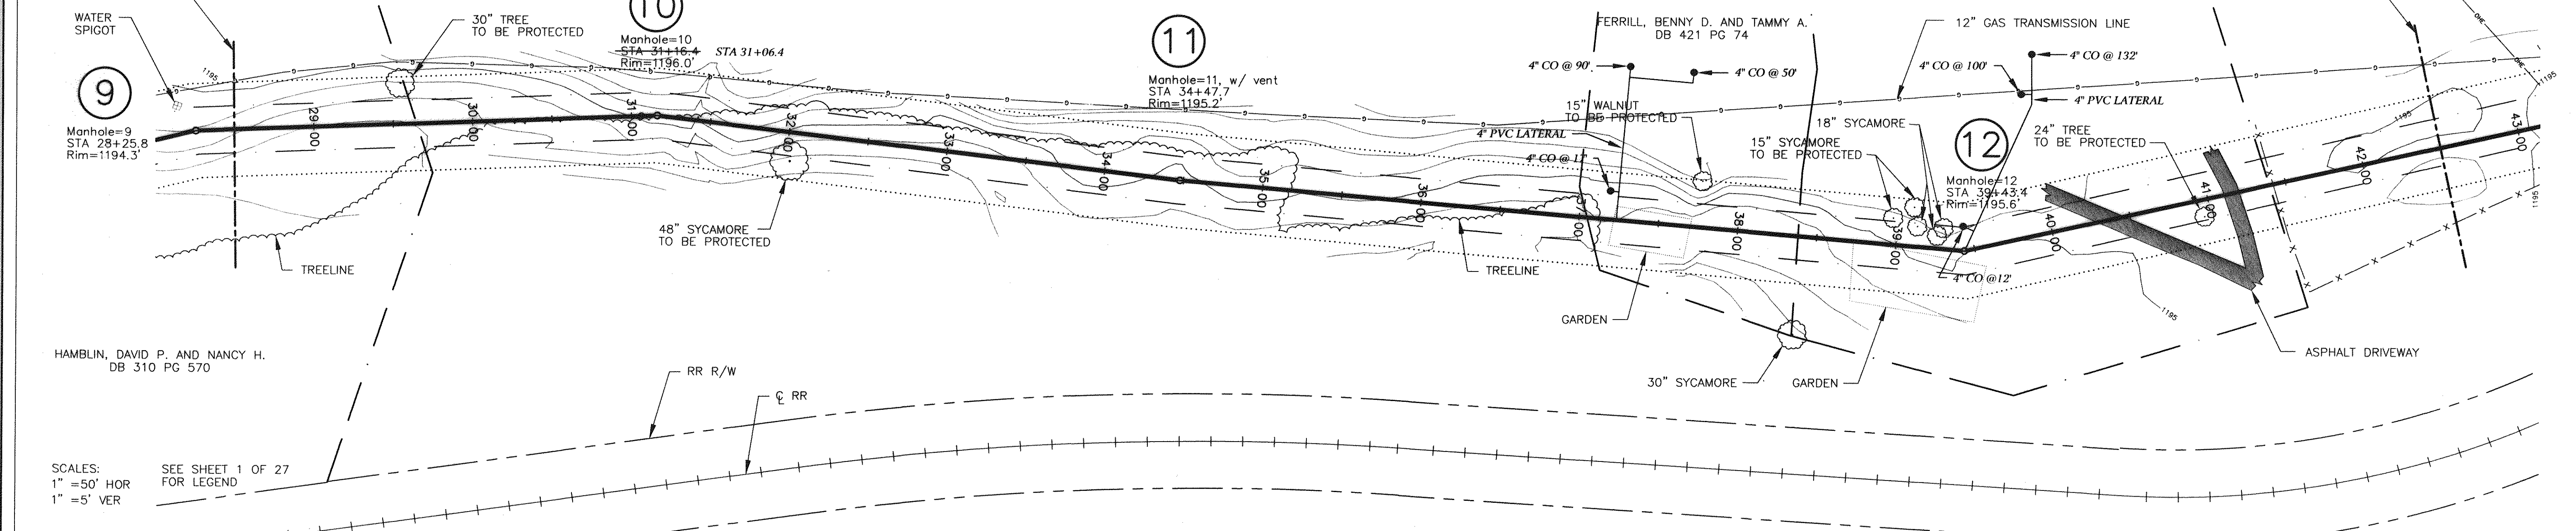

SCALES:
1" = 50' HOR
1" = 5' VER

SEE SHEET 1 OF 27
FOR LEGEND

FONT DESIGNATES AS BUILT CHANGES TO DESIGN PLANS

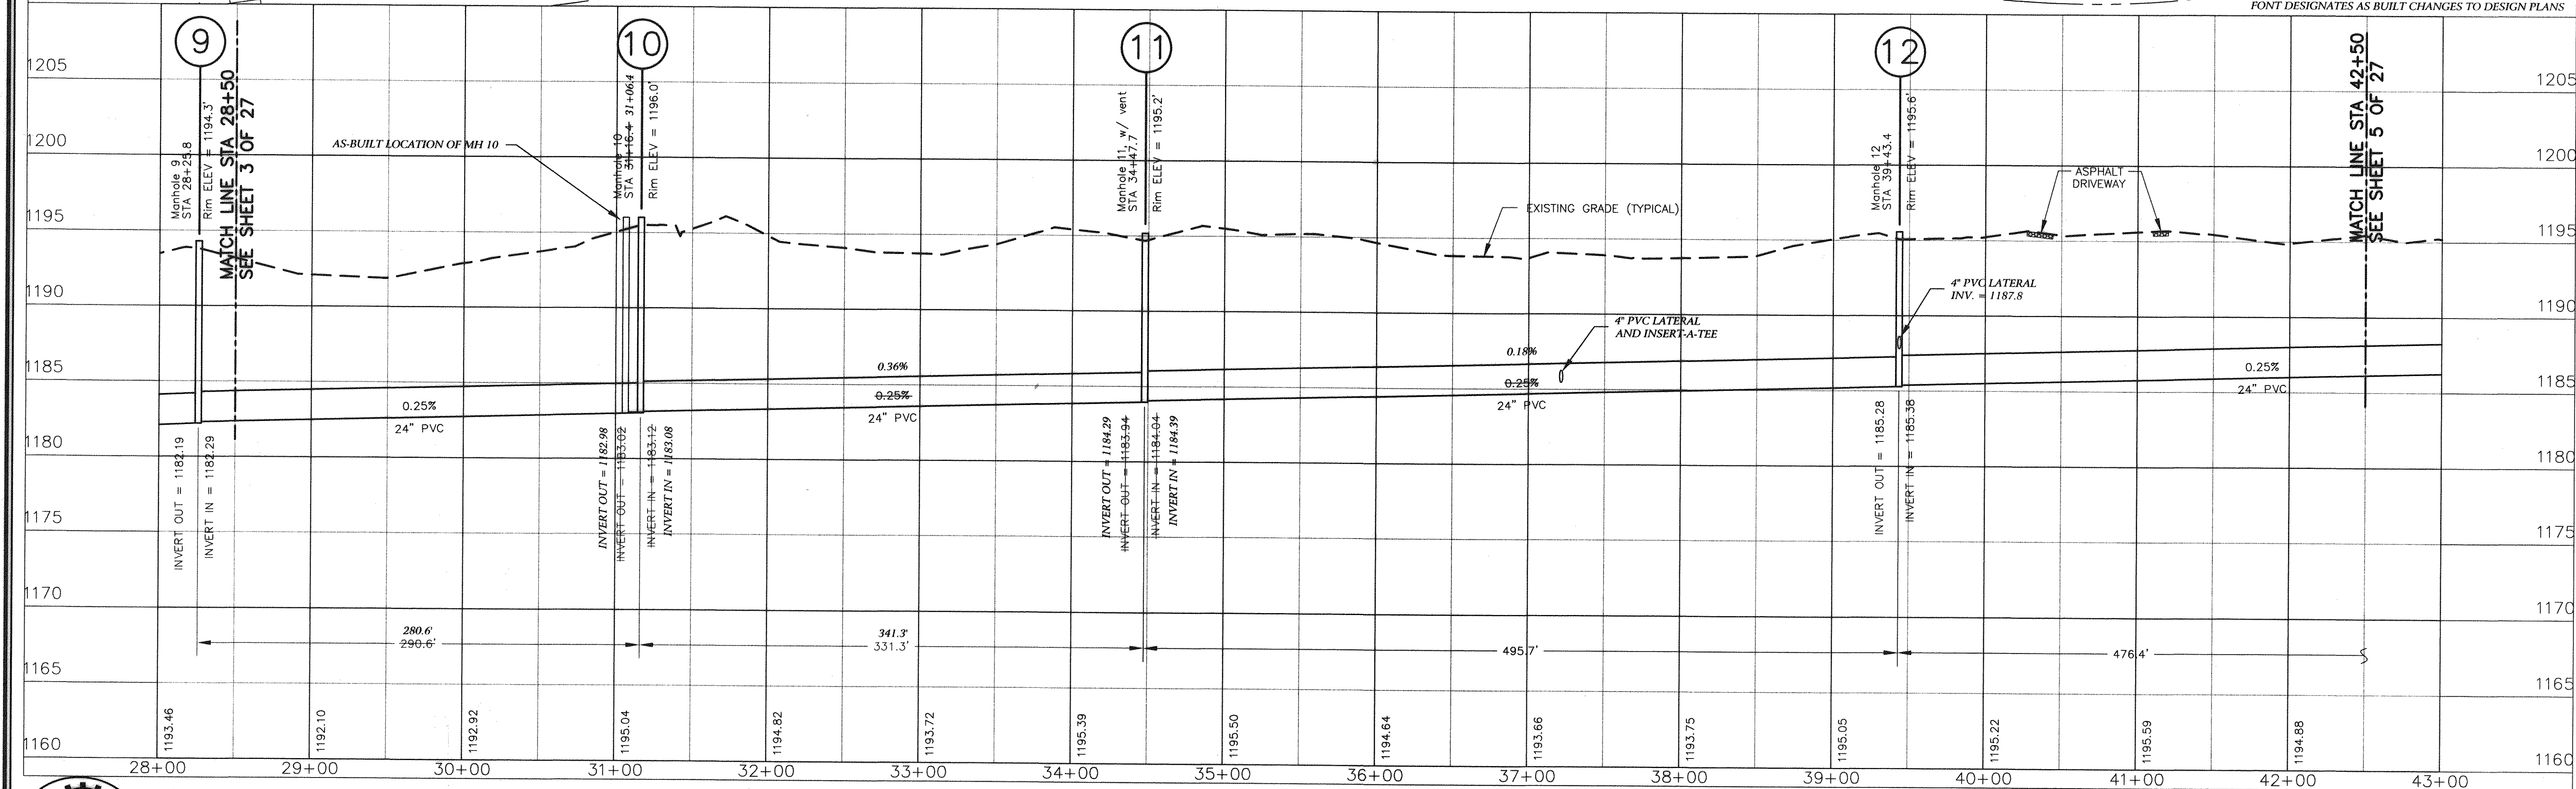

No.	Revision	By	Appd.	Date	Drawn
1	Relocate MH 13 & shorten line	SCG	WPJ	SEPT. 1997	JHG
					Designed
					SCG
					Checked
					WPJ/JST
					Approved
					WPJ