

MAYO, WILEY S. AND MARTHA B.
DB 189 PG 397

DAMIANO, JOSEPH R.
DB 343 PG 94

COOPER, D.J.
DB 240 PG 439



MATCH LINE STA 42+50
SEE SHEET 4 OF 27

MATCH LINE STA 56+50
SEE SHEET 6 OF 27

SUBMAIN B
SEE SHEET 17 OF 27

SUBMAIN A
SEE SHEET 16 OF 27

FONT DESIGNATES AS BUILT CHANGES TO DESIGN PLANS

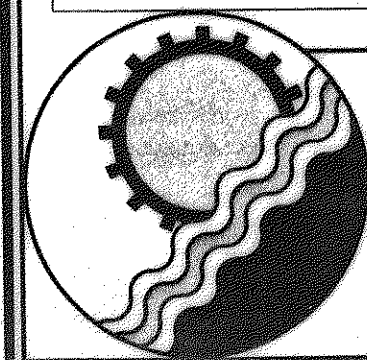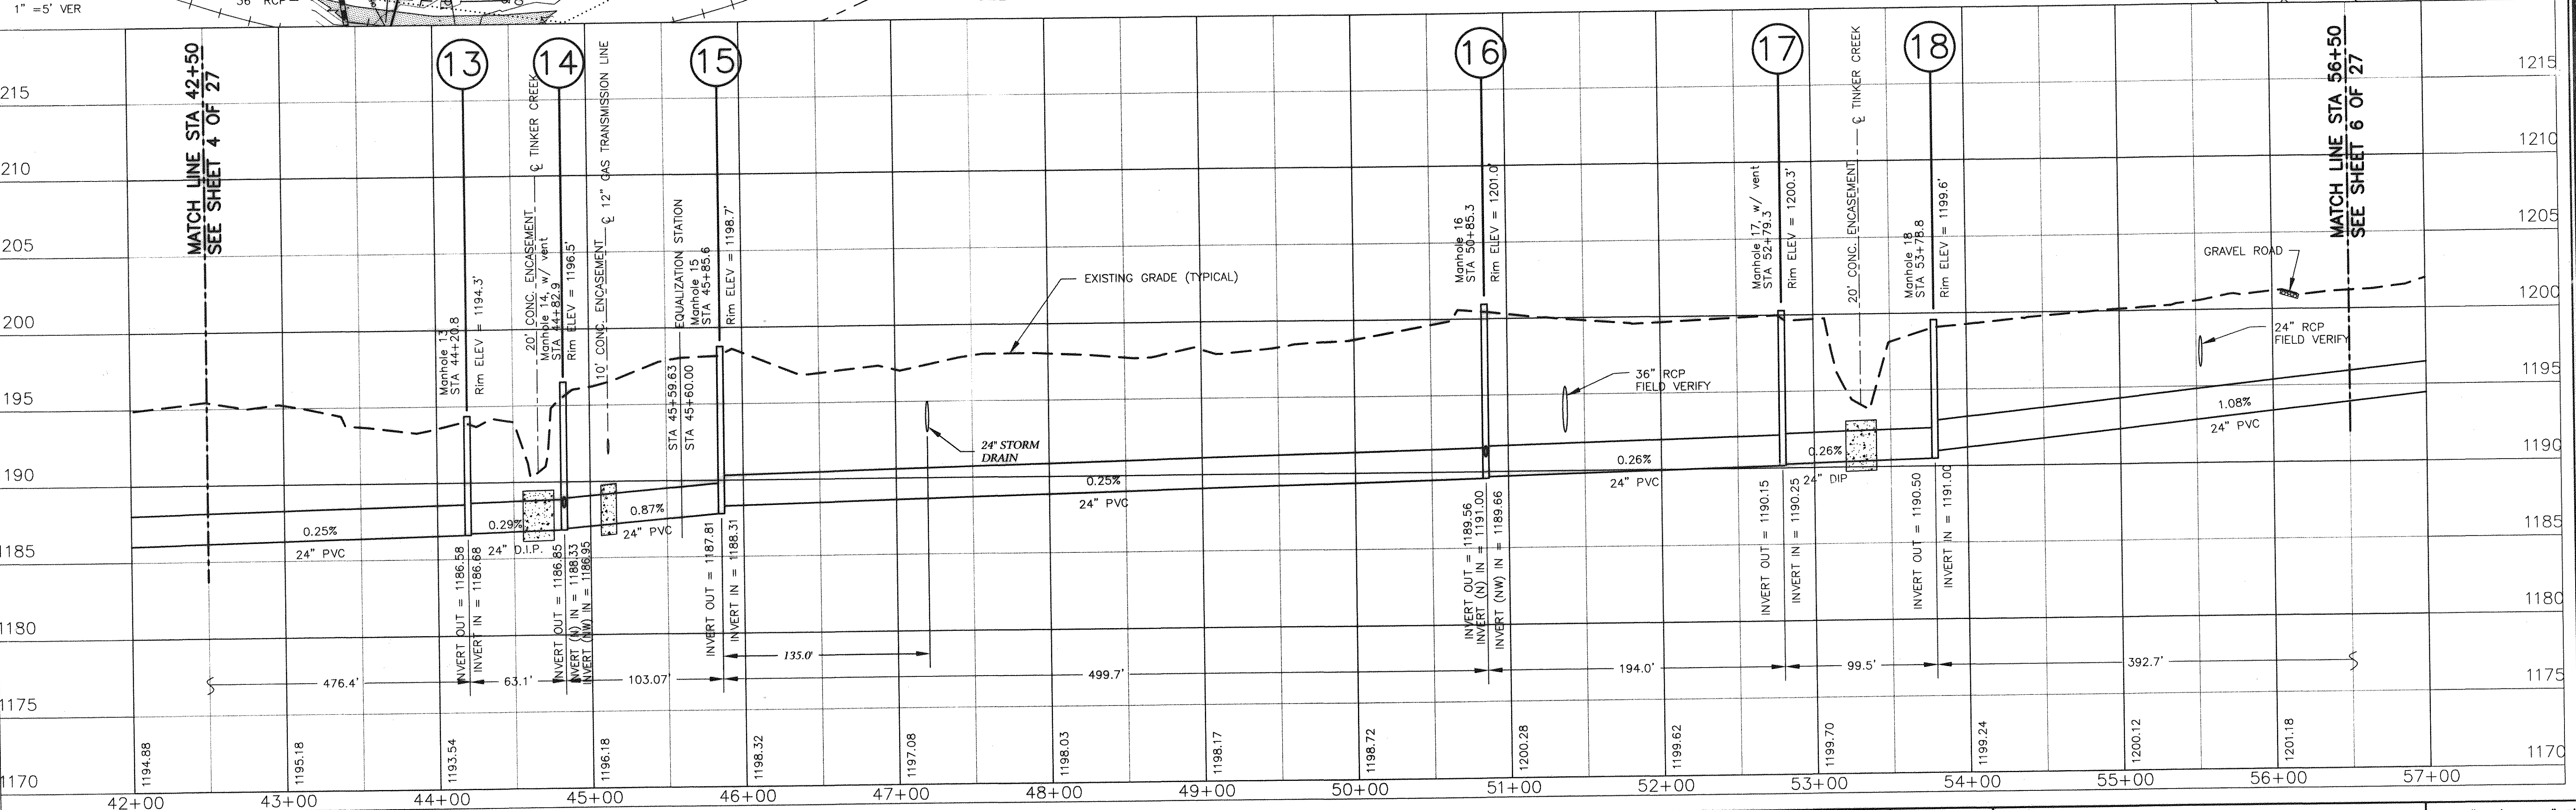

ENGINEERING CONCEPTS, INC.

20 S. ROANOKE ST., PO BOX 619
FINCASTLE, VIRGINIA 24090
540.473.1253 FAX: 540.473.1254

AS-BUILT

No.	Revision	By	Appd.	Date	Drawn
1	Relocate manholes #13 & #14	SCG	WPJ	Sept. 1997	JHG
					Designed
					SCG
					Checked
					WPJ/JST
					Approved
					WPJ

**GREENFIELD COLLECTOR AND
TINKER CREEK EXTENSION**

**PLAN & PROFILES
STA 42+00 - 57+00**

HOR: 1"=50' VER: 1"=5'

DECEMBER 1996

PROJECT: 96081

5 of 27