
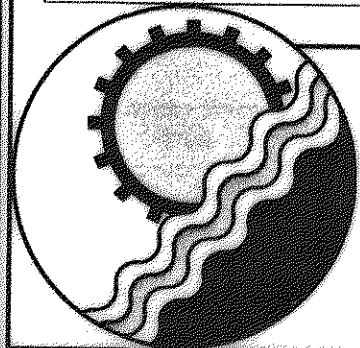
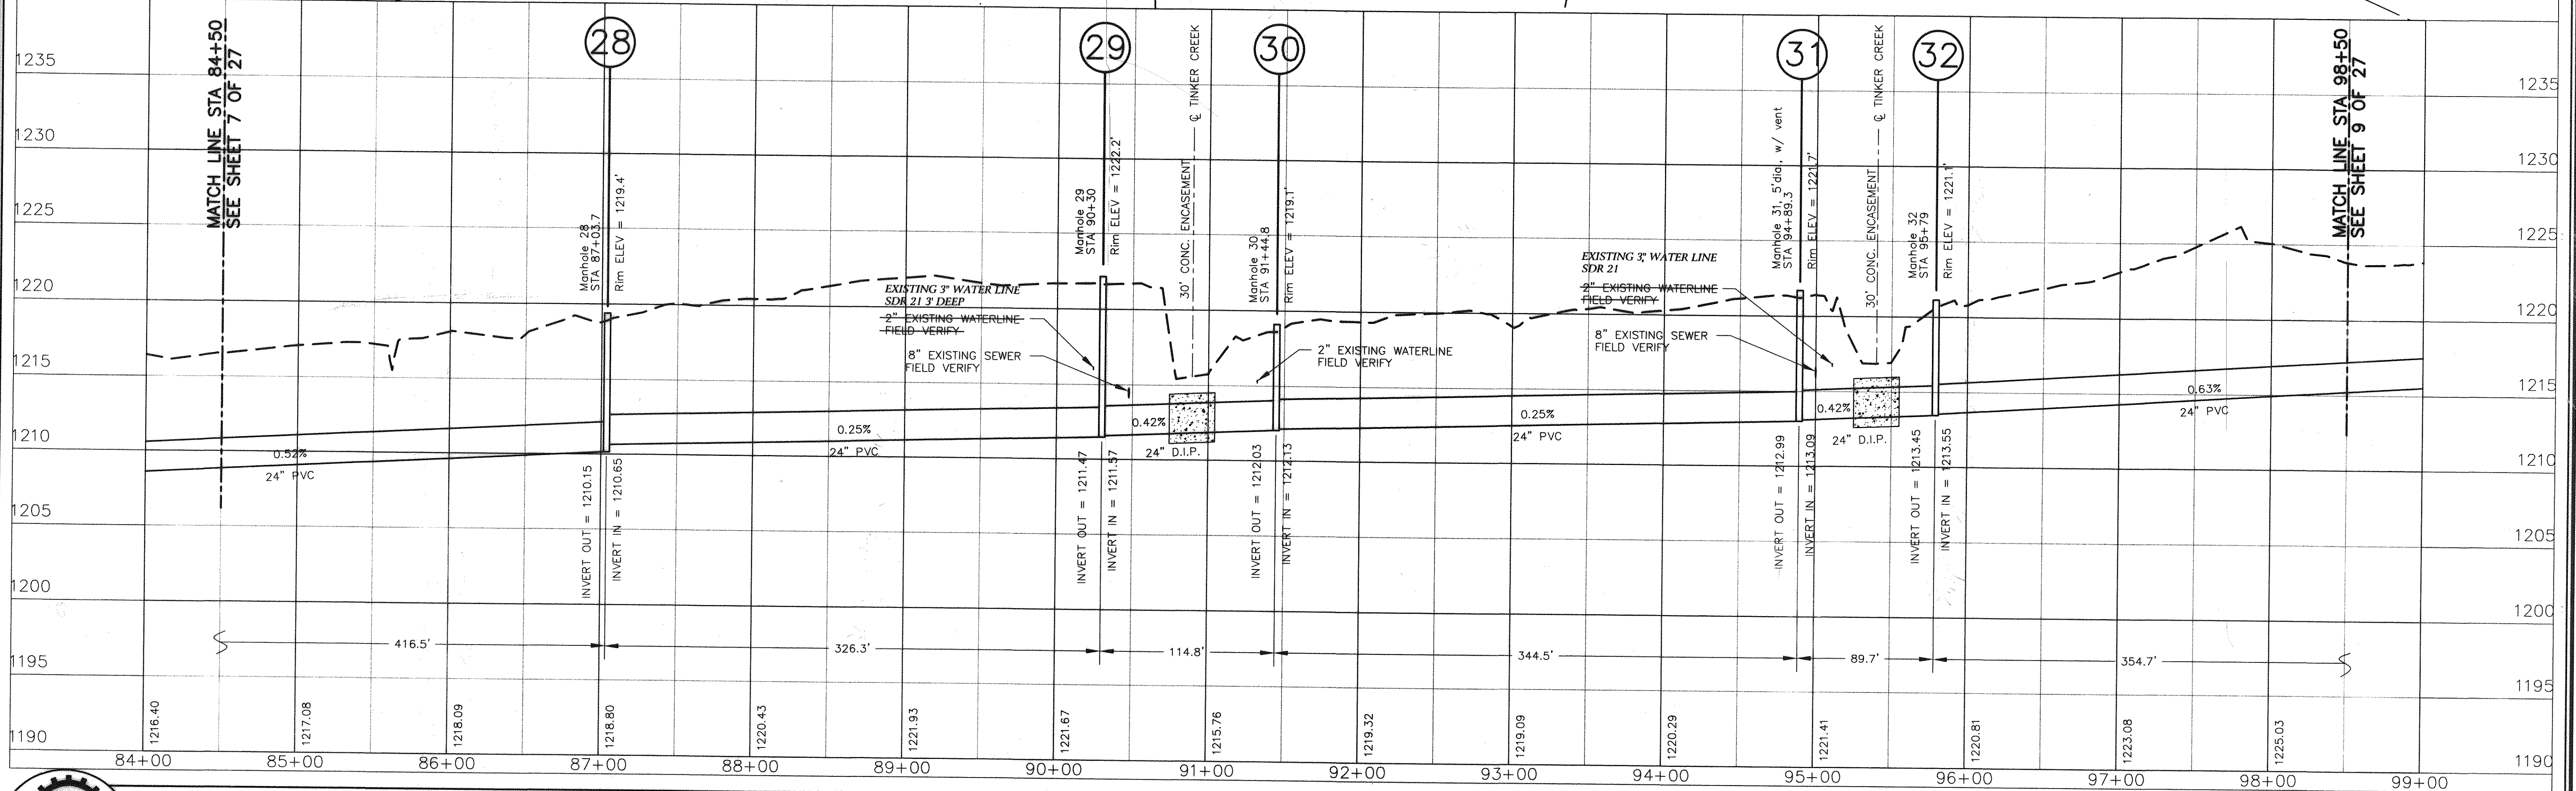


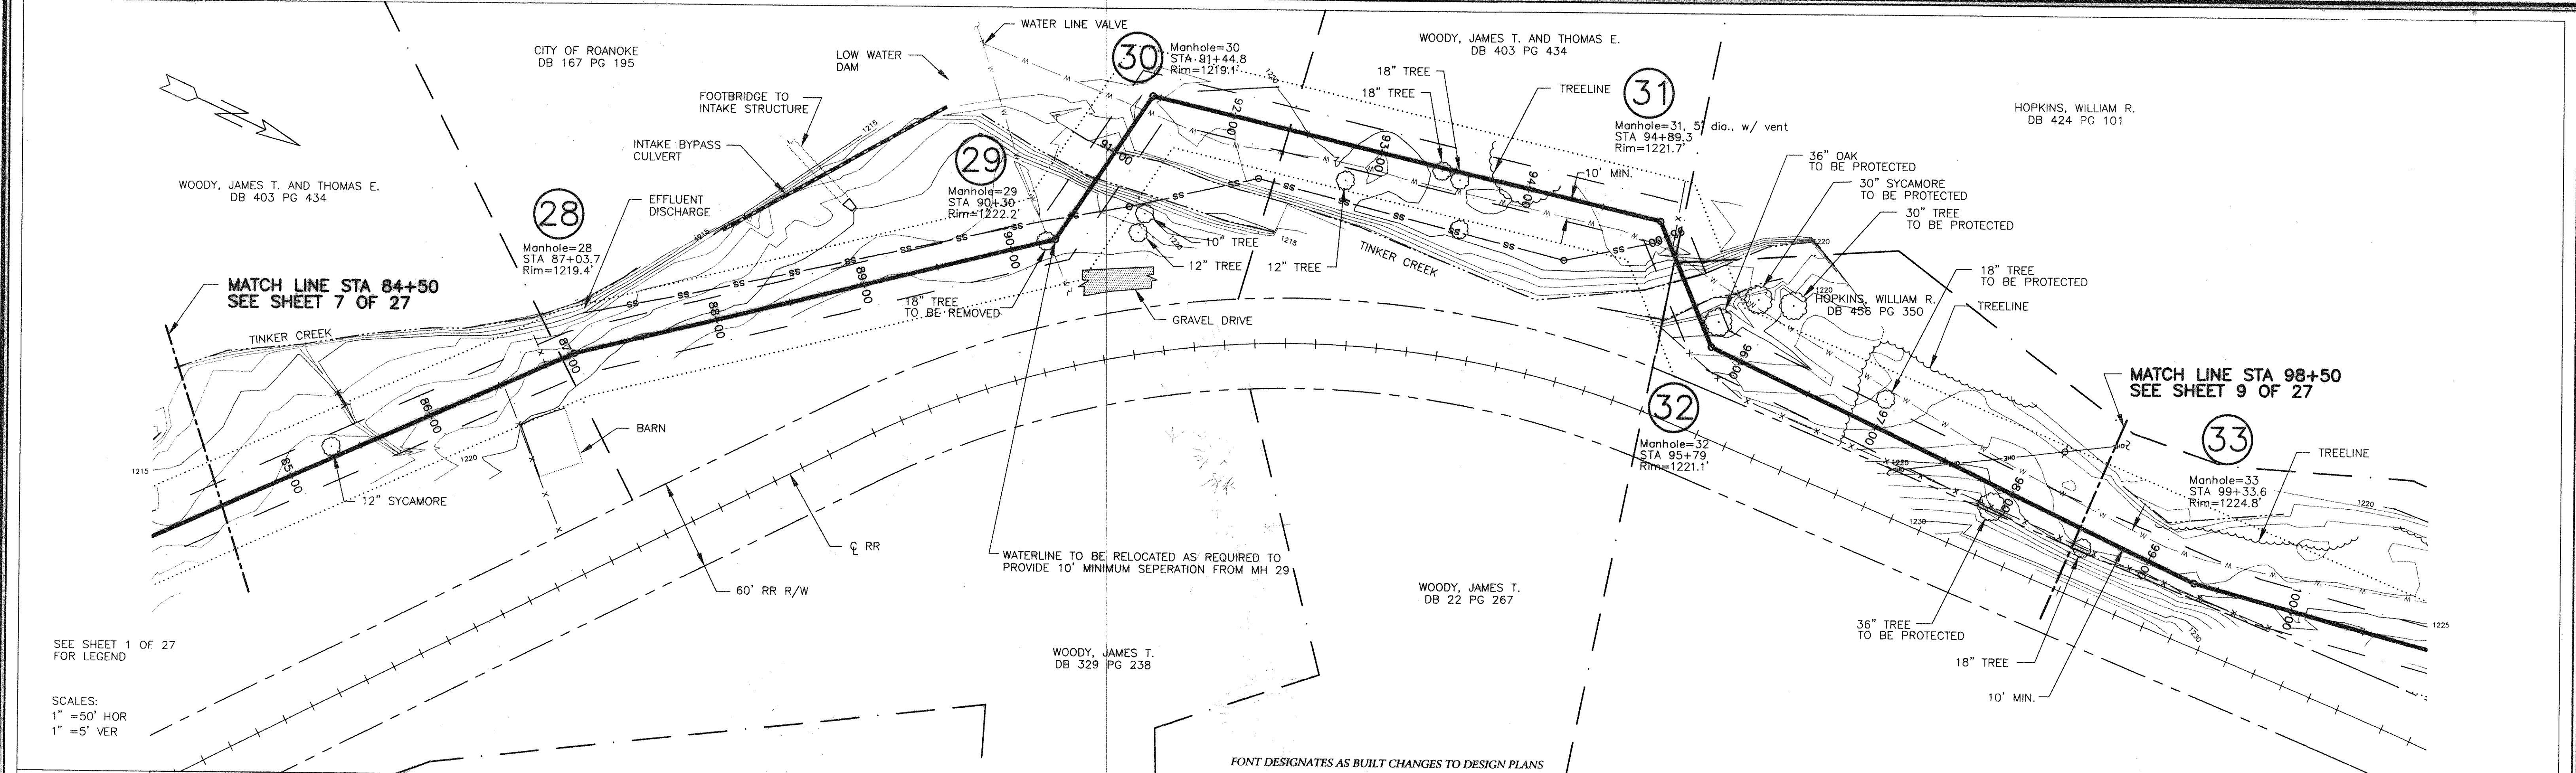

ENGINEERING CONCEPTS, INC.

20 S. ROANOKE ST., PO BOX 619
FINCASTLE, VIRGINIA 24090
540.473.1253 FAX: 540.473.1254

AS-BUILT

Drawn	PSN
Designed	SCG
Checked	WPJ/JST
Approved	WPJ

**GREENFIELD COLLECTOR AND
TINKER CREEK EXTENSION**

**PLAN & PROFILES
STA 84+00 - 99+00**

H: 1"=50' V: 1"=5'

DECEMBER 1996

PROJECT: 96081

8 of 27