

DRAWING SPACE LIMITED. LATERAL NOT DRAWN TO SCALE. SEE DISTANCES FOR CLARITY.

MATCH LINE STA 98+50
SEE SHEET 8 OF 27



SUBMAIN E
SEE SHEET 20 OF 27

MATCH LINE STA 112+50
SEE SHEET 10 OF 27

SCALES:
1" = 50' HOR
1" = 5' VER

SEE SHEET 1 OF 27
FOR LEGEND

FONT DESIGNATES AS BUILT CHANGES TO DESIGN PLANS

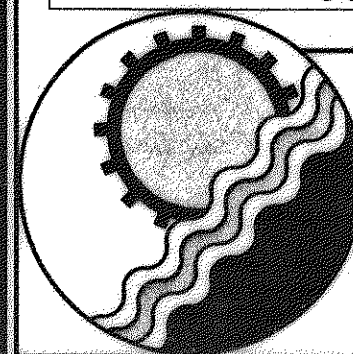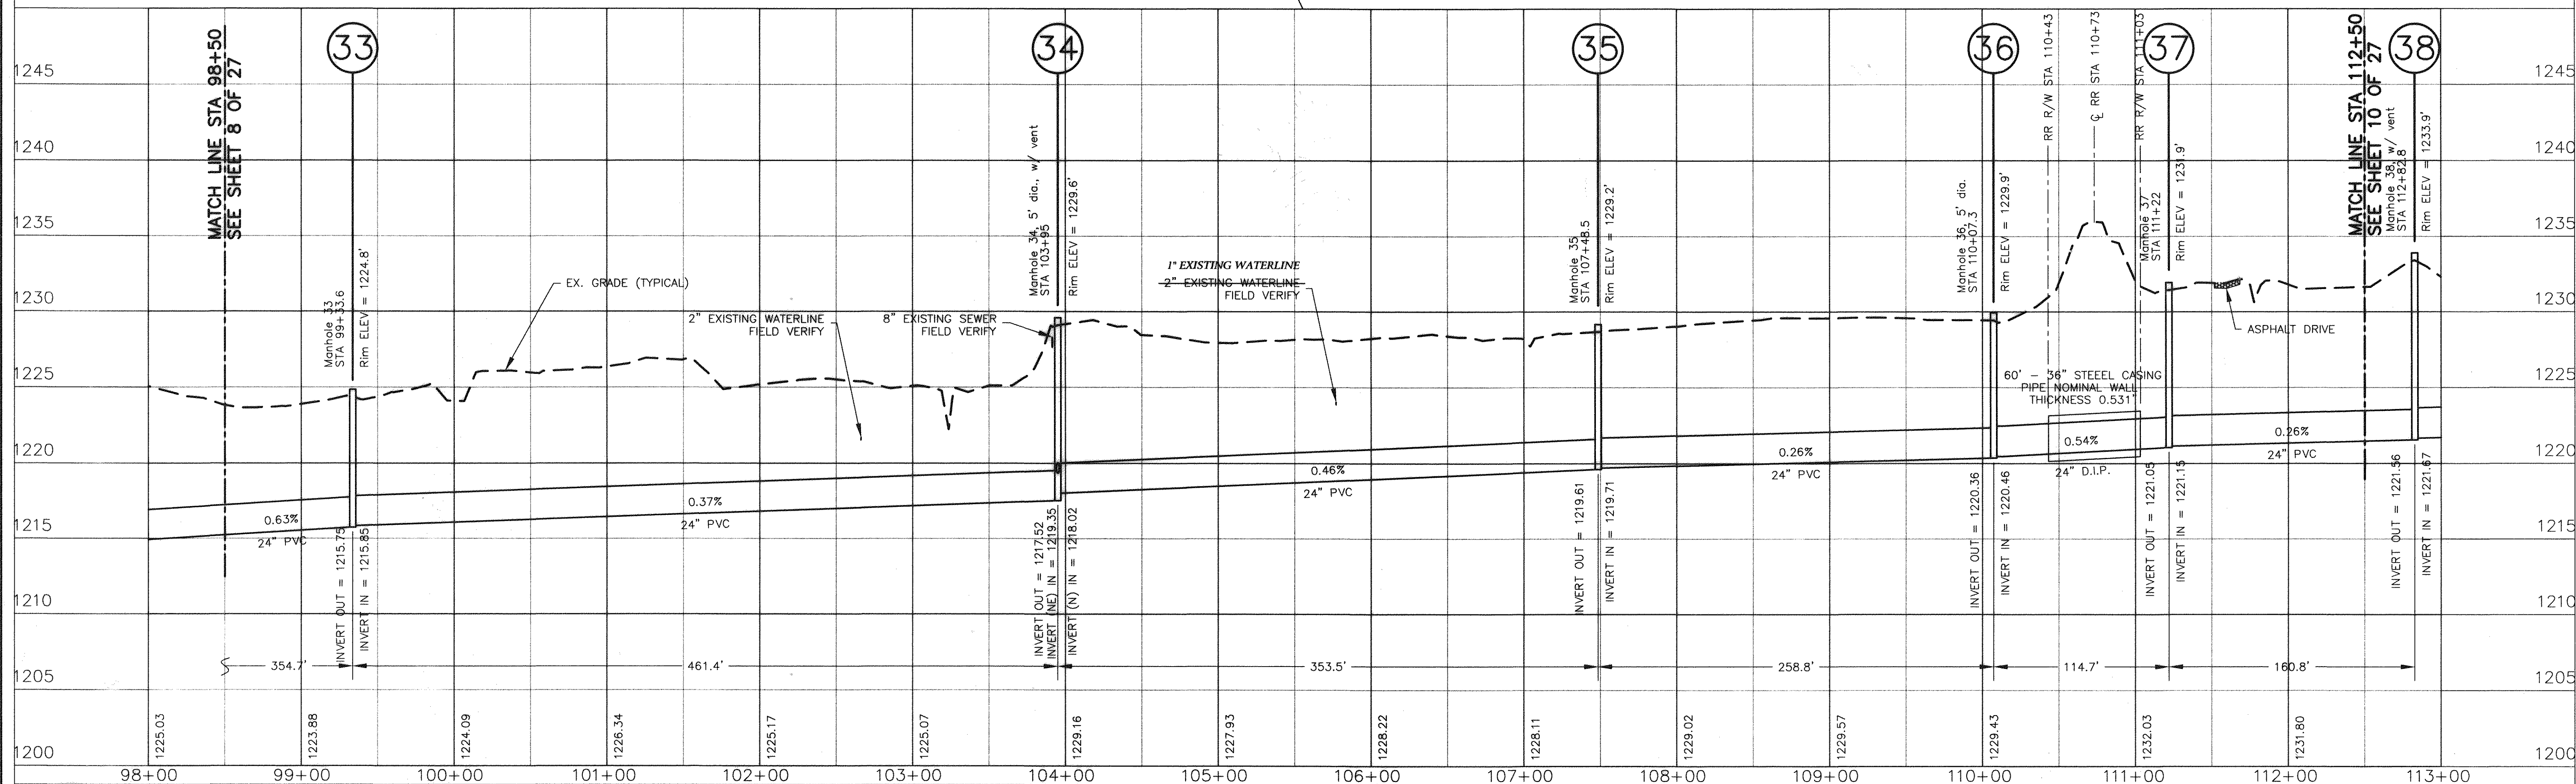

ENGINEERING CONCEPTS, INC.

20 S. ROANOKE ST., PO BOX 619
FINCASTLE, VIRGINIA 24090
540.473.1253 FAX: 540.473.1254

AS-BUILT

Drawn PSN
Designed SCG
Checked WPU/JST
Approved WPU

**GREENFIELD COLLECTOR AND
TINKER CREEK EXTENSION**

**PLAN & PROFILES
STA 98+00 - 113+00**

H: 1"=50' V: 1"=5'

DECEMBER 1996

PROJECT: 96081

9 of 27