


BOTETOURT COUNTY
DB 486 PG 594

MATCH LINE STA 140+50
SEE SHEET 11 OF 27

MATCH LINE STA 154+50
SEE SHEET 13 OF 27

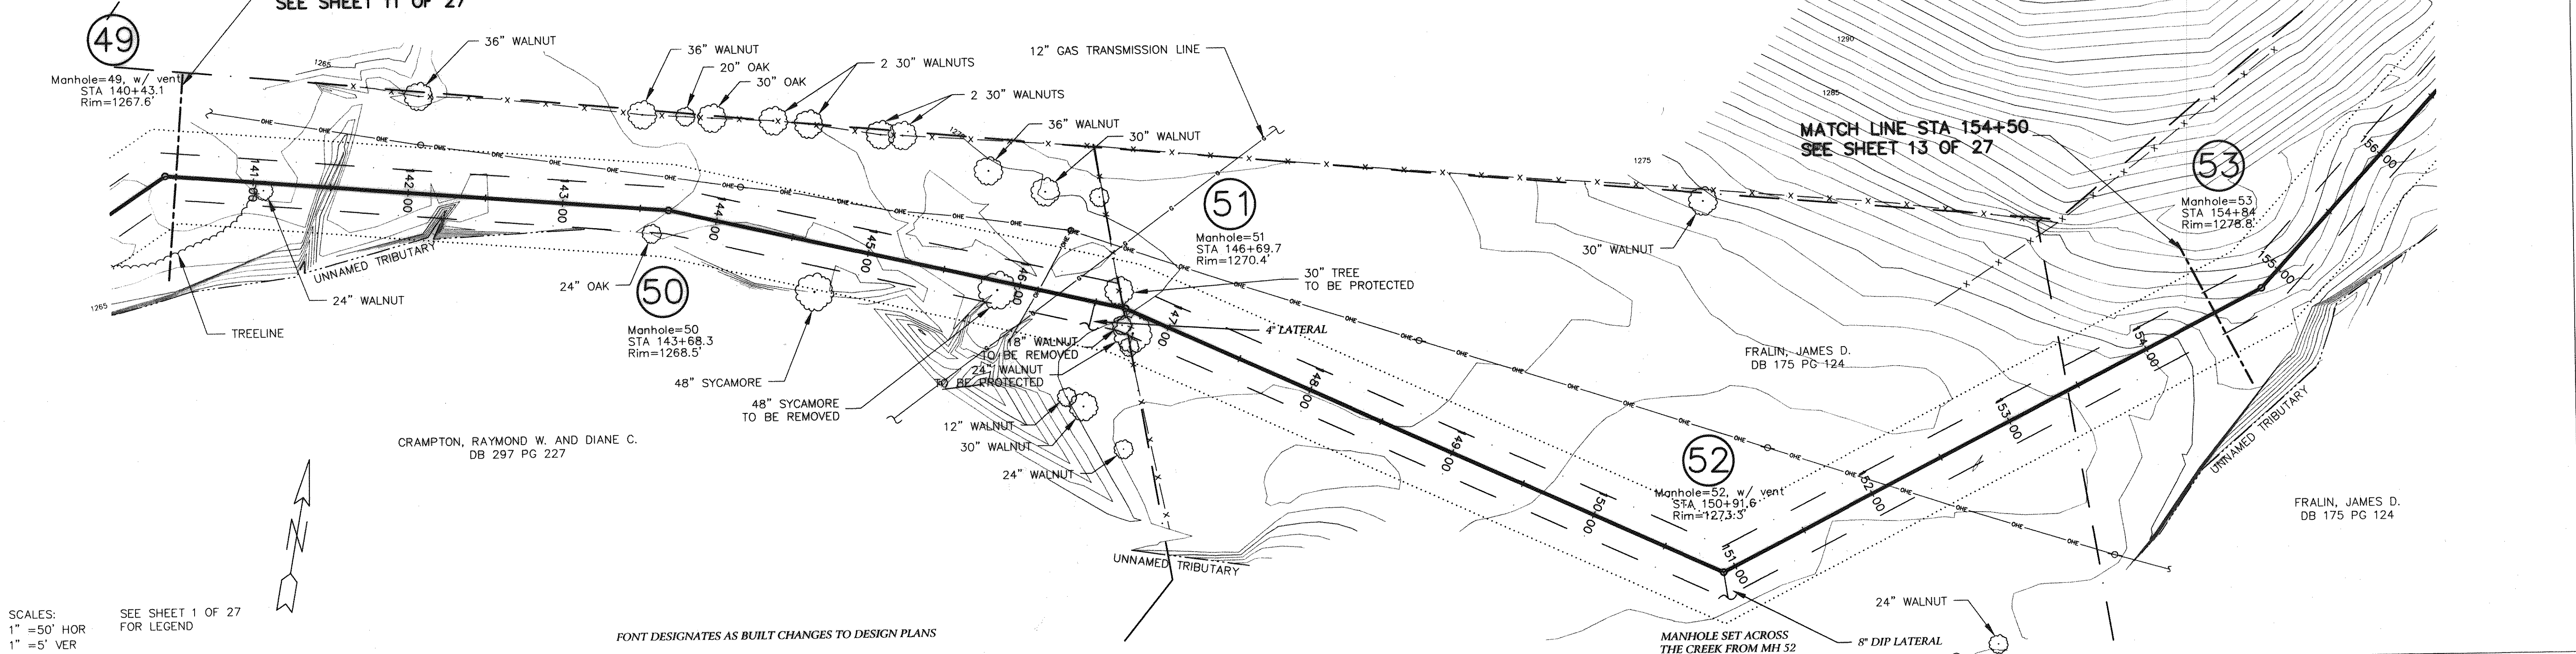

SCALES:
1\"/>

FONT DESIGNATES AS BUILT CHANGES TO DESIGN PLANS

