



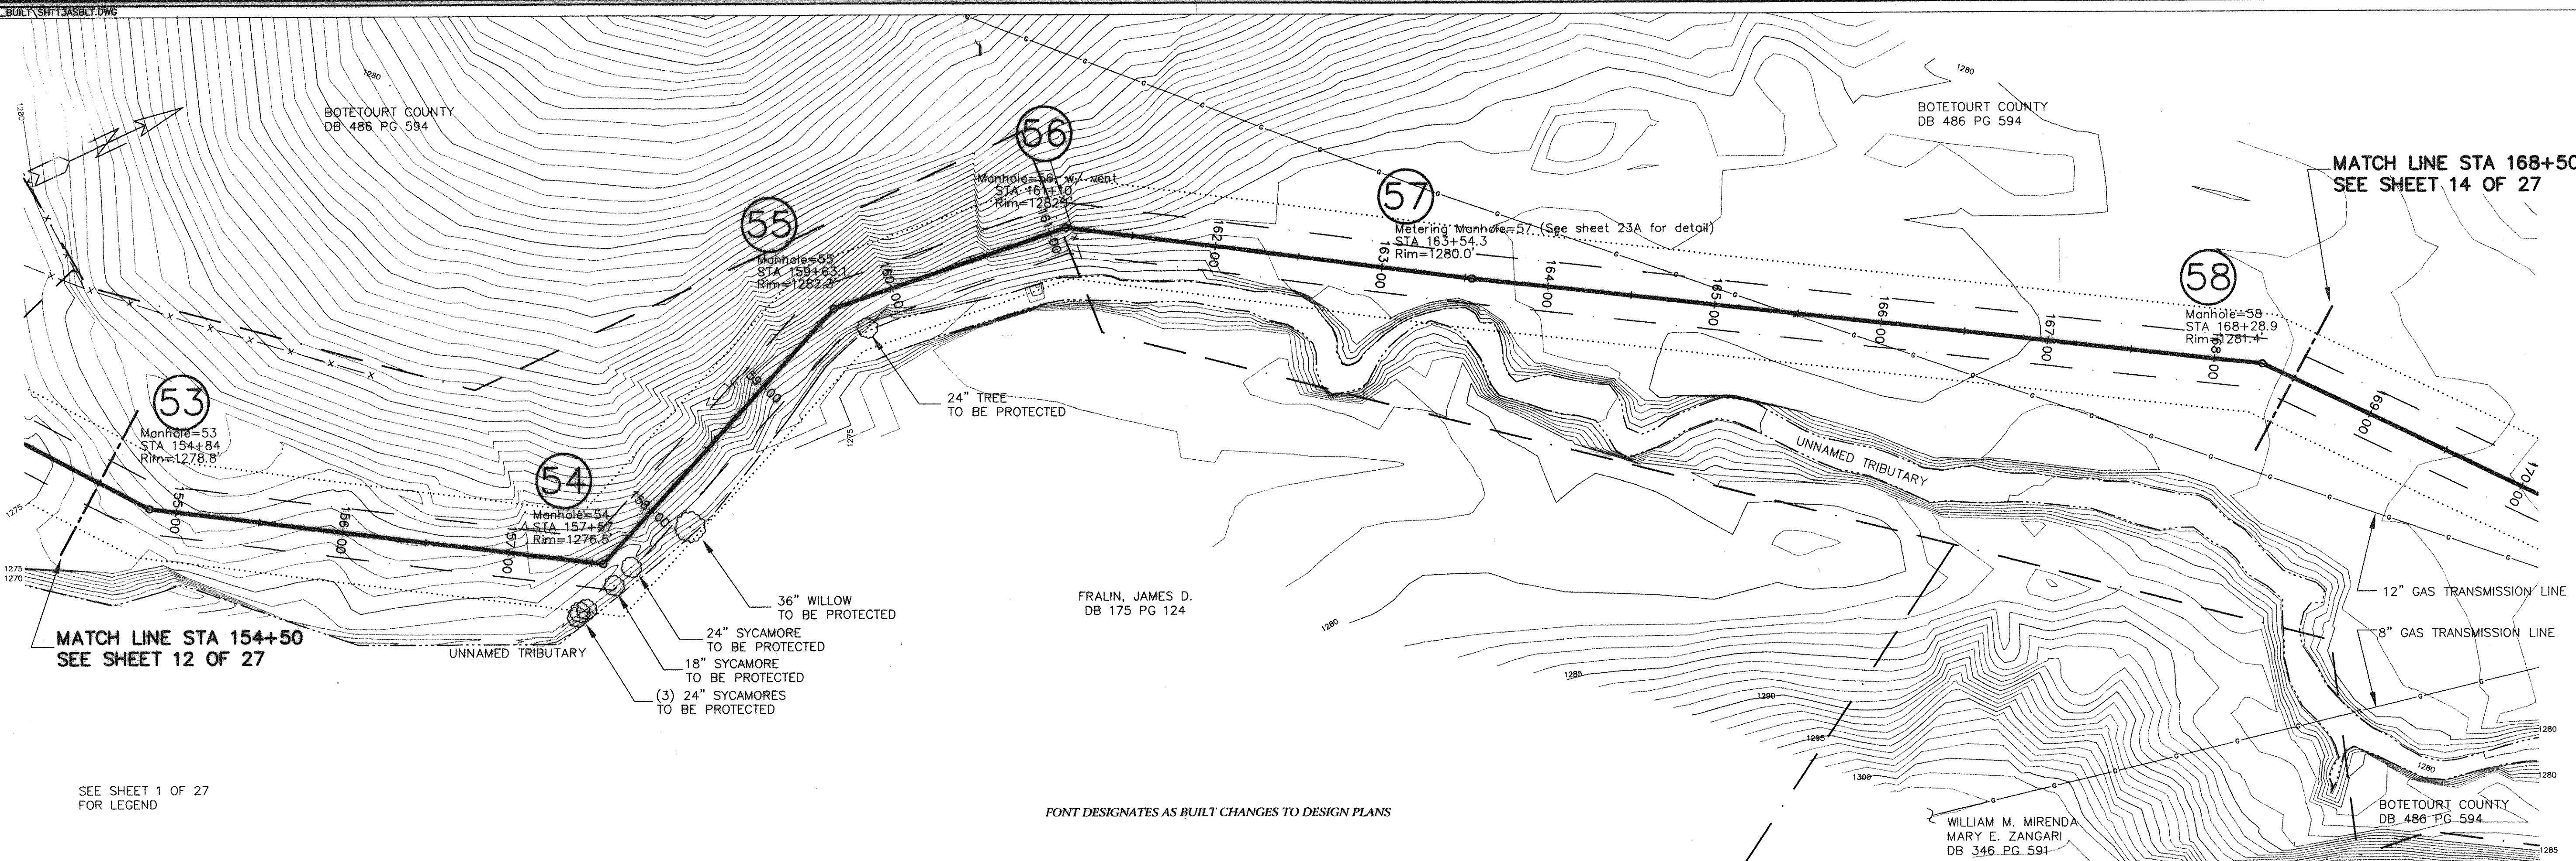


SCALES:
1" = 50' HOR
1" = 5' VER

SEE SHEET 1 OF 27
FOR LEGEND

FONT DESIGNATES AS BUILT CHANGES TO DESIGN PLANS

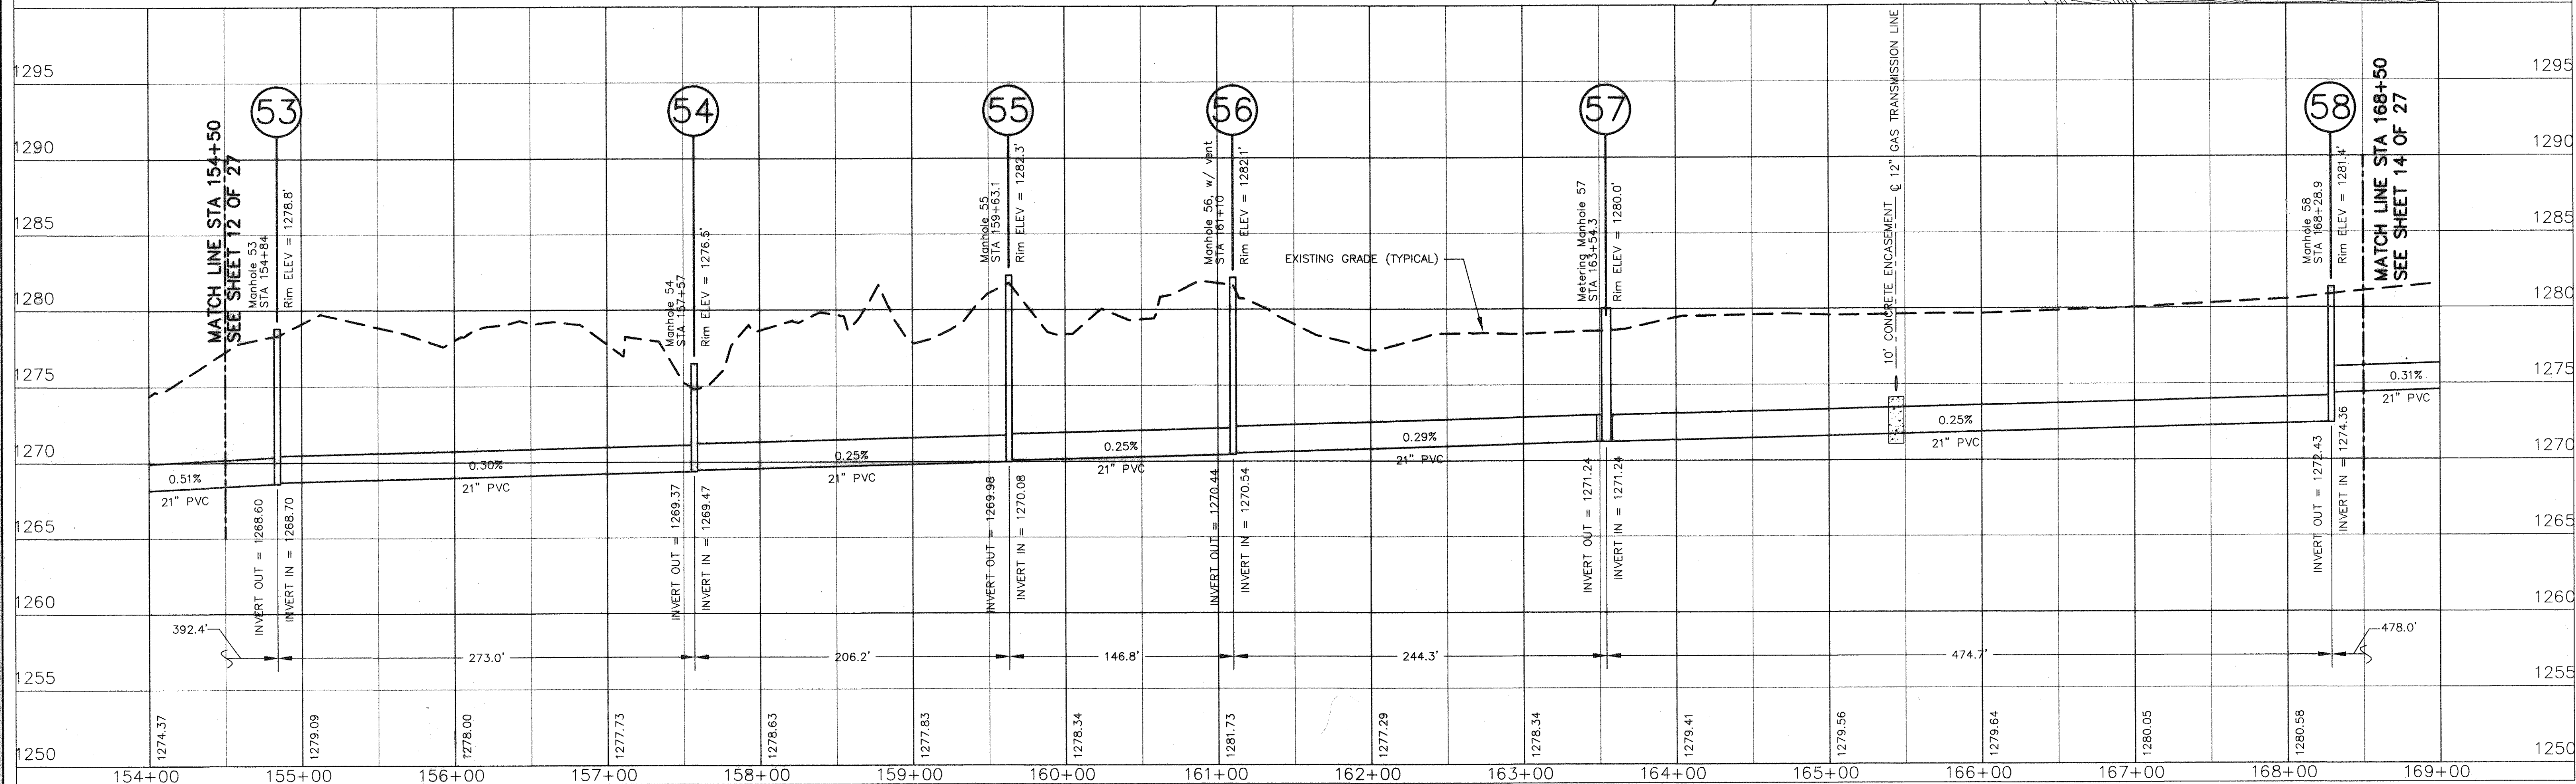

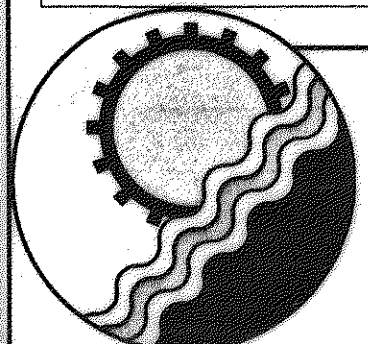

ENGINEERING CONCEPTS, INC.
20 S. ROANOKE ST., PO BOX 619
FINCASTLE, VIRGINIA 24090
540.473.1253 FAX: 540.473.1254

AS-BUILT

No.	Revision	By	Appd.	Date	Drawn
1	Metering manhole #57	SCG	WPJ	1/28/97	SCG

**GREENFIELD COLLECTOR AND
TINKER CREEK EXTENSION**

PLAN & PROFILES

STA 154+00 - 169+00

H:1"=50' V:1"=5'

DECEMBER 1996

PROJECT: 96081

13 of 27