



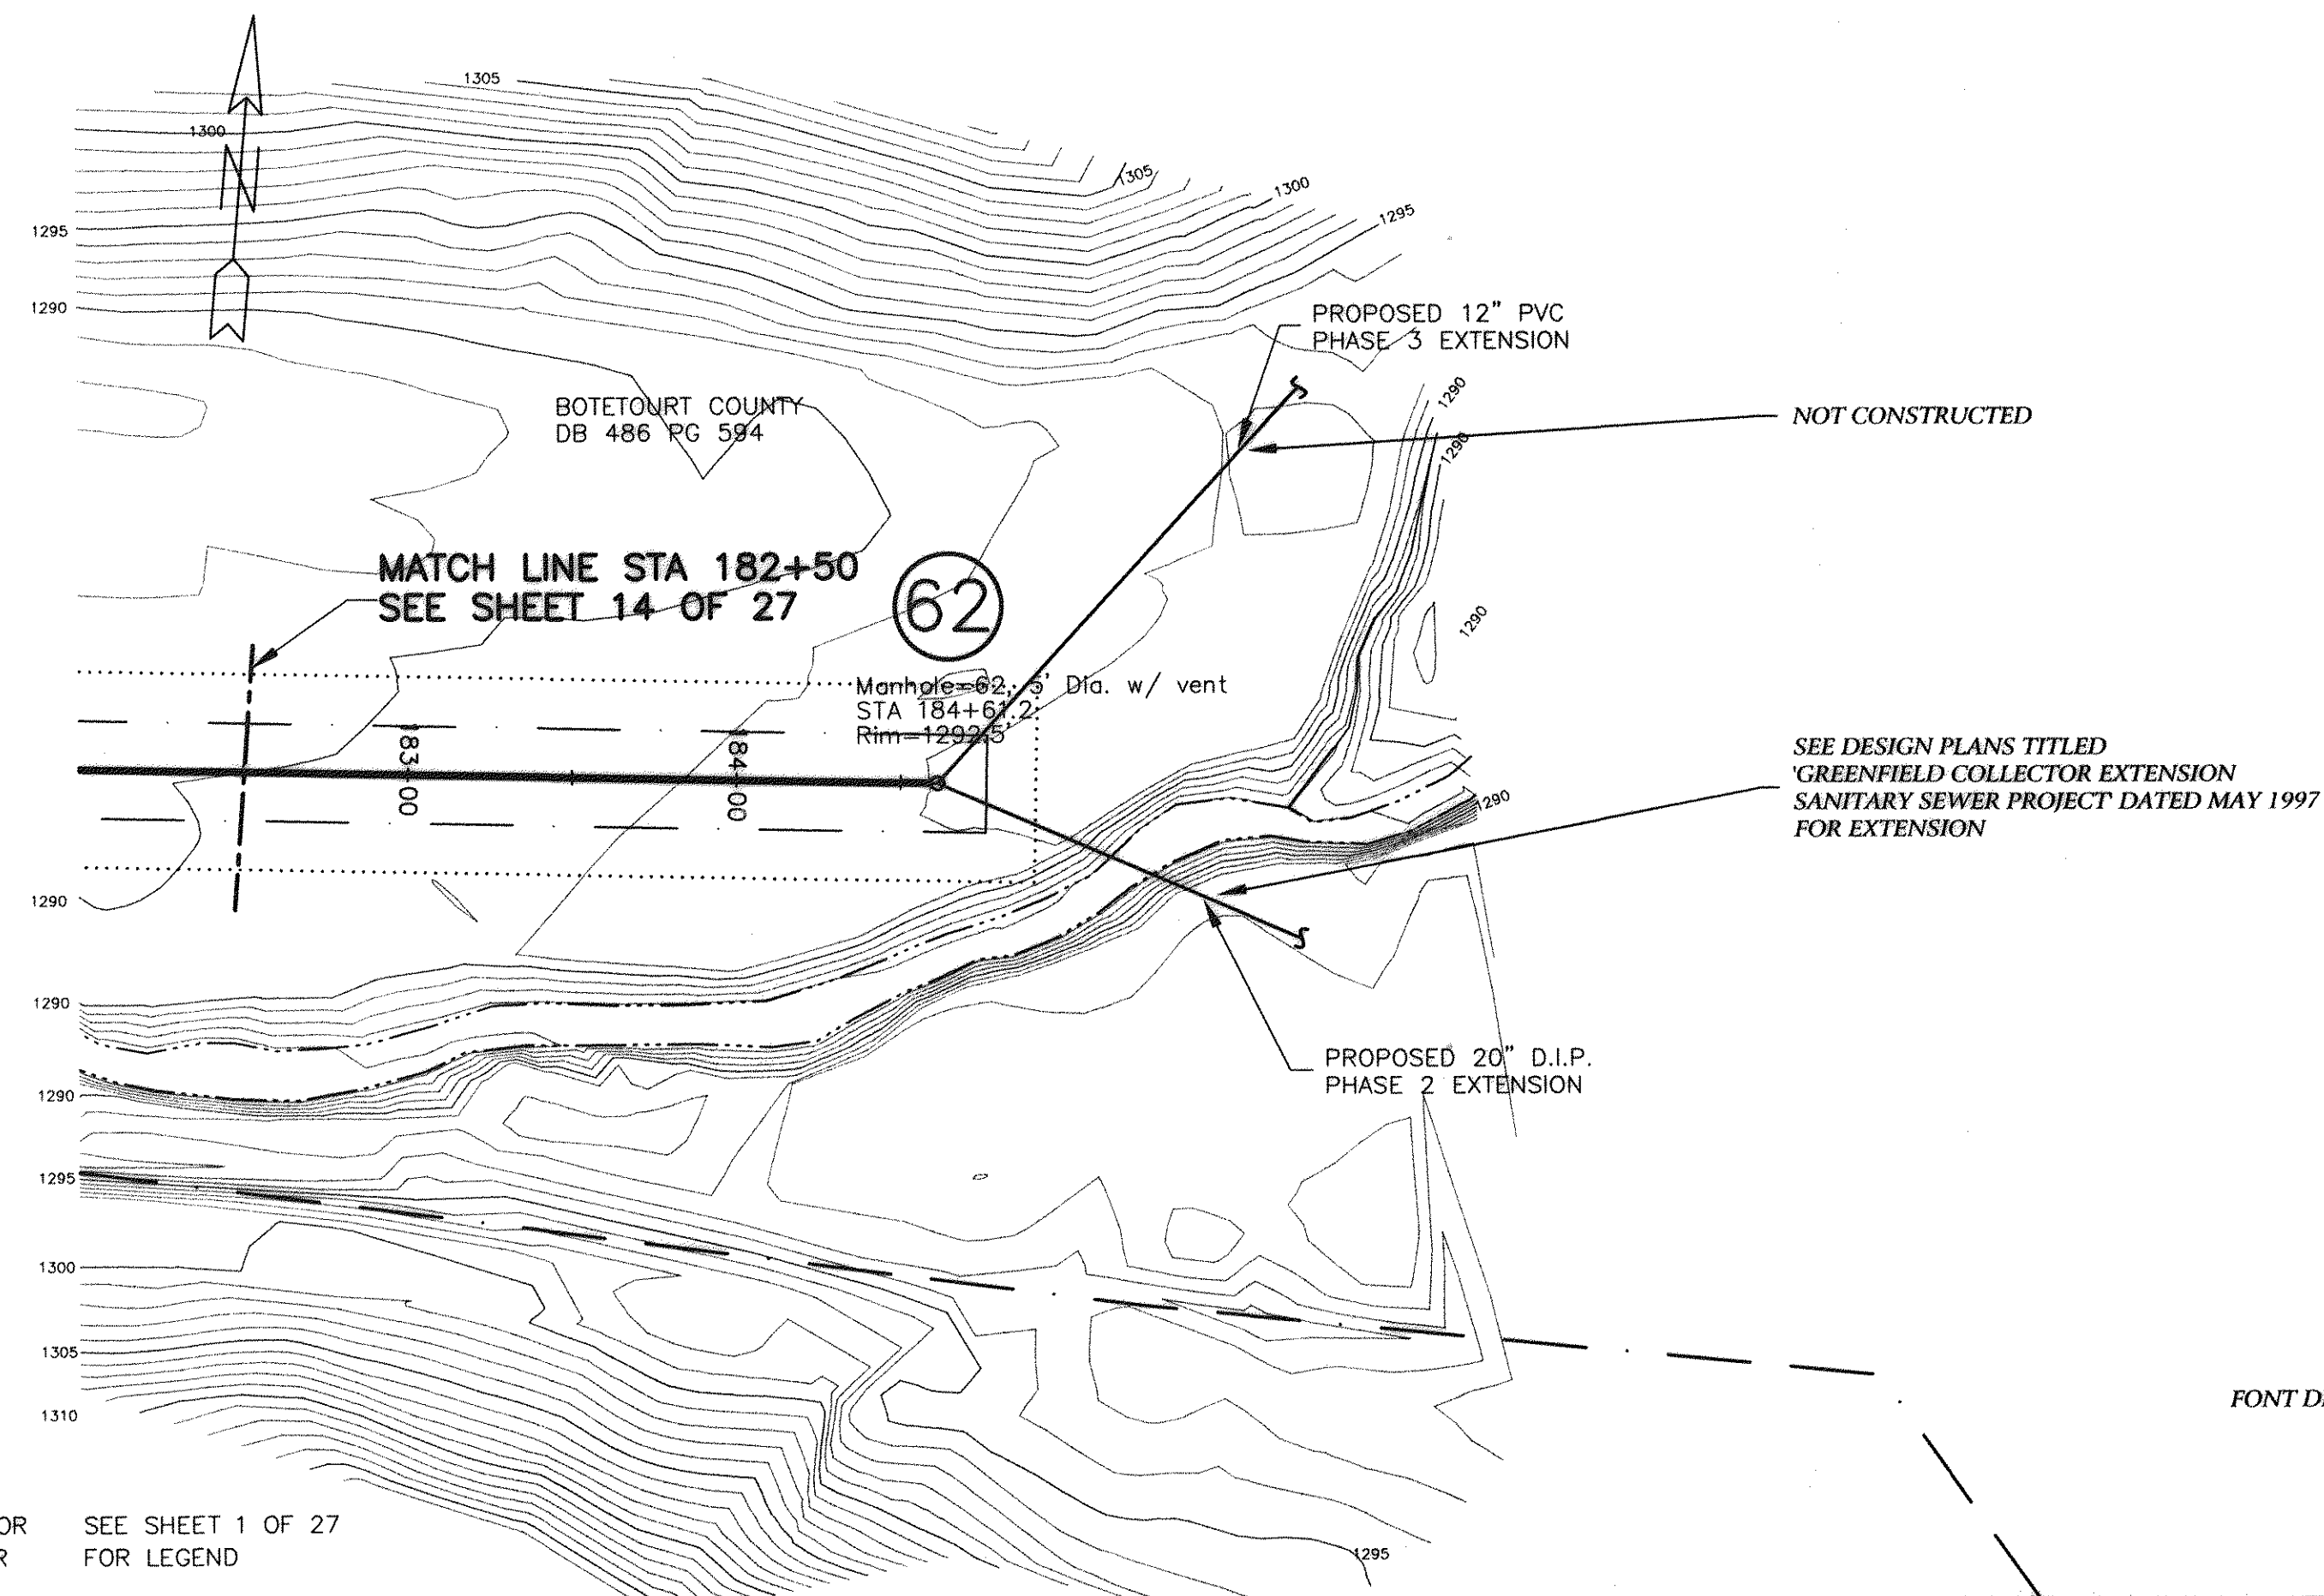


SCALES:
1" = 50' HOR
1" = 5' VER

SEE SHEET 1 OF 27
FOR LEGEND

FONT DESIGNATES AS BUILT CHANGES TO DESIGN PLANS

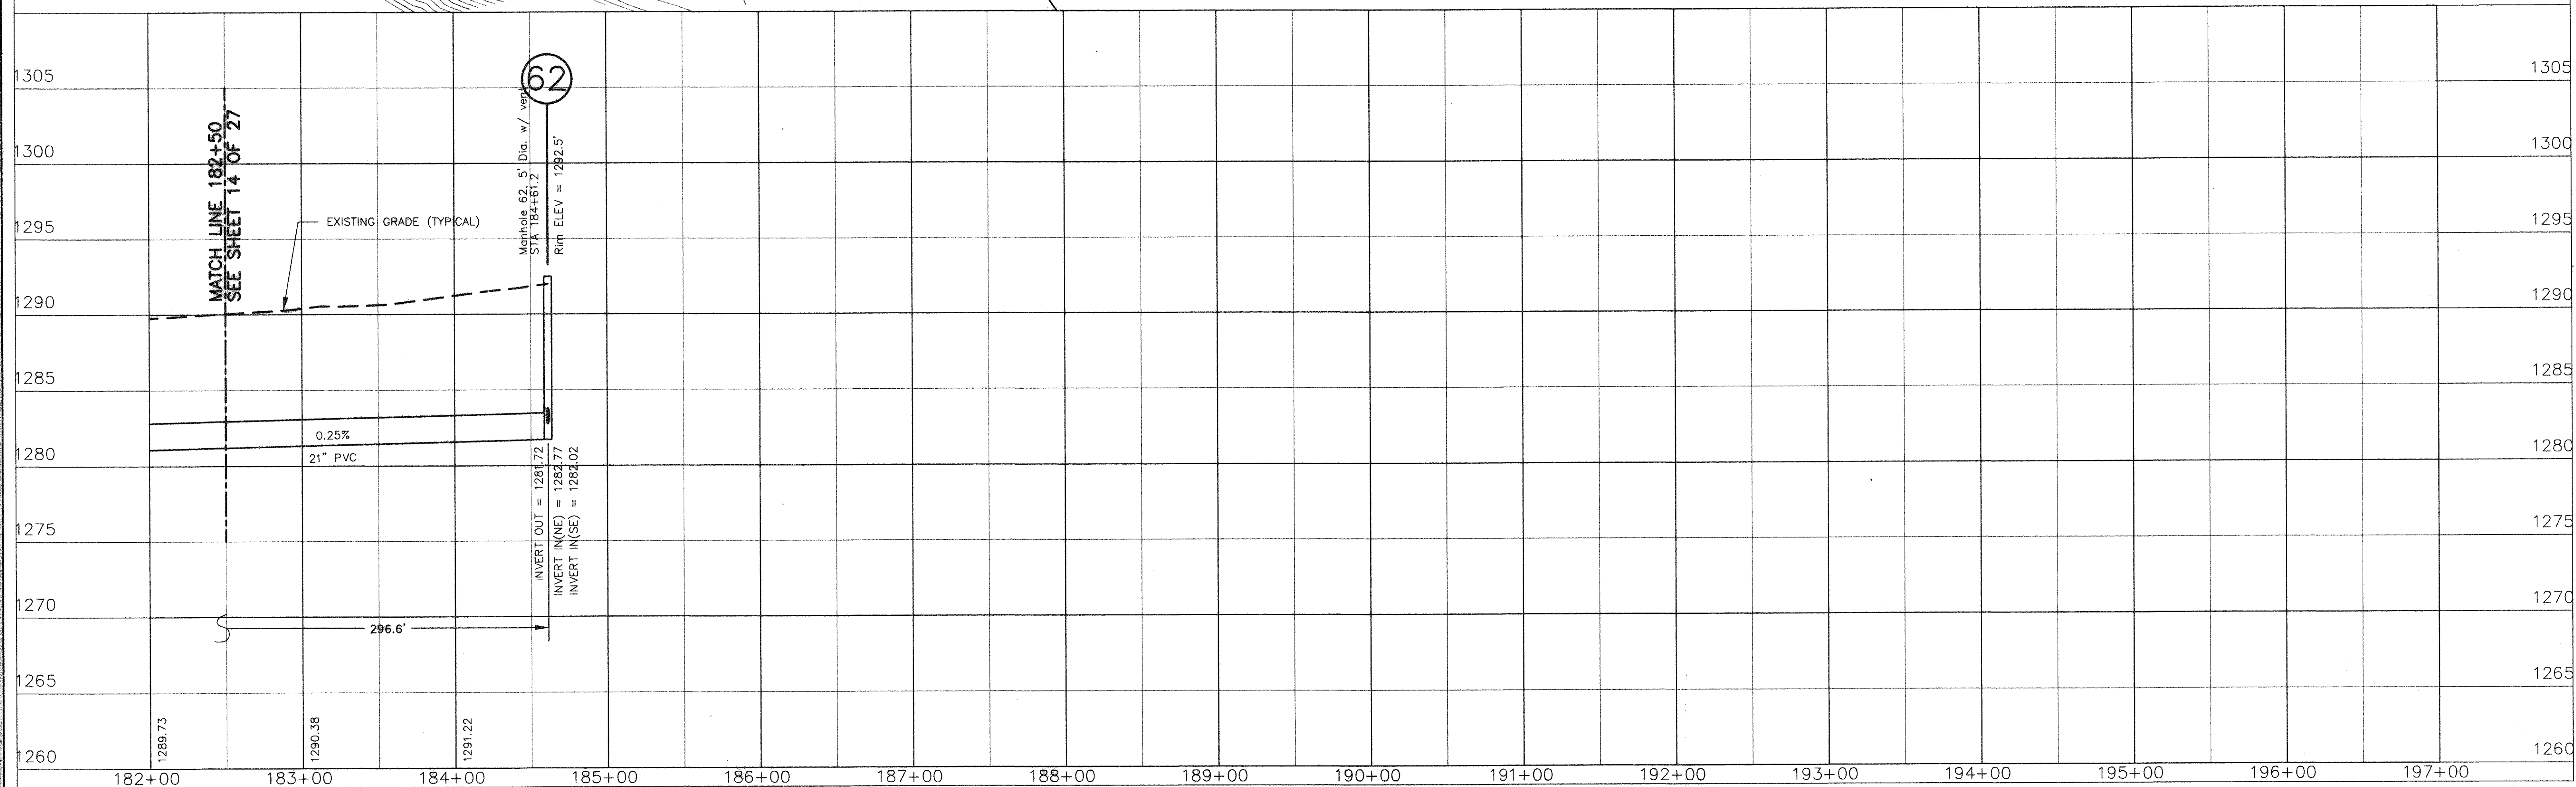

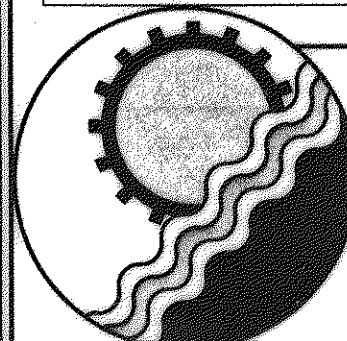

ENGINEERING CONCEPTS, INC.
20 S. ROANOKE ST., PO BOX 619
FINCASLE, VIRGINIA 24090
540.473.1253 FAX: 540.473.1254

AS-BUILT

No.	Revision	By	Appd.	Date	Drawn	PSN
1	Lower 5' Dia.MH 62- Prop. Ext	SCG	WPJ	May 1997	Designed	SCG
					Checked	WPJ/JST
					Approved	WPJ

**GREENFIELD COLLECTOR AND
TINKER CREEK EXTENSION**

PLAN & PROFILES

STA 182+00 - 184+61

H:1"=50' V:1"=5'

DECEMBER 1996

PROJECT: 96081

15 of 27