

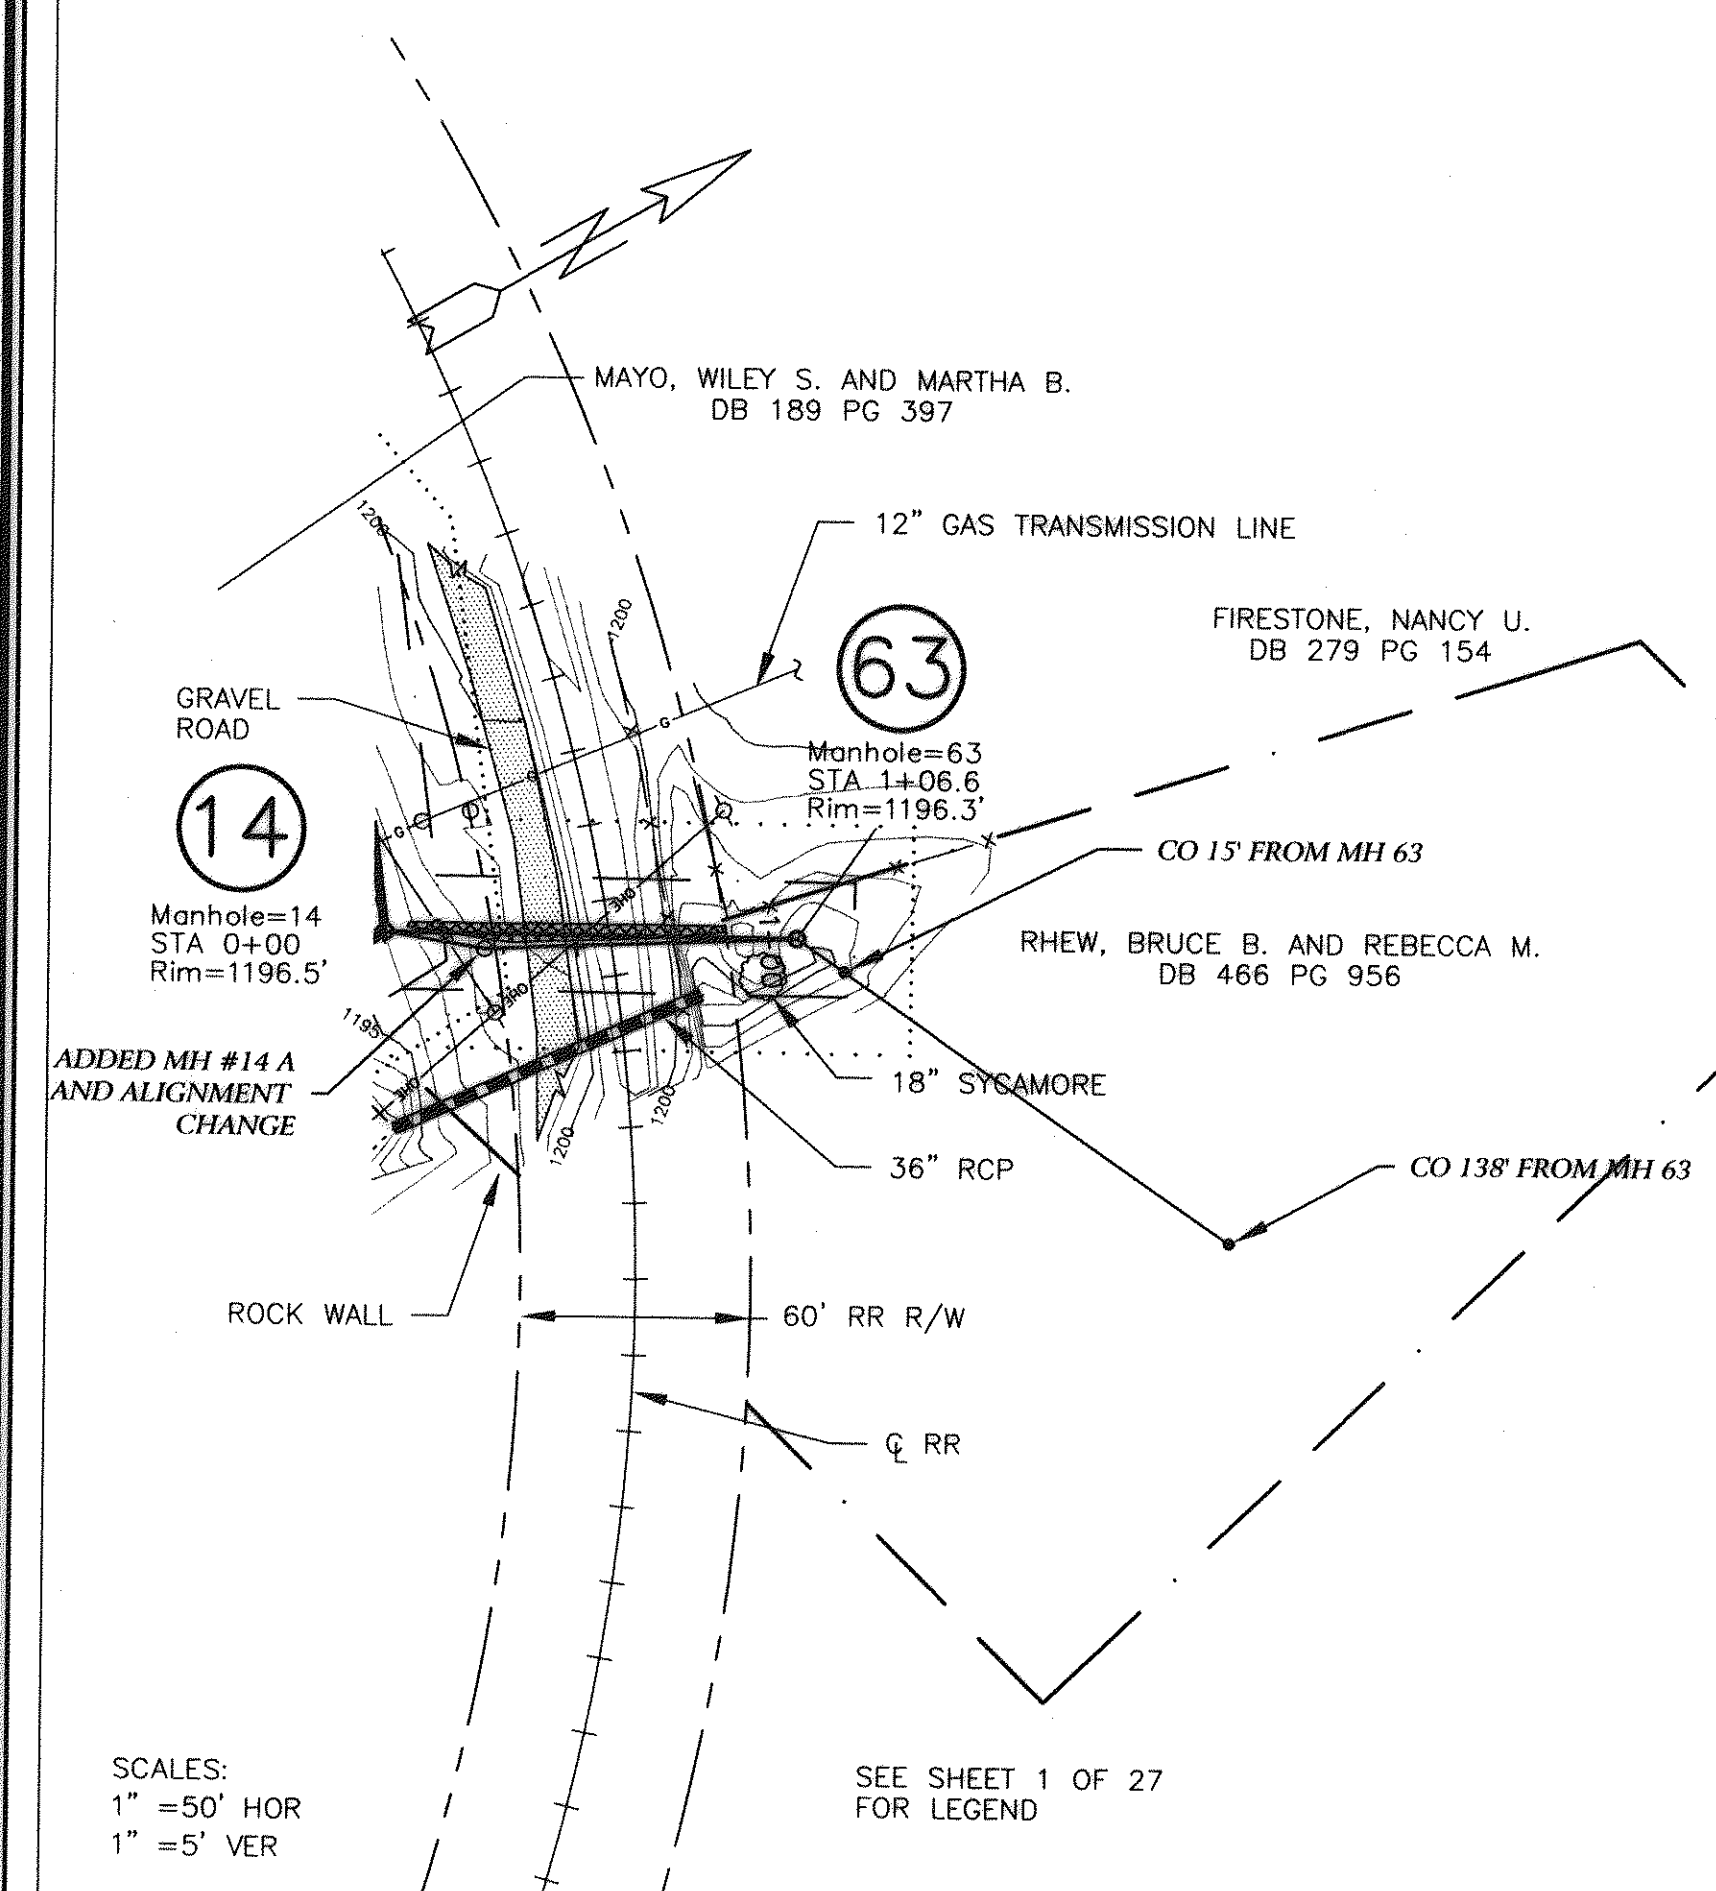


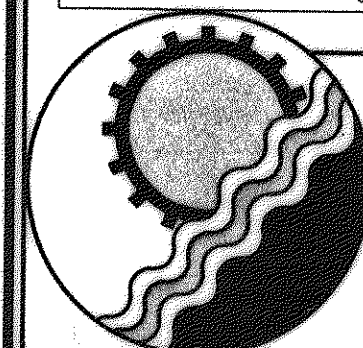

SCALES:
1" = 50' HOR
1" = 5' VER

SEE SHEET 1 OF 27
FOR LEGEND

FONT DESIGNATES AS BUILT CHANGES TO DESIGN PLANS

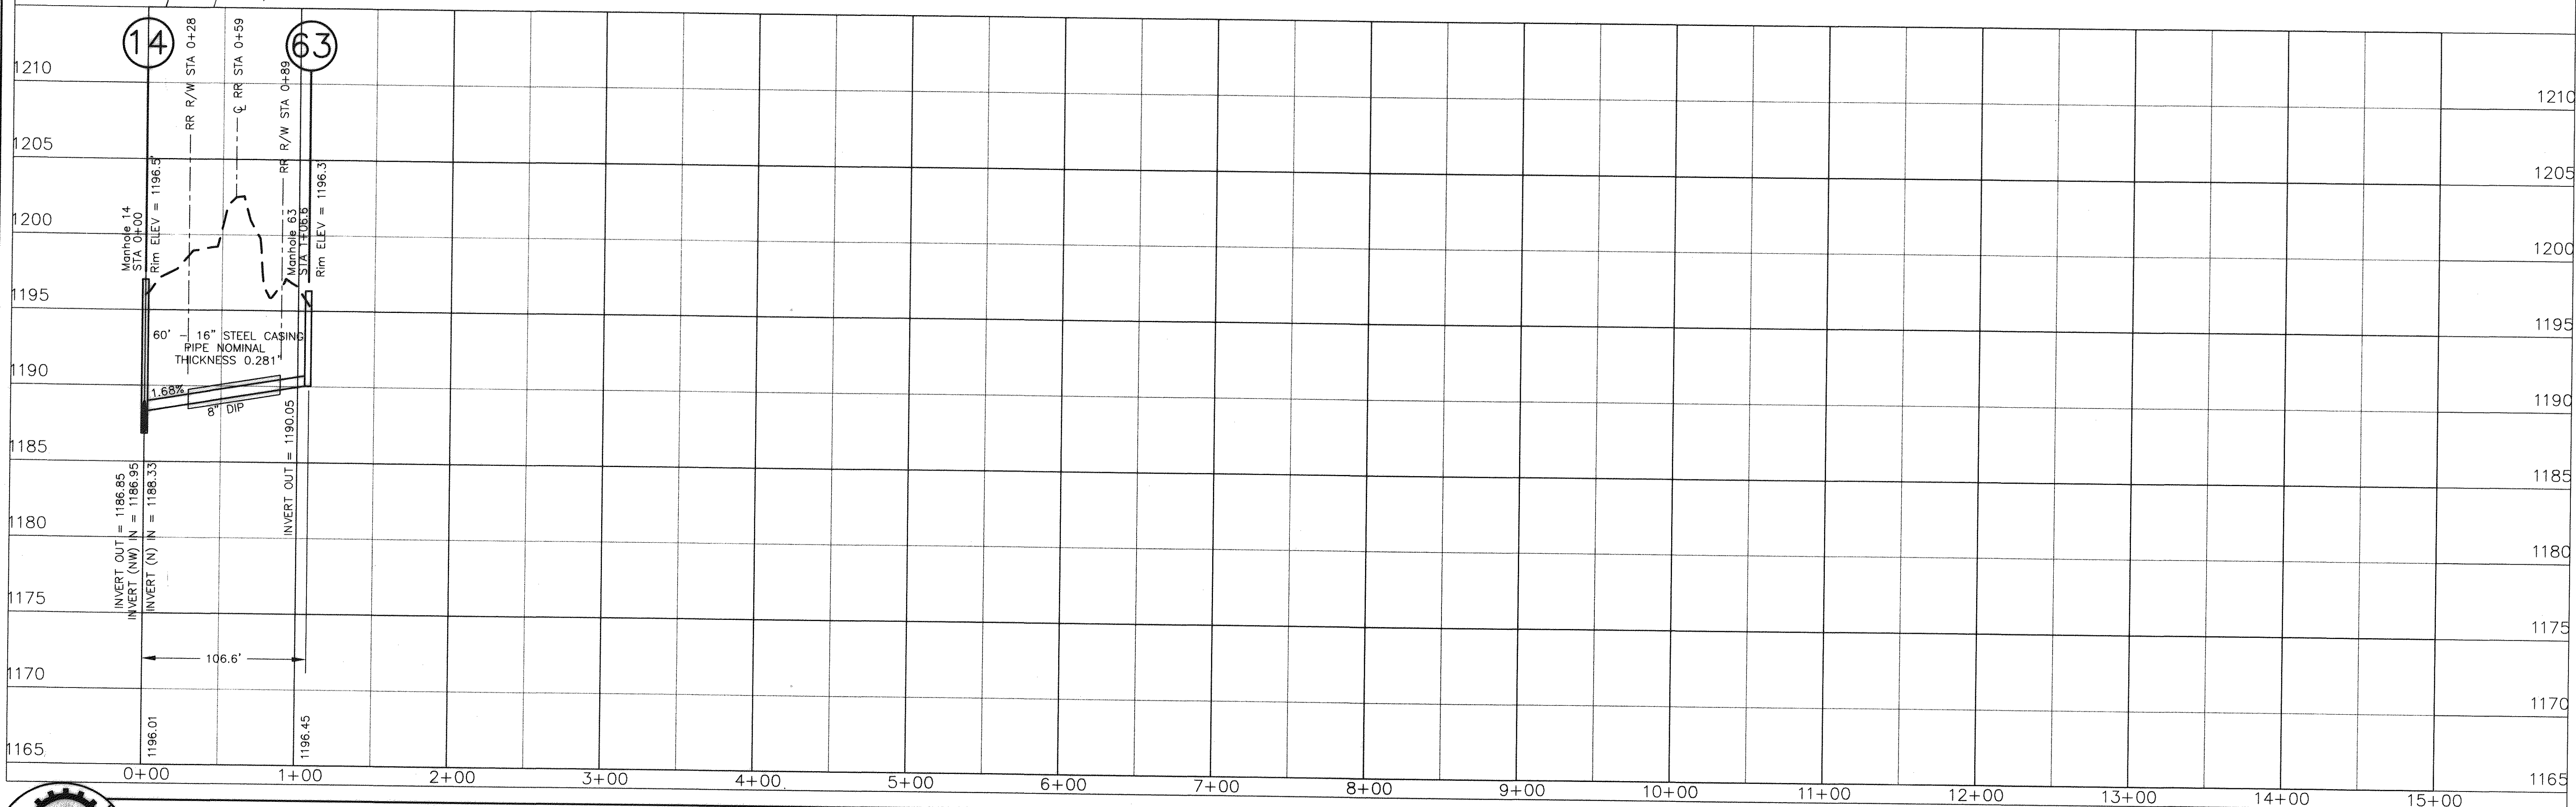

ENGINEERING CONCEPTS, INC.
20 S. ROANOKE ST., PO BOX 619
FINCASTLE, VIRGINIA 24090
540.473.1253 FAX: 540.473.1254

AS-BUILT

No.	Revision	By	Appd.	Date	Drawn	PSN
1	Relocated MH 14	SCG	WPJ	SEPT. 1997	Designed	SCG
					Checked	WPJ/JST
					Approved	WPJ

**GREENFIELD COLLECTOR AND
TINKER CREEK EXTENSION**

**PLAN & PROFILES
SUBMAIN "A" STA 0+00 - 1+07**

HOR: 1"=50' VER: 1"=5'
DECEMBER 1996
PROJECT: 96081
16 of 27