
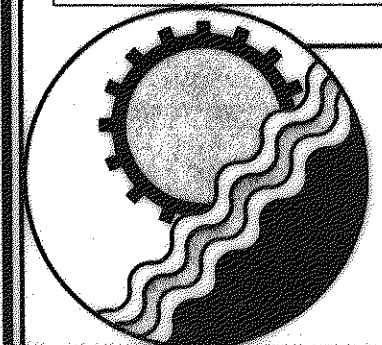
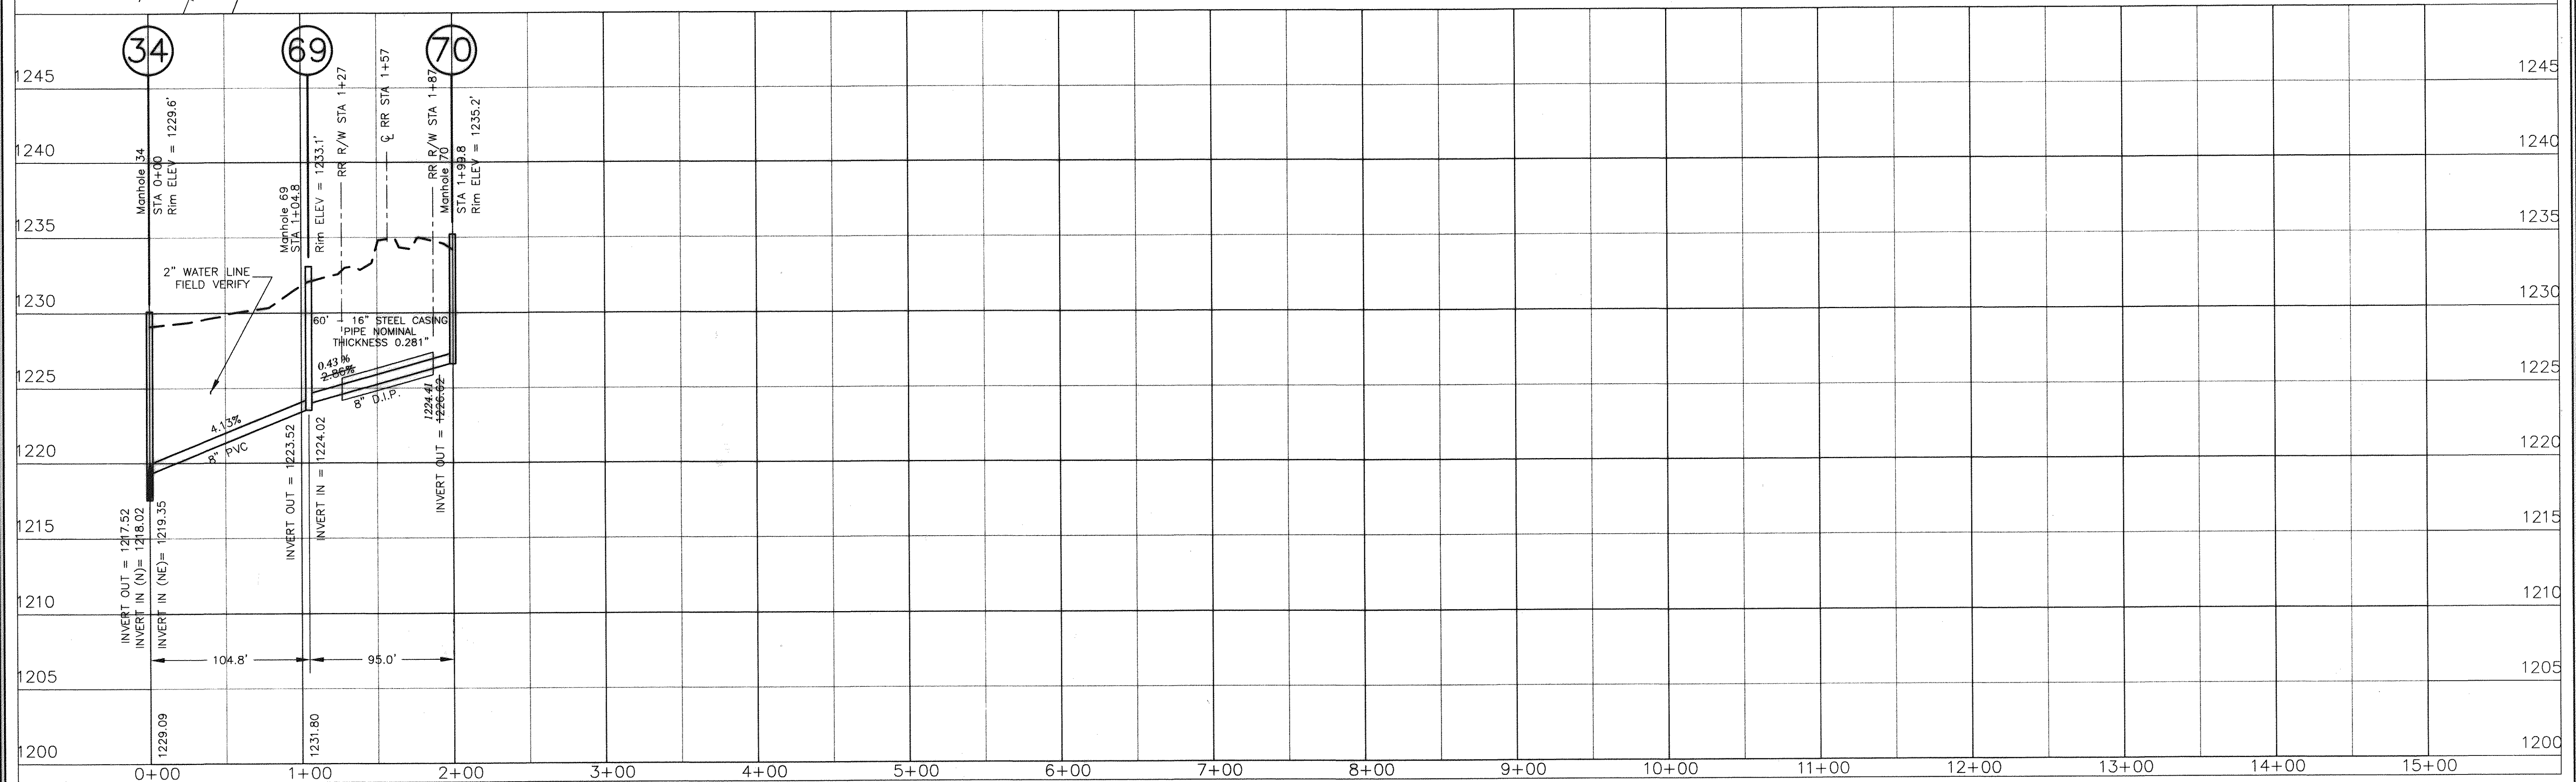


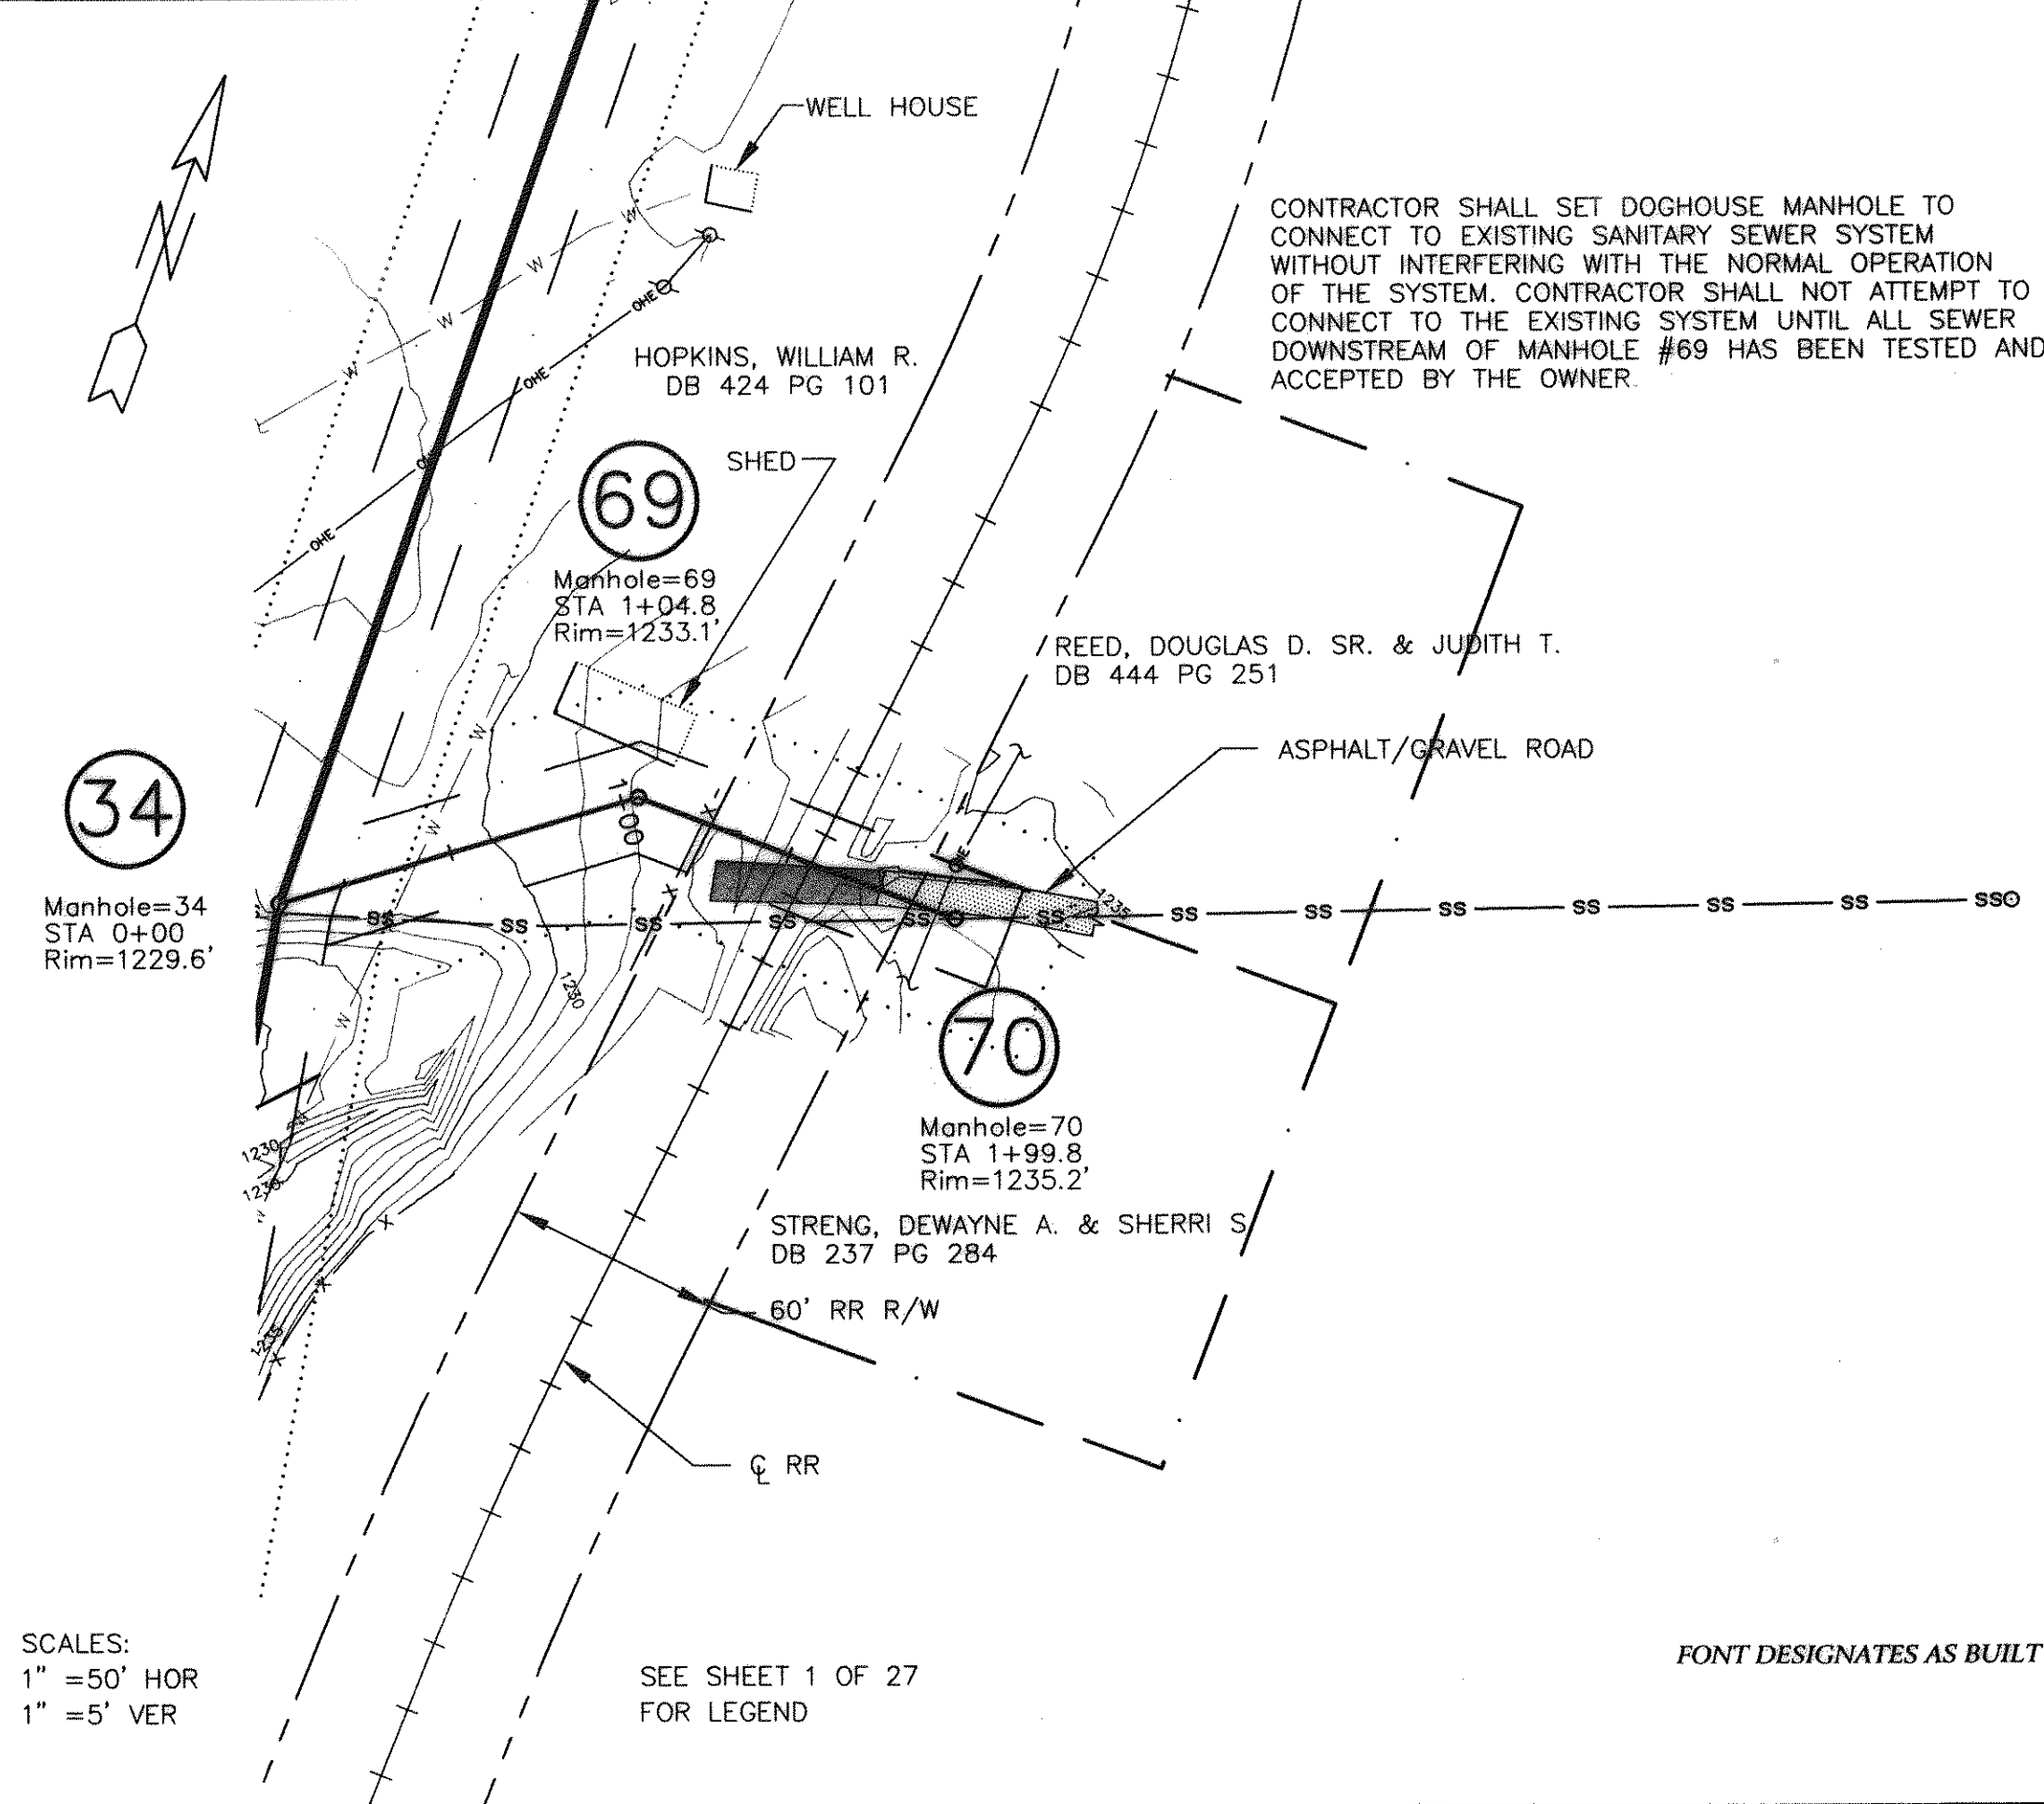

ENGINEERING CONCEPTS, INC.
20 S. ROANOKE ST., PO BOX 619
FINCASTLE, VIRGINIA 24090
540.473.1253 FAX: 540.473.1254

AS-BUILT

Drawn PSN
Designed SCG
Checked WPJ/JST
Approved WPJ

**GREENFIELD COLLECTOR AND
TINKER CREEK EXTENSION**
PLAN & PROFILES
SUBMAIN "E" STA 0+00 - 2+00

HOR: 1"=50' VER: 1"=5'
DECEMBER 1996
PROJECT: 96081
20 of 27