



MANHOLE STEP DETAIL

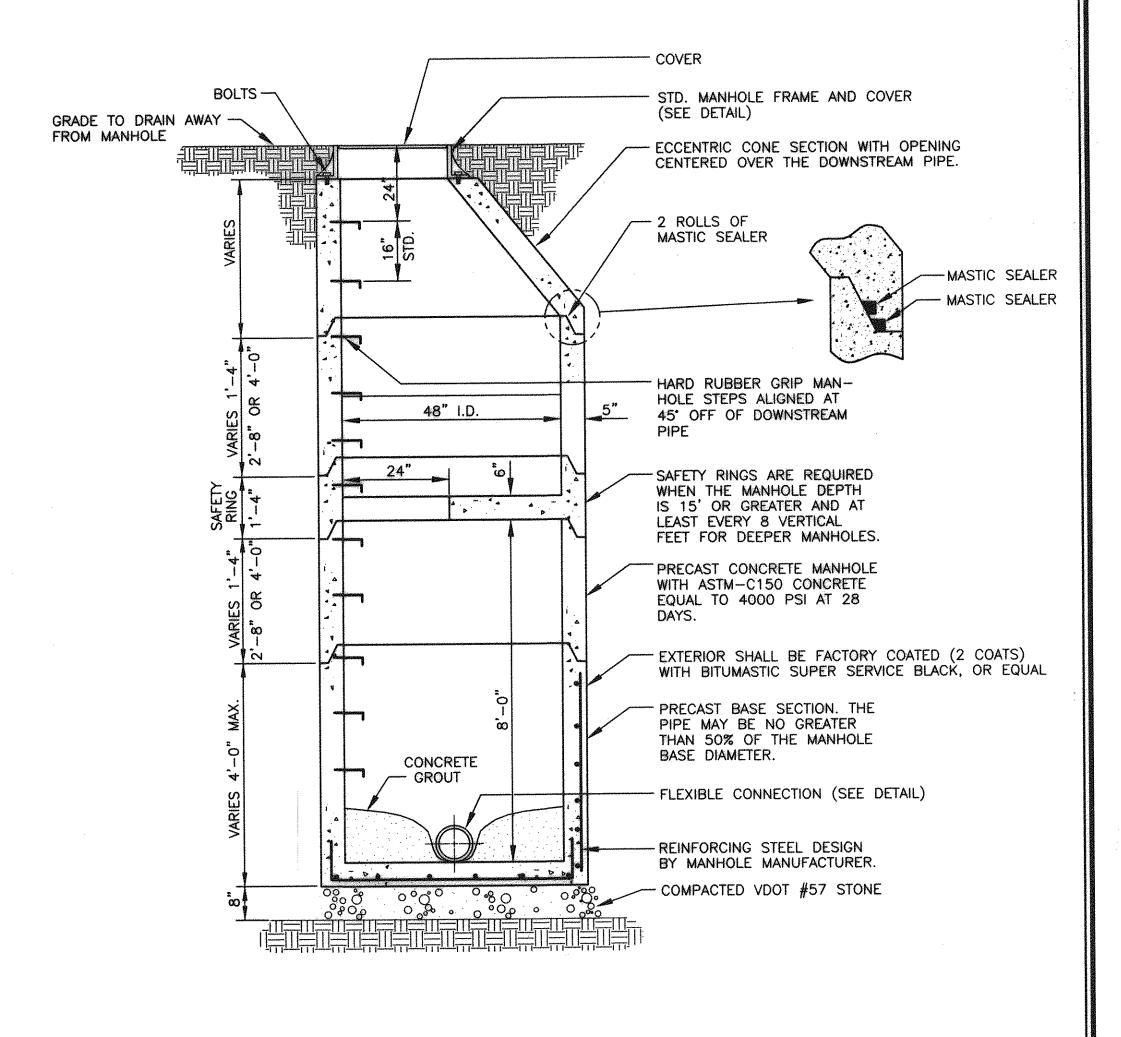


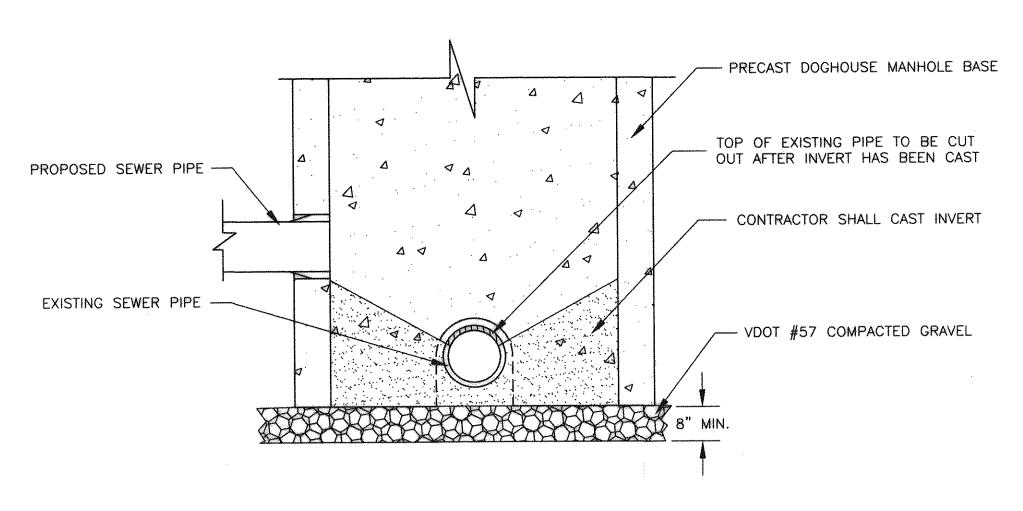

DOGHOUSE MANHOLE DETAIL

N.T.S.

PLEASE REFER TO THE PRECAST ECCENTRIC MANHOLE DETAIL (THIS SHEET) FOR ALL MANHOLE DIMENSIONS AND INFORMATION NOT OTHERWISE NOTED IN THIS DETAIL.

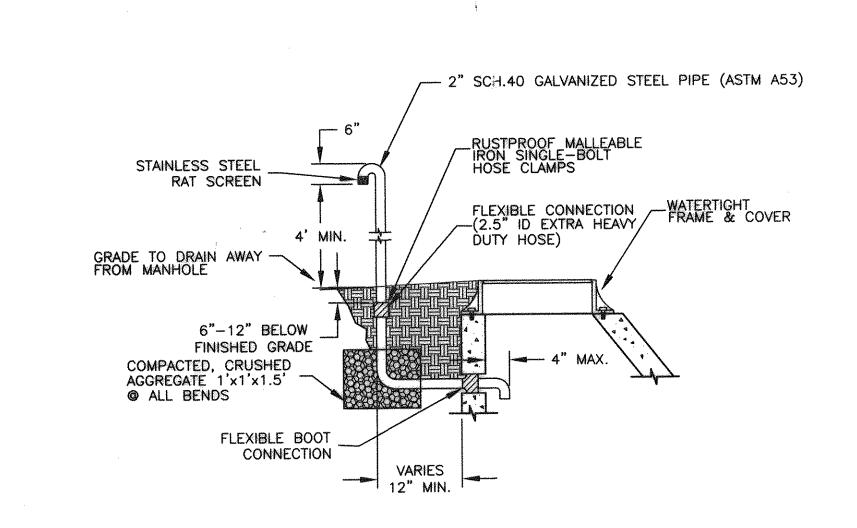

PRECAST ECCENTRIC MANHOLE

MANHOLE VENT DETAIL

ENGINEERING CONCEPTS, INC.

20 S. ROANOKE ST., PO BOX 619 FINCASTLE, VIRGINIA 24090 540.473.1253 FAX: 540.473.1254 AS-BUILT

4			1				
No.	Revision	Ву	Appd	. Date	Drawn PSN	GREENFIELD COLLECTOR AND	
1	DOGHOUSE MANHOLE DETAIL	scc	WPJ	1/21/97	Designed	TINKER CREEK EXTENSION	DECEMBER 1996
	1:	<u> </u>			SCG		PROJECT: 96081
					Checked WPJ/JST	SANITARY SEWER DETAILS	
		<u> </u>	,,,,,,,,,,,,,,,,,,,,,,,,,,,,,,,,,,,,,,,		Approved		23 of 27
	:				WPJ		