
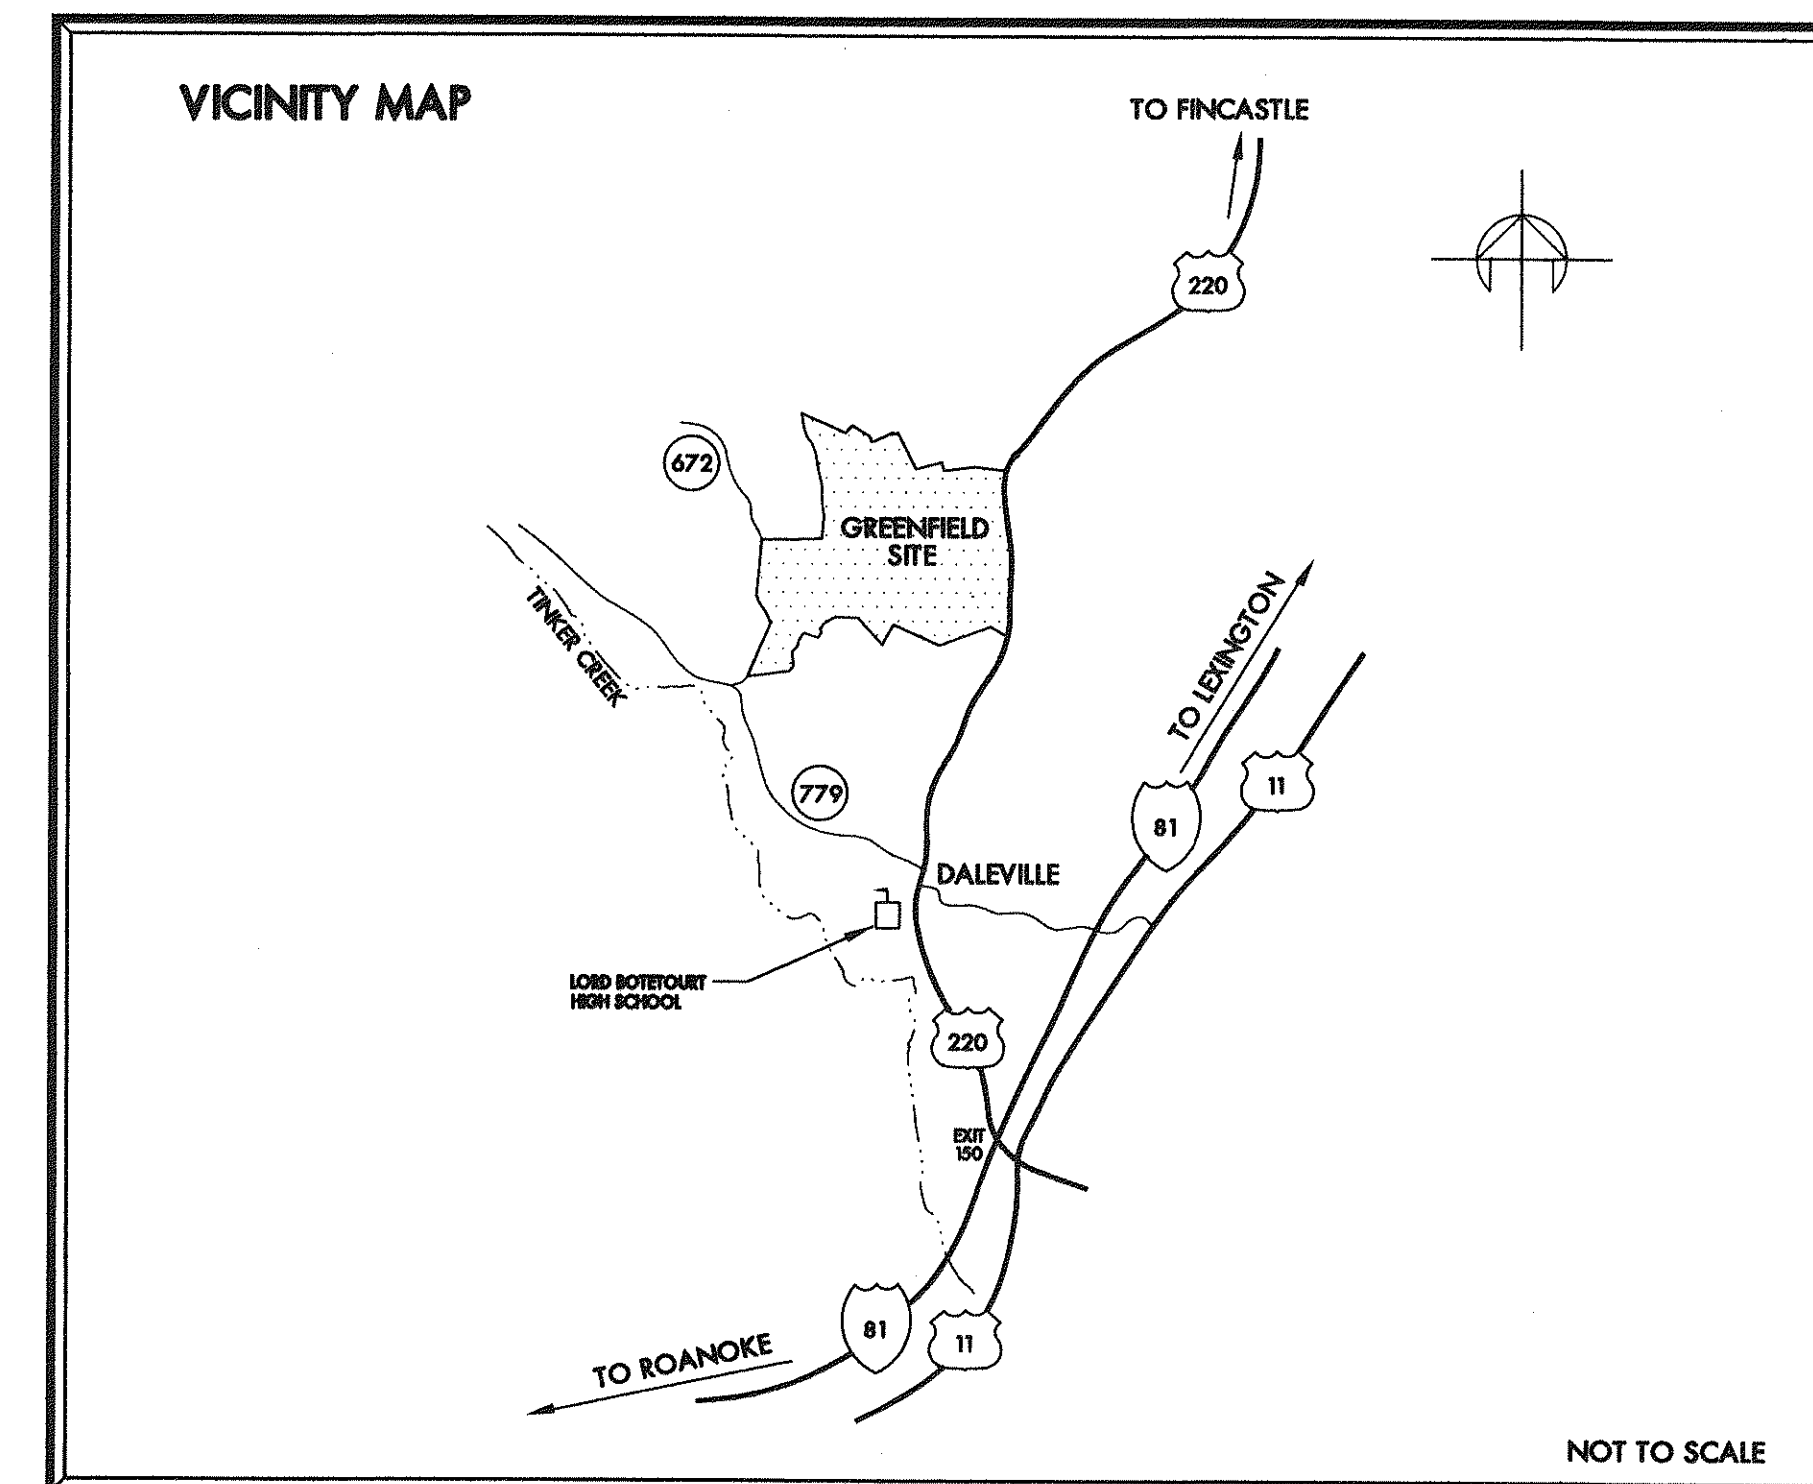


# GREENFIELD RAW WATER LINE #3


## BOTETOURT COUNTY DEPARTMENT OF PUBLIC FACILITIES AND PROGRAMS

BOTETOURT COUNTY, VIRGINIA  
JUNE 22, 1998

PROJECT NAME: GREENFIELD RAW WATER LINE #3  
DATE: FEB 18, 2000  
TYPE: WATER  
LOCATION: GREENFIELD  
TOTAL # SHEETS: 10  
AVE. FIRM: ECL  
# OF SETS: 1

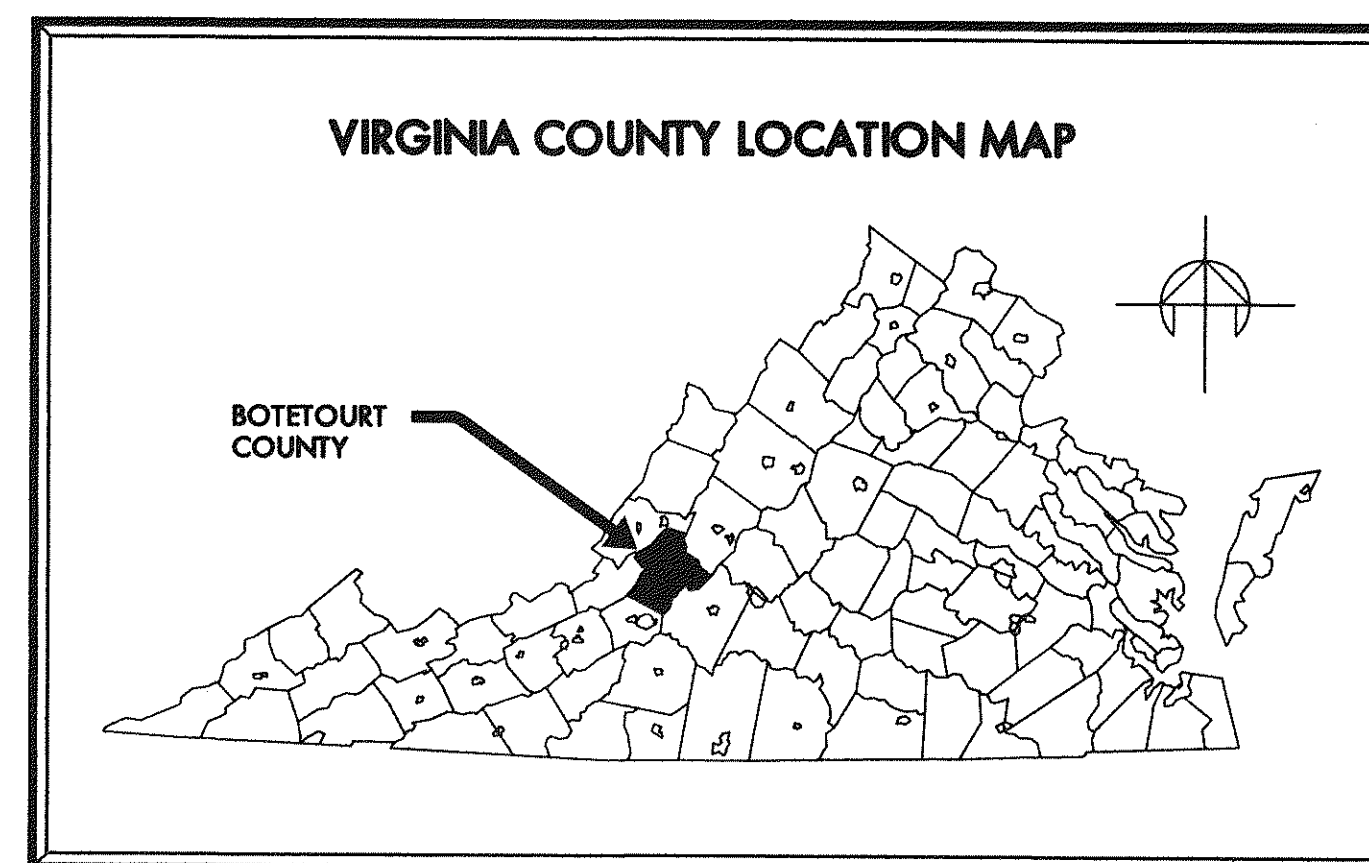

AS-BUILT  
FEBRUARY 18, 2000

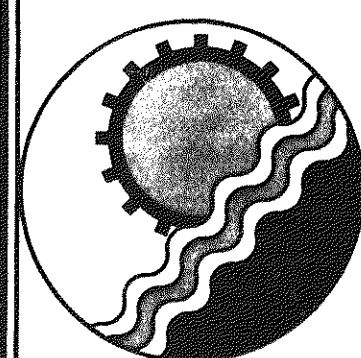

**ENGINEERING CONCEPTS, INC.**

20 S. ROANOKE ST., PO BOX 619  
FINCASTLE, VIRGINIA 24090  
540.473.1253 FAX: 540.473.1254

**OWNER: BOTETOURT COUNTY**

DEPARTMENT OF PUBLIC FACILITIES AND PROGRAMS  
1 WEST MAIN ST., BOX 4  
FINCASTLE, VIRGINIA 24090  
540.473.8316

