





ELDOR CORPORATION

IGNITION MANUFACTURING

THE BOTETOURT CENTER AT GREENFIELD


Botetourt County - Virginia

September 20, 2017

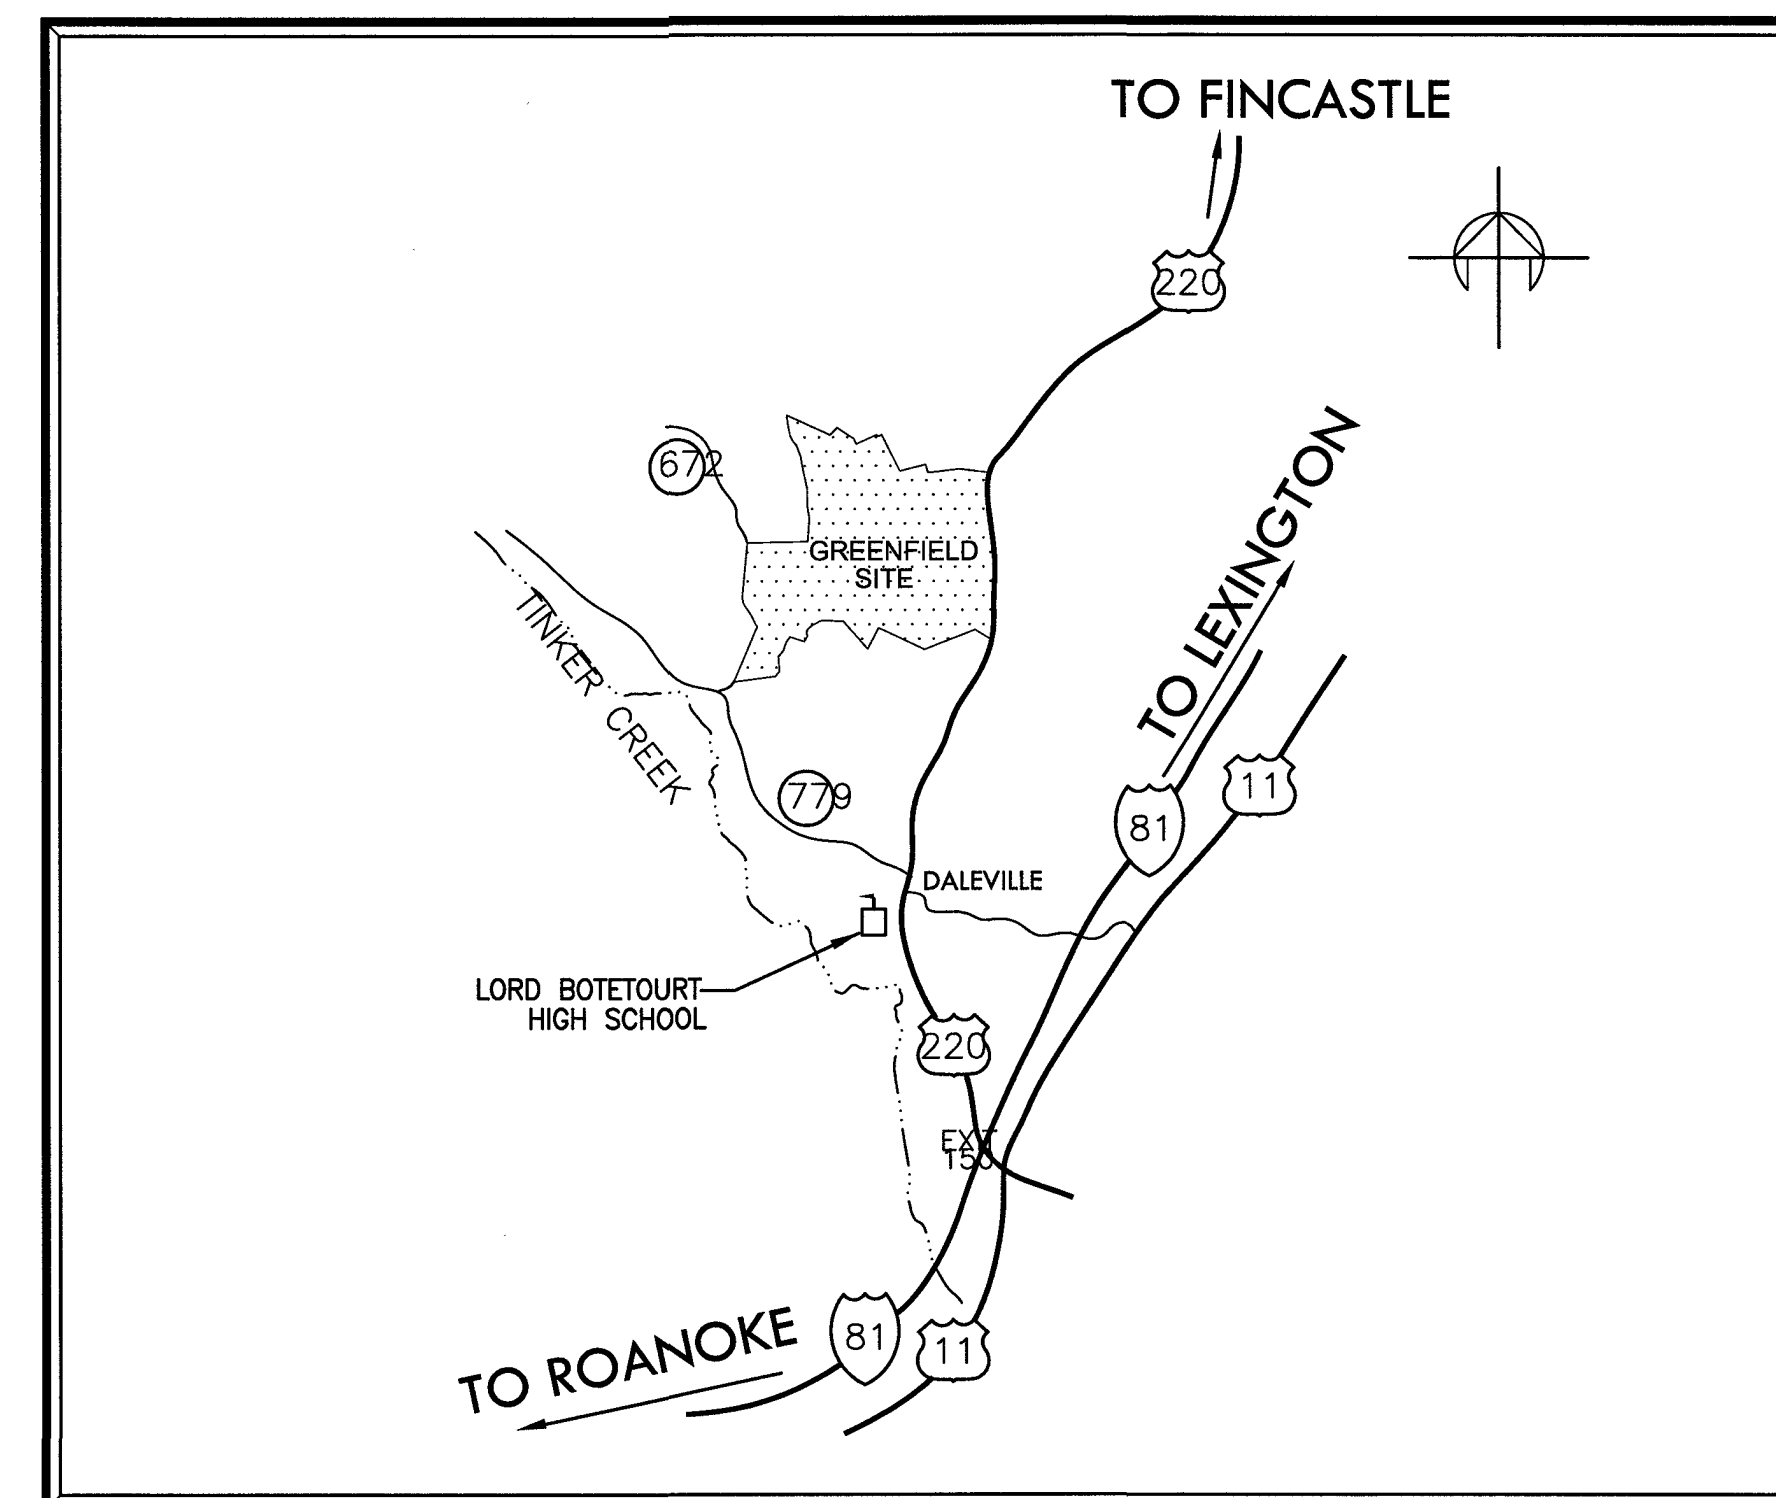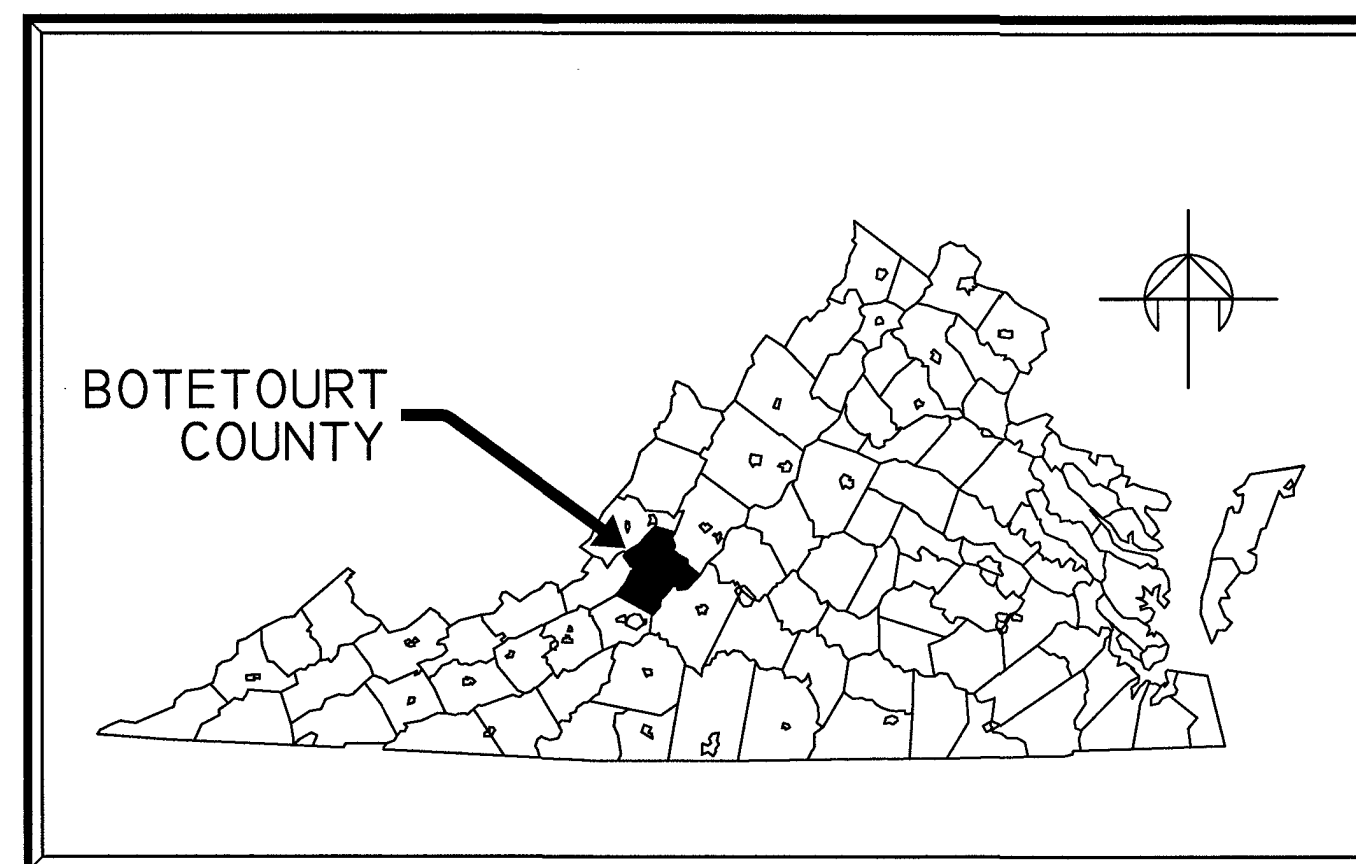

SHEET INDEX

- C1 COVER SHEET
- C2 GENERAL NOTES
- C3 EXISTING CONDITIONS & TOPOGRAPHY
- C4 OVERALL PLAN
- C5 GRADING PLAN
- C6 SITE DIMENSIONAL PLAN
- C7 SITE DETAILS
- C8 WATER DETAILS
- C9 SANITARY SEWER DETAILS
- C10 EROSION CONTROL DETAILS
- C11 SANITARY SEWER PROFILES
- C12 STORM SEWER PROFILES
- C13 STORM SEWER PROFILES - 2
- C14 STORM SEWER PROFILES - 3
- C15 GAS LINE PROFILE
- C16 WATERLINE PROFILES
- C17 WATERLINE PROFILES
- C18 EROSION CONTROL PLAN
- C19 TRANSPORTATION MANAGEMENT PLAN
- L-1 OVERVIEW OF PLANTING PLAN
- L-2 OVERALL PLANTING PLAN
- L-3 DETAILED PLANTING PLAN & DETAILS
- L-4 DETAILED CROSS-SECTIONS
- 1of1 SITE LIGHTING CALCULATIONS
- SUPP LIGHTING FIXTURE CUT SHEETS
- E003 LIGHTING FIXTURE PRODUCT DATA
- E010 ELECTRICAL SITE PLAN LIGHTING
- AS01 ROOF PLAN A, B, & C
- AS02 ROOF PLAN D, G, & H
- AS03 ROOF PLAN E, F, G, & K
- AS04 METL-SPAN & ROOFSCREEN CUTSHEETS
- AS05 EXTERIOR ELEVATIONS

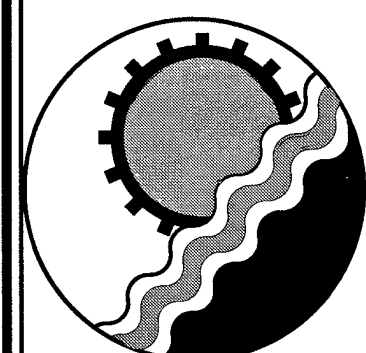


ENGINEERING CONCEPTS, INC.

20 S. ROANOKE ST., PO BOX 619
FINCASTLE, VIRGINIA 24090
540.473.1253 FAX: 540.473.1254



GRESHAM
SMITH AND
PARTNERS

Barton
Malow

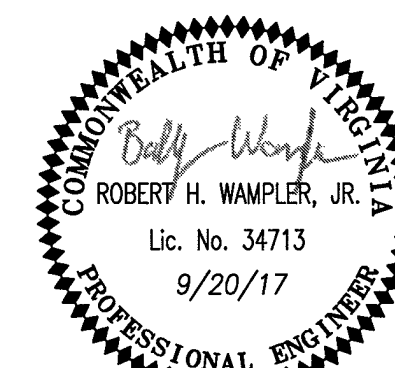

No.	Revision	By	Appd.	Date	Drawn	ECI
1	COORDINATION & COMMENTS	ECI	RHW	6/29/17	Designed	ECI
2	VDOT COMMENTS	ECI	RHW	8/11/17	Checked	RHW
3	ADD SHEETS FROM OTHERS	ECI	RHW	9/20/17	Approved	RHW

COVER SHEET
ELDOR IGNITION MANUFACTURING
THE BOTETOURT CENTER AT GREENFIELD
BOTETOURT COUNTY, VIRGINIA

SCALE: NONE
September 20, 2017
PROJECT: 16070
C1

CHARLES CRUSH
As-BUILTS
12-08-17