
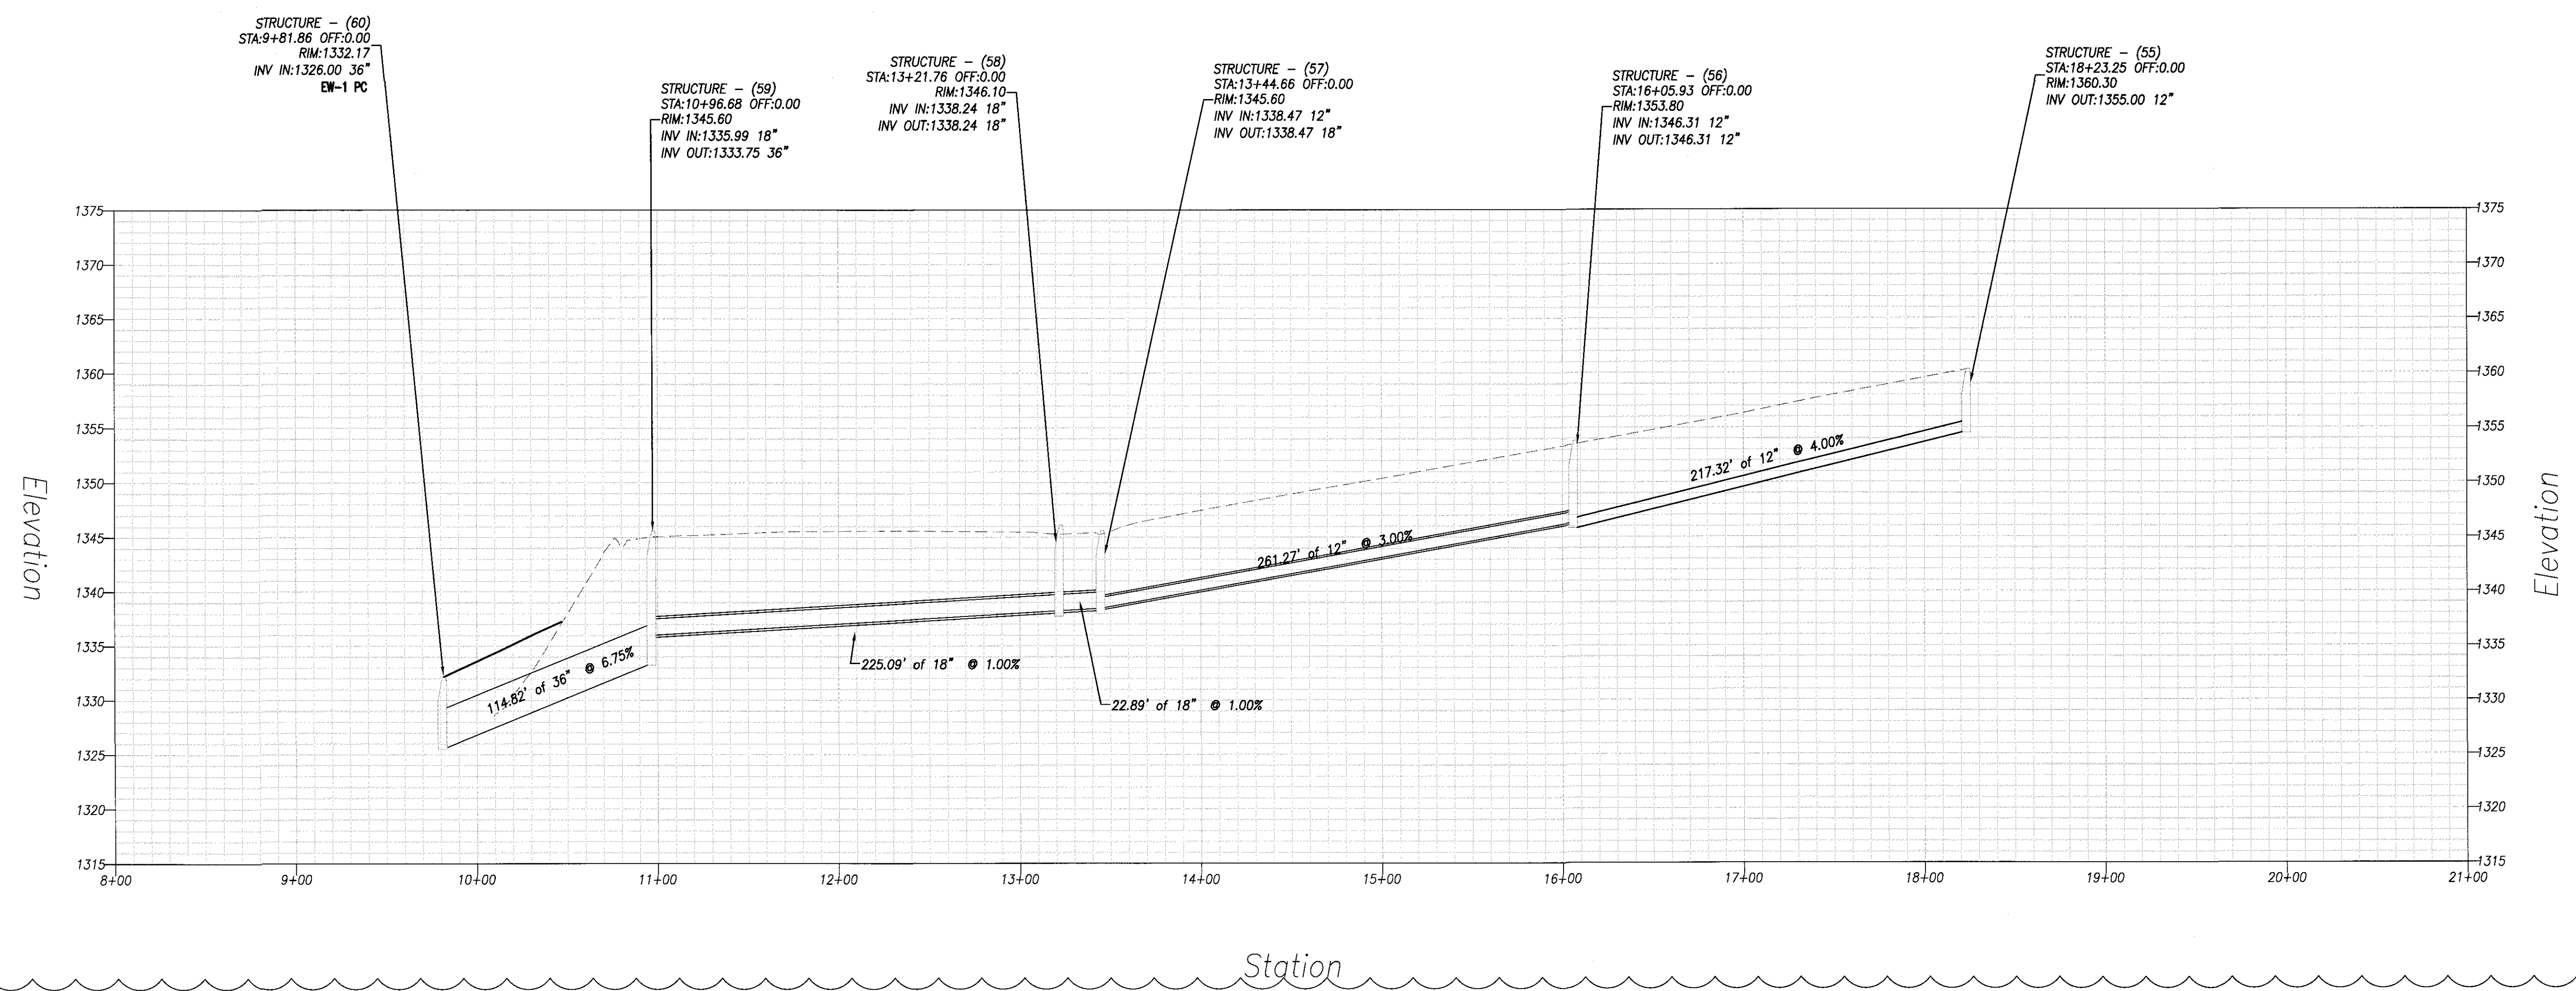


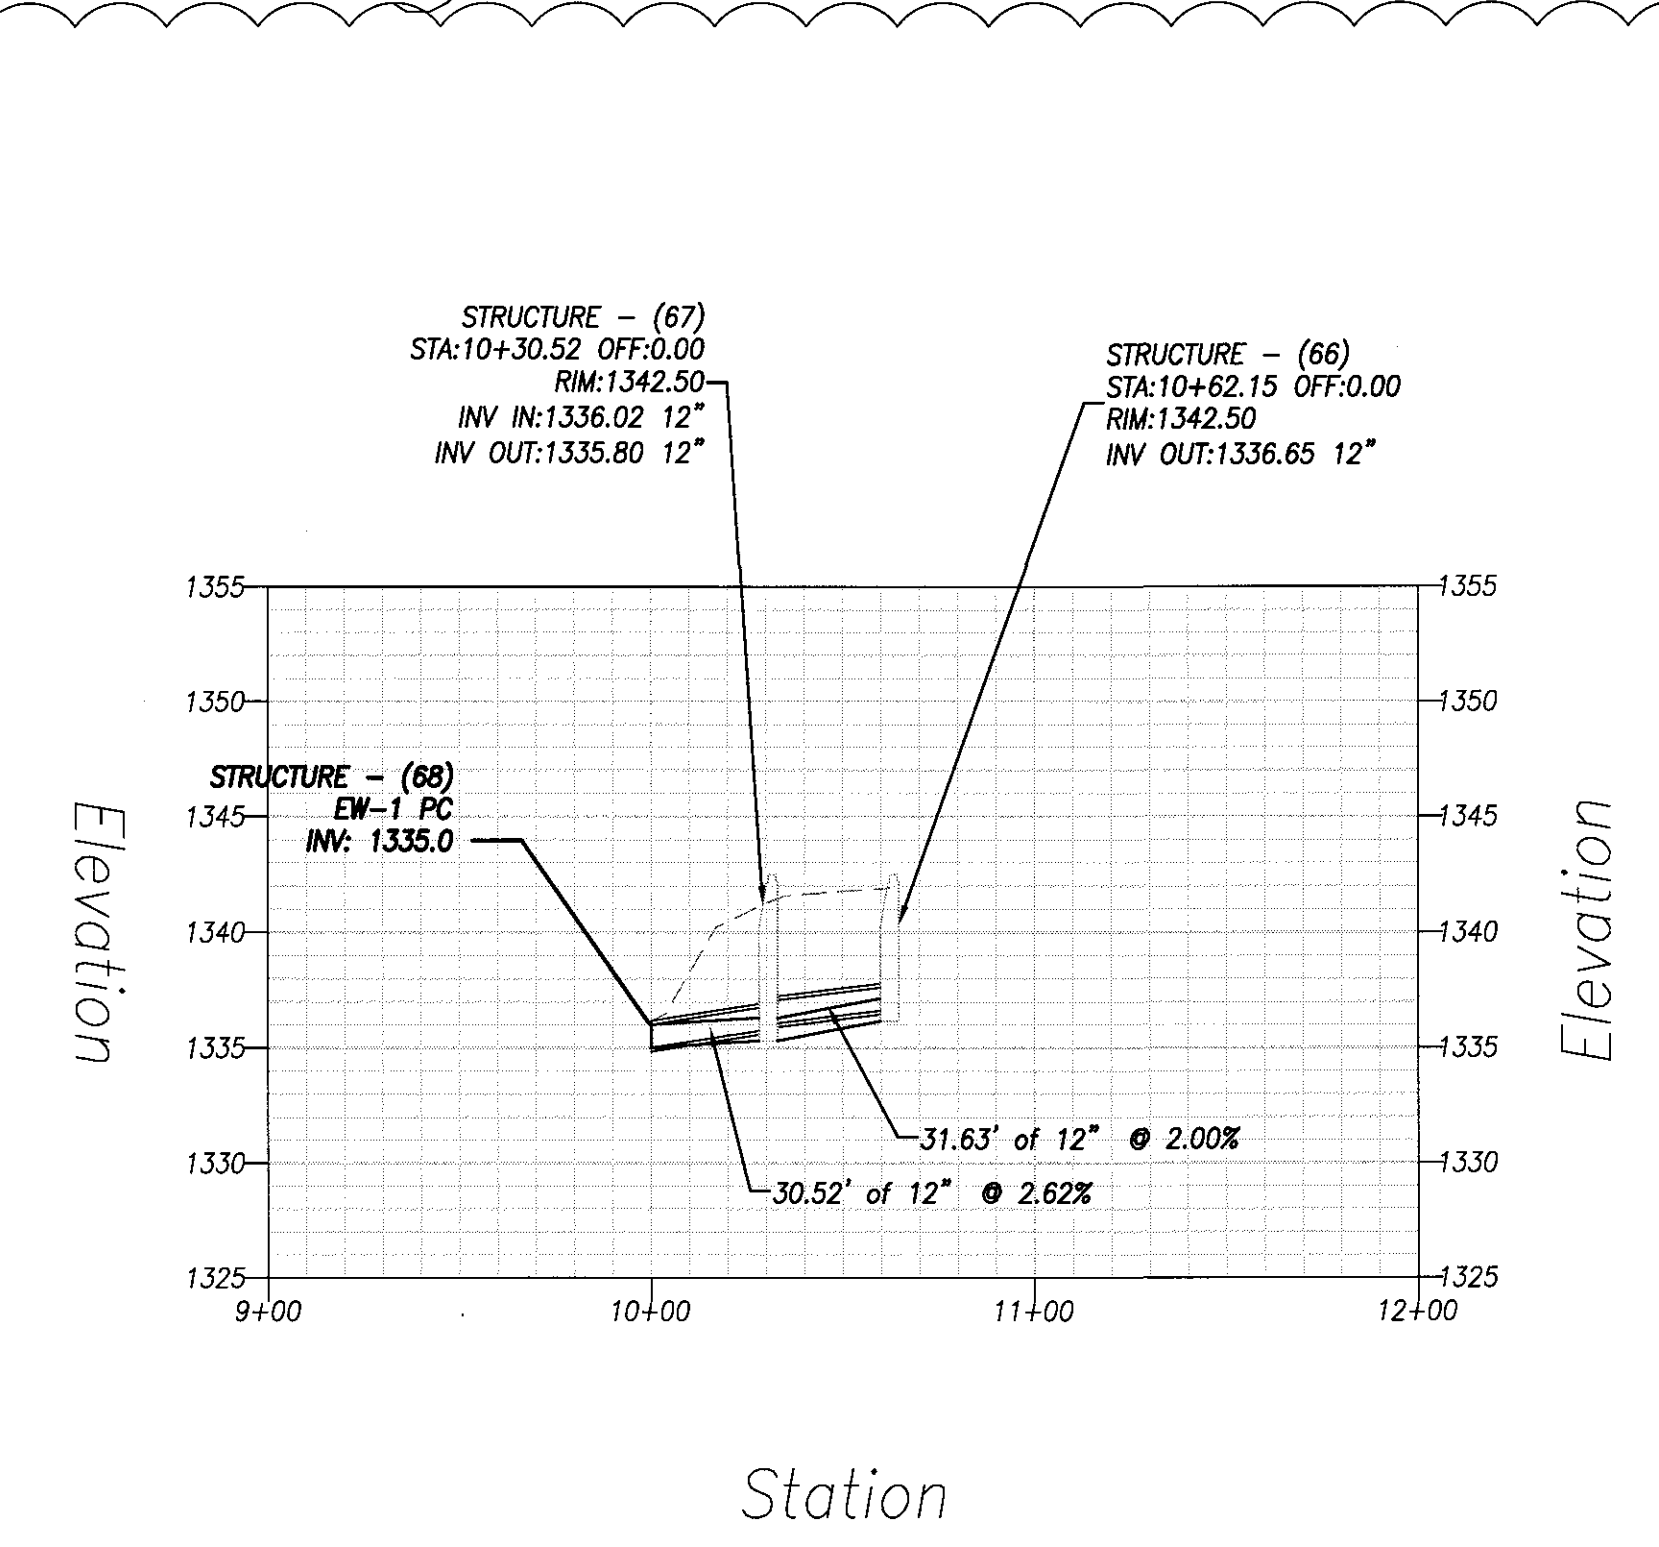

No.	Revision	By	Appd.	Date	Drawn
1	COORDINATION & COMMENTS	ECI	RHW	6/29/17	ECI
2	CORRECT STRUCTURE CALLOUTS	ECI	RHW	8/11/17	ECI
					Checked RHW
					Approved RHW

STORM SEWER PROFILES ELDOR IGNITION MANUFACTURING		H:1"=50' V:1"=10'
THE BOTETOURT CENTER AT GREENFIELD BOTETOURT COUNTY - VIRGINIA		DATE: August 11, 2017
		PROJECT: 16070
		C12