
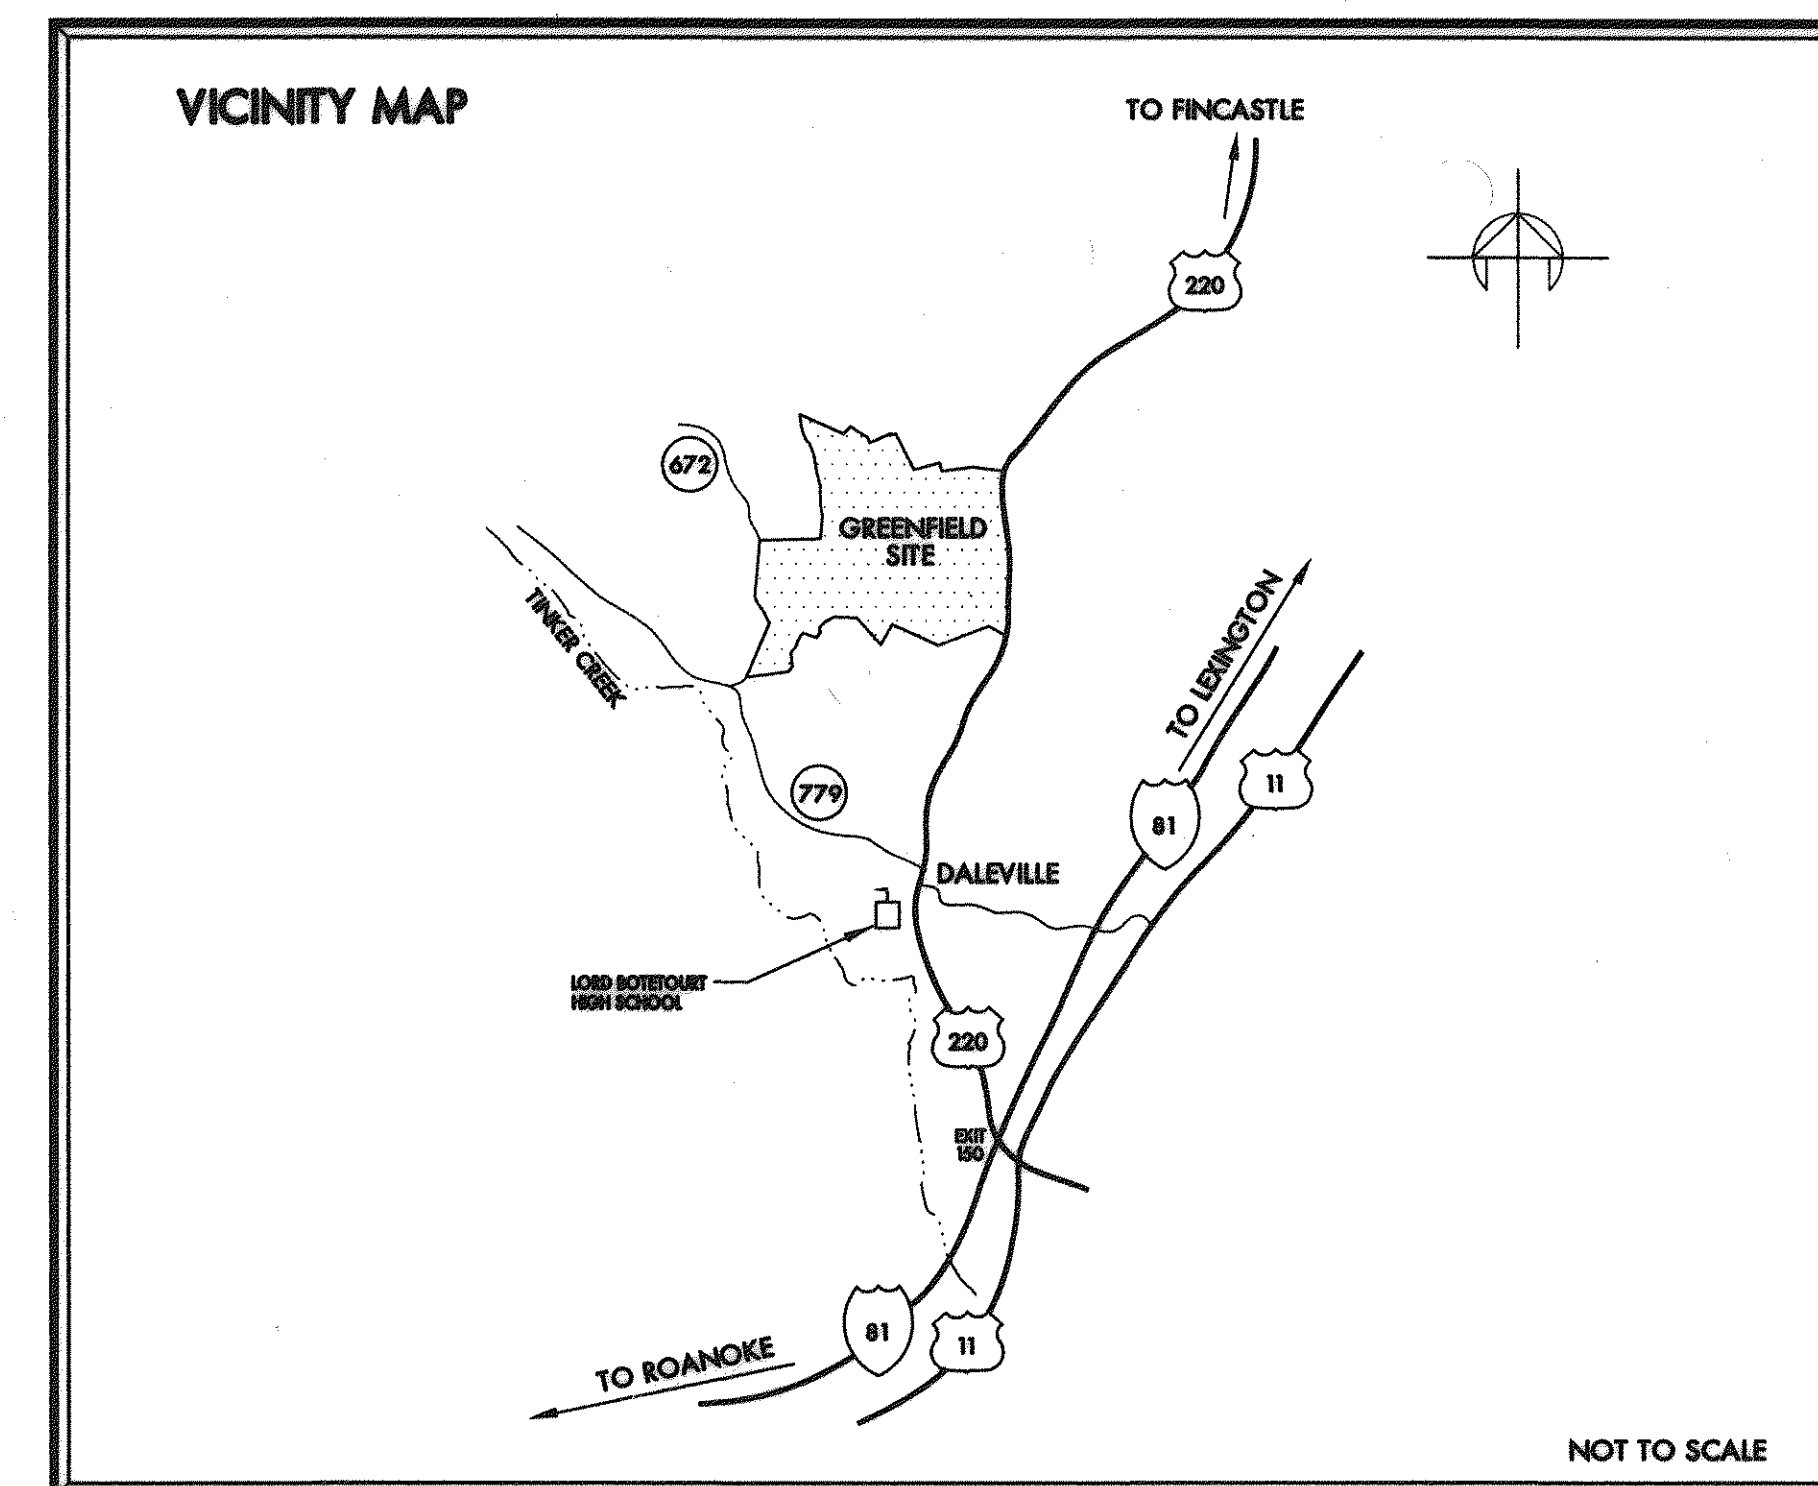


GREENFIELD TANK FILL PIPELINE


BOTETOURT COUNTY DEPARTMENT OF PUBLIC FACILITIES AND PROGRAMS

BOTETOURT COUNTY, VIRGINIA
JUNE 22, 1998

A8 GREENFIELD
PROJECT NAME: Tank Fill Pipeline
DATE: Feb. 22, 2000
TYPE: WATER
LOCATION: 6
TOTAL SHEETS: 6
SHEET NO.: 1
OF SETS: 1

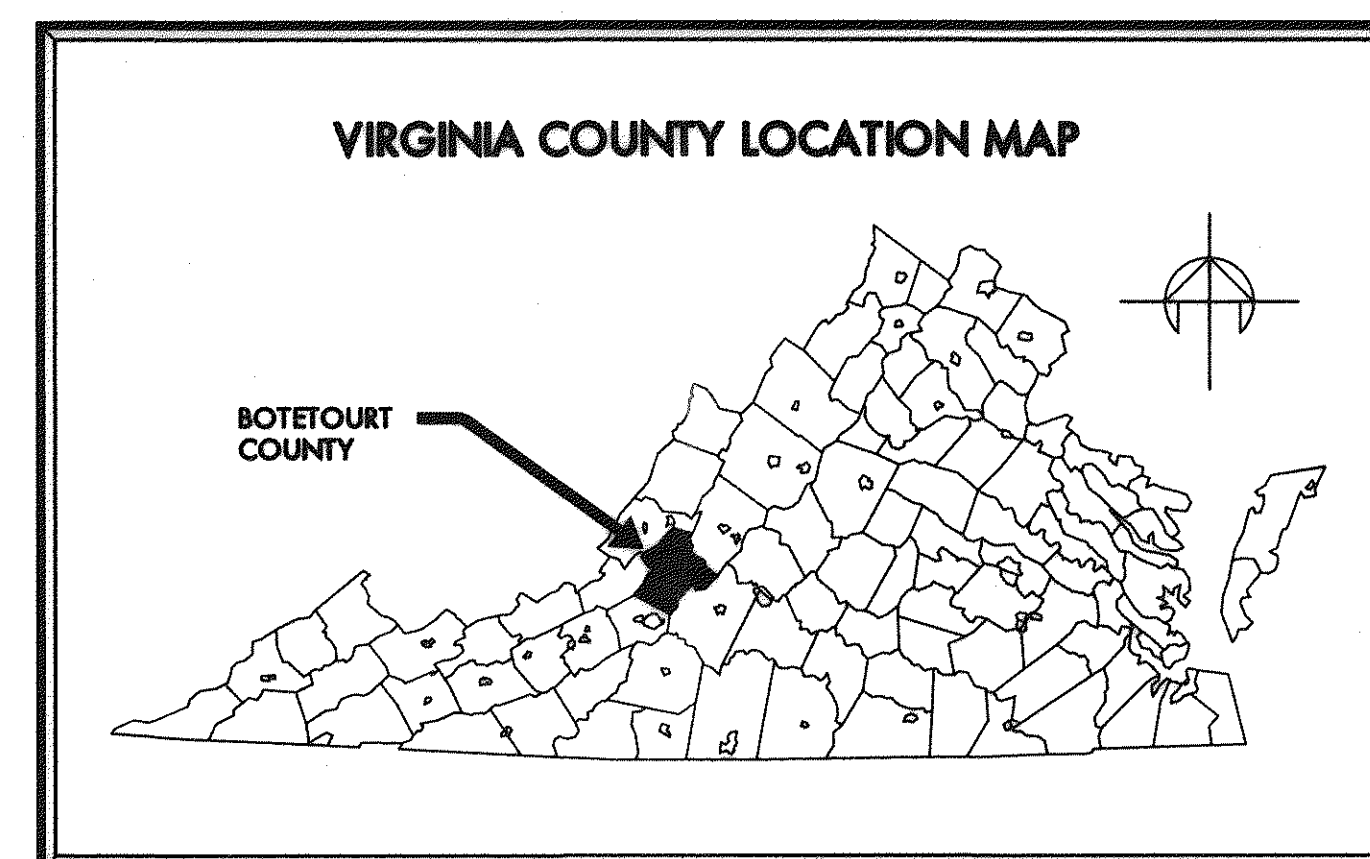

AS-BUILT
FEBRUARY 22, 2000

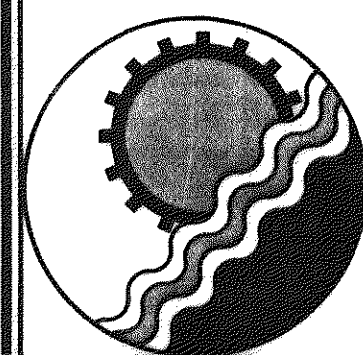

ENGINEERING CONCEPTS, INC.

20 S. ROANOKE ST., PO BOX 619
FINCASTLE, VIRGINIA 24090
540.473.1253 FAX: 540.473.1254

OWNER: BOTETOURT COUNTY

DEPARTMENT OF PUBLIC FACILITIES AND PROGRAMS
1 WEST MAIN ST., BOX 4
FINCASTLE, VIRGINIA 24090
540.473.8316

