



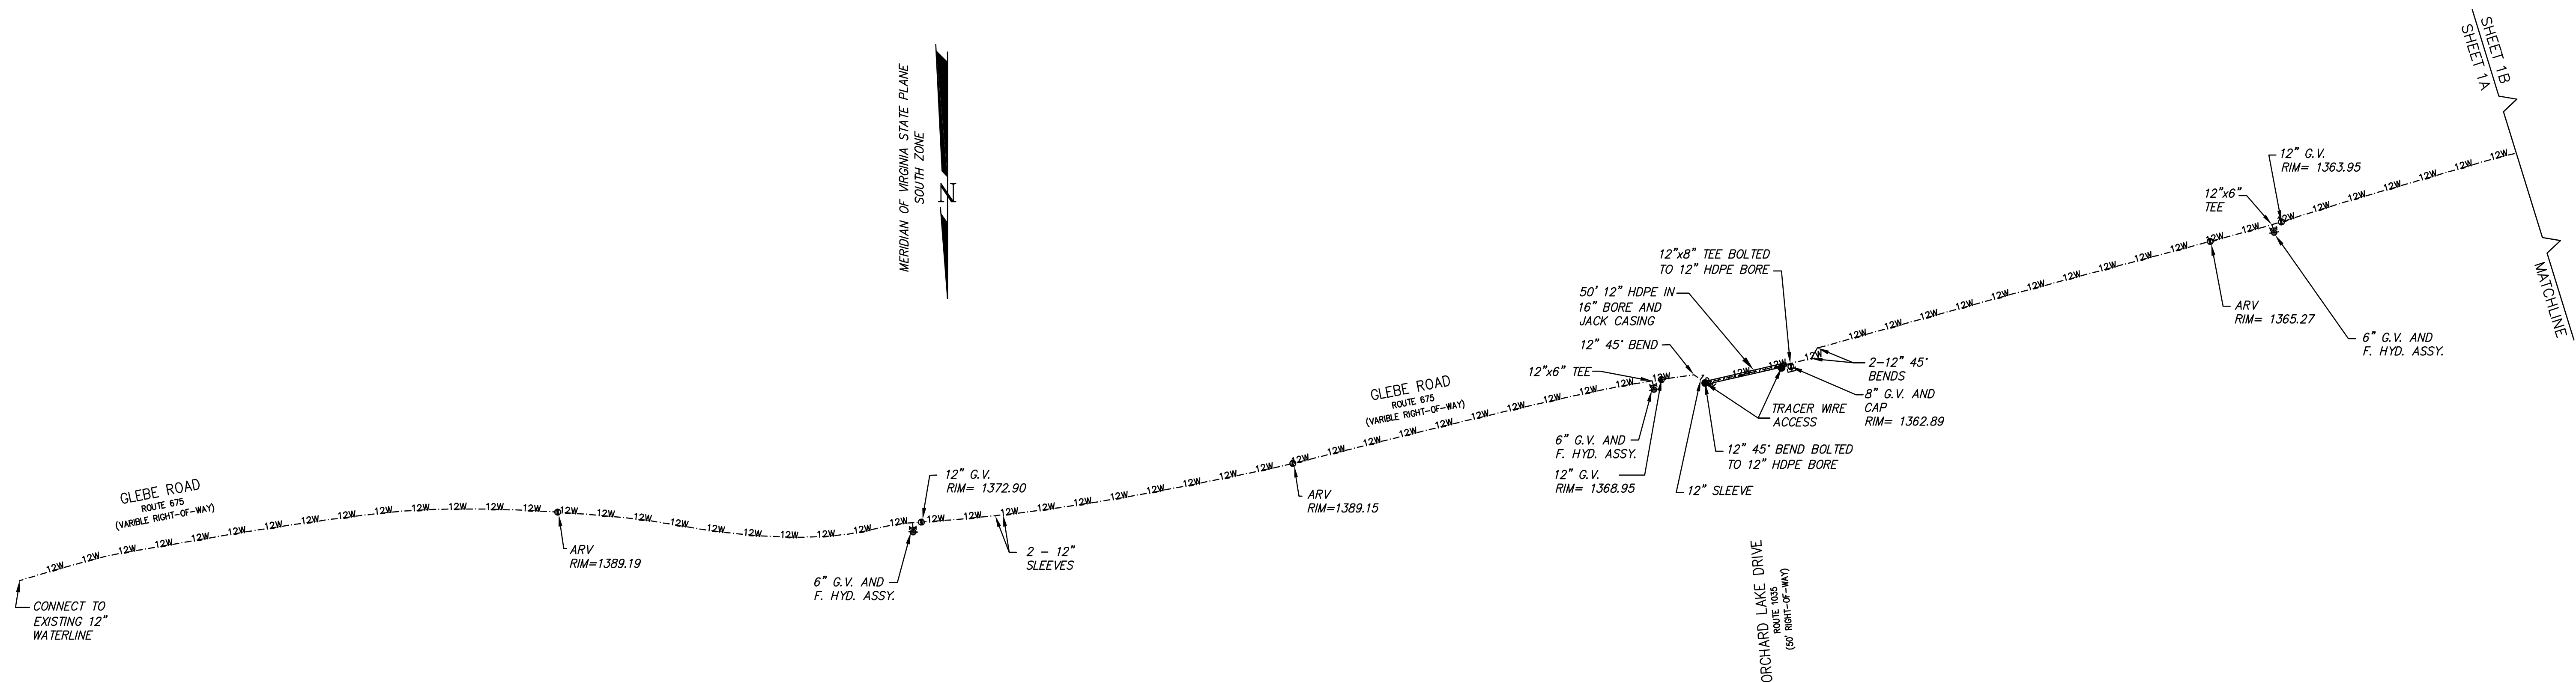

SHEET 1A

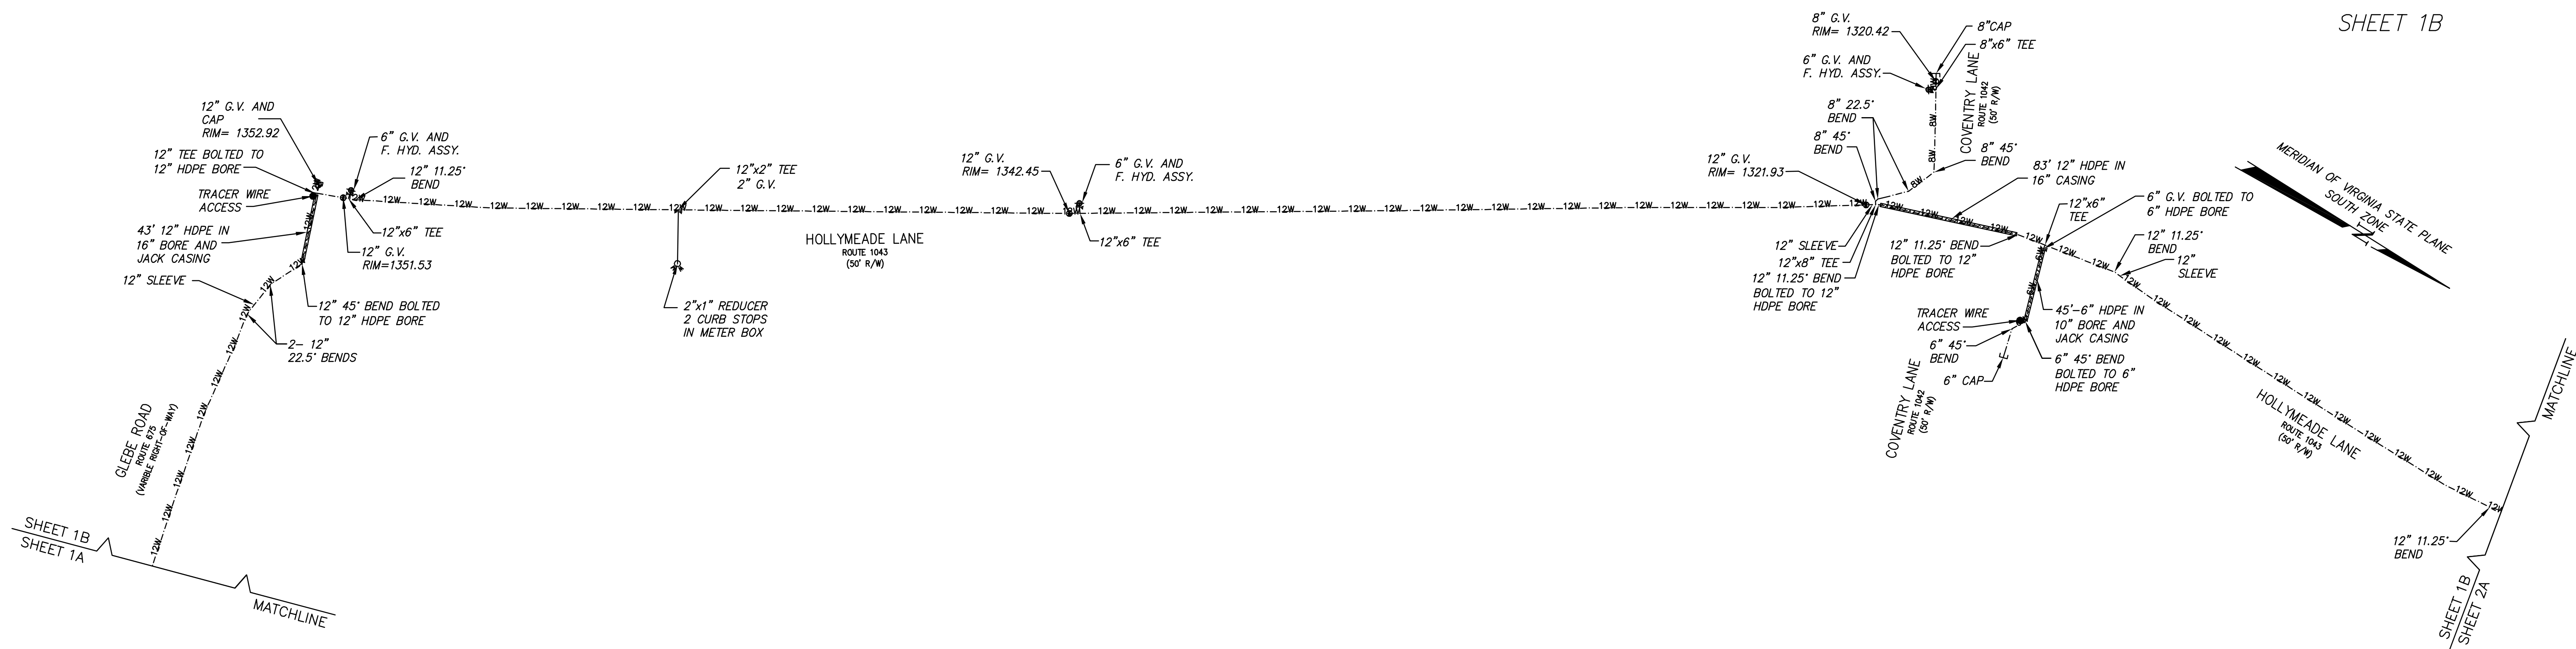

SHEET 1B


- ⊙ TRACER WIRE ACCESS
- ⊙ WATER VALVE
- ⊙ FIRE HYDRANT
- ⊙ WATER VAULT
- ⊙ AIR RELEASE VALVE
- ⊙ WATER METER

THIS AS-BUILT SURVEY IS BASED ON THE COORDINATE SYSTEM OF PLANS BY HURT & PROFFITT FOR THE WESTERN VIRGINIA WATER AUTHORITY TITLED HOLLYMEADE-GLEBE ROAD GREENFIELDS TANK WATERLINE EXTENSION, DATED NOVEMBER 15, 2019, PROJECT No. 20190009.

THIS AS-BUILT SURVEY IS BASED ON A FIELD SURVEY OF VISIBLE WATERLINE IMPROVEMENTS, AS-BUILT SKETCHES FROM THE CONTRACTOR FOR UNDERGROUND IMPROVEMENTS AND UNDERGROUND UTILITY LOCATION BY THE WESTERN VIRGINIA WATER AUTHORITY. THE FIELD SURVEY WAS COMPLETED BY CALDWELL WHITE ASSOCIATES, CONCLUDED ON AUGUST 18, 2020.

THIS AS-BUILT SURVEY WAS COMPLETED UNDER THE DIRECT AND RESPONSIBLE CHARGE OF, FRANK B. CALDWELL, III, L.S., FROM AN ACTUAL GROUND SURVEY MADE UNDER MY SUPERVISION. THE ORIGINAL DATA WAS OBTAINED ON AUGUST 18, 2020; AND THIS DIGITAL GEOSPATIAL DATA INCLUDING METADATA MEETS MINIMUM ACCURACY STANDARDS UNLESS OTHERWISE NOTED.

50 25 0 50 100 150
SCALE IN FEET

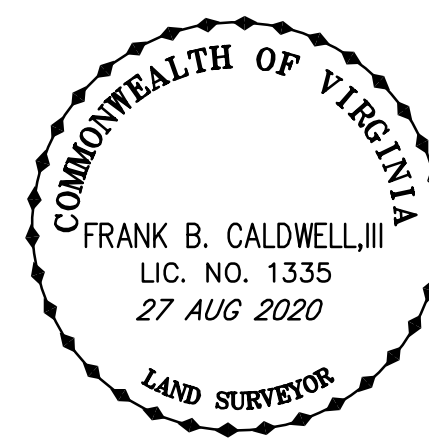

AS-BUILT SURVEY
FOR
WELLS CONSTRUCTION
SHOWING NEW WATERLINE LOCATION
WESTERN VIRGINIA WATER AUTHORITY PROJECT No. 20190009
SITUATE AT GLEBE ROAD, HOLLYMEADE ROAD
COUNTY OF BOTETOURT, VIRGINIA

CWA
CALDWELL WHITE ASSOCIATES
ENGINEERS / SURVEYORS / PLANNERS
4203 MELROSE AVENUE, N.W. P.O. BOX 6280
ROANOKE, VIRGINIA 24017-0280
Telephone: (540) 366-5400 Fax: (540) 366-8702
E-Mail: cwaroanoke@aol.com

Drawn: C.L. Hurd
Checked: F.B. Caldwell
Date: AUGUST 27, 2020
Scale: 1"=50'
Tax Parcel: VARIES
Field Book: CH-20
W.O.: 20-0003