
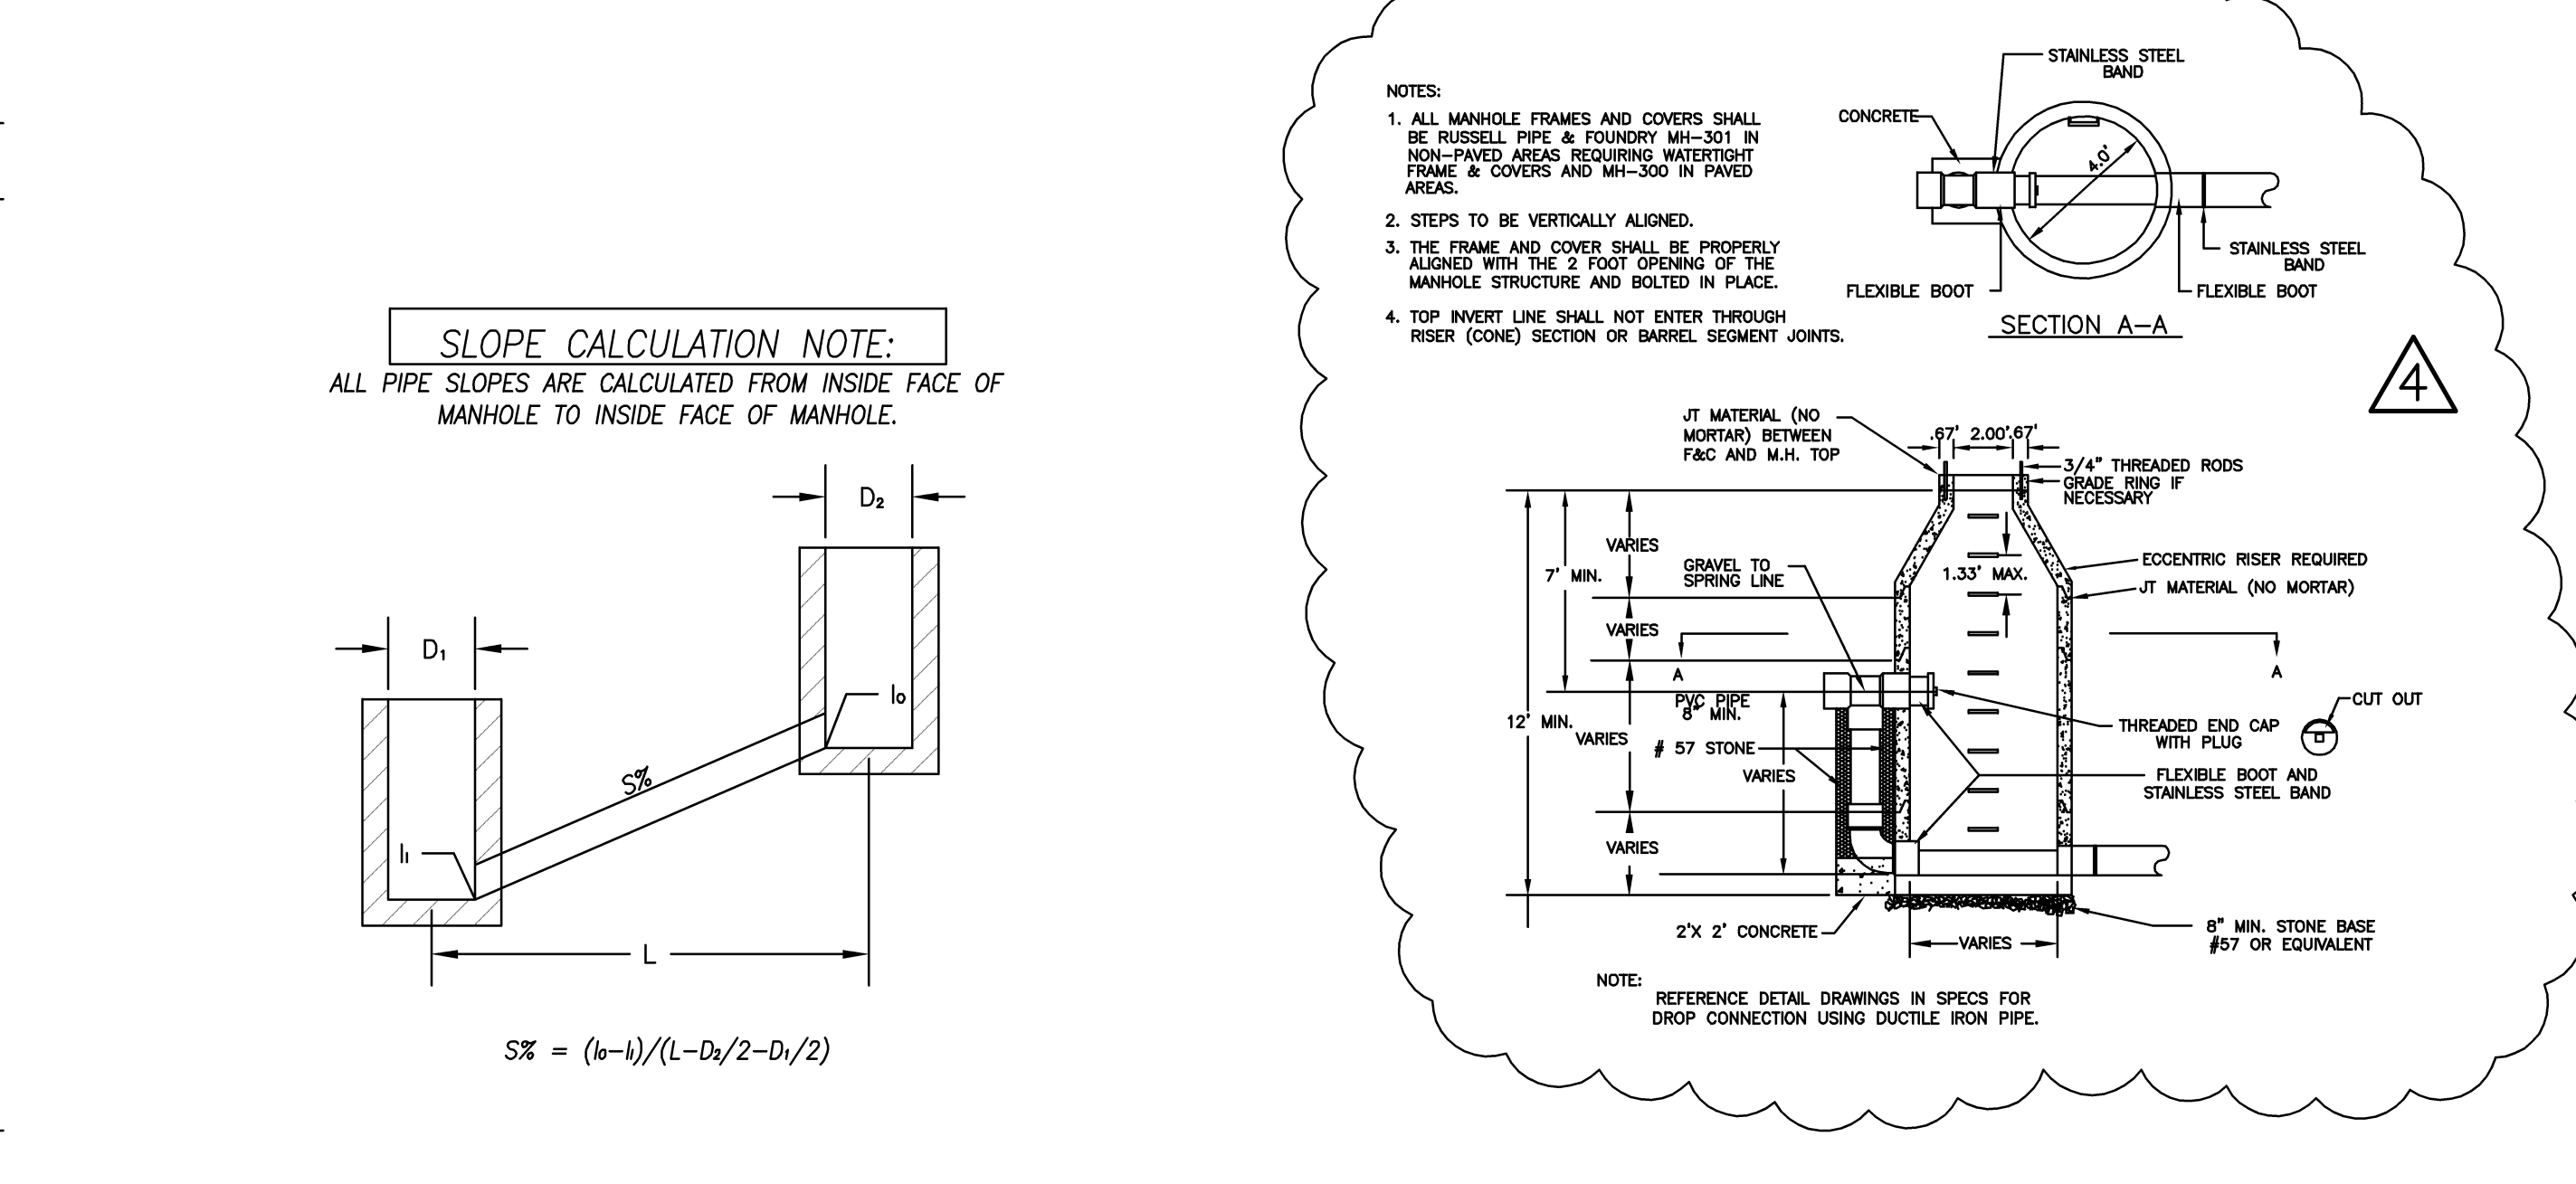
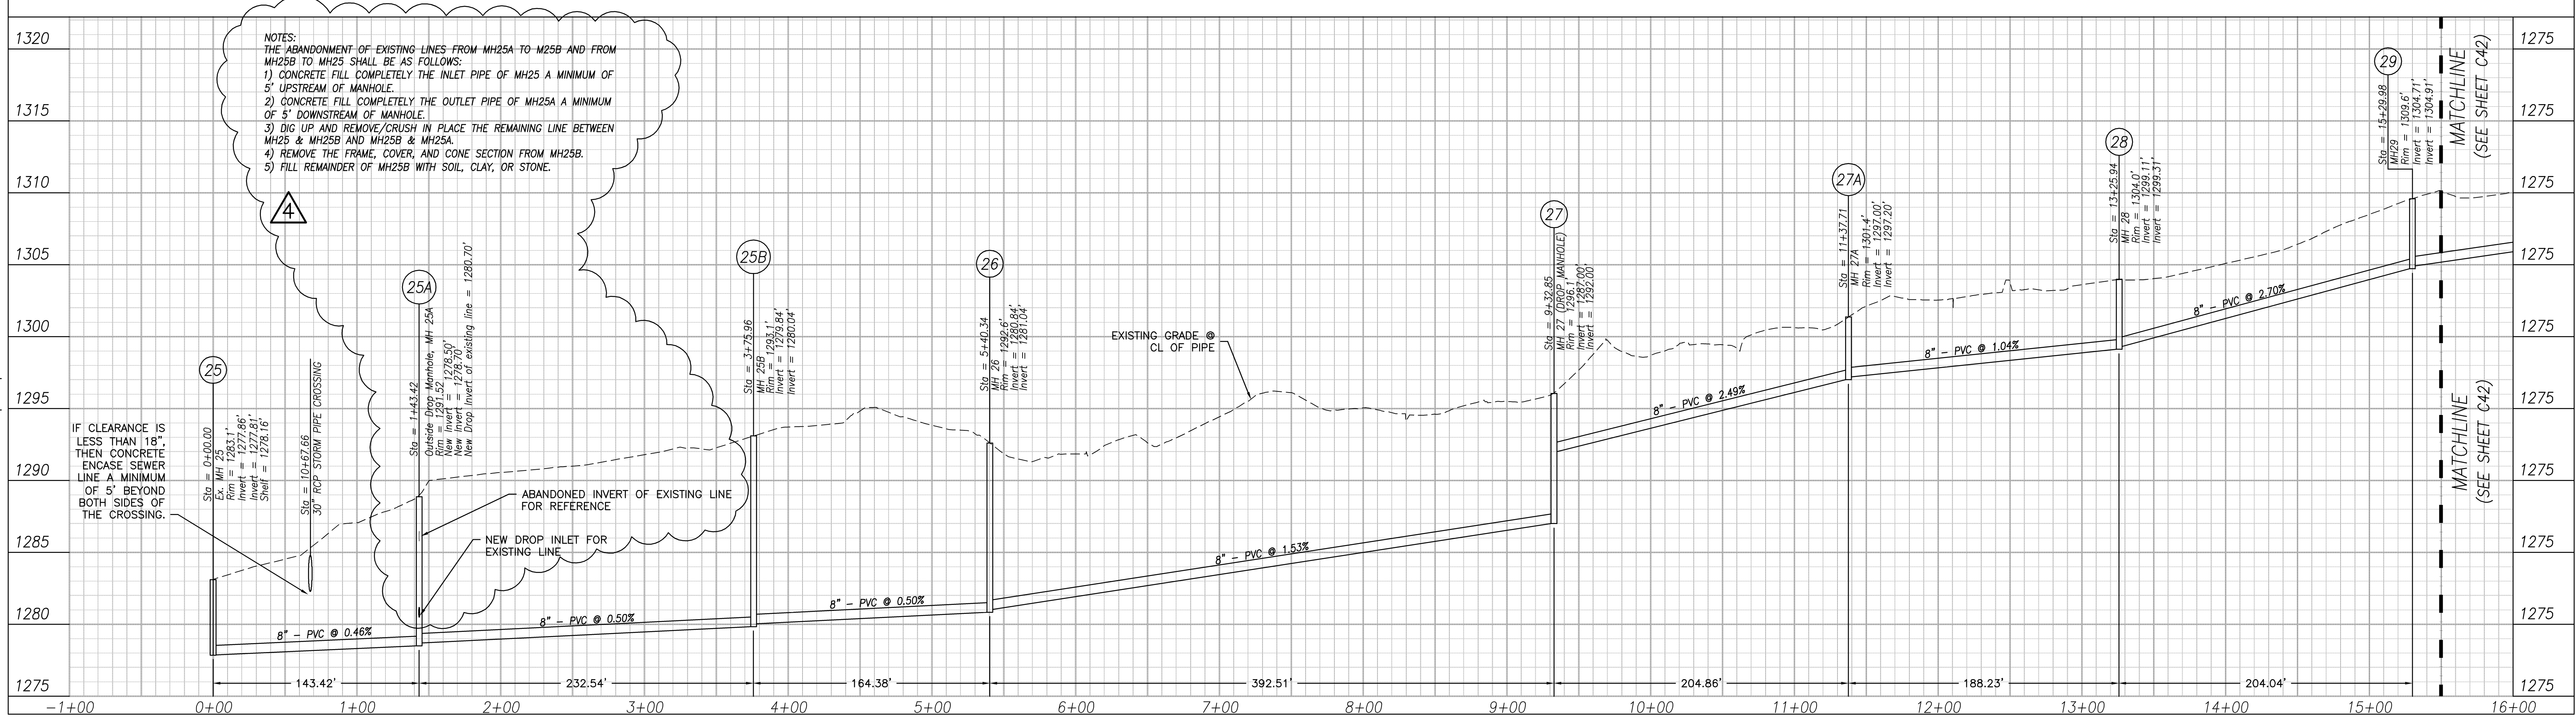


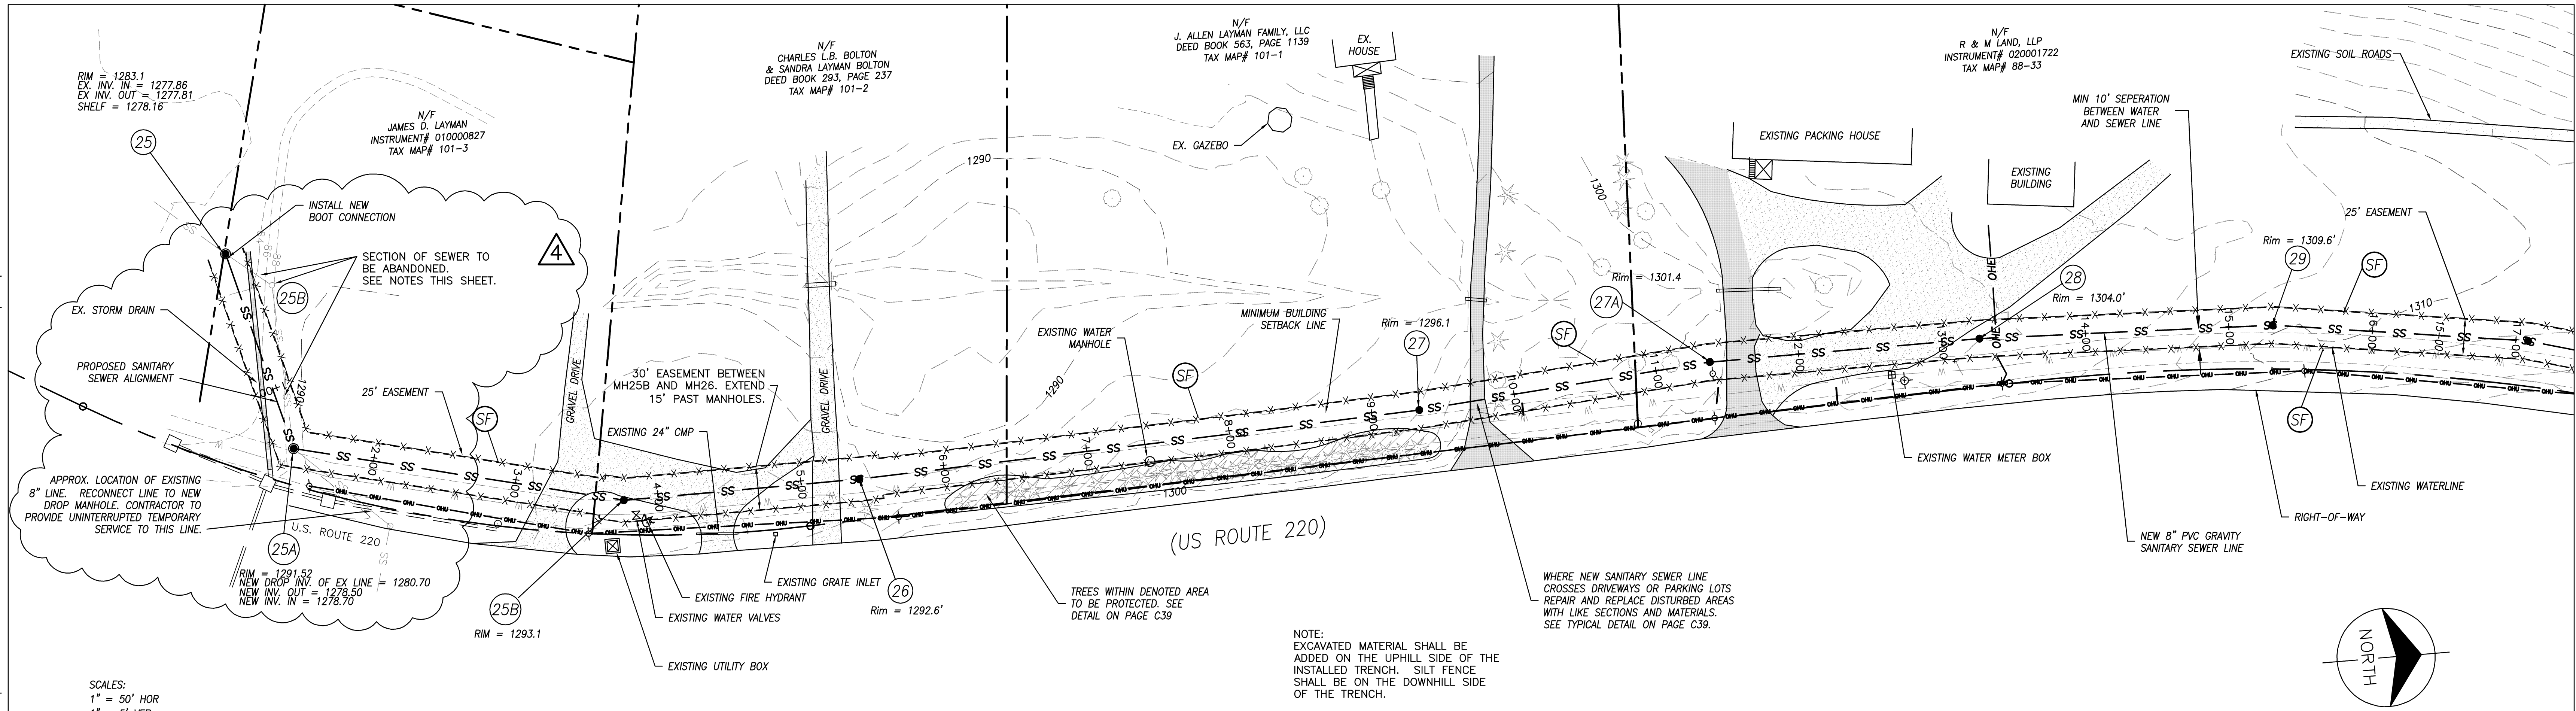

KEYPLAN

20 South Roanoke St.
Fincastle, Virginia 24090
540.473.1253 540.473.1254(Fax)
email@engineeringconcepts.com
ECI PROJECT #02019

GENERAL NOTES

20 South Roanoke St.
Fincastle, Virginia 24090
540.473.1253 540.473.1254(Fax)
email@engineeringconcepts.com
ECI PROJECT #02019

PROJECT TITLE

SFCS Inc. • 305 South Jefferson Street
Roanoke, Virginia 24011.2003
540.344.6664 • Fax 540.343.6925
www.sfcs.com

PROJECT DESIGNER : SFCS

PROJECT ARCHITECT : SFCS

PROJECT ENGINEER : ECI

DRAWN BY : ECI

CHECKED BY : ECI

APPROVED BY : ECI

NO. REVISION DESCRIPTION DATE

1 REVISIONS PER BOT. CO. 11/12/03

2 SEWER ALIGNMENT REVISIONS 9/14/04

3 SEWER ALIGNMENT REVISIONS 2/09/05

4 SEWER ALIGNMENT REVISIONS 2/15/05

DRAWING TITLE

OFFSITE GRAVITY
SANITARY SEWER
PLAN & PROFILE

COMM. NO. 97115.00

DATE 11/12/03

DRAWING

SHEET

41

OF