
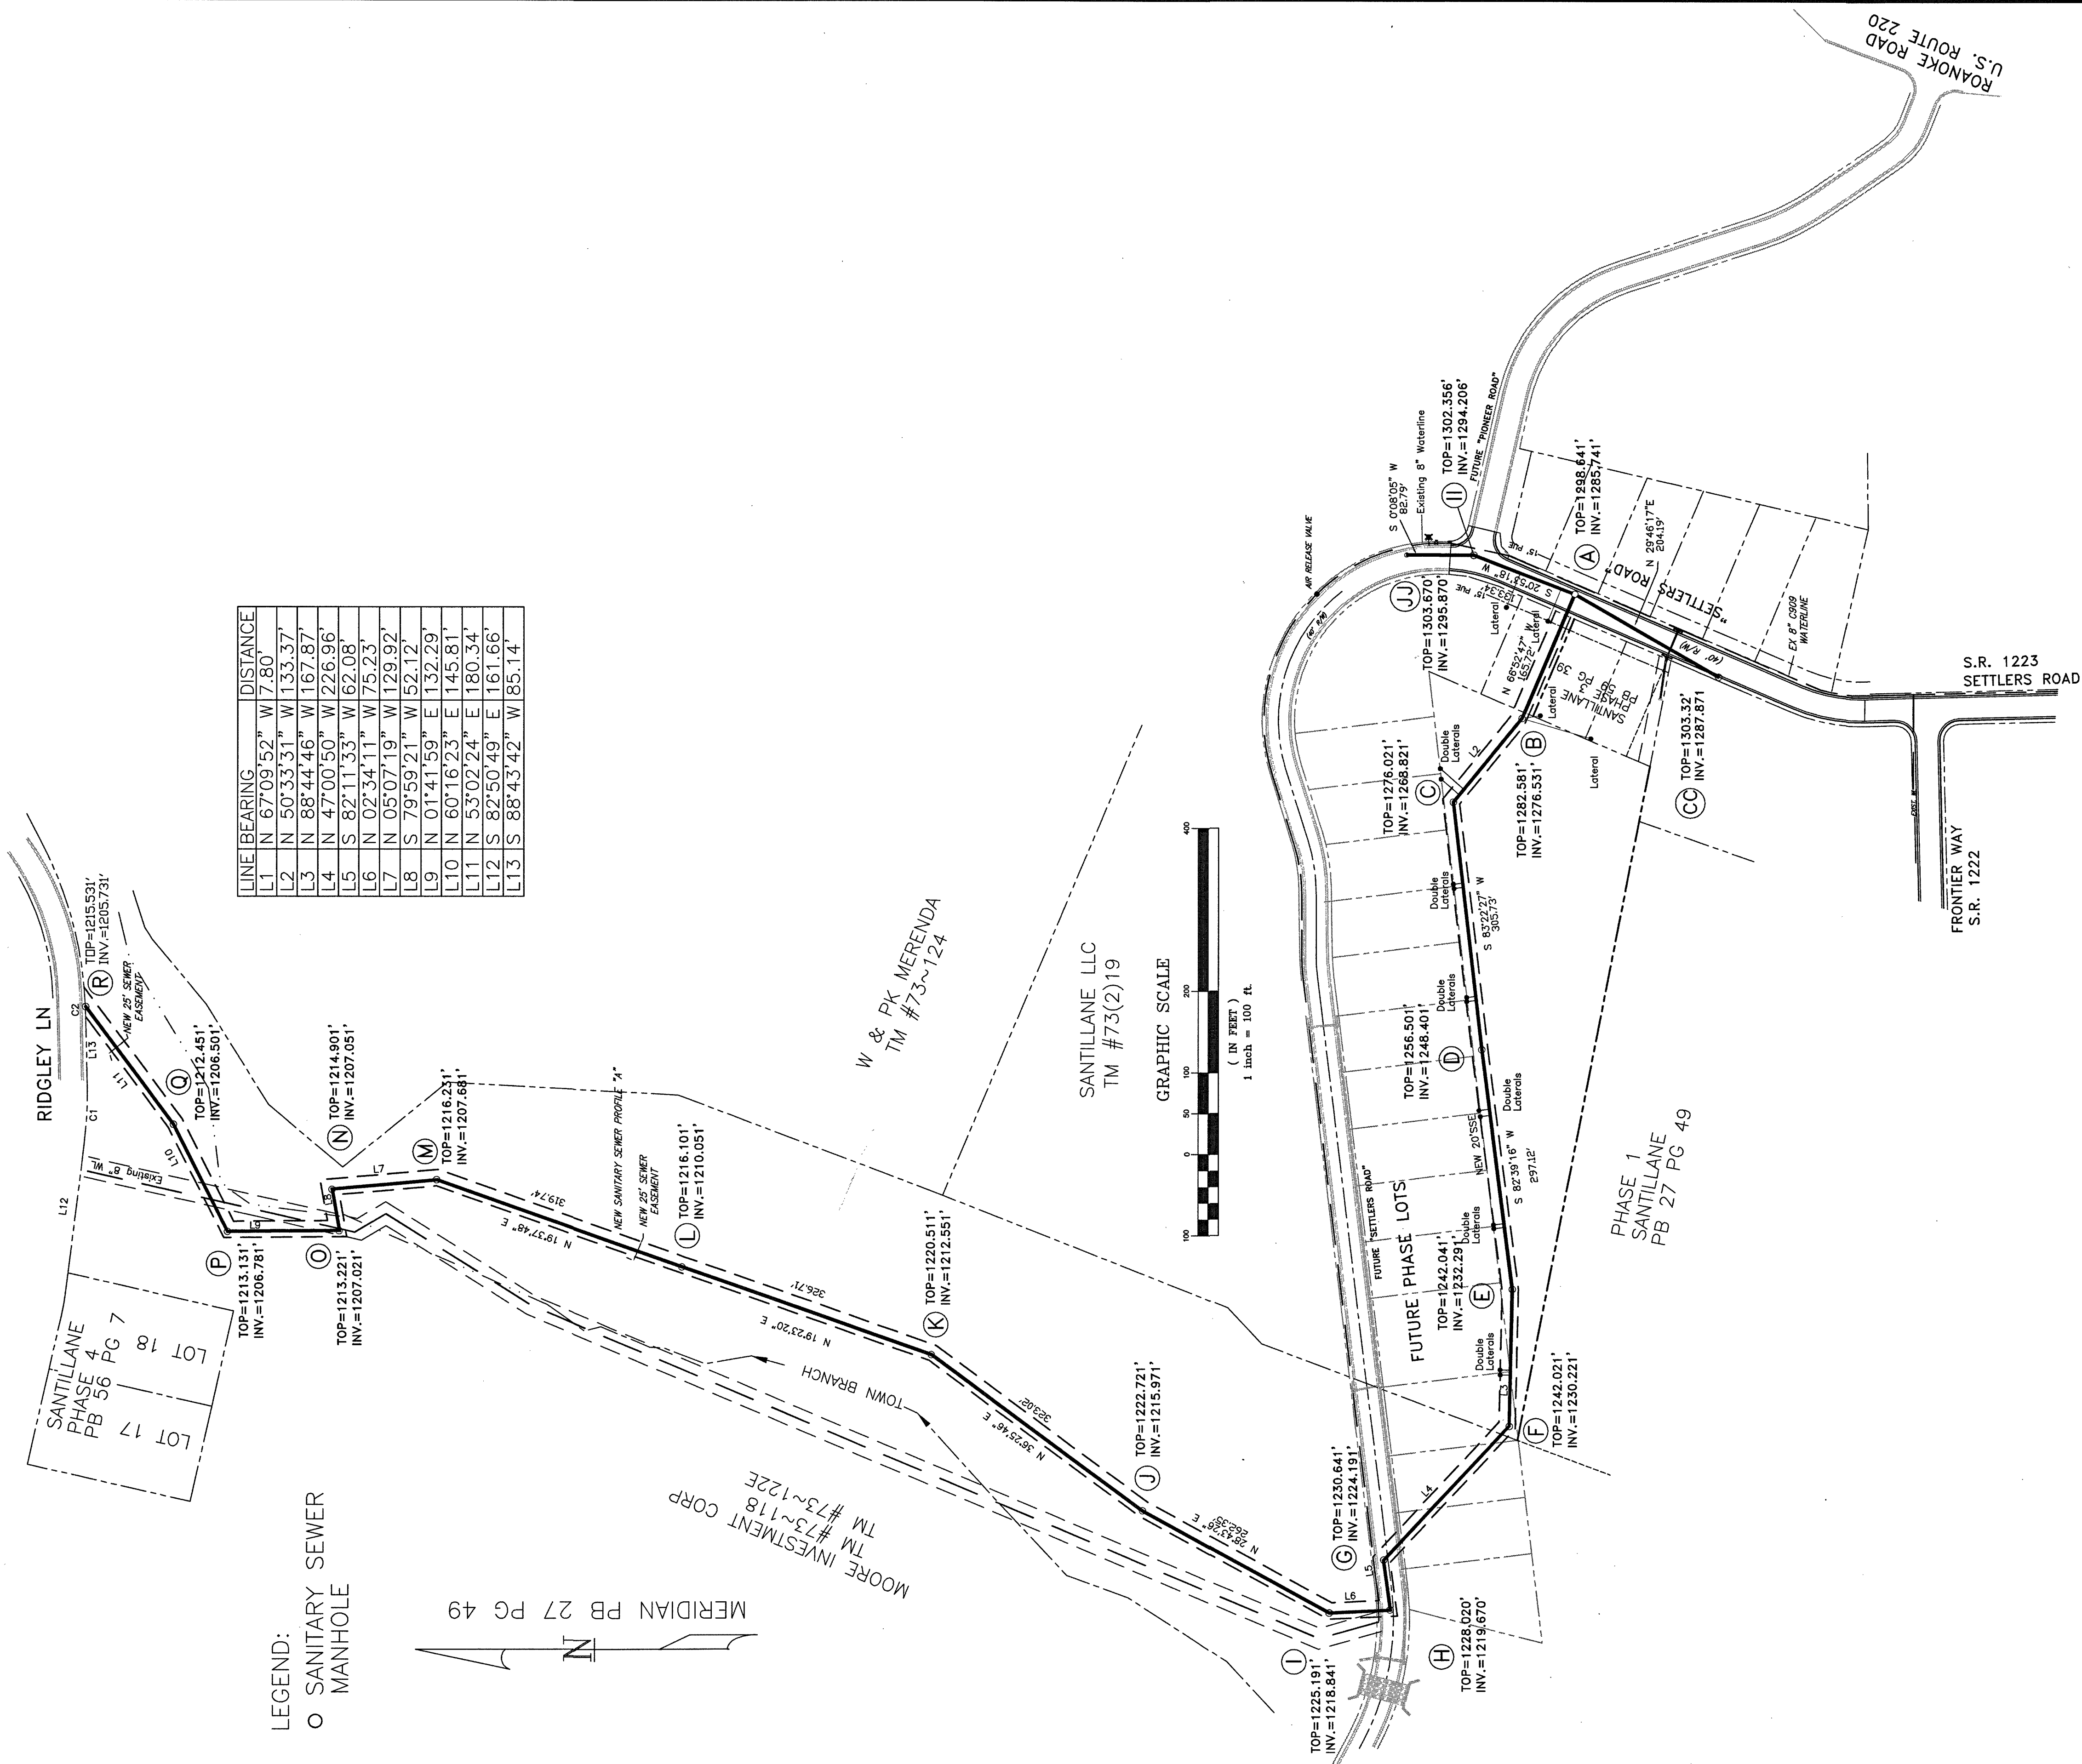


SANITARY SEWER ASBUILTS
SANTILLANE SUBDIVISION
BOTETOURT COUNTY, VIRGINIA

PLAN SHEET

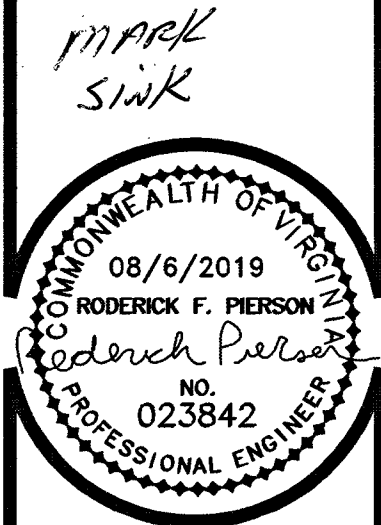

LINE	BEARING	DISTANCE
L1	N 67°09'52" W	7.80'
L2	N 50°33'31" W	133.37'
L3	N 88°44'46" W	167.87'
L4	N 47°00'50" W	226.96'
L5	S 82°11'33" W	62.08'
L6	N 02°34'11" W	75.23'
L7	N 05°07'19" W	129.92'
L8	S 79°59'21" W	52.12'
L9	N 01°41'59" E	132.29'
L10	N 60°16'23" E	145.81'
L11	N 53°02'24" E	180.34'
L12	S 82°50'49" E	161.66'
L13	S 88°43'42" W	85.14'

LEGEND:
O SANITARY SEWER
MANHOLE