


DEVELOPMENT PLANS FOR
SANTILLANE TOWNHOMES
AMSTERDAM MAGISTERIAL DISTRICT
BOTETOURT COUNTY, VIRGINIA

SANTILLANE

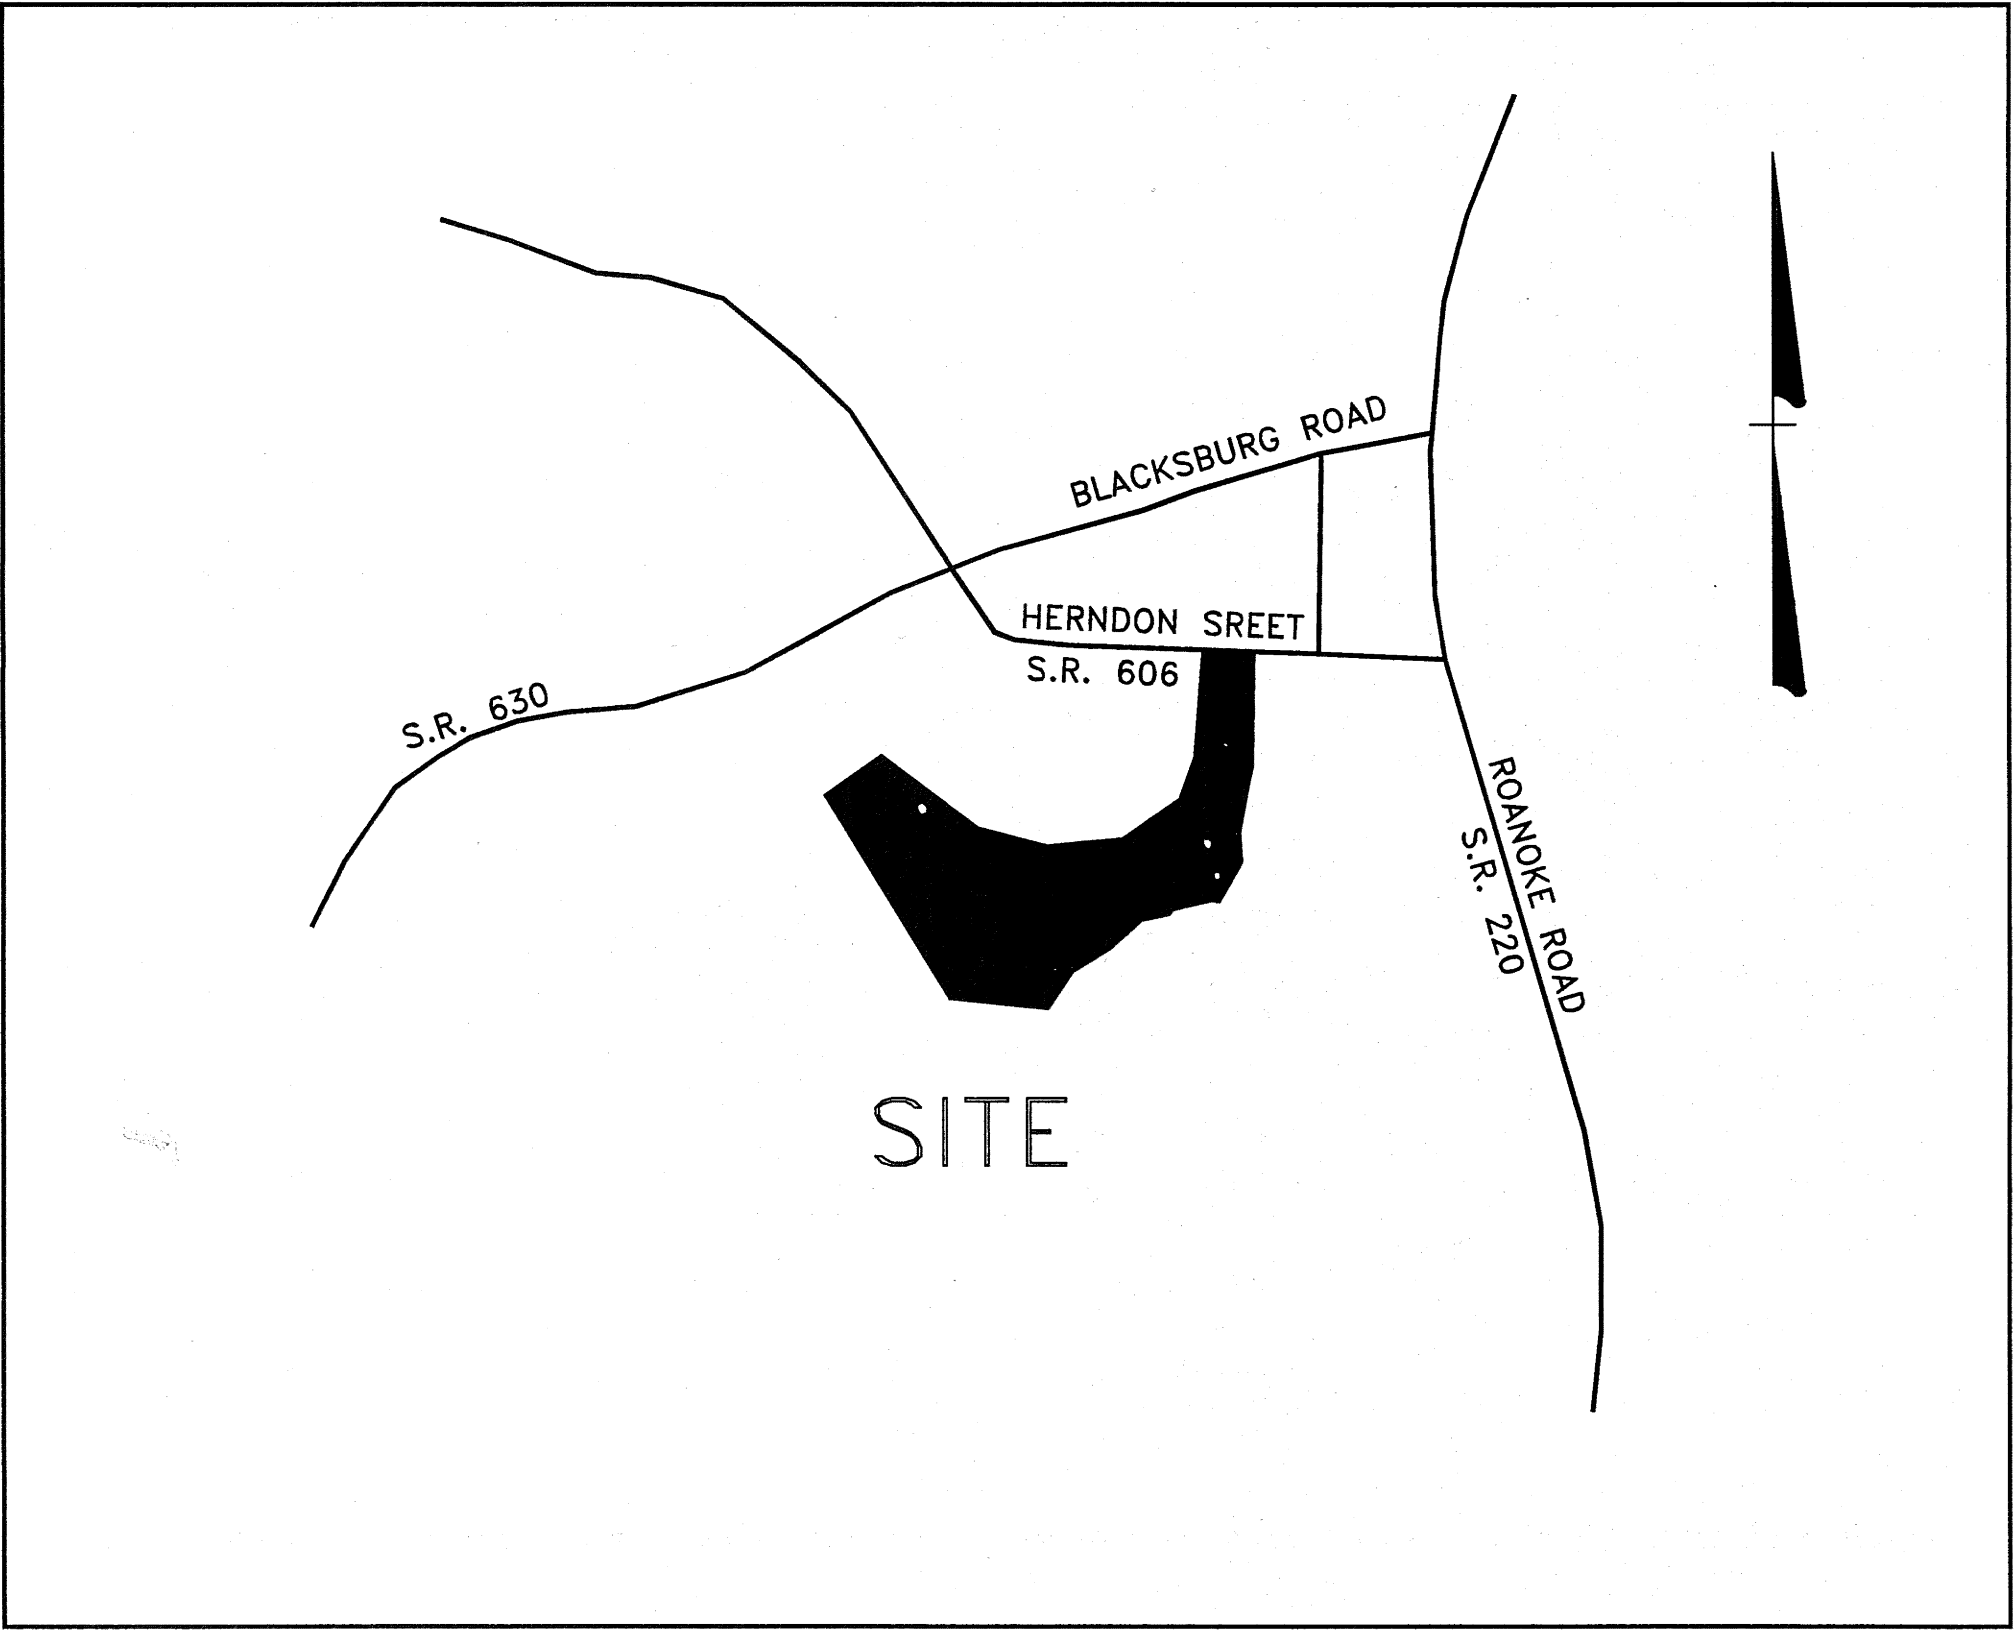

LOCATION MAP

TAX NO. 73-122E AND 118
18 LOT SUBDIVISION


SHEET INDEX

- 1. COVER SHEET
- 2. PLAN SHEET
- 3. GRADING SHEET
- 4. E&S SHEET
- 5. ROADWAY PROFILE SHEET
- 6. ROADWAY PROFILE SHEET & DRAINAGE STRUCTURES
- 7. SEWER PROFILE SHEET
- 8. SEWER PROFILE SHEET
- 9. LIMITS OF CONSTRUCTION SHEET
- 10. CROSS-SECTIONS SHEET
- 10A. CROSS-SECTIONS SHEET
- 11. WATER DETAILS SHEET
- 12. SEWER DETAILS SHEET
- 13. SEWER DETAILS SHEET
- 14. E&S DETAILS SHEET
- 15. ROADWAY SPECIFICATIONS SHEET
- 16. USGS MAP

DEVELOPER:
MOORE INVESTMENT CORPORATION, INC.
P.O. BOX 461
FINCASTLE, VA 24090
540.473.3058

ENGINEER:
PIERSON ENGINEERING & SURVEYING
RODERICK F. PIERSON, LLS, PE
P.O. BOX 311
DALEVILLE, VA 24083
540.966.3027
540.966.5906 fax

REV	DATE	DESCRIPTION

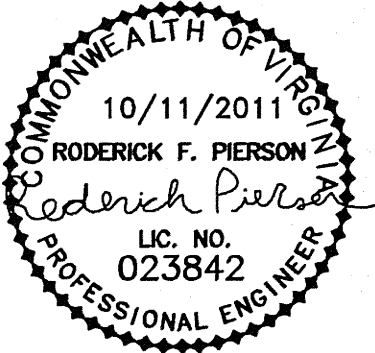

As-Built:
01/08/2014

10/11/2011