



# SHEETZ, INC.

## BOTETOURT COUNTY - DALEVILLE, VIRGINIA

### CATAWBA ROAD & HWY. 220

### REVISED JULY 18, 2018

- ☐ REVIEW/PRELIMINARY
- ☒ APPROVAL/PERMITTING
- ☐ BIDDING/CONSTRUCTION
- ☐ RECORD

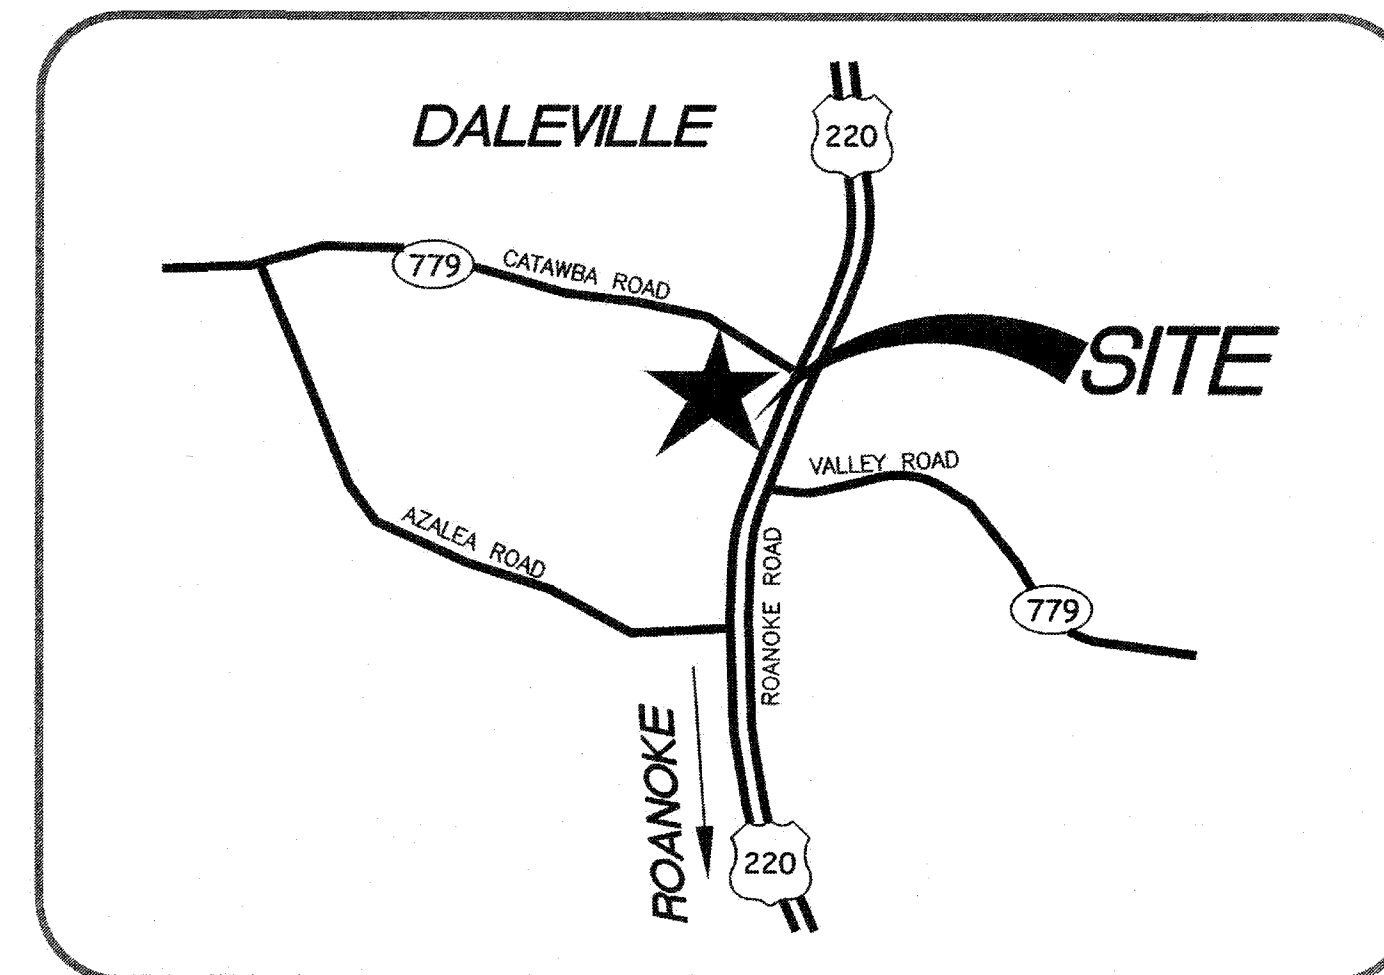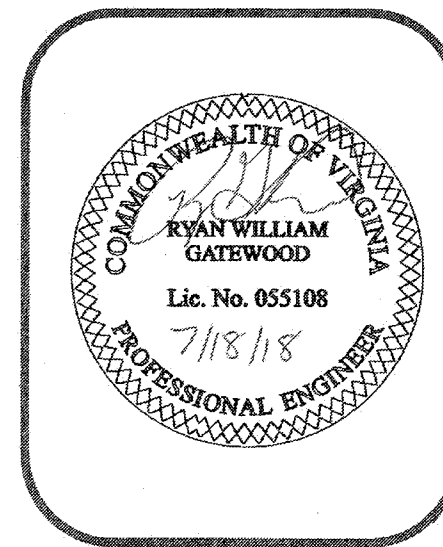

VICINITY MAP

RESPONSIBLE LAND DISTURBER CERTIFICATE  
RLD # \_\_\_\_\_ EXP. DATE \_\_\_\_\_  
NAME: \_\_\_\_\_ NUMBER: (336)-978-1028  
EMAIL: sasmith@sheetz.com

#### CURRENT OWNER:

CONTACTS:  
OWNER - SCOTT FRIEDMAN THE MORGAN COMPANIES (954)-637-2023  
DEVELOPER- SHEETZ INC., SAM SMITH (336) 978-1028  
BOTETOURT COUNTY - DREW T PEARSON, PLANNING & ZONING (540) 928-2080  
WATER SERVICE - MITCH EAKIN (WWWA) (540) 355-1134  
TELEPHONE - ROBERT KELLAM (CENTURY LINK) (276) 666-4294  
CABLE - JUAN ROSARIO GALARCE (COMCAST) (336) 484-1034  
ELECTRIC - TODD ALL (AEP) 1-800-956-4237  
SANITARY SEWER - MITCH EAKIN (WWWA) (540) 355-1134  
GAS SERVICE - BRETT BENNETT (ROANOKE GAS) (540) 777-3971

#### ENGINEERING/SURVEYING SERVICES

#### L E & D PROFESSIONALS P.C.

RYAN GATEWOOD, P.E. - ENGINEER - (434) 792-3680  
G. MARK JOHNSON - PRESIDENT - (434) 792-3680

WESTERN VIRGINIA WATER AUTHORITY: AVAILABILITY LETTER # AL17-152

#### SHEET INDEX

- S1. COVER SHEET
- S2. EXISTING CONDITIONS
- S3. SITE PLAN
- S4. UTILITY PLAN
- S5. STAKEOUT PLAN
- S6. TRUCK ROUTING
- S7. E & S PHASE I
- S8. E & S PHASE II & GRADING PLAN
- S9. GRADING PLAN & SPOT SHOT
- S10. LIGHTING PLAN
- S11. DUMPSTER DETAILS
- S12. CARWASH DETAILS
- S13. SHEETZ STANDARD DETAILS
- S14. SHEETZ STANDARD DETAILS
- S15. E & S DETAILS
- S16. E & S DETAILS
- S17. E & S DETAILS
- S18. E & S DETAILS
- S19. E & S DETAILS
- S20. E & S DETAILS
- S21. STANDARD DETAILS
- S22. STANDARD DETAILS
- S23. STANDARD DETAILS
- S24. STANDARD DETAILS
- S25. PROFFER CONDITIONS
- BUILDING ELEVATIONS - FRONT & REAR
- CAR WASH ELEVATIONS
- CANOPY ELEVATIONS
- DEBORAH M. BROWN - LANDSCAPE ARCHITECTURE
- L1. LANDSCAPING PLAN
- L2. TREE CANOPY STUDY
- L3. LANDSCAPING DETAILS
- RED LEONARD - LIGHTING PLANS & DETAILS
- SH-1 THRU SH-6

**LE&D**  
**PROFESSIONALS, P.C.**

RIVER RUN EXECUTIVE OFFICES  
SUITE-B  
110 EXCHANGE STREET  
DANVILLE, VA. 24541

PHONE NO. (434) 792-3680  
FAX NO. (434) 792-3685  
WEB ADDRESS: [www.landeng.com](http://www.landeng.com)

CHARLES CRUSH  
AS-BUILTS  
07-08-19

AS-BUILTS  
SHEETZ (Bot.)  
C779