

# The Glebe


## Cottage 21

PROPERTY OWNER IDENTIFICATION

1. PROPERTY OWNER:  
VIRGINIA BAPTIST HOMES INC.
2. SUBMITTING ENGINEER:  
ENGINEERING CONCEPTS, INC.  
20 S. ROANOKE ST.  
FINCASTLE, VIRGINIA 24090  
(540) 473-1253  
BOBBY WAMPLER, P.E. – PROJECT ENGINEER

ABBREVIATIONS


O.D.	OUTSIDE DIAMETER	ELEC	ELECTRIC (UNDERGROUND)
MH	MANHOLE	SS	SANITARY SEWER
XING	CROSSING	C.I.	CAST IRON
GPM	GALLONS PER MINUTE	W	WATERLINE
PSI	POUNDS PER SQUARE INCH	WV	WATER VALVE
P.I.V.	POST INDICATOR VALVE	CONC.	CONCRETE
MIN	MINIMUM	INV.	INVERT
ST	STORM DRAIN	V.D.O.T.	VIRGINIA DEPARTMENT OF TRANSPORTATION
VERT.	VERTICAL	TYP.	TYPICAL
HORIZ.	HORIZONTAL	ELEV.	ELEVATION
BLDG.	BUILDING	@	AT
MAX.	MAXIMUM	CL	CENTERLINE
F.F.E.	FINISHED FLOOR ELEVATION	PVC	POLYVINYL CHLORIDE
FIN.	FINISHED	F.H.	FIRE HYDRANT
FDTN.	FOUNDATION	TELE	TELEPHONE
Ø	DIAMETER	H.P.	HIGH POINT
CLR.	CLEARANCE	EXIST/EX	EXISTING
WWF	WELDED WIRE FABRIC	HDPE	HIGH DENSITY POLYETHYLENE
FD	FOUNDATION DRAIN	O.C.	ON CENTER
ADS	ADVANCED DRAINAGE SYSTEM	A.E.	AIR ENTRAINED

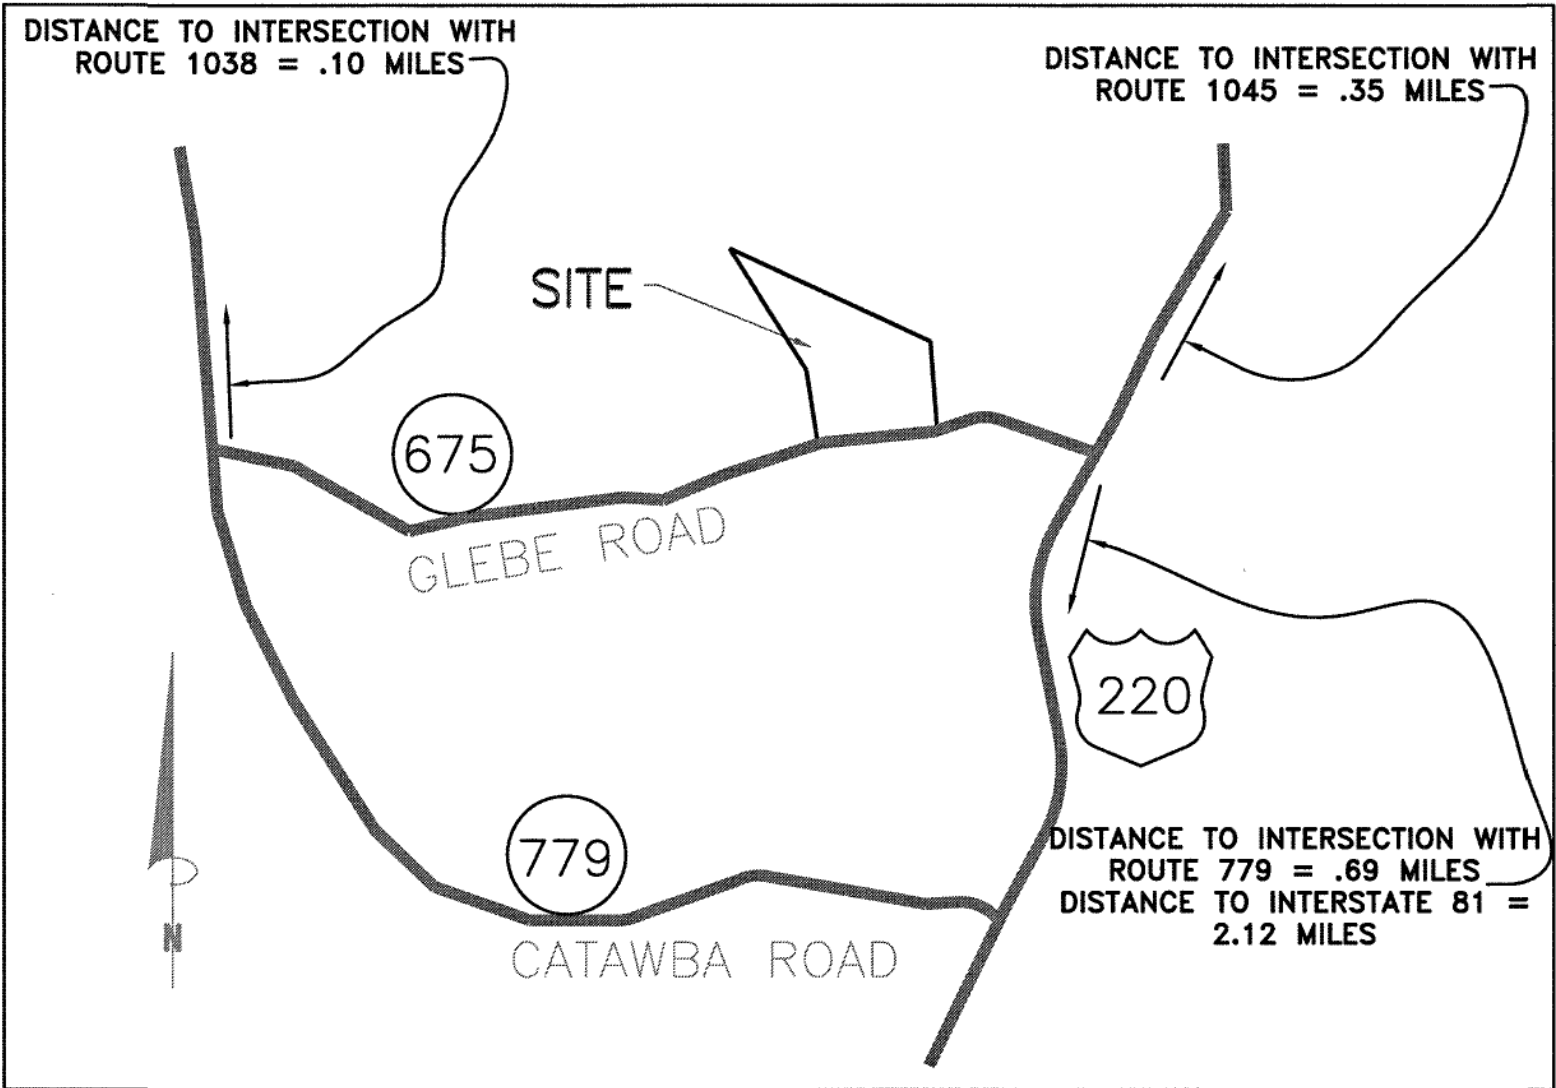

VICINITY MAP  
NO SCALE

SHEET INDEX

- C1 COVER SHEET
- C2 GENERAL NOTES
- C3 SITE DIMENSIONAL AND UTILITY PLAN
- C4 GRADING PLAN
- C5 DRAINAGE MAP
- C6 EROSION & SEDIMENT CONTROL PLAN
- C7 DETAILS

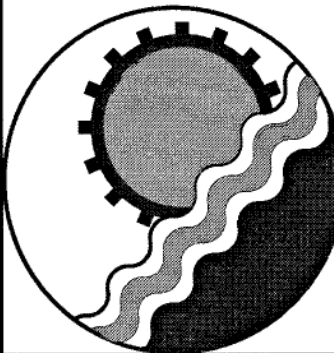

ENGINEERING CONCEPTS, INC.

20 S. ROANOKE ST., PO BOX 619  
FINCASTLE, VIRGINIA 24090  
540.473.1253 FAX: 540.473.1254

As-Built 10/04/2016

Drawn msmJ	COVER SHEET COTTAGE ADDITION – 21	SCALE: NONE
Designed ECI		DATE: SEP. 21, 2016
Checked RHW	"THE GLEBE" BOTETOURT COUNTY – VIRGINIA	PROJECT: 16064
Approved RHW		C1

