

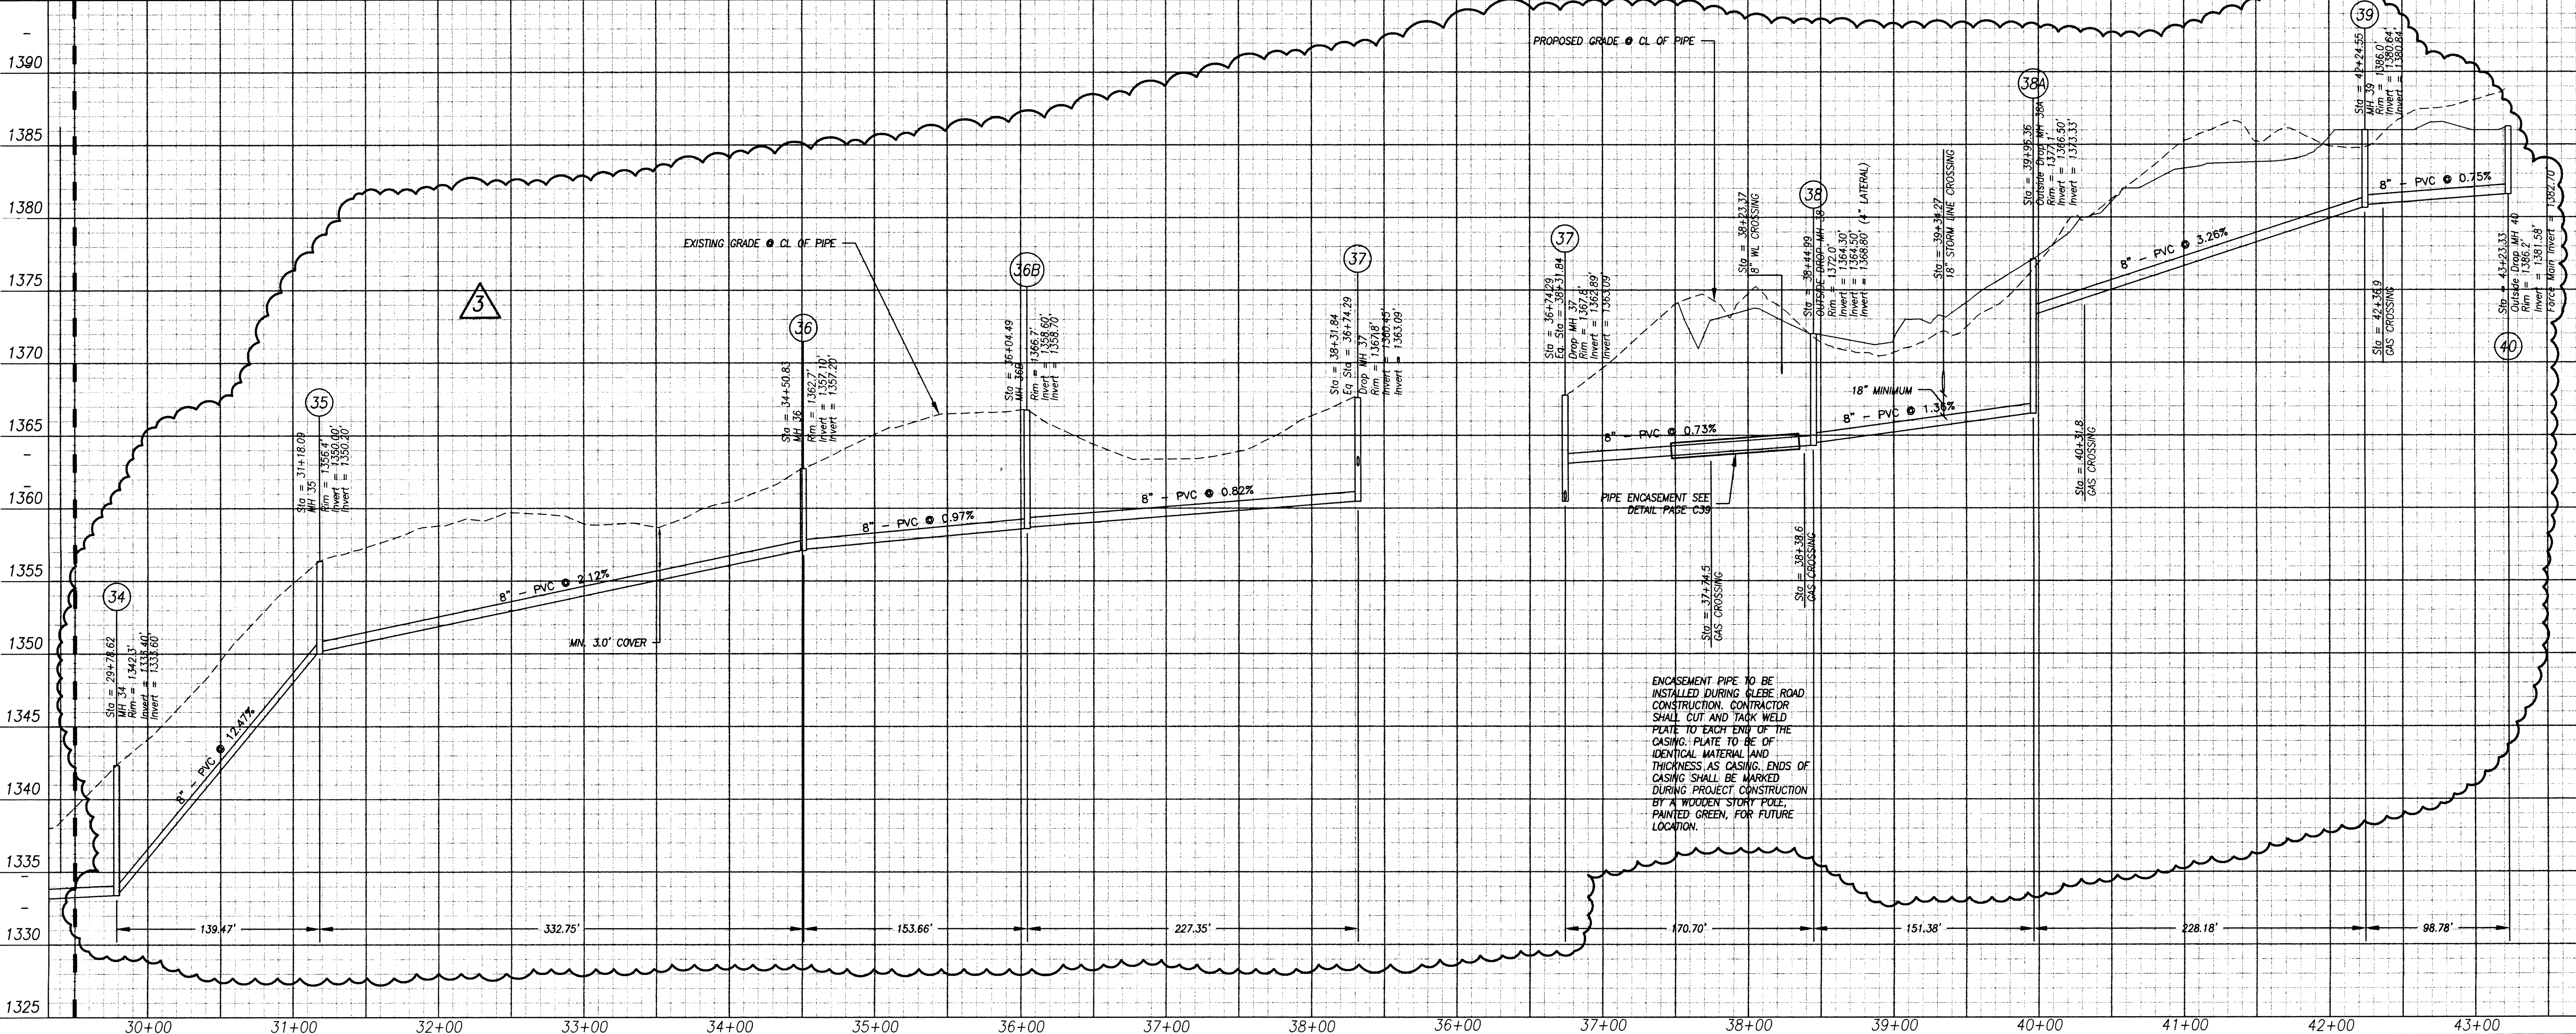


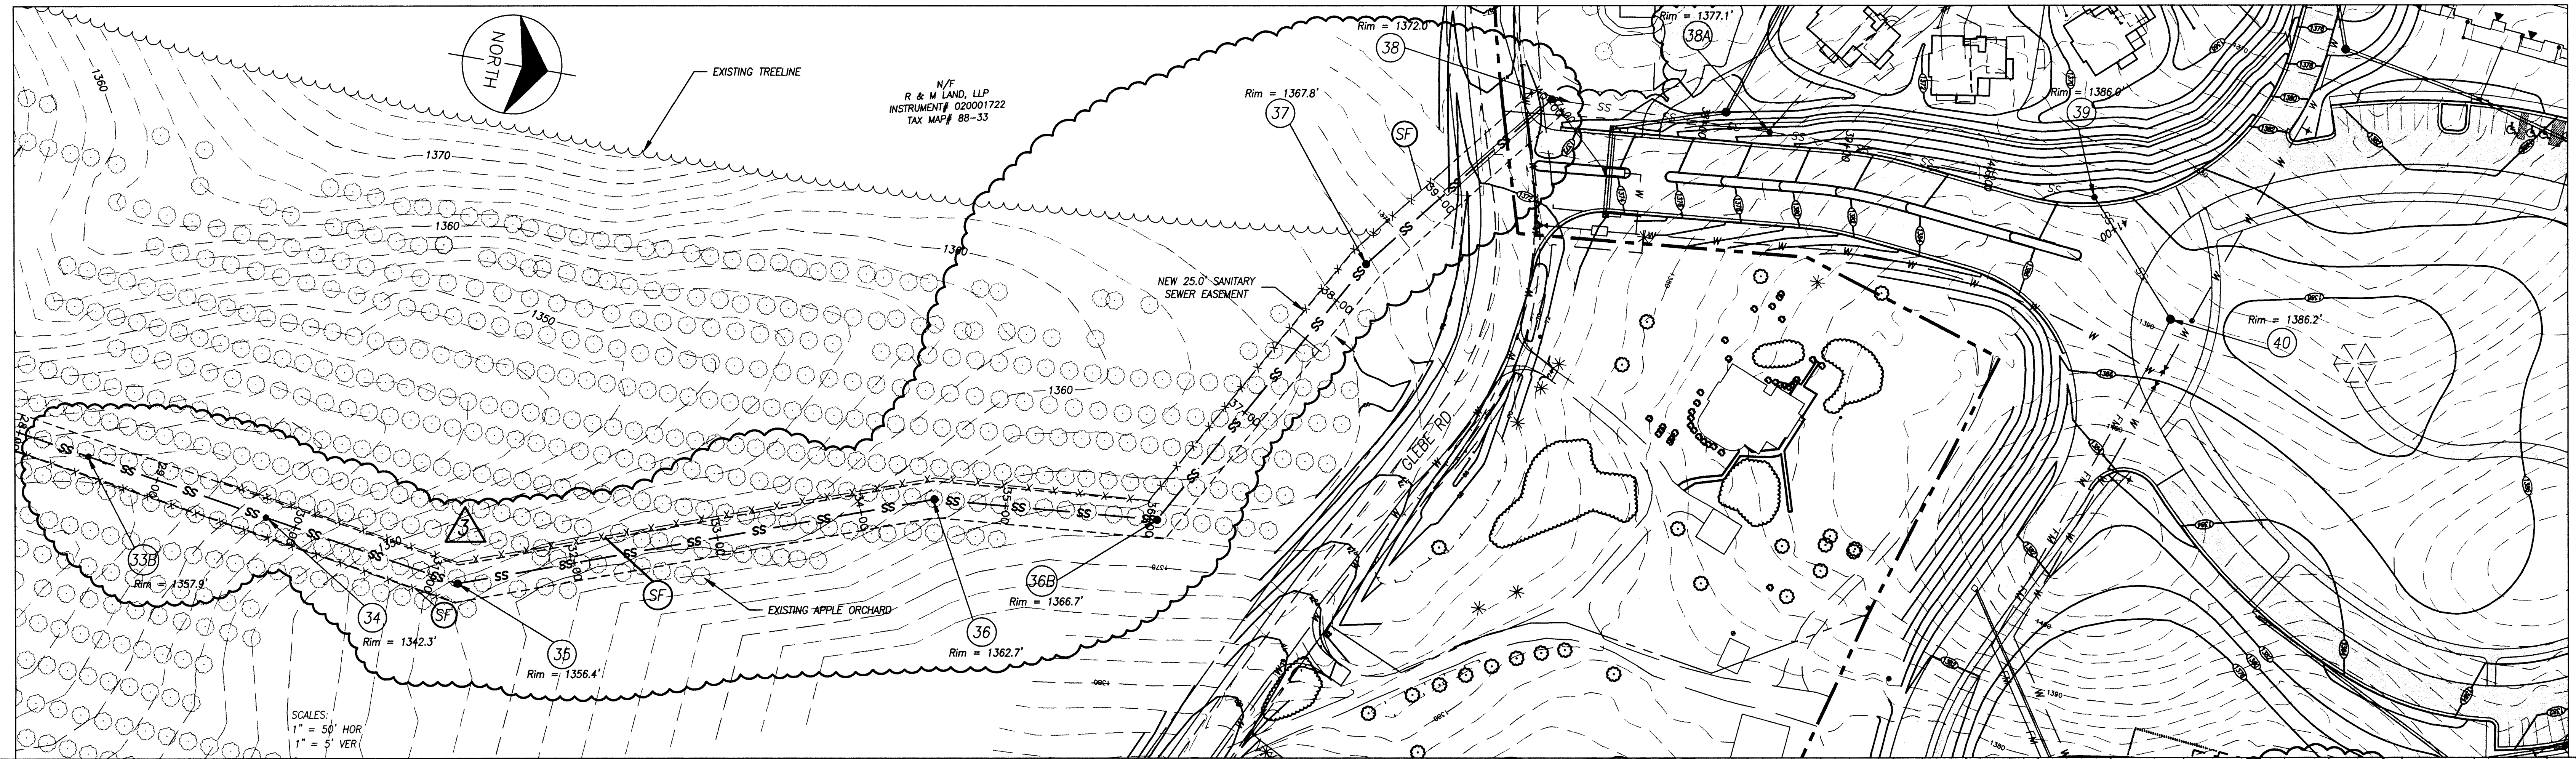



NOTE:
EXCAVATED MATERIAL SHALL BE
ADDED ON THE UPHILL SIDE OF THE
INSTALLED TRENCH. SILT FENCE
SHALL BE ON THE DOWNHILL SIDE
OF THE TRENCH.

KEYPLAN

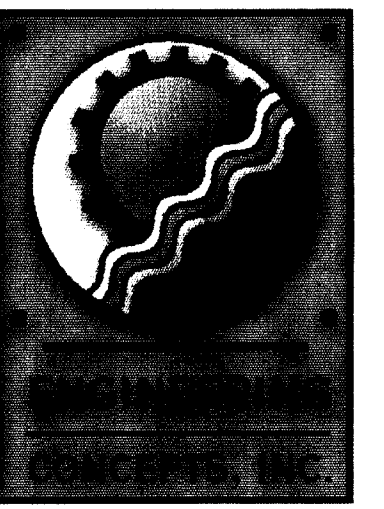

20 South Roanoke St.
Fincastle, Virginia 24090
540.473.1253 540.473.1254 (Fax)
email@engineeringconcepts.com
ECI PROJECT #02019

GENERAL NOTES

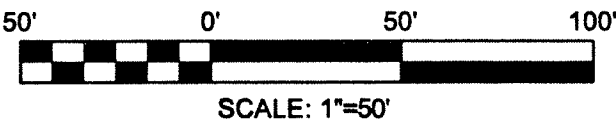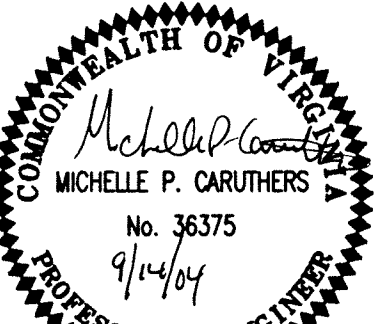

PROJECT TITLE

The Glebe

SFCS Architecture
Engineering
Planning
Interiors
SFCS Inc. • 305 South Jefferson Street
Roanoke, Virginia 24011.2003
540.344.6664 • Fax 540.343.6925
www.sfcs.com

PROJECT DESIGNER	: SFCS
PROJECT ARCHITECT	: SFCS
PROJECT ENGINEER	: ECI
DRAWN BY	: ECI
CHECKED BY	: ECI
APPROVED BY	: ECI
NO.	REVISION DESCRIPTION DATE
1	BOT CO REQUESTED CHANGES 9/4/03
2	REVISIONS PER BOT. CO. 11/12/03
3	REVISIONS SEWER ALIGNMENT 09/14/04

DRAWING TITLE
**OFFSITE GRAVITY
SANITARY SEWER
PLAN & PROFILE**

COMM. NO.	DATE
#715.00	11/12/03
DRAWING	SHEET

C43

43 OF 43