


THIS DRAWING PREPARED AT THE
CHARLOTTEVILLE OFFICE
608 Preston Avenue, Suite 200 | Charlottesville, VA 22903
TEL 434.295.5624 FAX 434.295.8317 www.tlmmost.com

YOUR VISION ACHIEVED THROUGH OURS.

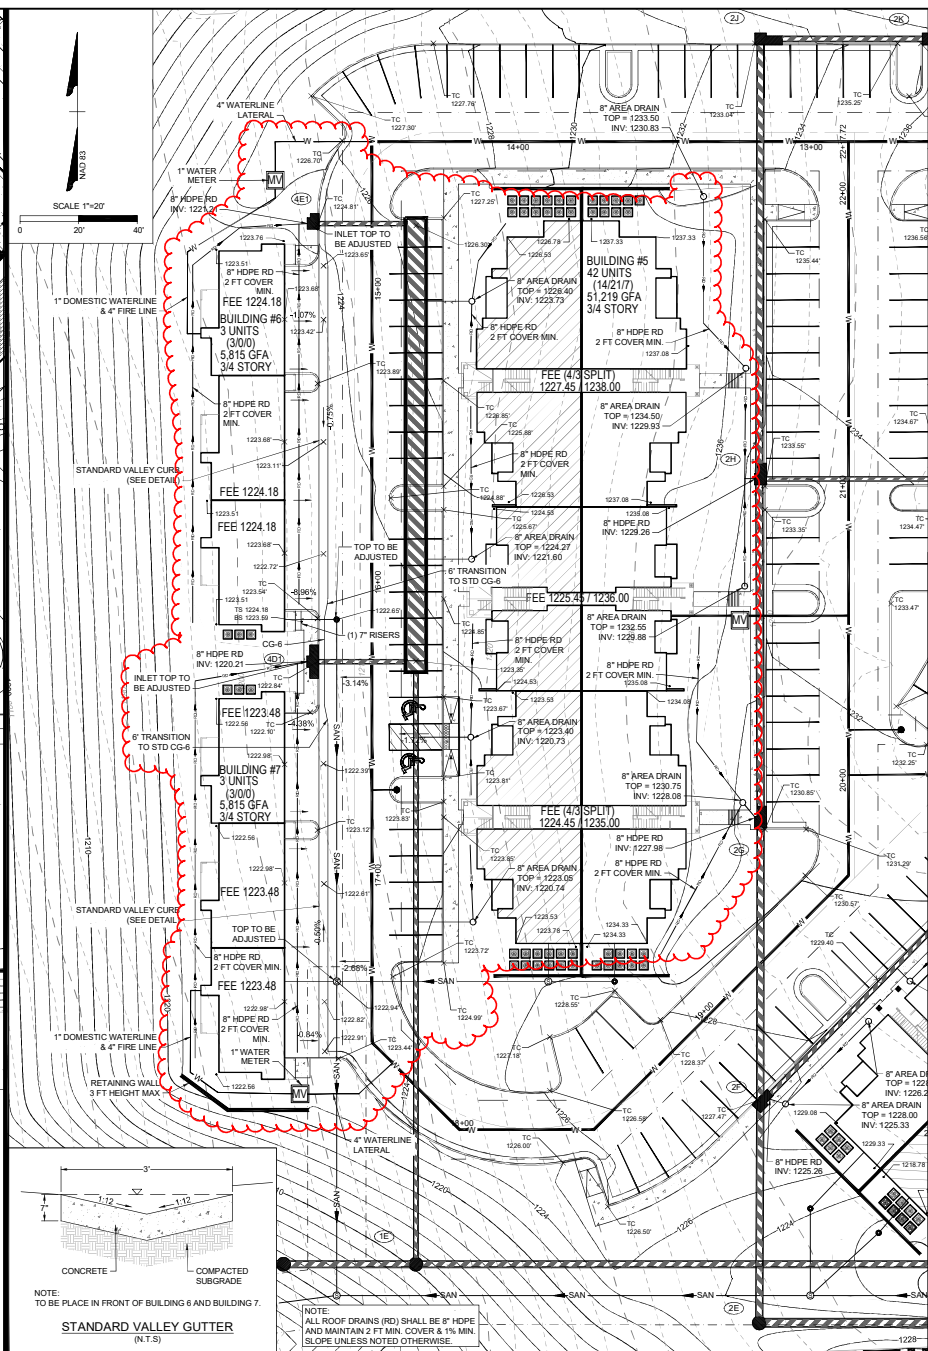

PRO

GSL

NO

JOB NO. 40062	THE RESERVE AT DALEVILLE BOTETOURT COUNTY, VA FIELD CHANGE #3 - BUILDINGS 1-7 GRADING, WATERLINE & ROOF DRAIN
SHEET NO. FC3.2	

These plans and associated documents are the exclusive property of TIMACONS GROUP and may not be reproduced in whole or in part and shall not be used for any purpose whatsoever, inclusive, but not limited to construction, bidding, and/or construction taking without the express written consent of TIMACONS GROUP.