
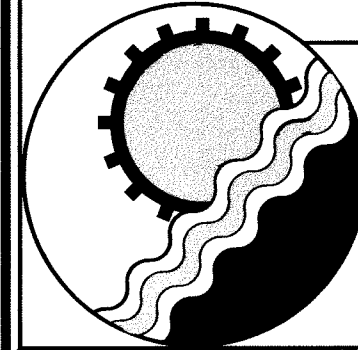
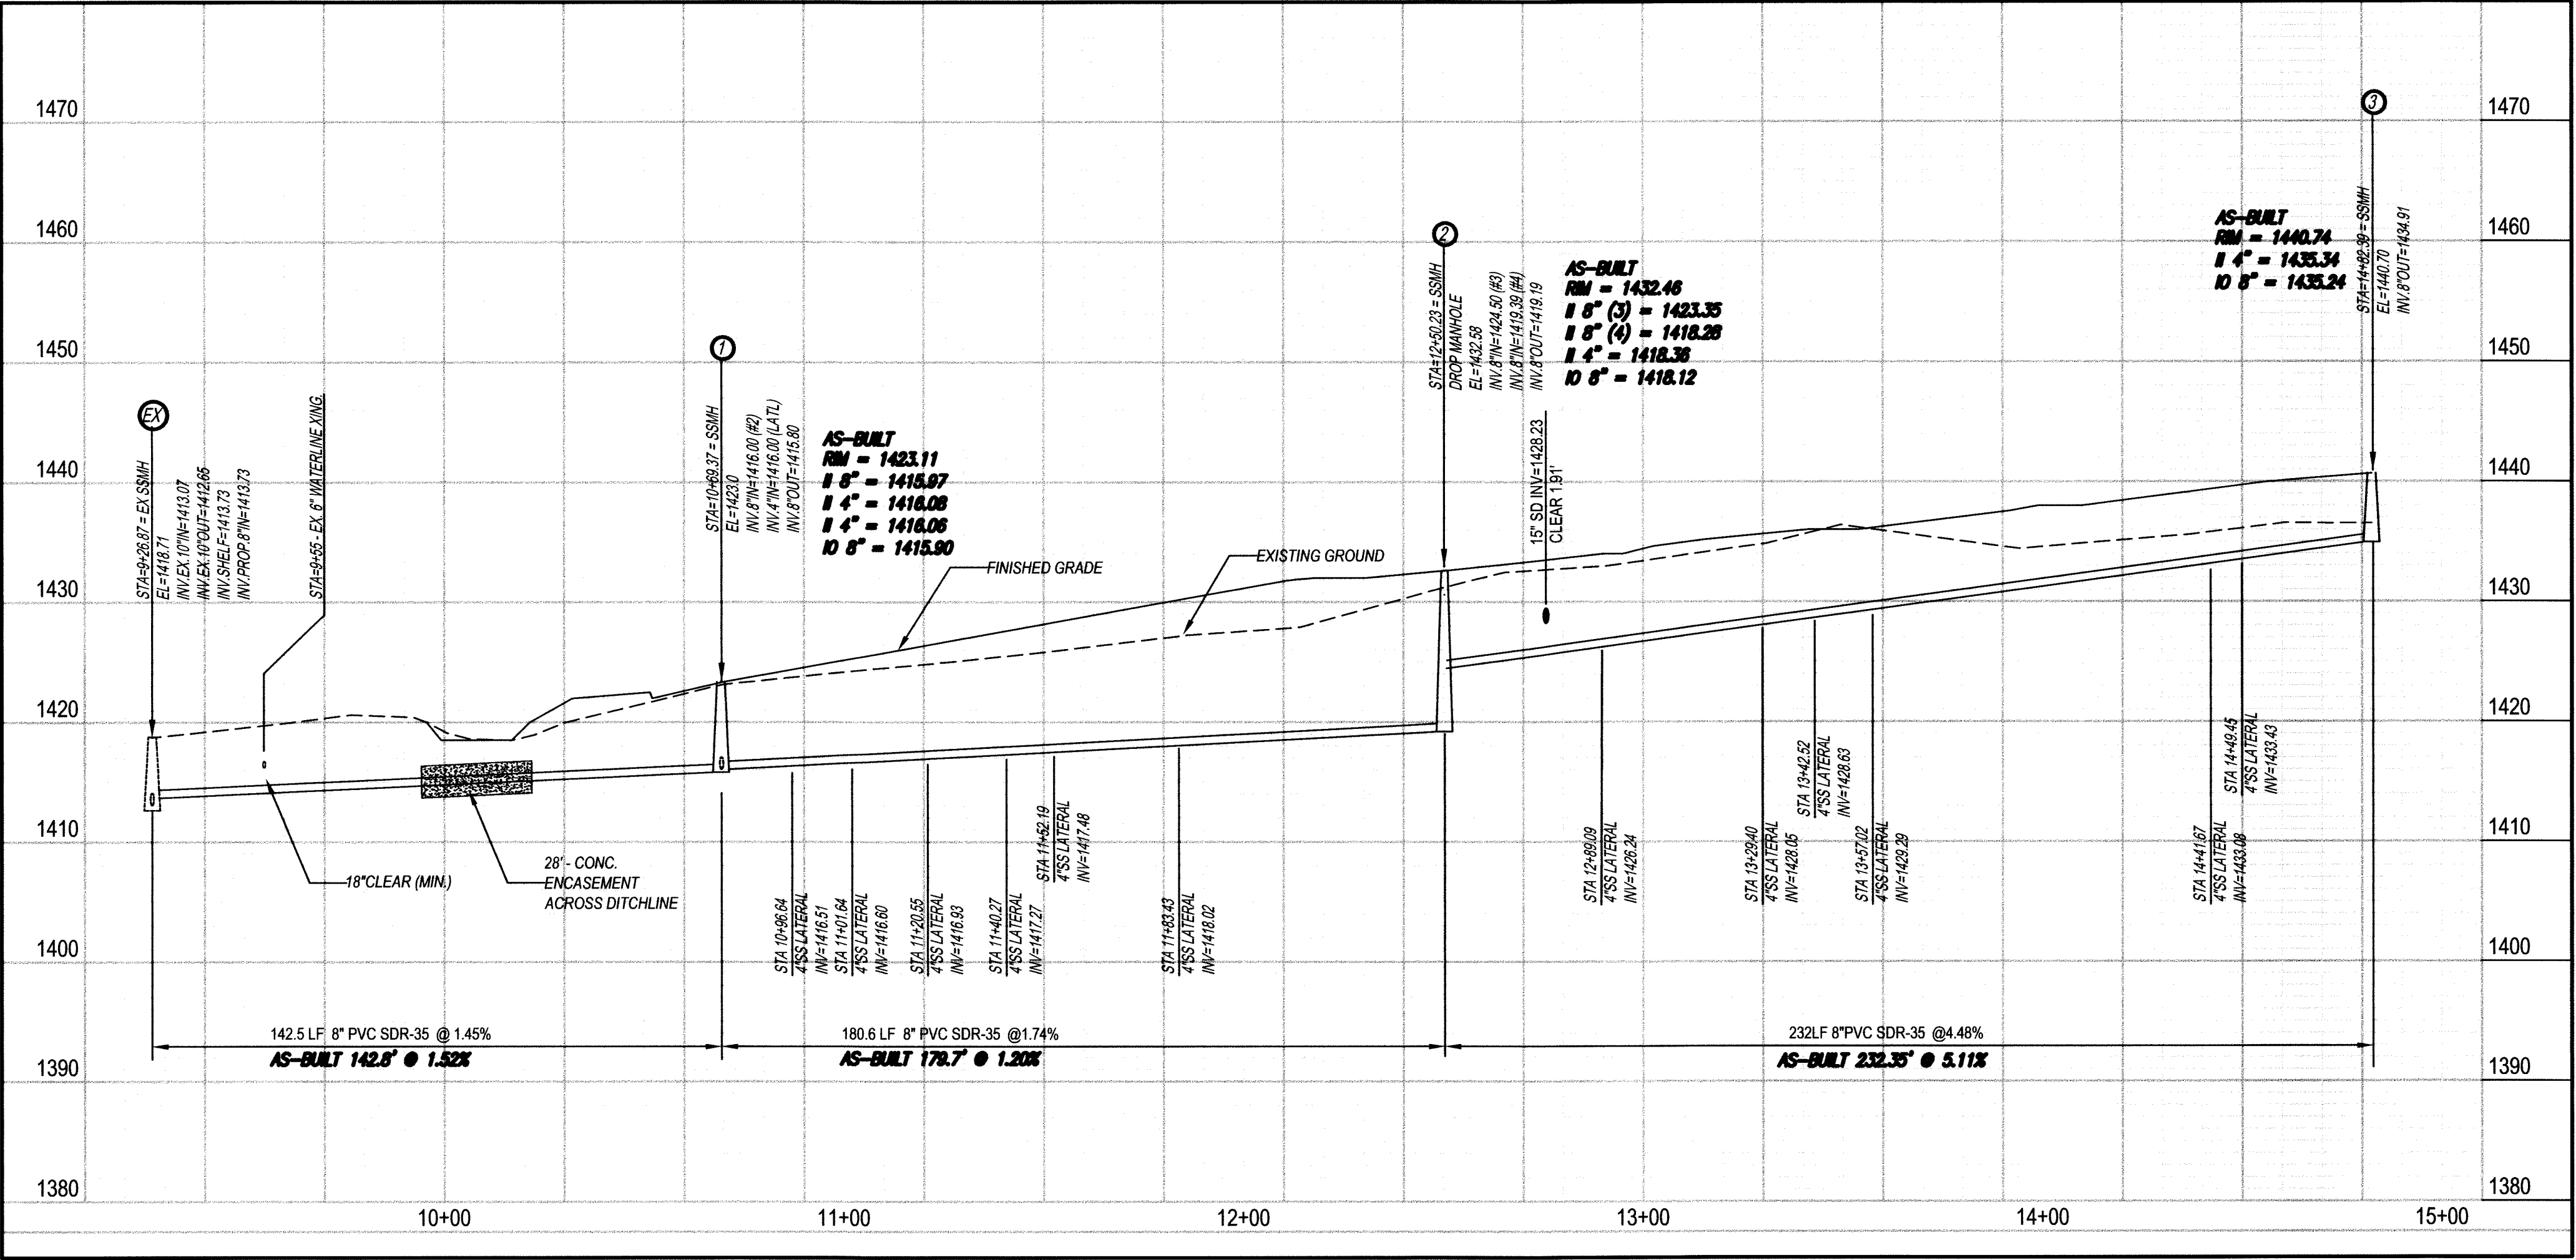


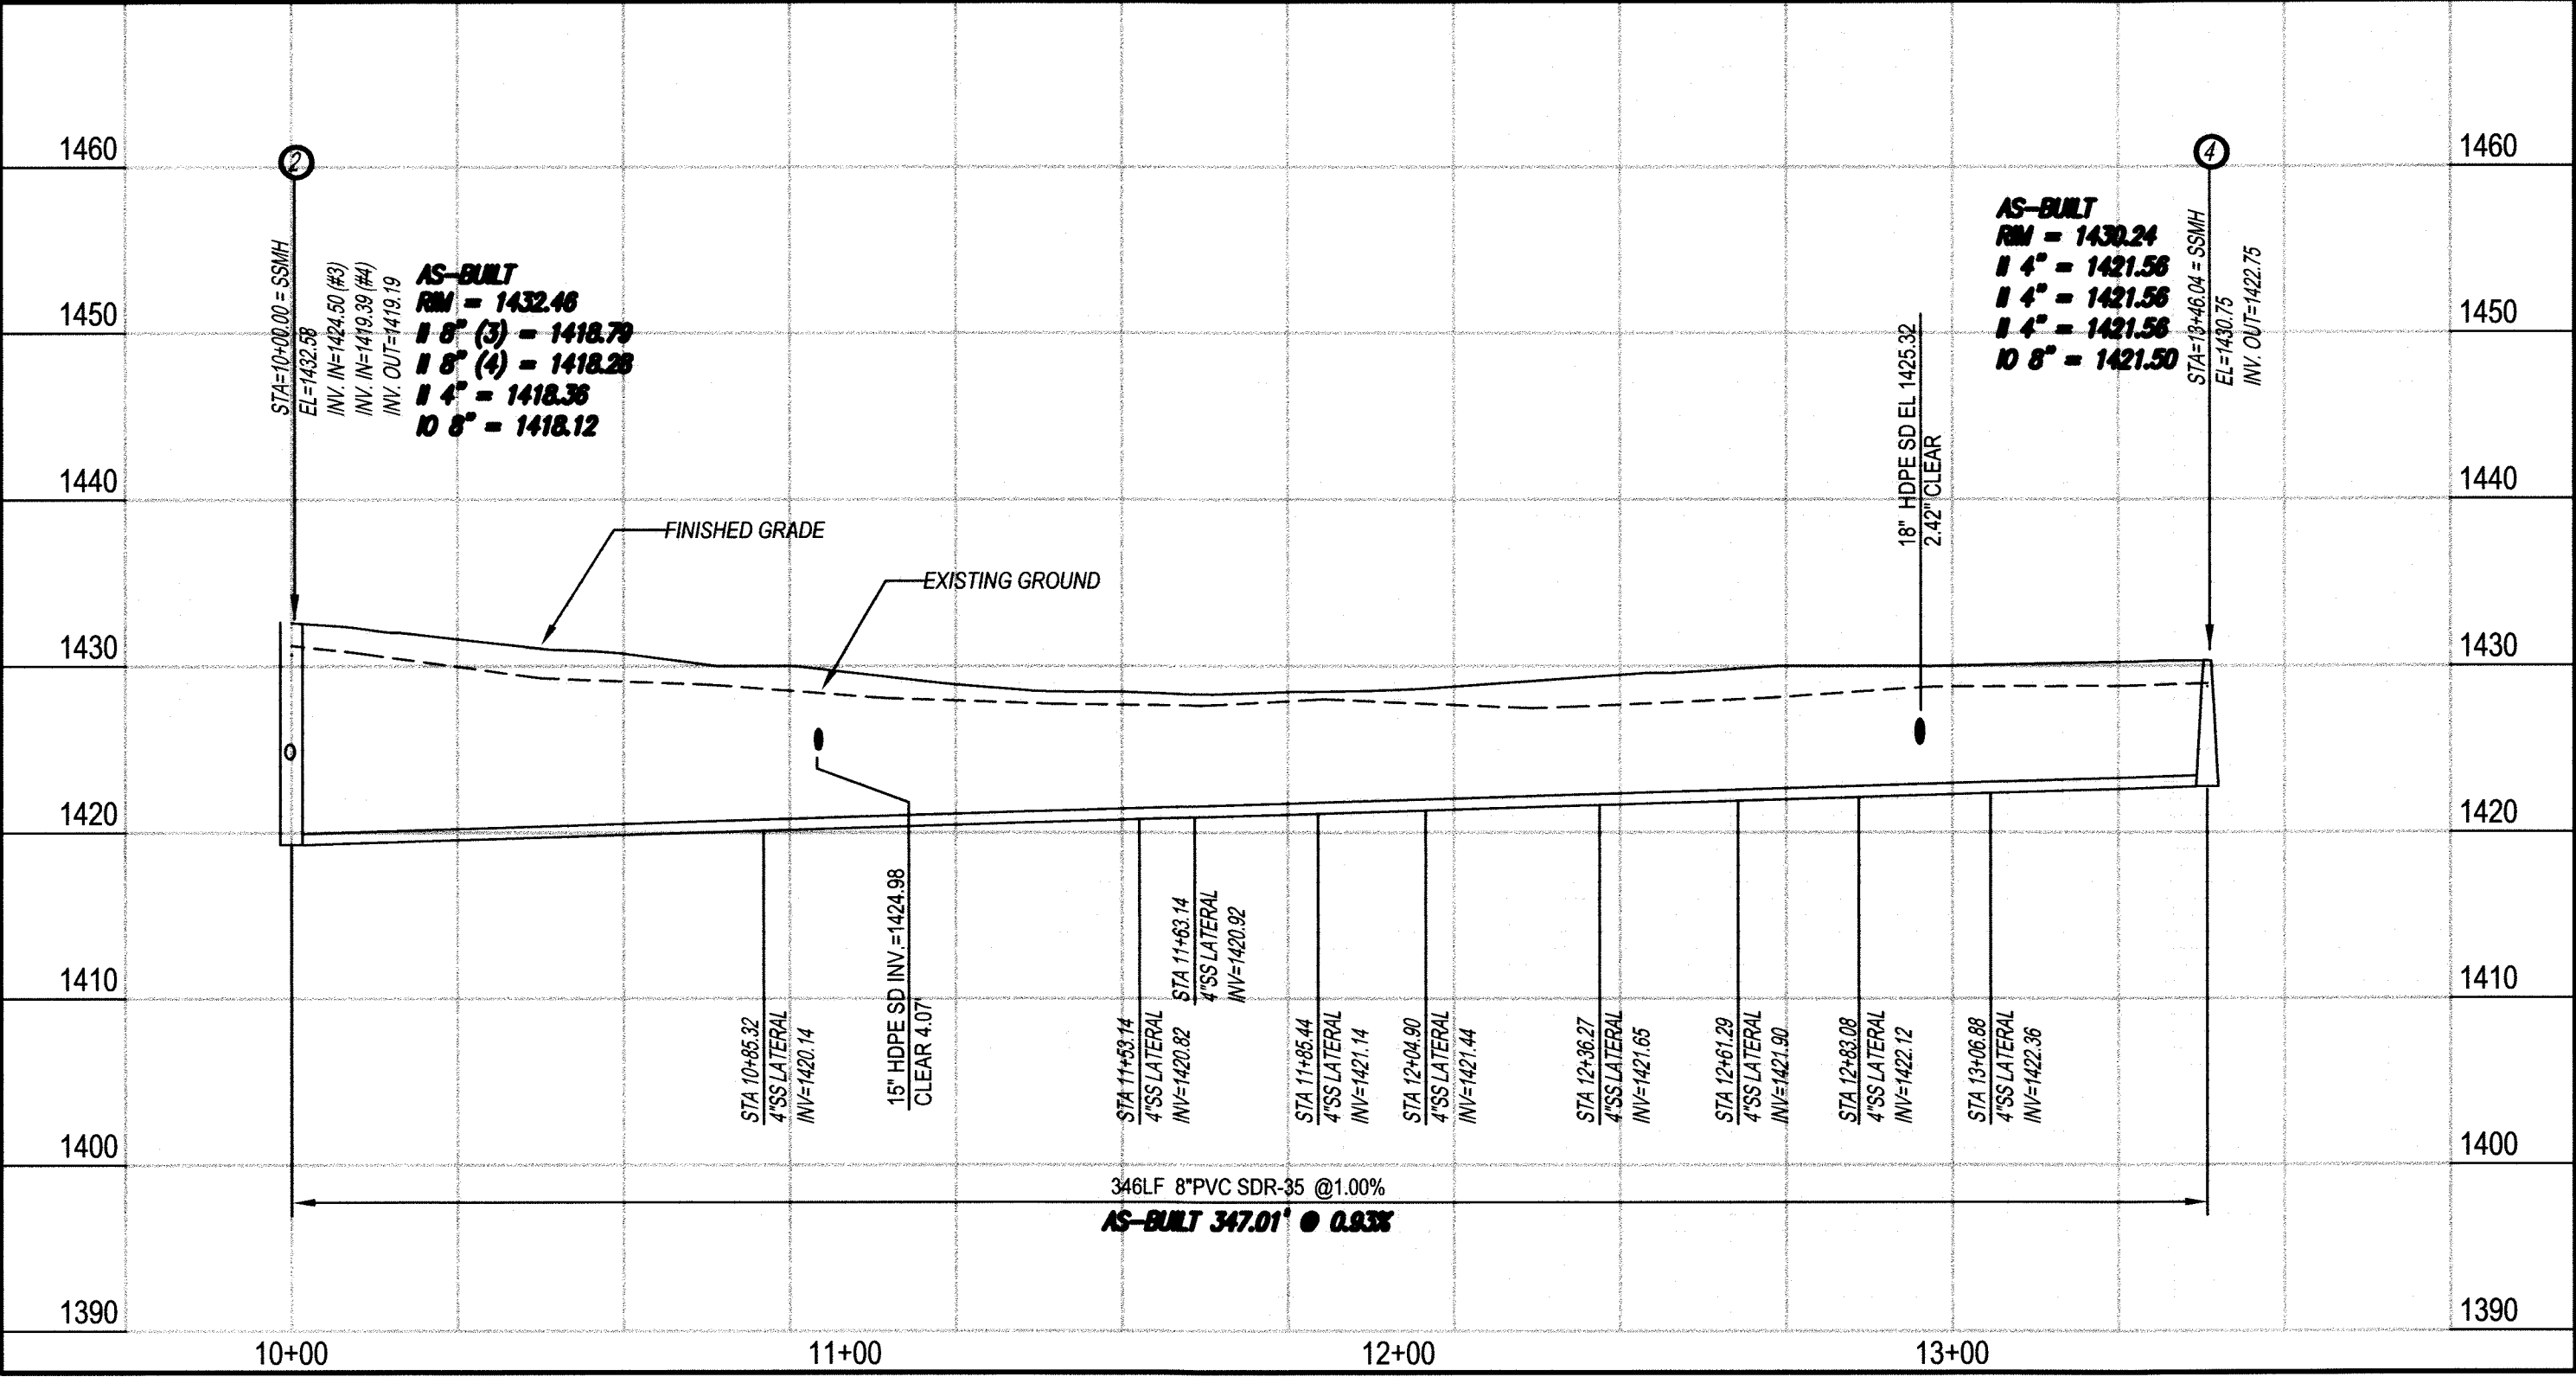

ENGINEERING CONCEPTS, INC.
20 S. ROANOKE ST., PO BOX 619
FINCASTLE, VIRGINIA 24090
540.473.1253 FAX: 540.473.1254

AS-BUILT

Drawn MSMJ/RHW	BERKLEY COMMONS BOTETOURT COUNTY, VIRGINIA SANITARY SEWER PROFILES	SCALE: H:1"=30' V:1"=10'
Designed MSMJ/RHW		MAY 2003
Checked RHW/HTB		PROJECT: 00023
Approved HTB		8 of 10