



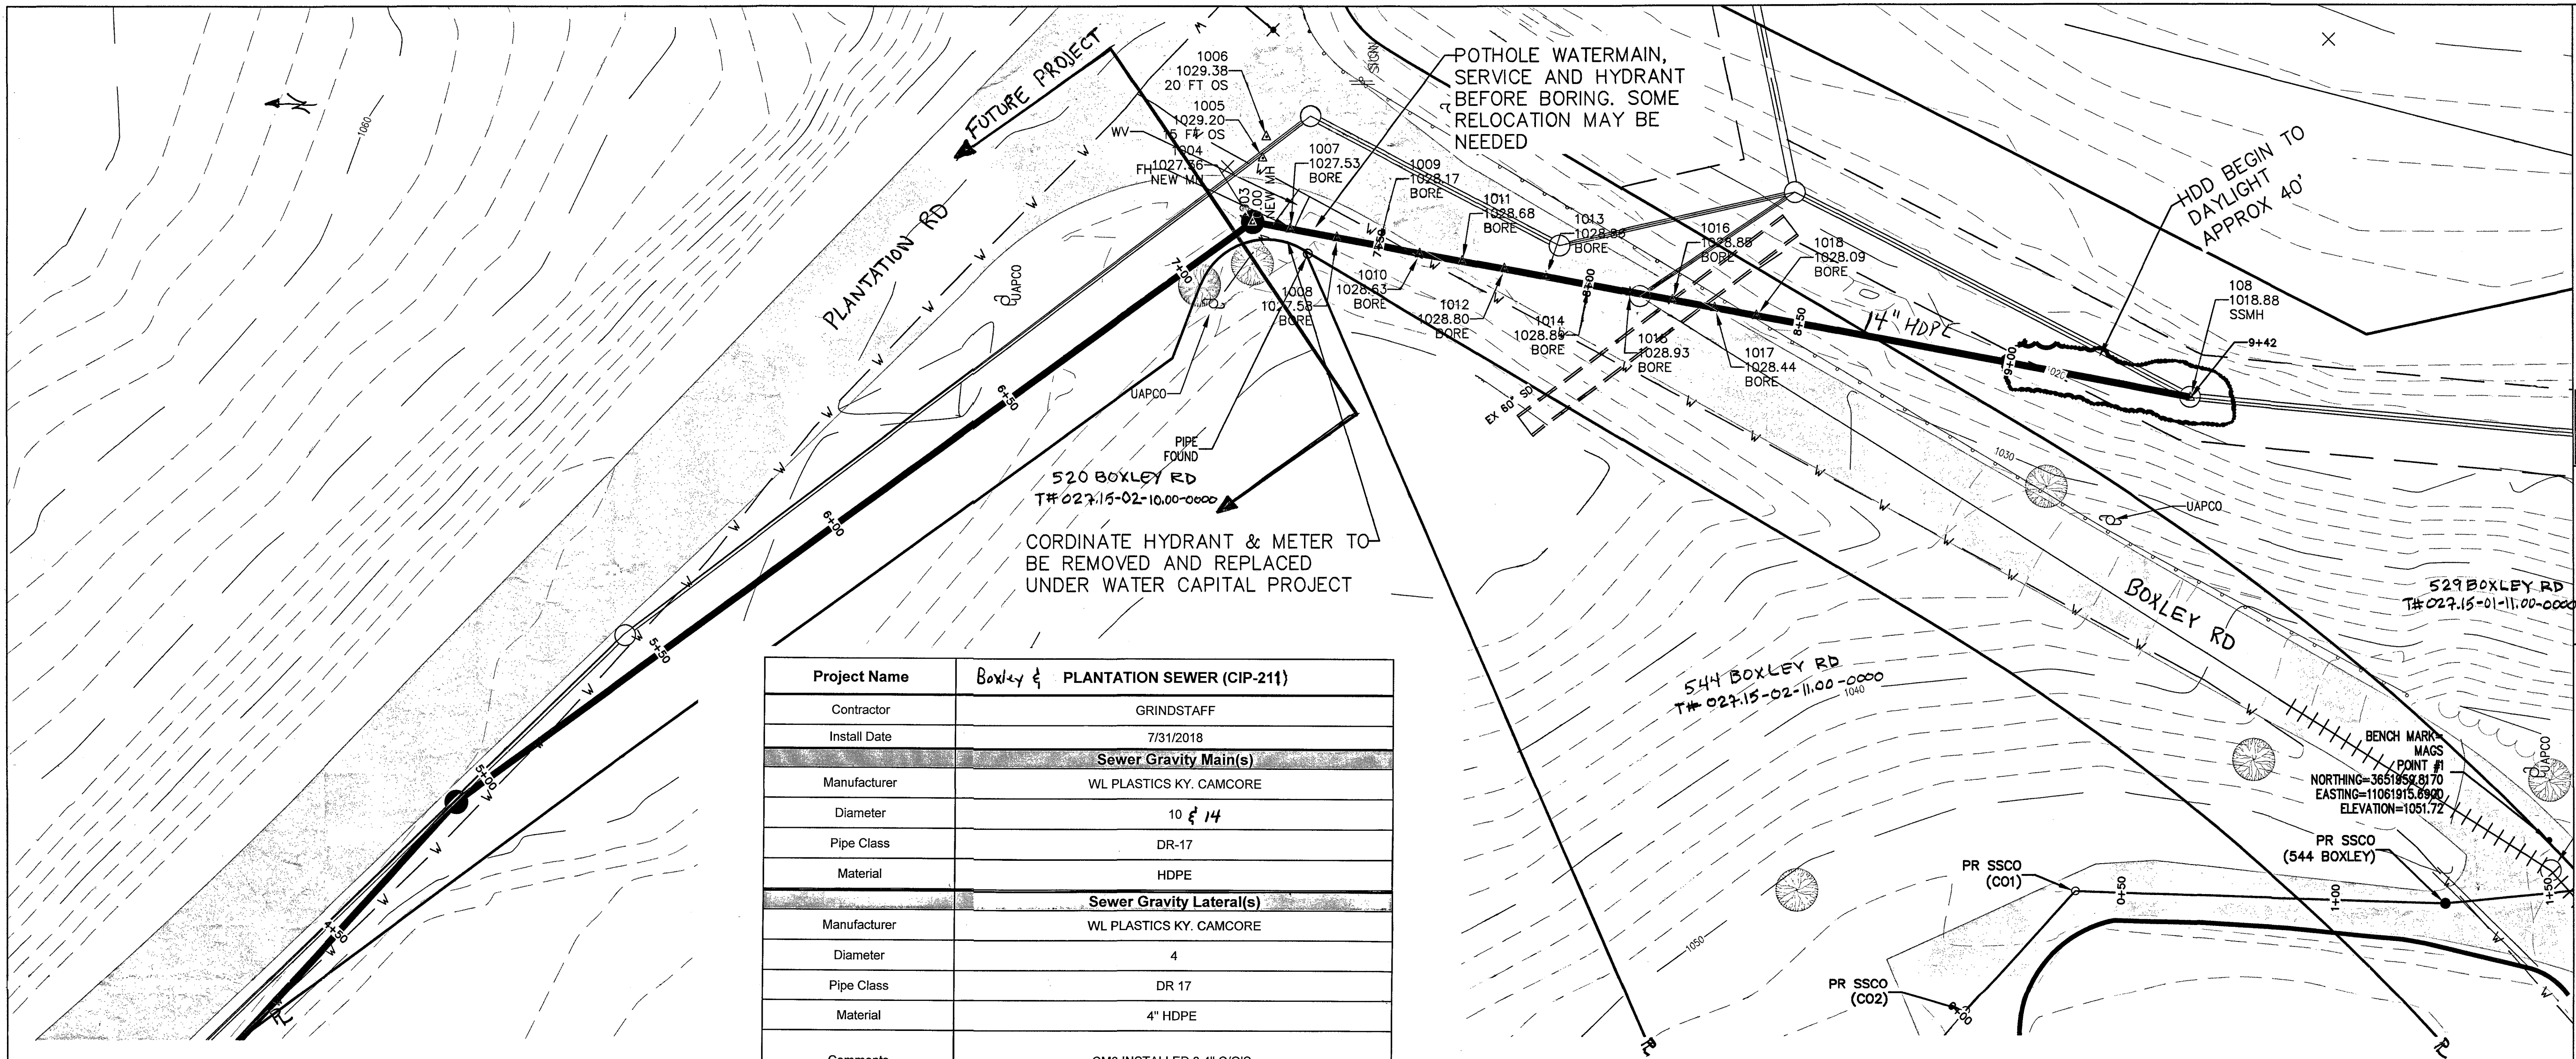

Project Name	Boxley & PLANTATION SEWER (CIP-211)
Contractor	GRINDSTAFF
Install Date	7/31/2018
Sewer Gravity Main(s)	
Manufacturer	WL PLASTICS KY. CAMCORE
Diameter	10 & 14
Pipe Class	DR-17
Material	HDPE
Sewer Gravity Lateral(s)	
Manufacturer	WL PLASTICS KY. CAMCORE
Diameter	4
Pipe Class	DR 17
Material	4\" HDPE
Comments	CM3 INSTALLED 3 4\" C/O'S
Sewer Manhole(s)	
Manufacturer	CSI
Material	PRE-CAST
Ring & Cover Manuf.	
Cover Type	WWA STANDARD FRAMES / H20 TIGHT COVERS
Comments	CM3 INSTALLED MH.04C-4050, MH. 04C-4051,MH. 04C-4052

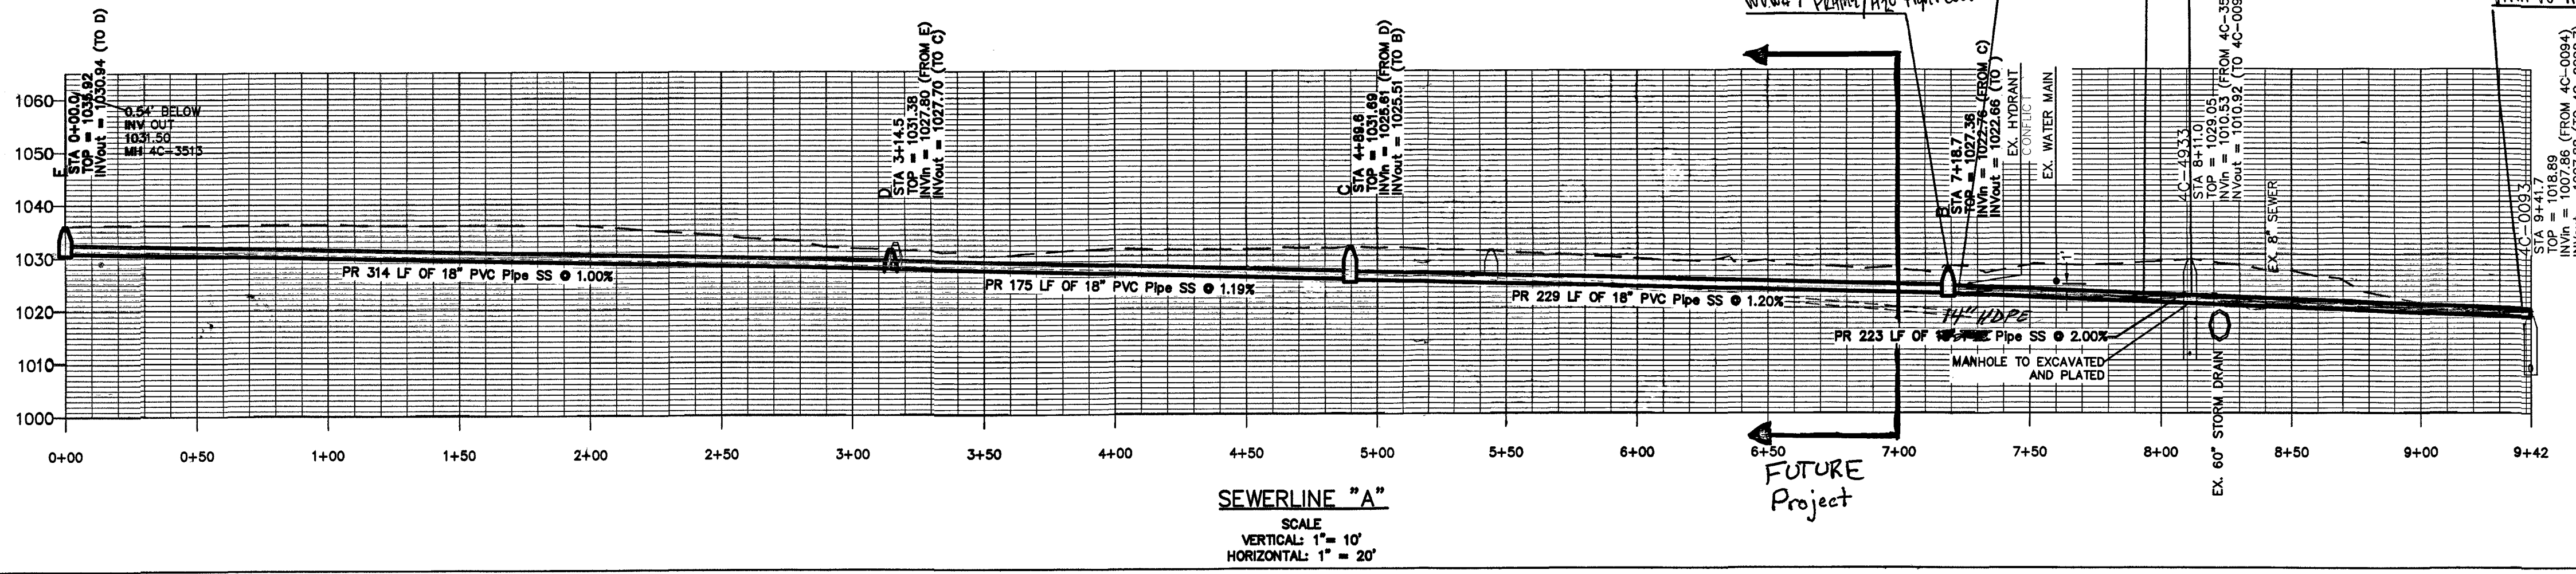

WESTERN VIRGINIA

WATER AUTHORITY

ENGINEERING SERVICES
601 S JEFFERSON ST, SUITE 300
ROANOKE, VA 24011
540-853-5700

As-Built

PRELIMINARY

Boxley &

PLANTATION SEWER (CIP-211)

By

Date

Description

Rev

Designed: AAS

Drawn: AAS

Checked: TEC

Approved: TEC

Date: 7/2/18

Project:

1

Sheet 1 of 2

PLAN & PROFILE