


170.17

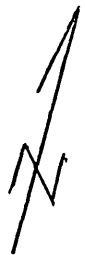

1	6"	7'E of EPL	
2	2"	O.E.P.L.	

Done