


CITY OF ROANOKE

↑
N
DIRECTION

AEP POI
301-258

Repair on Storm pipe
used SDR-35 w/Fernco's

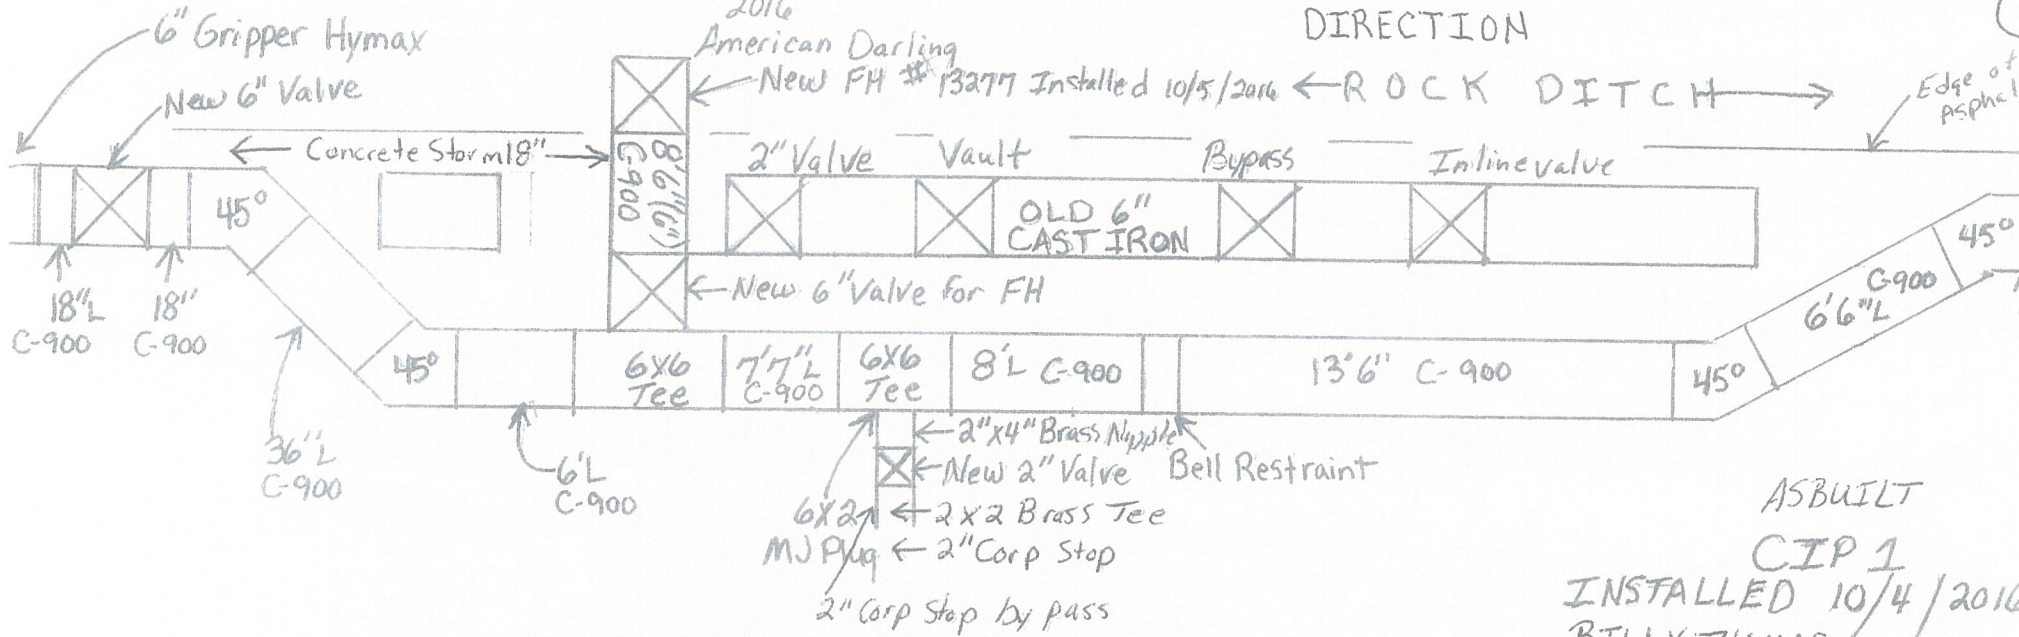

ASBUILT
CIP 1
INSTALLED 10/4/2016
BILLY THOMAS

NOTES: RIGHT TO LEFT
FH TO 6" VALVE 34 1/2 FT.
TO 45° 33 FT.
TO 45° 32 FT.
TO 2" VALVE 14 FT.
TO 6" FH VALVE 8 1/2 FT.
TO 45°
TO 45°
TO 6" VALVE 15 1/2 FT.

BRAMBLE LN SW

NOTES 3616
RIGHT TO LEFT
AEP POLE TO 6" VALVE 11 FT.
45° BEND 13 FT.
45° BEND 20 FT.
2" VALVE 39 1/2 FT.
6" FH VALVE 45 1/2 FT.
45° BEND 54 FT
45° BEND 56 FT.
6" VALVE 58 FT