


CITY OF ROANOKE

← Z
DIRECTION

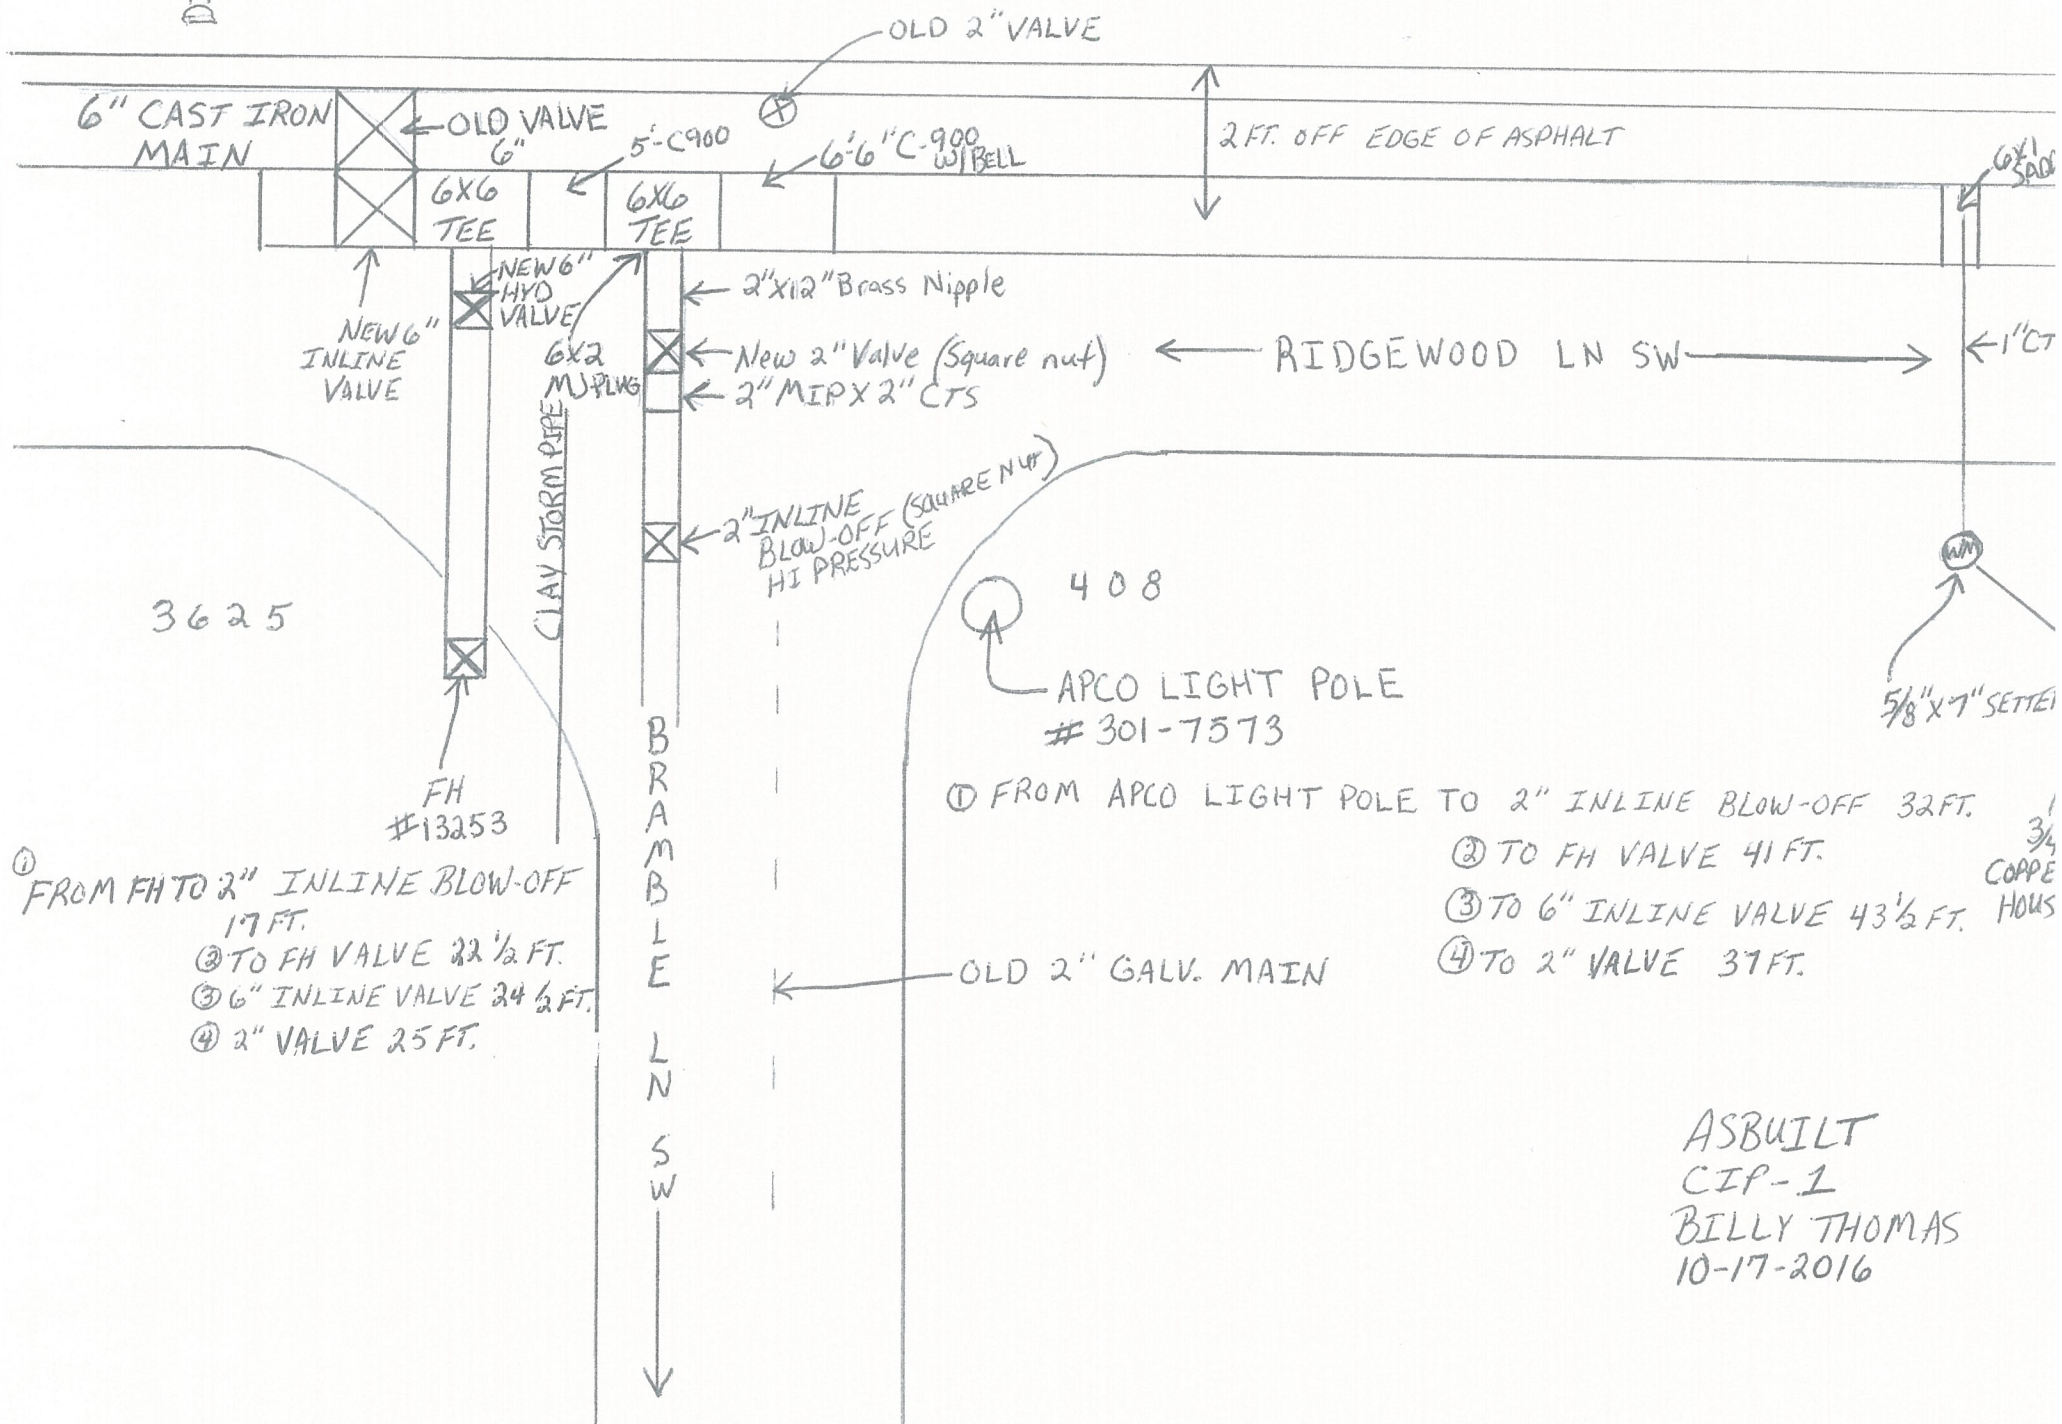

ASBUILT
CIP-1
BILLY THOMAS
10-17-2016