


← N
DIRECTION

CITY OF ROANOKE

3646
RIDGEWOOD
LN SW

3654
RIDGEWOOD
LN SW

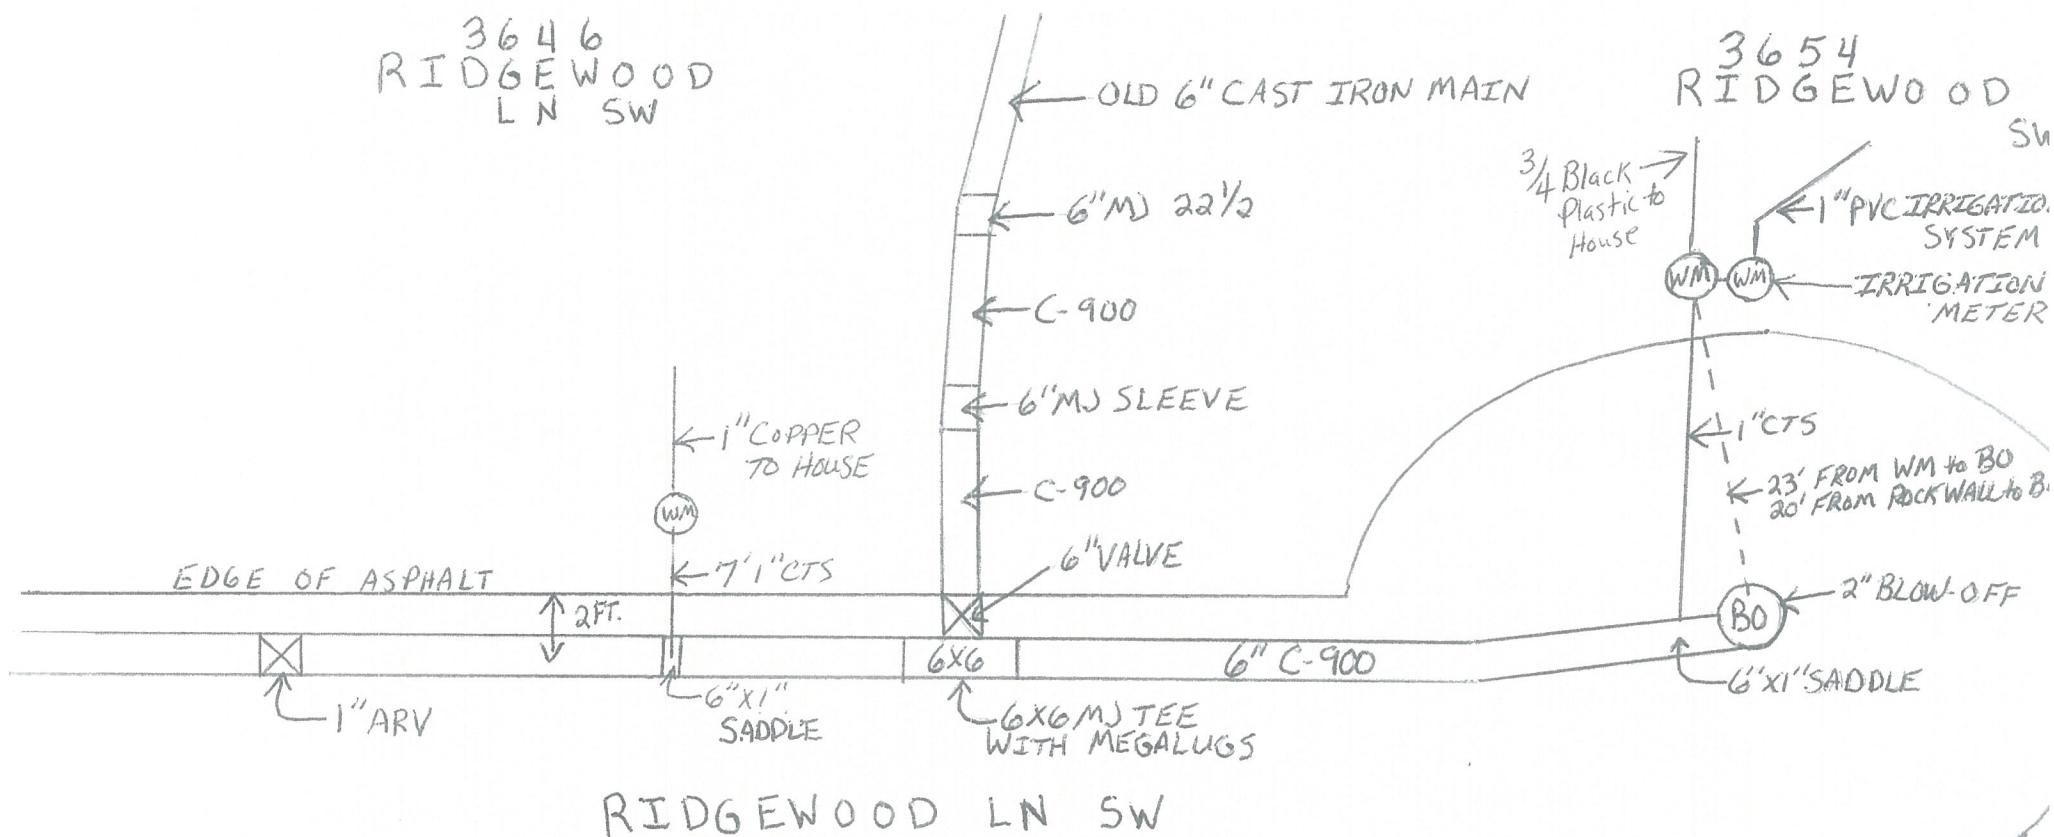

NOTES:

FROM B.O. TO 6X6 TEE & VALVE 57'
 B.O. TO SERVICE AT 3646 93'
 B.O. TO ARV 130.9'
 B.O. TO SERVICE AT 3635 230'
 B.O. TO INLINE 6" VALVE 353'

NEW 6" C-900 MAIN IS LOCATED 2FT. OFF EDGE OF ASPHALT

ASBUILT
 CIP-1
 BILLY THOMAS
 10-20-2016