


7-18-69

2-11298

DATE STARTED	July 31, 1969				
DATE COMP.	Aug 25, 1969				
FEET MAIN	SIZE	VALVE	VAULT	BOX	
2172'	12"	3	3		
50'	8"	-	-		
F. H. COMP.	1	6"	1	1	
F. H. STUB ONLY	-				
SERV. INS. BY:	-				
MAINS INS. BY:	RWD				
NO. 3/4" SERV. INS.	-				
CITY OR CO.	County				
DEPT. INSP.	BRH & DTM				

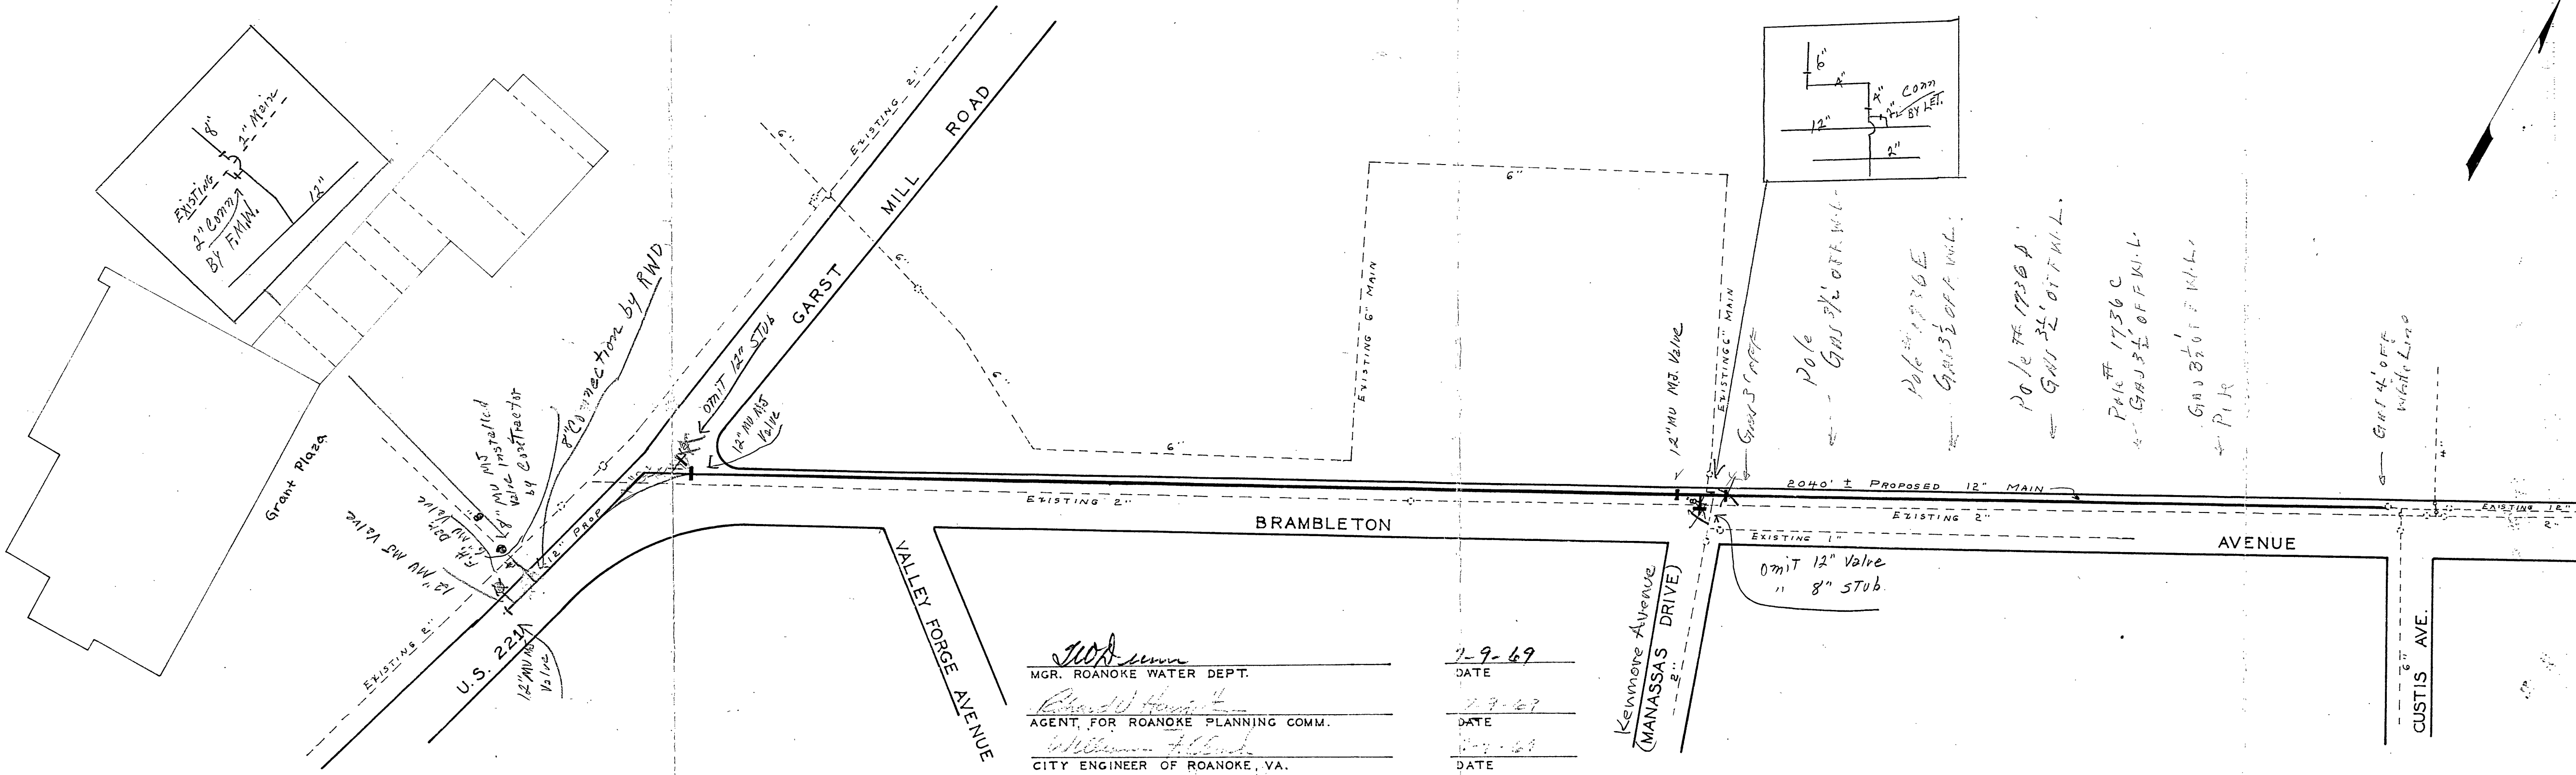

William F. Smith
MGR. ROANOKE WATER DEPT.
Richard J. Hargis
AGENT, FOR ROANOKE PLANNING COMM.
William F. Smith
CITY ENGINEER OF ROANOKE, VA.
William F. Smith
DIRECTOR OF PUBLIC WORKS

7-9-69
DATE
7-9-69
DATE
7-9-69
DATE
7-9-69
DATE

WATER DEPARTMENT
CITY OF ROANOKE, VA.
BRAMBLETON AVENUE S.W.
SCALE - 1" = 100'
DRAWN BY E.L.A. JULY 8, 1969

69-31-C

DIST MAP # 62