

"AS-BUILT"
SECTIONS 1, 2, 3

DEVELOPMENT PLANS

FOR

BRANDERWOOD

ROANOKE CO., VIRGINIA

DATE: 13 DECEMBER 1989

DEVELOPER

BOONE, BOONE & LOEB, INC.


APPROVED:

DEVELOPMENT REVIEW COORDINATOR
ROANOKE COUNTY, VA. DATE


RESIDENT ENGINEER, VIRGINIA DEPARTMENT OF
HIGHWAYS & TRANSPORTATION DATE

INDEX OF DRAWINGS

SHEET	DESCRIPTION
1	COVER SHEET
2	ROANOKE COUNTY STANDARD COVER SHEET
3	RECORD PLAT (TWO SHEETS)
4	NOTES & ROAD SECTIONS
5	PLAN & PROFILES
6	PLAN & PROFILES
7	PLAN & PROFILES
8	PLAN & PROFILES
9	SANITARY SEWER PROFILE
10	SANITARY SEWER PROFILE
11	STORM DRAIN PROFILE
12	EROSION CONTROL & DRAINAGE DIVIDE
13	OFF-SITE WATER PLAN & PROFILE (PREVIOUSLY SUBMITTED & APPROVED)
14	WATER SYSTEM DETAILS - SECTION #1 (PREVIOUSLY SUBMITTED & APPROVED)
15	STANDARD ROANOKE COUNTY WATER DETAIL
16	STANDARD ROANOKE COUNTY SEWER DETAIL
12A	ROANOKE COUNTY EROSION & SILTATION COST ESTIMATE

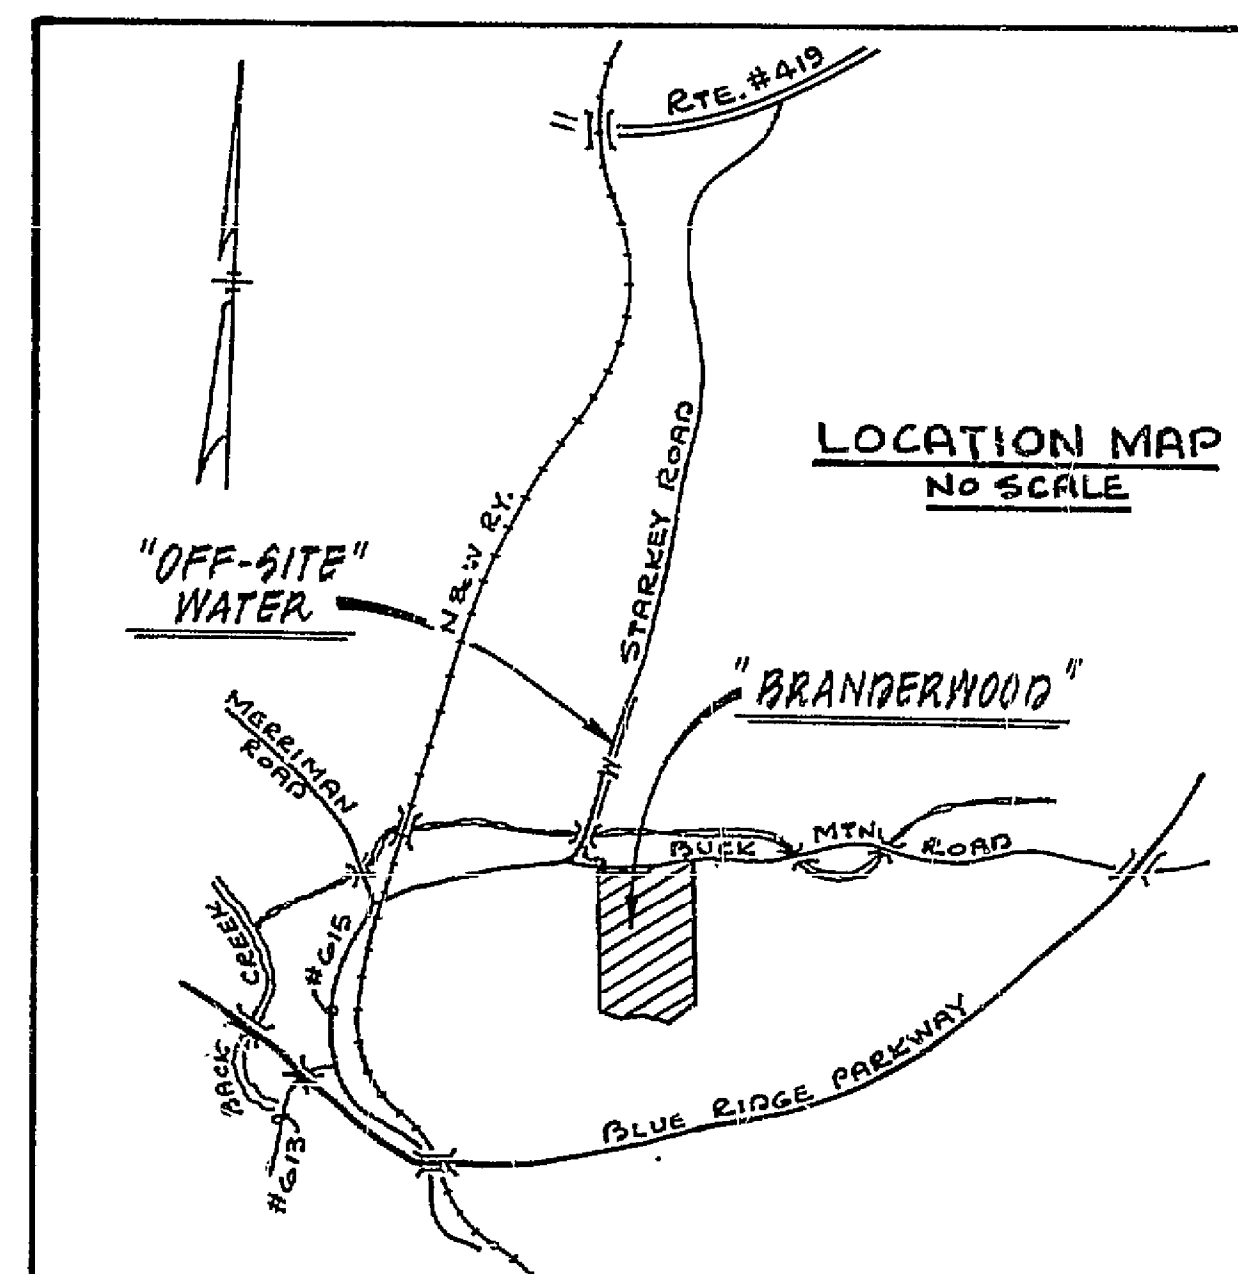

BUFORD T. LUMSDEN & ASSOCIATES, P.C.
ENGINEERS - SURVEYORS
ROANOKE, VIRGINIA

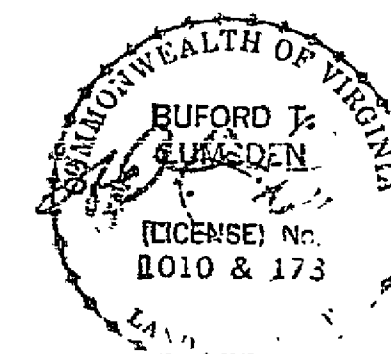

*84-66
SHEET #1 OF 15

