


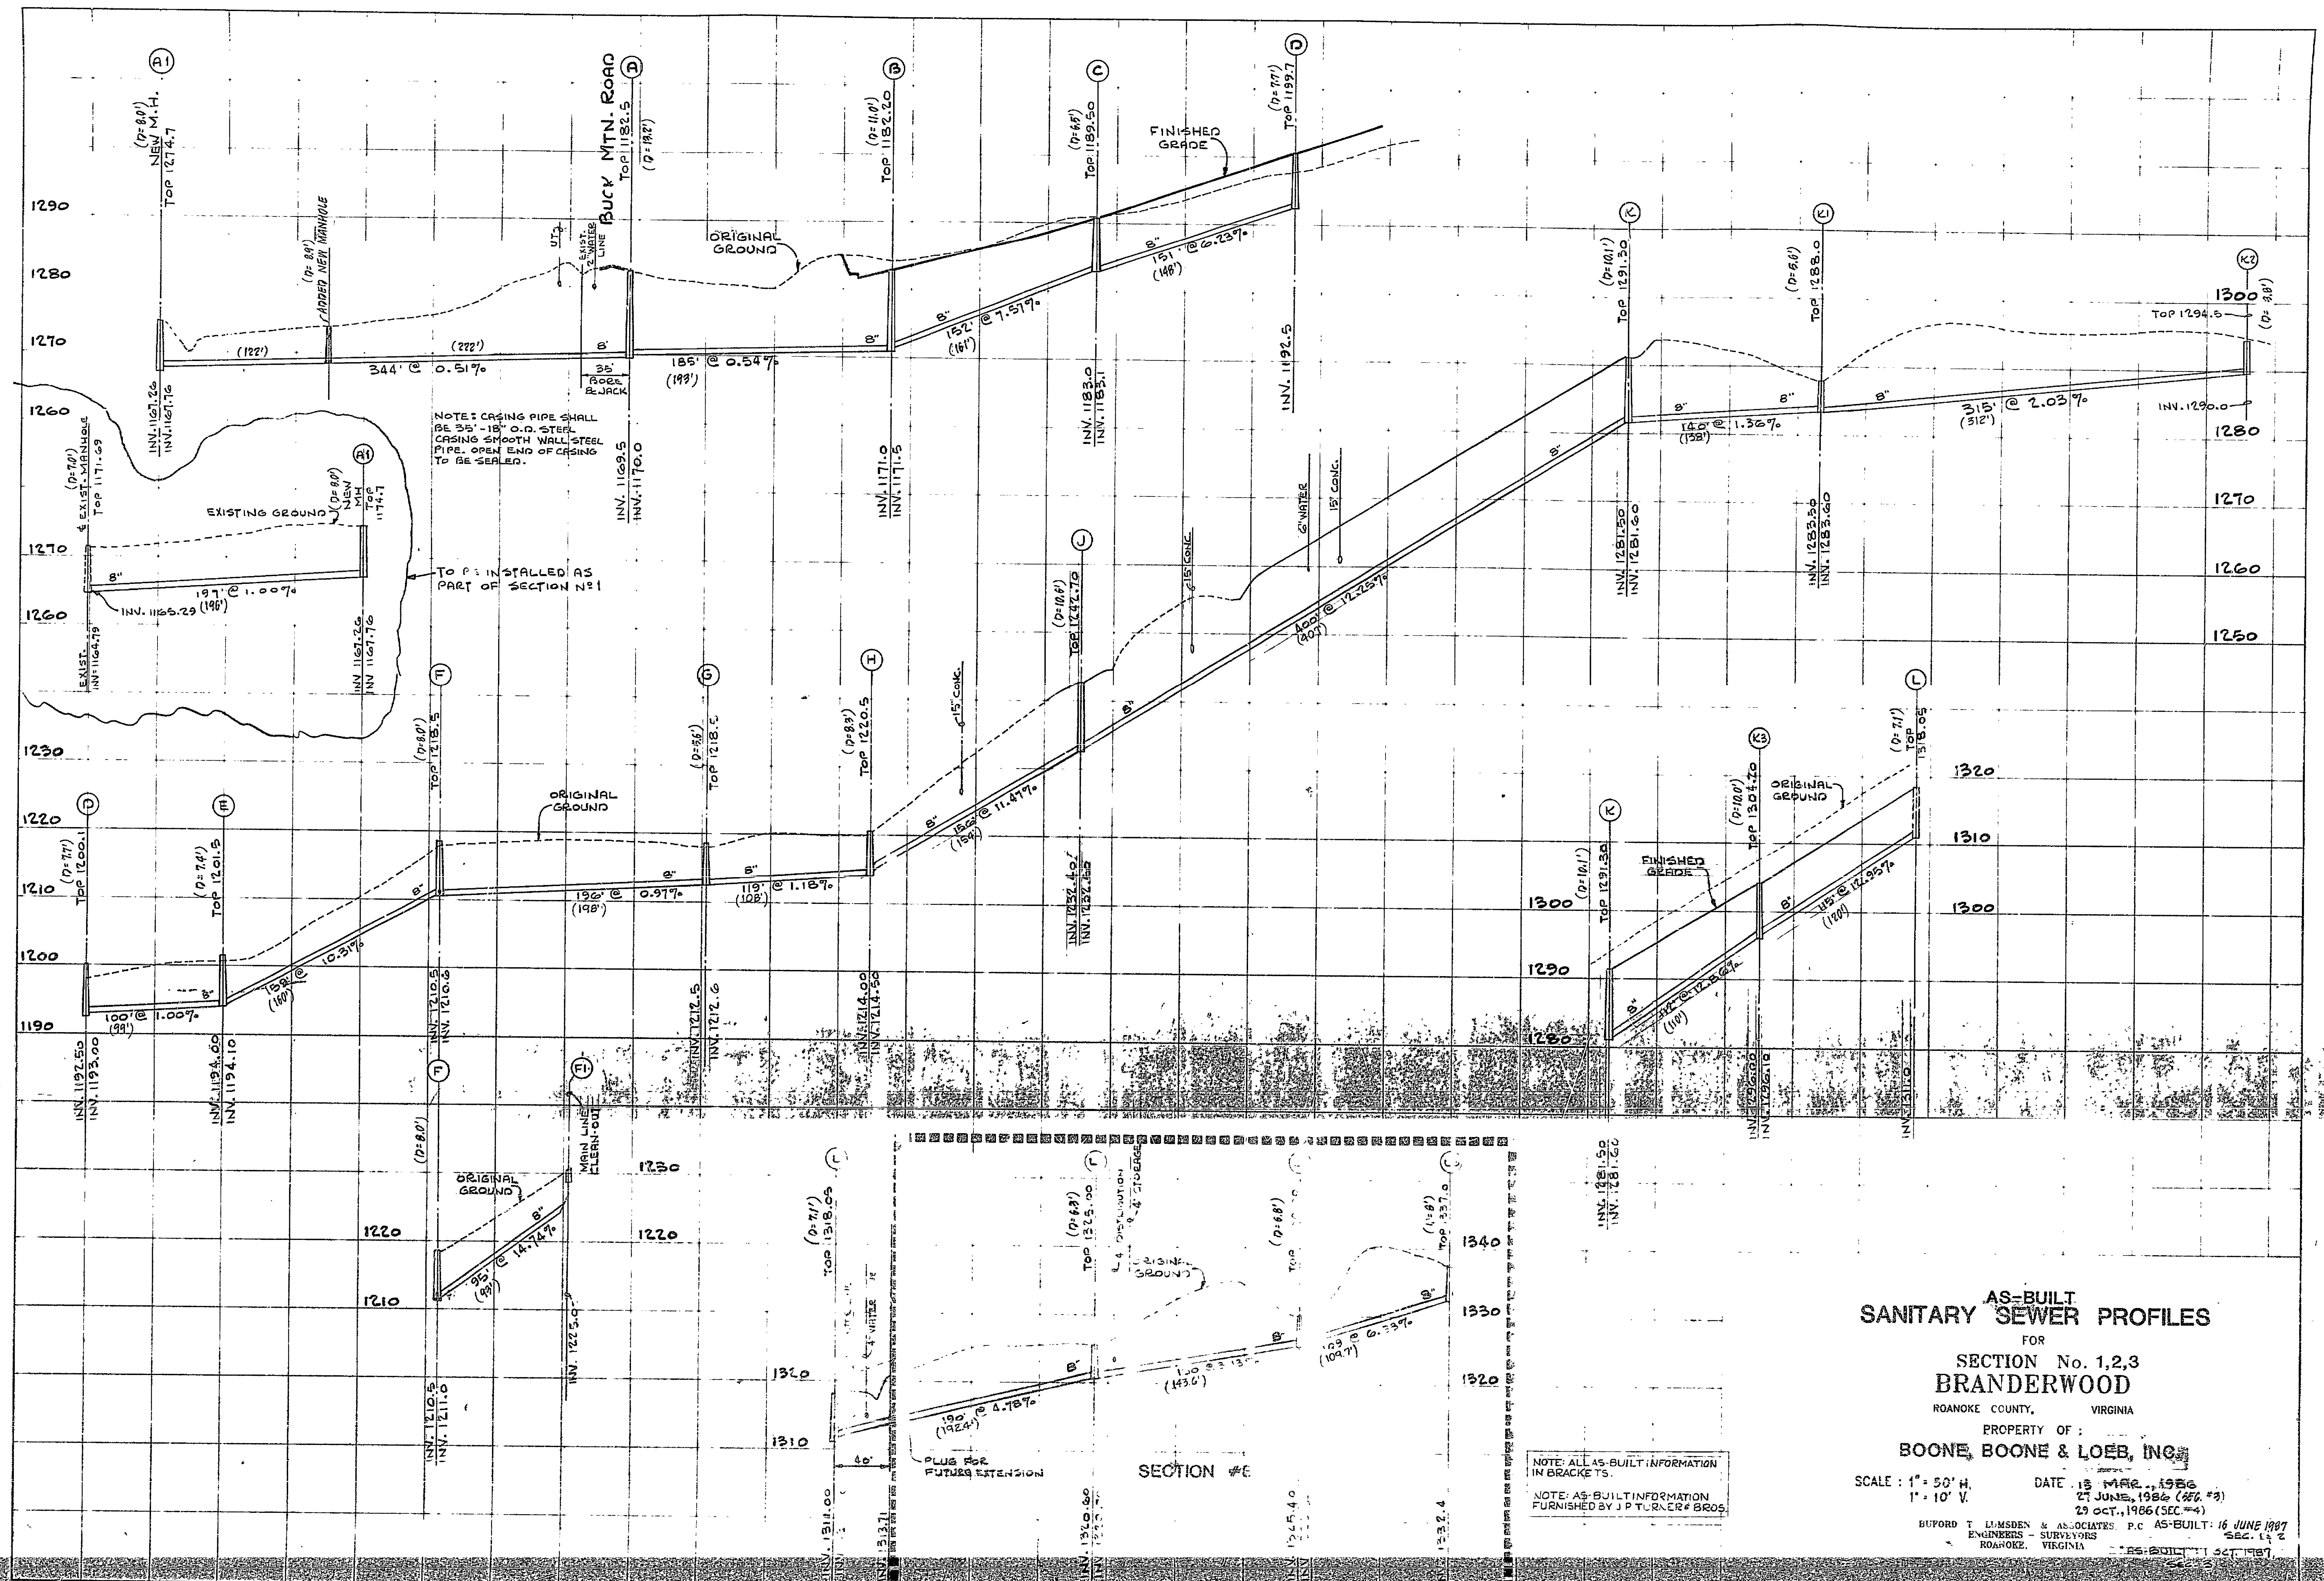

AS-BUILT SANITARY SEWER PROFILES

FOR
SECTION No. 1, 2, 3
BRANDERWOOD

ROANOKE COUNTY, VIRGINIA

PROPERTY OF:

BOONE, BOONE & LOEB, INC.

SCALE: 1" = 50' H.
1" = 10' V.

DATE: 15 MAR., 1986
27 JUNE, 1986 (REV. #3)
27 OCT., 1986 (SEC. #4)

BY: BUFORD T. LAMSDEN & ASSOCIATES, P.C. AS-BUILT: 16 JUNE 1987
ENGINEERS - SURVEYORS
ROANOKE, VIRGINIA

SHEET 9 OF 10