




BALZERS ASSOCIATES
PLANNERS / ARCHITECTS
ENGINEERS / SURVEYORS
Riverside / Richmond
New River Valley / Lynchburg
www.balzers.cc
1300 Commerce Center
Richmond, VA 23269
804.772.6600

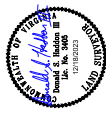

BRANDON AVENUE COMMERCIAL CENTER
WWMA WATER & SANITARY AS-BUILT

DRAWN BY: EJP
DESIGNED BY: KAM
CHECKED BY: DSH
DATE: 12/18/2023
SCALE: 1" = 20'
REVISIONS:

AS-BUILT
PROJECT NO.

