
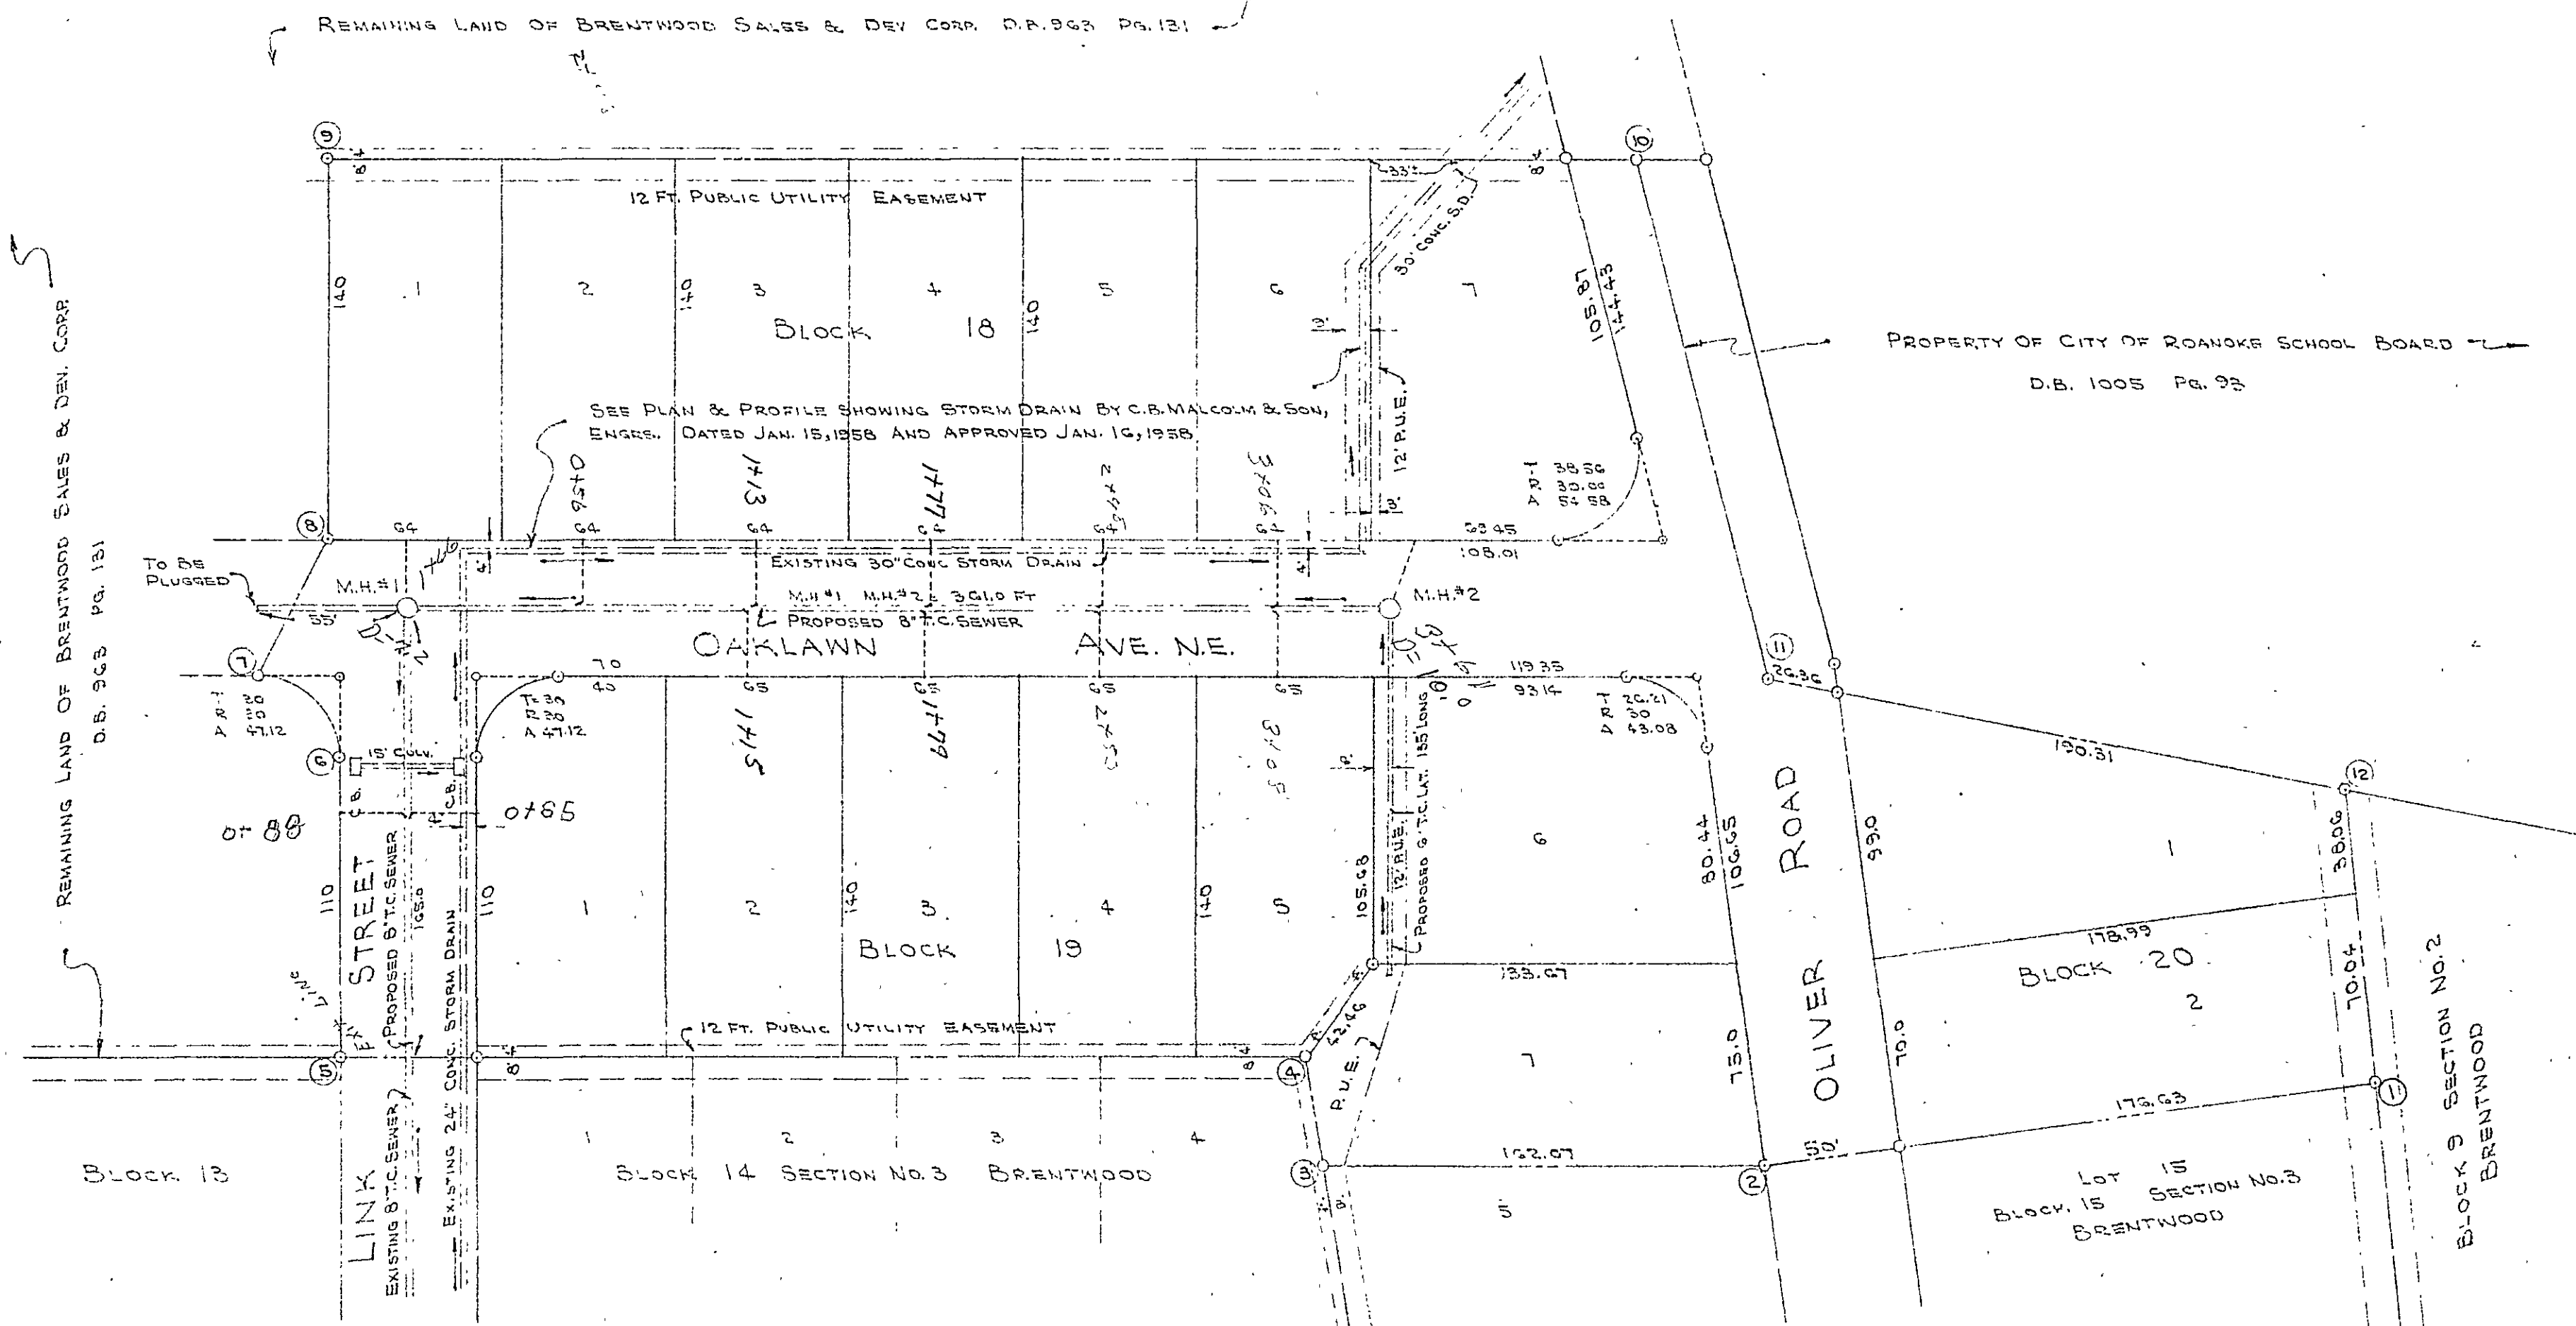


| PLAN      | DATE    | BY     | CHECKED |
|-----------|---------|--------|---------|
| NO. 1     | 3-27-59 | C.B.M. | C.B.M.  |
| NOTE BOOK |         |        |         |
| NO.       |         |        |         |

| PROFILE   | DATE    | BY     | CHECKED |
|-----------|---------|--------|---------|
| NO. 1     | 3-27-59 | C.B.M. | C.B.M.  |
| NOTE BOOK |         |        |         |
| NO.       |         |        |         |

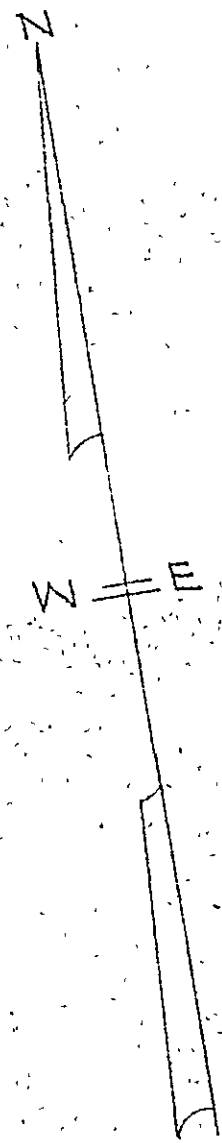

PLAN SCALE 1" = 50'

APPROVED:  
*[Signature]*  
CITY ENGINEER OF ROANOKE VIRGINIA

3-31-59  
DATE

AGENT, ROANOKE CITY PLANNING COMM. DATE

as built plans  
4/2/59

NOTE: SEWER MAIN AND MANHOLES TO BE CONSTRUCTED IN ACCORDANCE WITH CITY OF ROANOKE STANDARDS AND SPECIFICATIONS.

PRELIMINARY MAP  
SECTION No. 4  
BRENTWOOD.

PROPERTY OF BRENTWOOD SALES & DEV. CORP.  
B. IRVIN GIMBERT PRES & G.W. REED, JR., SECT.  
ROANOKE, VIRGINIA

BY: C.B. MALCOLM & SON  
STATE CERT. ENGRS.

DATE: MARCH 27, 1959 SCALE: AS NOTED

