


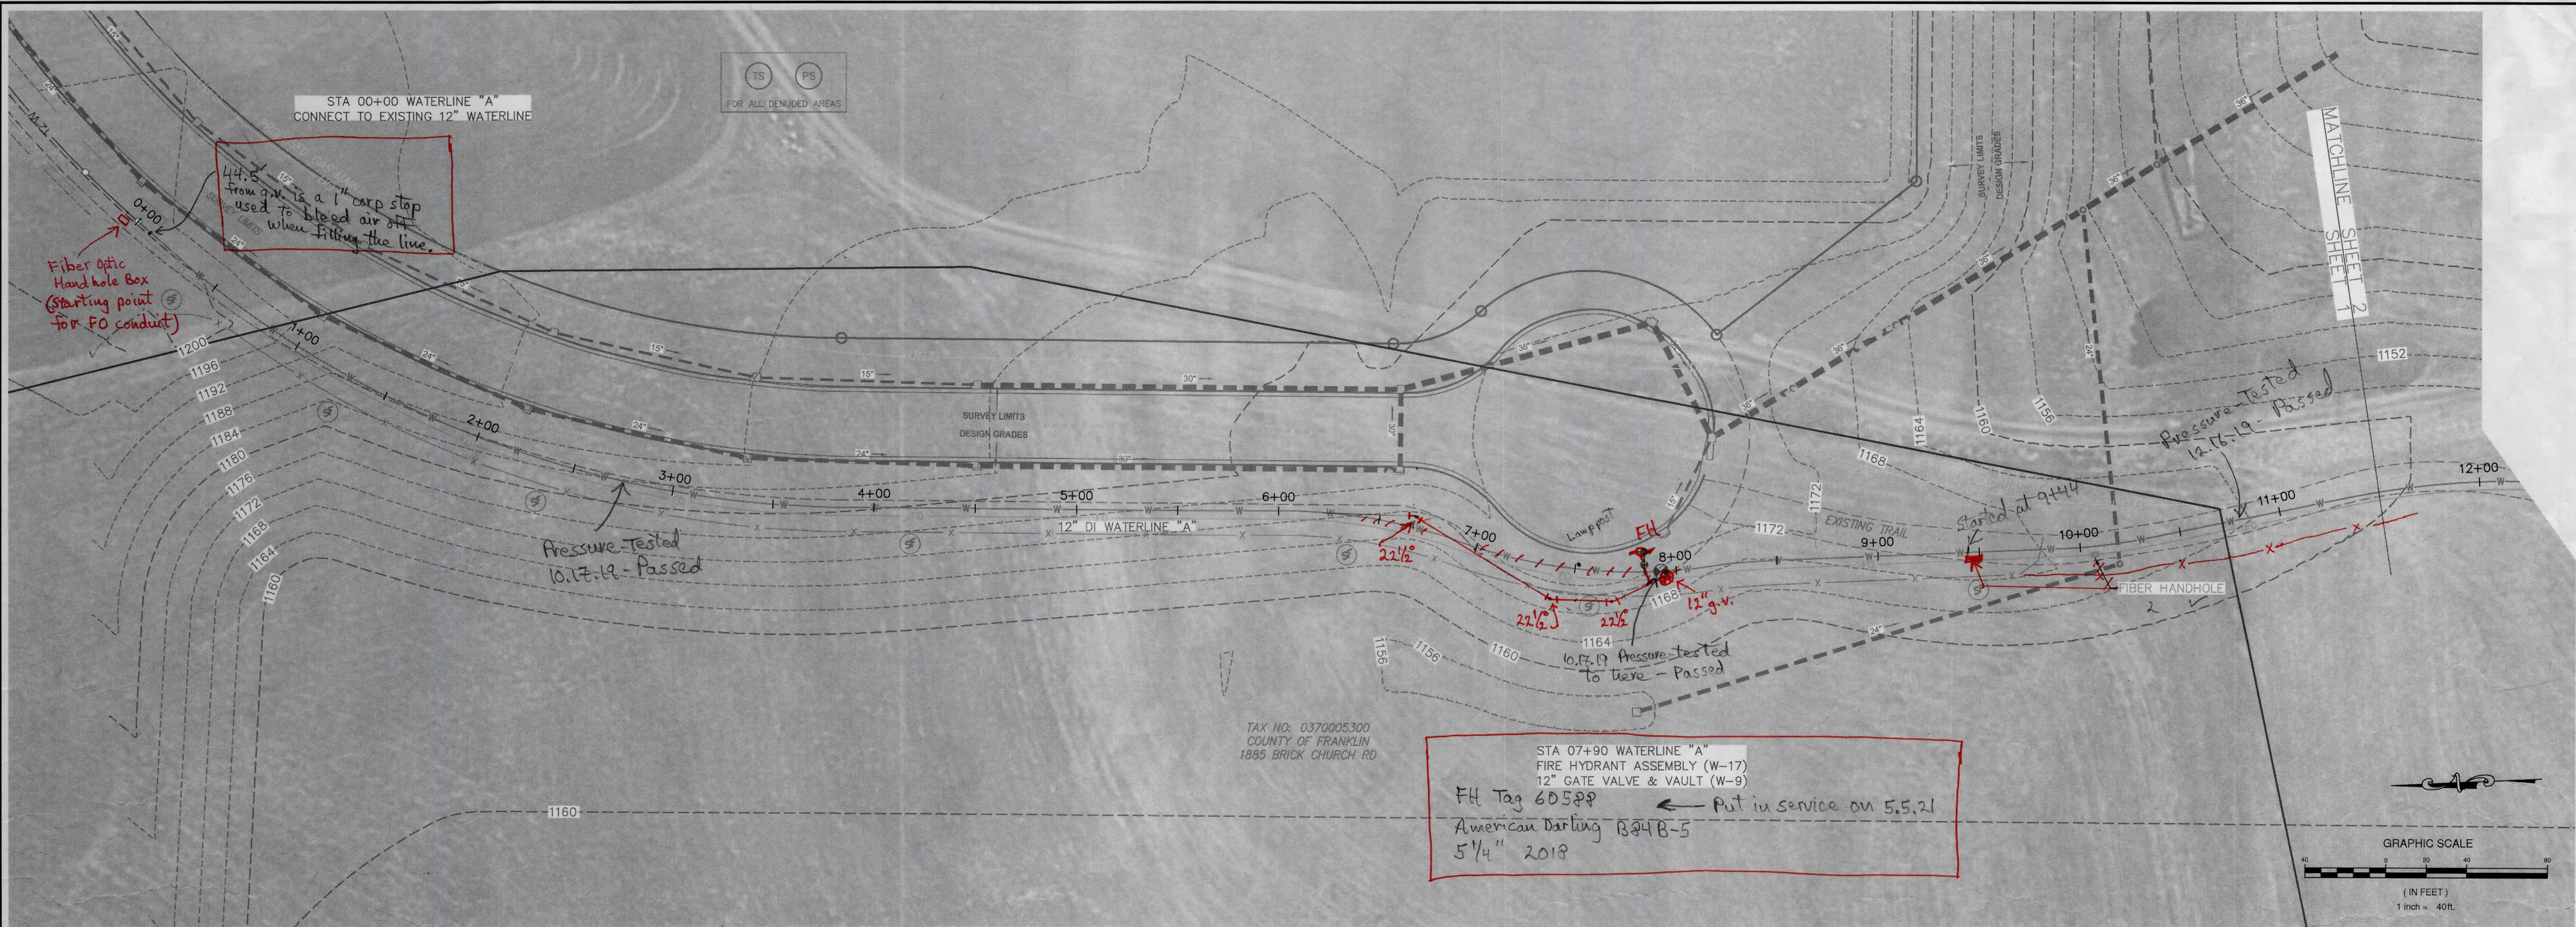


H₂O Valves - American Flow Control - 12", 8", 6", 2"
Pipe - U.S. Pipe DIP CL 350 12", 8", 6"
12" Flying W HDPE DR 11


12" - CCW To Open 39 Turns
8" - CCW To Open 27 Turns
6" - CCW To Open 21 Turns
2" - CCW To Open 9 Turns

Service Line - 1" Endot HDPE, SDR-9
Fire Hydrants - American Darling B94B-5 5 1/4"

Waterline is between the road and
the Fiber Optic Conduit except as noted.

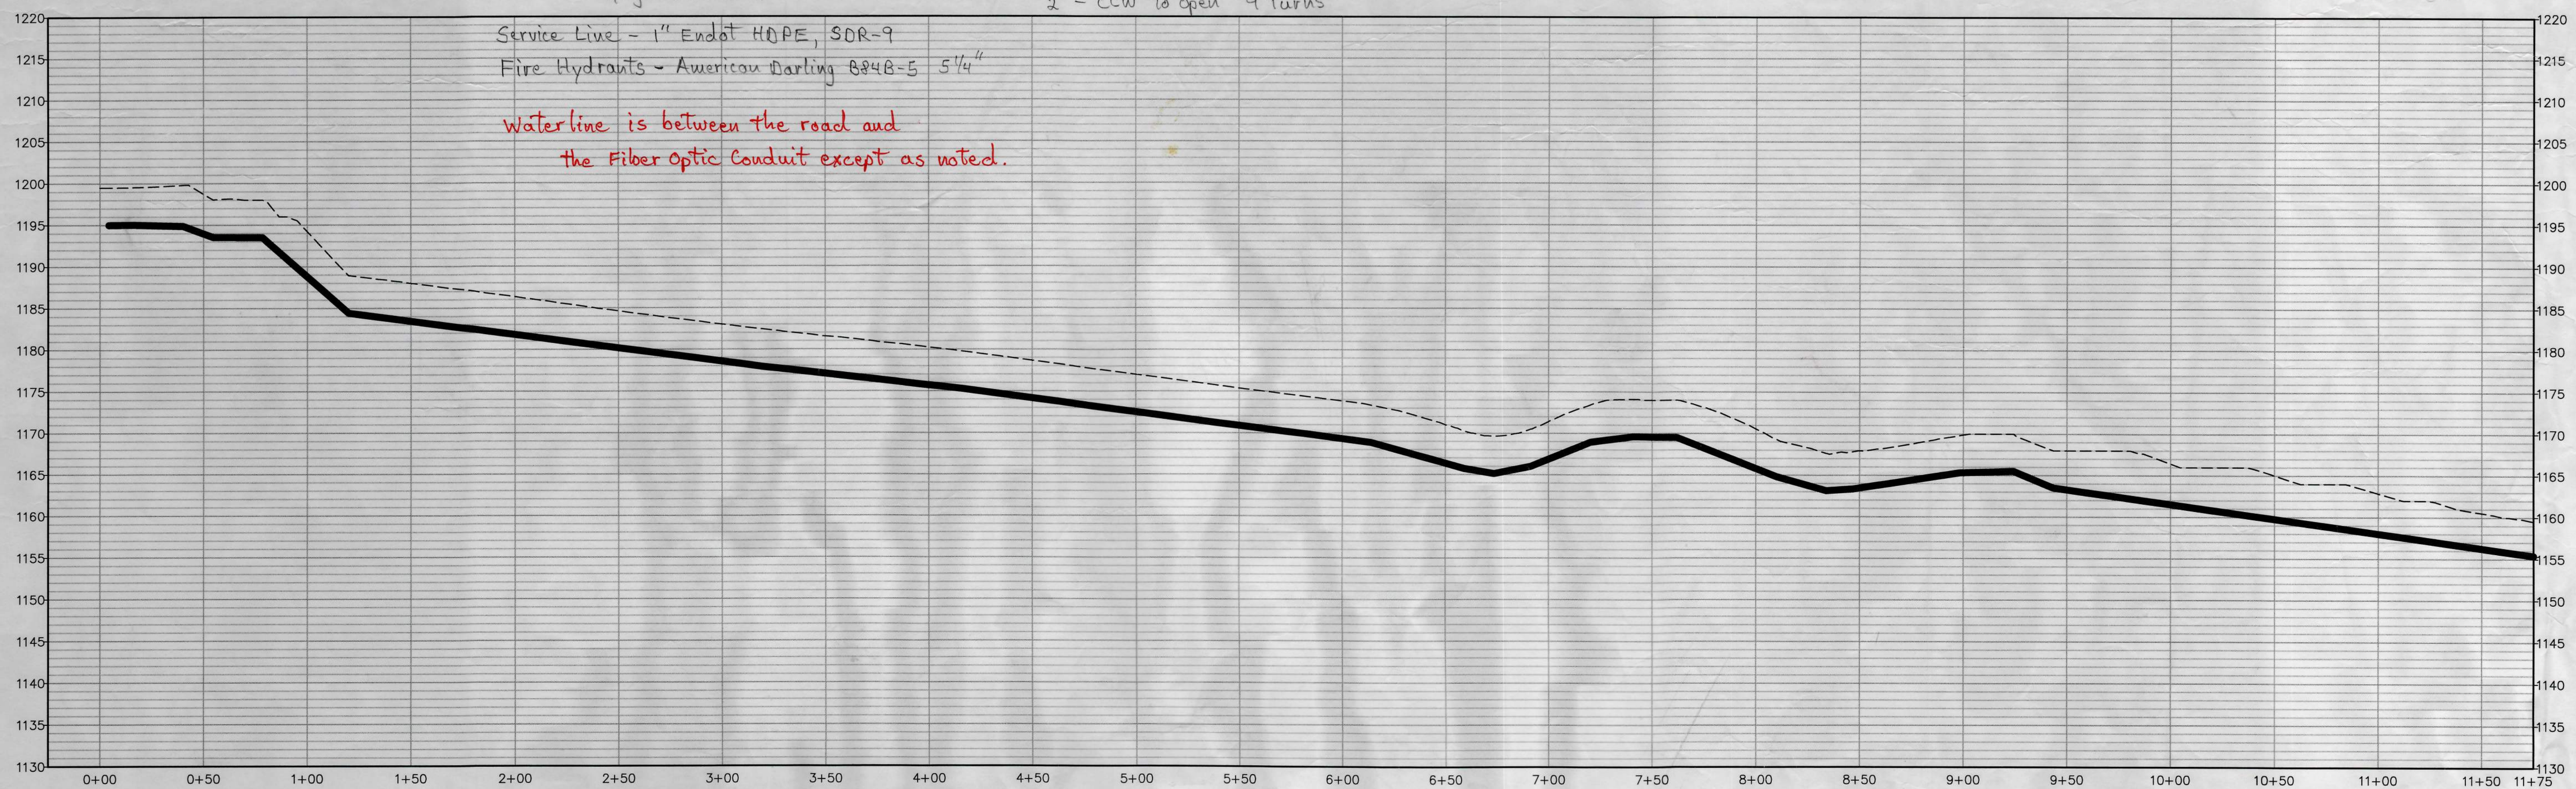

PROFILE: STA -0+25 TO STA 11+75 - Scale: H: 1"=40', V: 1"=10'

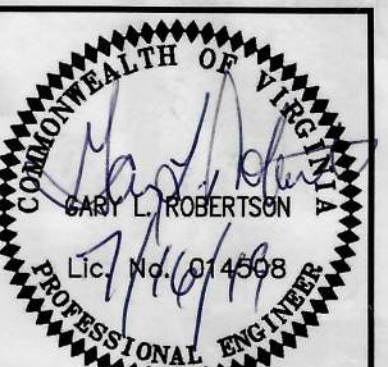

WESTERN VIRGINIA
WATER AUTHORITY



BRICK CHURCH ROAD
WATERLINE EXTENSION

FRANKLIN COUNTY, VIRGINIA

REVISIONS

DESIGNED BY:	GLR
DRAWN BY:	PDG, DRJ
CHECKED BY:	WNR
SCALE:	1" = 40'
DATE:	APRIL 2019
PROJECT NUMBER:	WCIP-340
SHEET TITLE:	PLAN & PROFILE

1

1 OF 11